

# PLAN OF SURVEY OF BLOCK 204 PLAN 62M-1238 CITY OF HAMILTON

SCALE 1:300  
10m 5m 0 10m 20m 30 metres

RADY-PENTEK & EDWARD SURVEYING LTD., O.L.S.

## METRIC

DISTANCES AND COORDINATES SHOWN ON THIS PLAN ARE IN METRES AND CAN BE CONVERTED TO FEET BY DIVIDING BY 0.3048.

## SURVEYOR'S CERTIFICATE

I CERTIFY THAT:

1. THIS SURVEY AND PLAN ARE CORRECT AND IN ACCORDANCE WITH THE SURVEYS ACT, THE SURVEYORS ACT AND THE LAND TITLES ACT AND THE REGULATIONS MADE UNDER THEM.

2. THE SURVEY WAS COMPLETED ON THE 31<sup>st</sup> DAY OF AUGUST, 2018.

DATE Sept-20 2018.

T. Singh  
T. SINGH  
ONTARIO LAND SURVEYOR

I REQUIRE THIS PLAN TO BE DEPOSITED UNDER THE LAND TITLES ACT.

DATE Sept-20 2018  
T. Singh  
T. SINGH, O.L.S.

PLAN 62R-20980

RECEIVED AND DEPOSITED

DATE September 21, 2018

"J. Mackenzie"

REPRESENTATIVE FOR LAND REGISTRAR FOR THE LAND TITLES DIVISION OF WENTWORTH (No.62)


## SCHEDULE

| PART | PART OF BLOCK | PLAN     | PART OF P.I.N. |
|------|---------------|----------|----------------|
| 1    | 204           | 62M-1238 | 17501-0726     |
| 2    | 204           |          | 17501-0726     |
| 3    | 204           |          | 17501-0726     |
| 4    | 204           |          | 17501-0726     |
| 5    | 204           |          | 17501-0726     |
| 6    | 204           |          | 17501-0726     |
| 7    | 204           |          | 17501-0726     |
| 8    | 204           |          | 17501-0726     |
| 9    | 204           |          | 17501-0726     |
| 10   | 204           |          | 17501-0726     |
| 11   | 204           |          | 17501-0726     |
| 12   | 204           |          | 17501-0726     |

PARTS 1 TO 12 (INCLUSIVE) COMPRISE ALL OF P.I.N. 17501-0726

PARTS 1 TO 12 (INCLUSIVE) ARE SUBJECT TO AN EASEMENT IN GROSS AS SET OUT IN WE1193623

PARTS 1 TO 12 (INCLUSIVE) ARE SUBJECT TO AN EASEMENT FOR ENTRY AS IN WE1245521

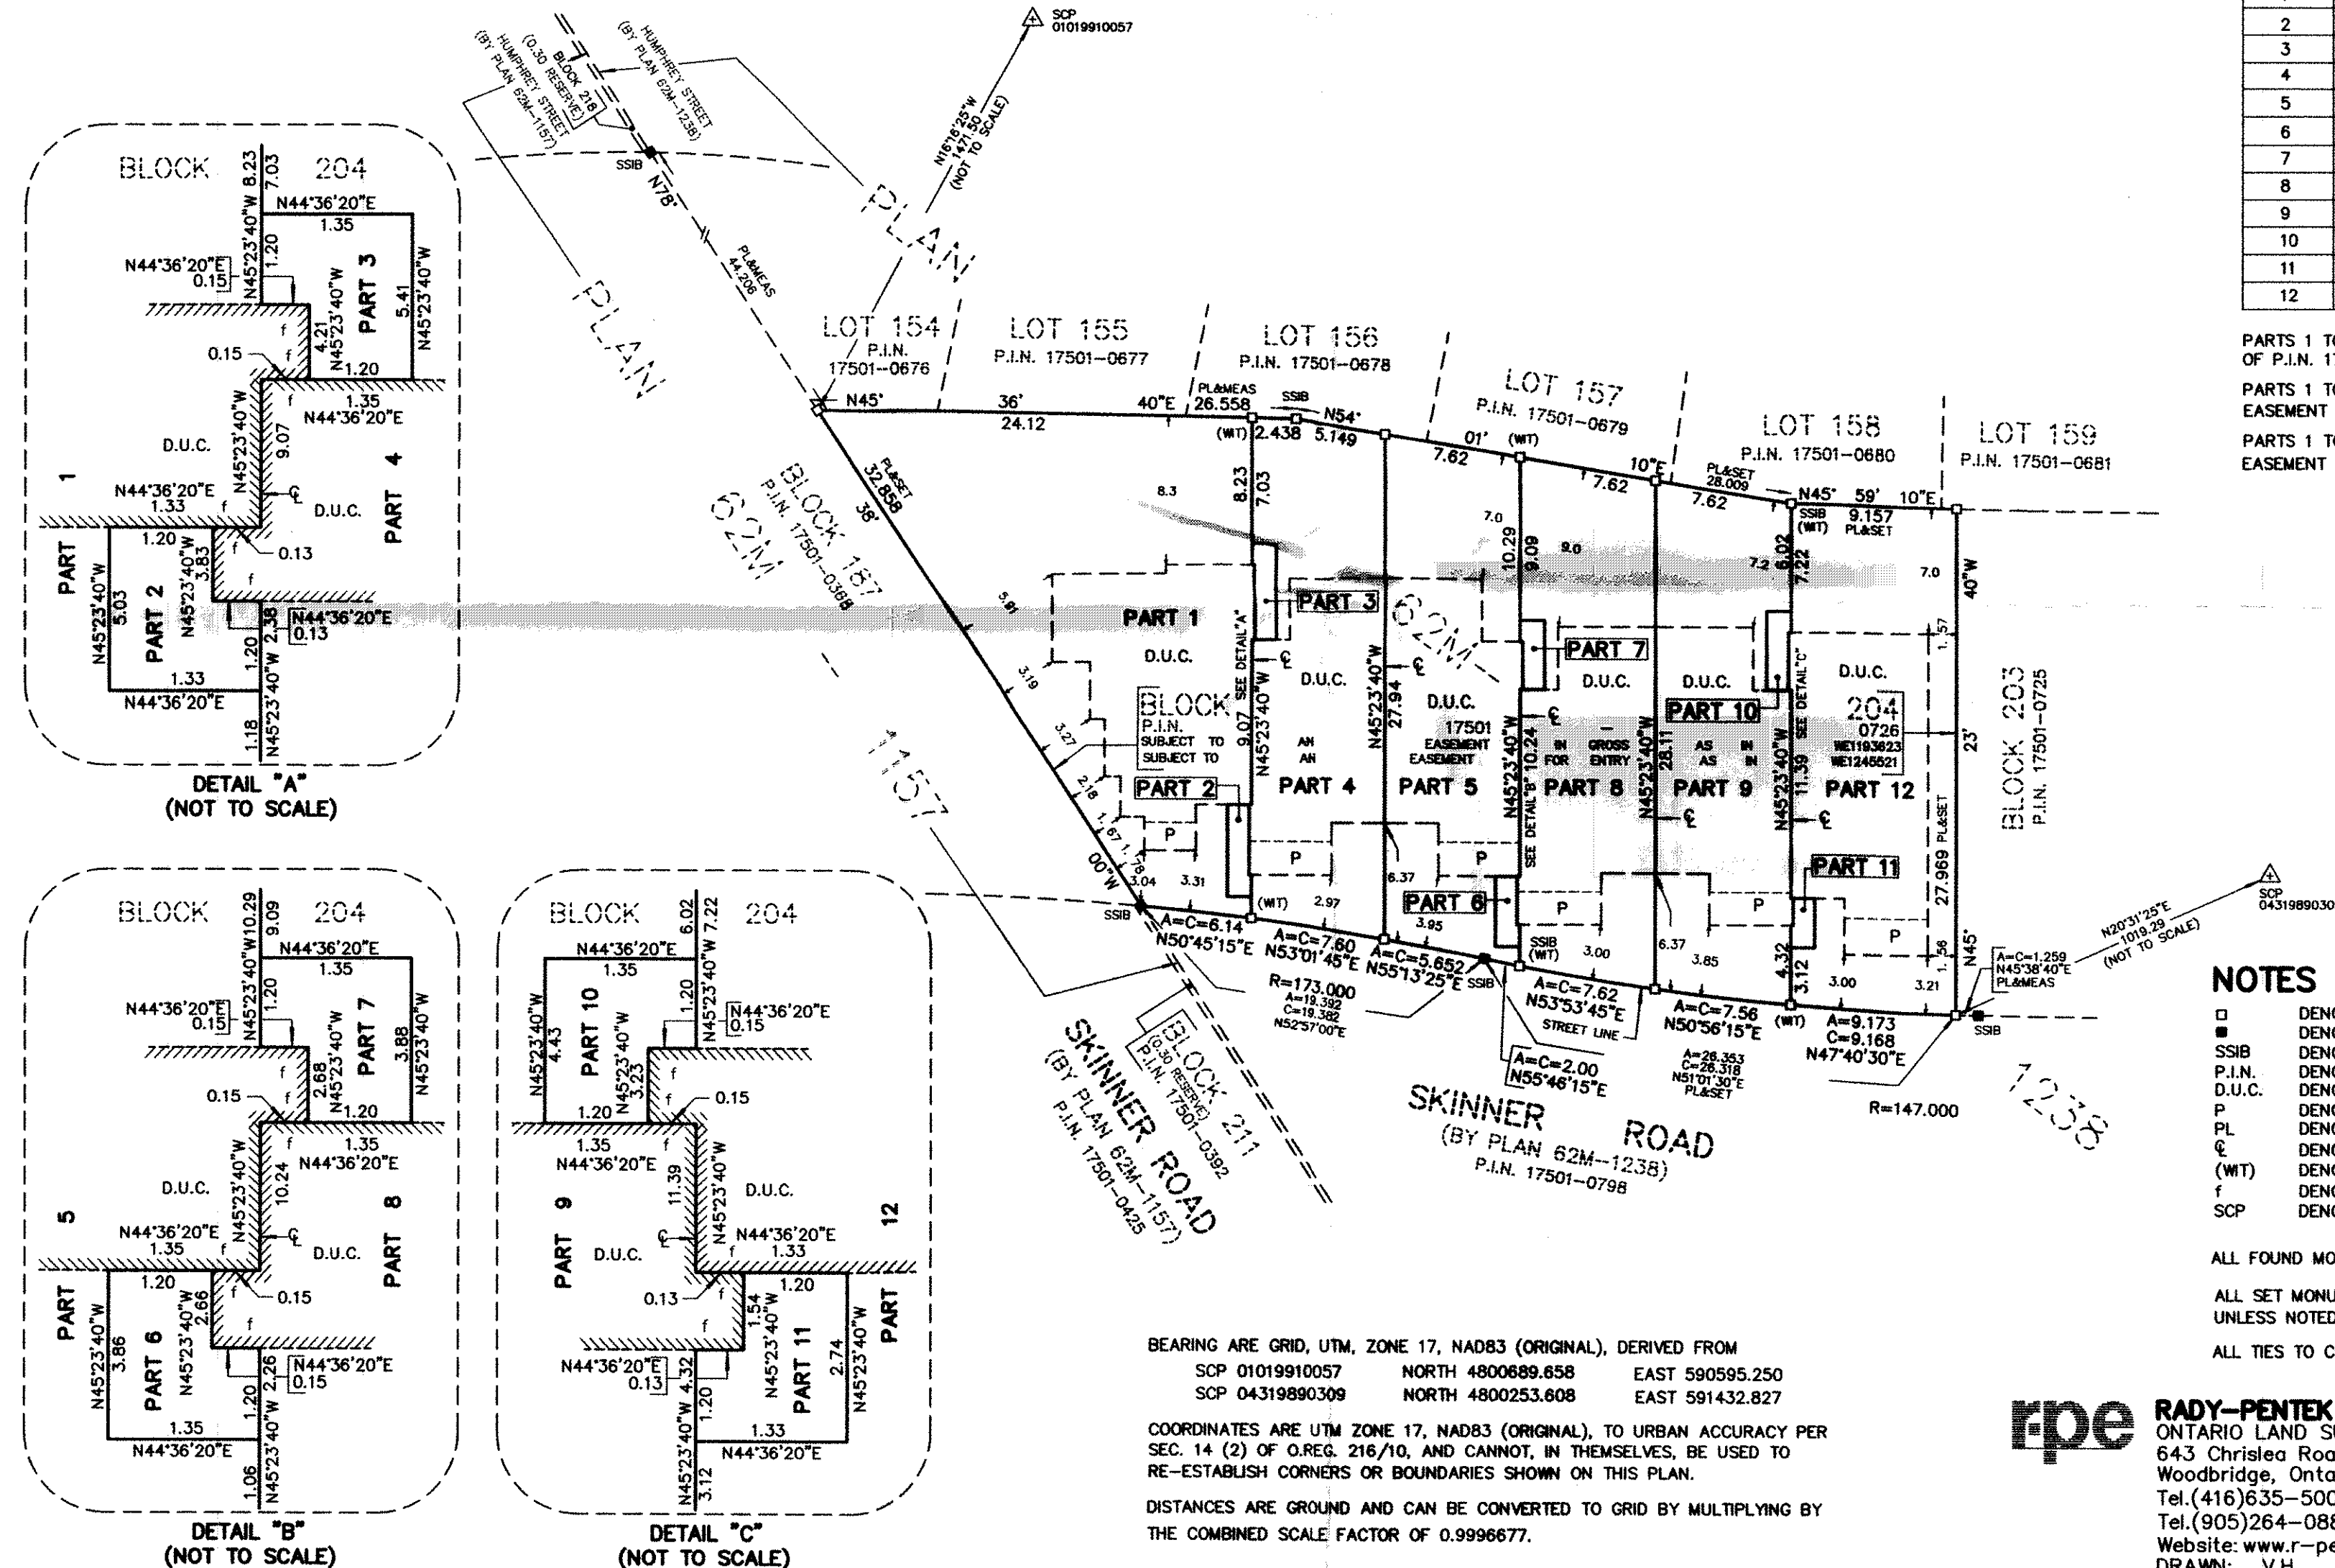

## NOTES

- DENOTES MONUMENT SET
- DENOTES MONUMENT FOUND
- SSIB DENOTES SHORT STANDARD IRON BAR
- P.I.N. DENOTES PROPERTY IDENTIFIER NUMBER
- D.U.C. DENOTES DWELLING UNDER CONSTRUCTION
- P DENOTES PORCH
- PL DENOTES PLAN 62M-1238
- ℄ DENOTES CENTRELINE OF WALL
- (WT) DENOTES WITNESS
- f DENOTES FACE OF WALL
- SCP DENOTES SPECIFIED CONTROL POINT

ALL FOUND MONUMENTS BY J. D. BARNES LIMITED, O.L.S.

ALL SET MONUMENTS ARE IRON BARS UNLESS NOTED OTHERWISE.

ALL TIES TO CONCRETE FOUNDATION

**rpe**

**RADY-PENTEK & EDWARD SURVEYING LTD.**

ONTARIO LAND SURVEYORS

643 Chrislea Road, Suite 7  
Woodbridge, Ontario L4L 8A3

Tel.(416)635-5000 Fax (416)635-5001

Tel.(905)264-0881 Fax (905)264-2099

Website: www.r-pe.ca

DRAWN: V.H.

CHECKED: G.Y./T.S.

JOB No. 18-067

CAD FILE No. 18-067R12