



**BRAMPTON**  
Flower City

Planning and Development Services  
Building Division  
8850 McLaughlin Road, Unit 1  
Brampton, ON L6Y 5T1

**WATER PIPE SIZING AND PLUMBING DATA SHEET**

**CERTIFIED MODEL WITH ONE DWELLING UNIT**

**THIS TABLE IS APPLICABLE FOR A HOUSE AFTER DECEMBER 31, 2017**

Builder Name: GREENPARK HOMES  
Certified Model Name: CLOVER 11A  
Optional Floor Layout:  
Application No.:



SWhite

The Ontario Building Code Div. B, 7.6.3 regulates size and capacity of pipes for a new house. Please enter the number of individual fixtures as listed and bathroom groups<sup>(6)</sup> or powder room groups<sup>(7)</sup> per floor. The fixture units and required minimum size of water service will automatically be calculated.

Description	Basement Floor	First Floor	Second Floor	Third Floor
	Qty.	Qty.	Qty.	Qty.
Bathroom group <sup>(6)</sup>	1		2	
Bidet				
Extra Shower			1	
Lav				
Bar Sink				
Powder room <sup>(7)</sup>		1		
Kitchen Sink		1		
Dishwasher		1		
Laundry Tub			1	
Washing Machine			1	
Hose Bib		2		

Total Fixture Units 25.7

Minimum Diameter of Water Service Pipe  
Required from the Property Line to the  
House (Inch) 3/4

**Notes:**

- (1) A potable water system shall be designed, constructed and installed to conform to good engineering practice appropriate to the circumstances, such as that described in the ASHRAE Handbooks and ASPE Data Books.
- (2) No water system between the point of connection with the water service pipe or the water meter and the first branch that supplies a water heater that serves more than one fixture shall be less than 1/4 in. in size.
- (3) The minimum water pressure at the entry to the building is 200 kPa, and the total maximum length of the water system is 90 m.
- (4) In a hot water distribution system of a developed length of more than 30 m from the HWT to the farthest fixture or supplying more than 4 storeys, the water temperature shall be maintained by, (a) recirculation, or (b) a self-regulating heat tracing system.
- (5)

Where piping may be exposed to freezing conditions, it shall be protected from the effects of freezing.

(6) A bathroom group consists of 1 water closet, 1 lavatory, and 1 bathtub (with or without showerhead)

(7) A powder room group consists of 1 water closet and 1 lavatory.

~~Certified Model #~~

Builder

M Plan

Model

Greenpark


2060

Lot

BIK316 Site

PLEASE SEE  
NOTES AS TH  
OF THE REVIEW



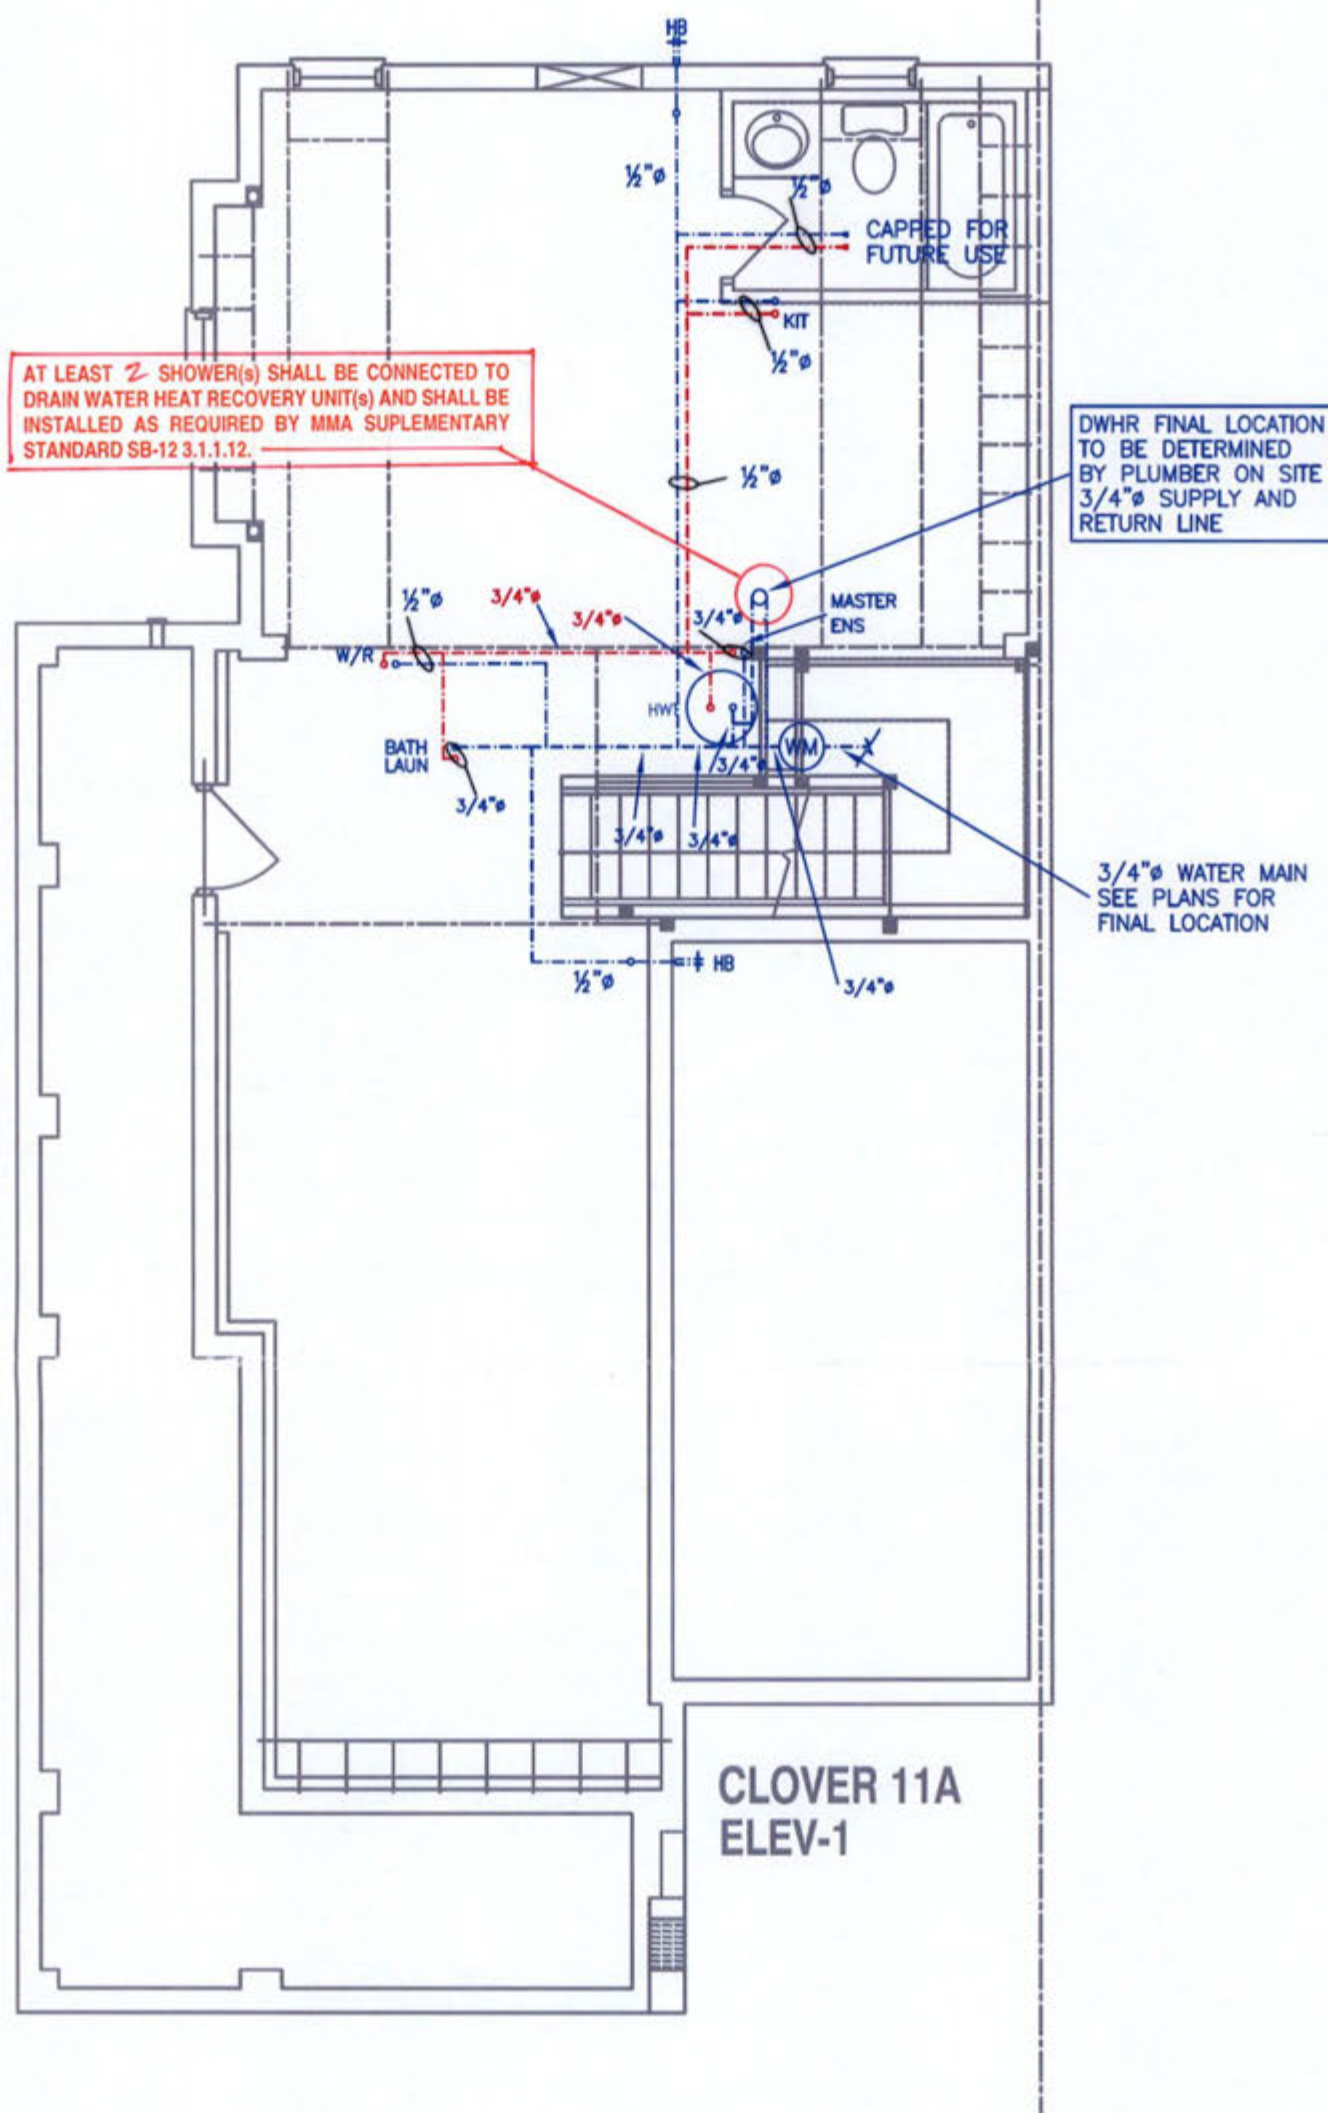

AT LEAST 2 SHOWER(S) SHALL BE CONNECTED TO DRAIN WATER HEAT RECOVERY UNIT(S) AND SHALL BE INSTALLED AS REQUIRED BY MMA SUPPLEMENTARY STANDARD SB-12 3.1.1.12.

DWHR FINAL LOCATION TO BE DETERMINED BY PLUMBER ON SITE 3/4" SUPPLY AND RETURN LINE

3/4" WATER MAIN SEE PLANS FOR FINAL LOCATION

THE ATTACHED KEY FORM PART OF THE DRAWINGS

ALL PLUMBING SHALL CONFORM TO THE ONTARIO BUILDING CODE, O.B.C. 332/12, AS AMENDED, DIVISION B, PART 7.

NOTES

1. DRAWINGS ARE TO BE PRINTED IN COLOUR
2. WHERE A 3/4" TUB SPOUT/ SPIGOT CONNECTION IS USED ON THE BATHTUB FAUCET THE WATER SUPPLY PIPE SHALL BE 3/4" TO THE BRANCH FOR THE BATHTUB
3. BASEMENT BATHROOM ROUGH-IN SHALL BE USED IN SIZING OF WATER PIPE
4. EXACT LOCATION OF ALL PLUMBING PIPING TO BE DETERMINED ON SITE


LEGEND

SYMBOL	DESCRIPTION (SEE PLAN FOR PIPE SIZING)
WM	WATER METER, PROVIDE SUPPLY PIPE SIZE/ $\phi$
HB	HOSE BIB
—	PROPOSED COLD WATER LINE & RISER
—	PROPOSED HOT WATER LINE & RISER
FD	FLOOR DRAIN



Client <b>GREENAPRK HOMES</b>	<b>HVACDESIGNS LTD.</b> 375 Finley Ave. Suite 202 - Ajax, Ontario L1S 2E2 Tel. 905.619.2300 - 905.420.5300 Fax 905.619.2375 Email: info@hvacdesigns.ca Web: www.hvacdesigns.ca Specializing in Residential Mechanical Design Services	<b>CITY OF BRAMPTON</b> BUILDING DIVISION REVIEWED  NOV 30 2018  PLUMBING BY KOFI MORIEL	Sheet Title <b>BASEMENT PLUMBING LAYOUT</b>
Project Name <b>MINNISALE HOMES CORP BRAMPTON, ONTARIO</b>			Date AUGUST 2018
CLOVER 11A 1880 sqft			Scale 3/16" = 1'-0"
			LO# 79568




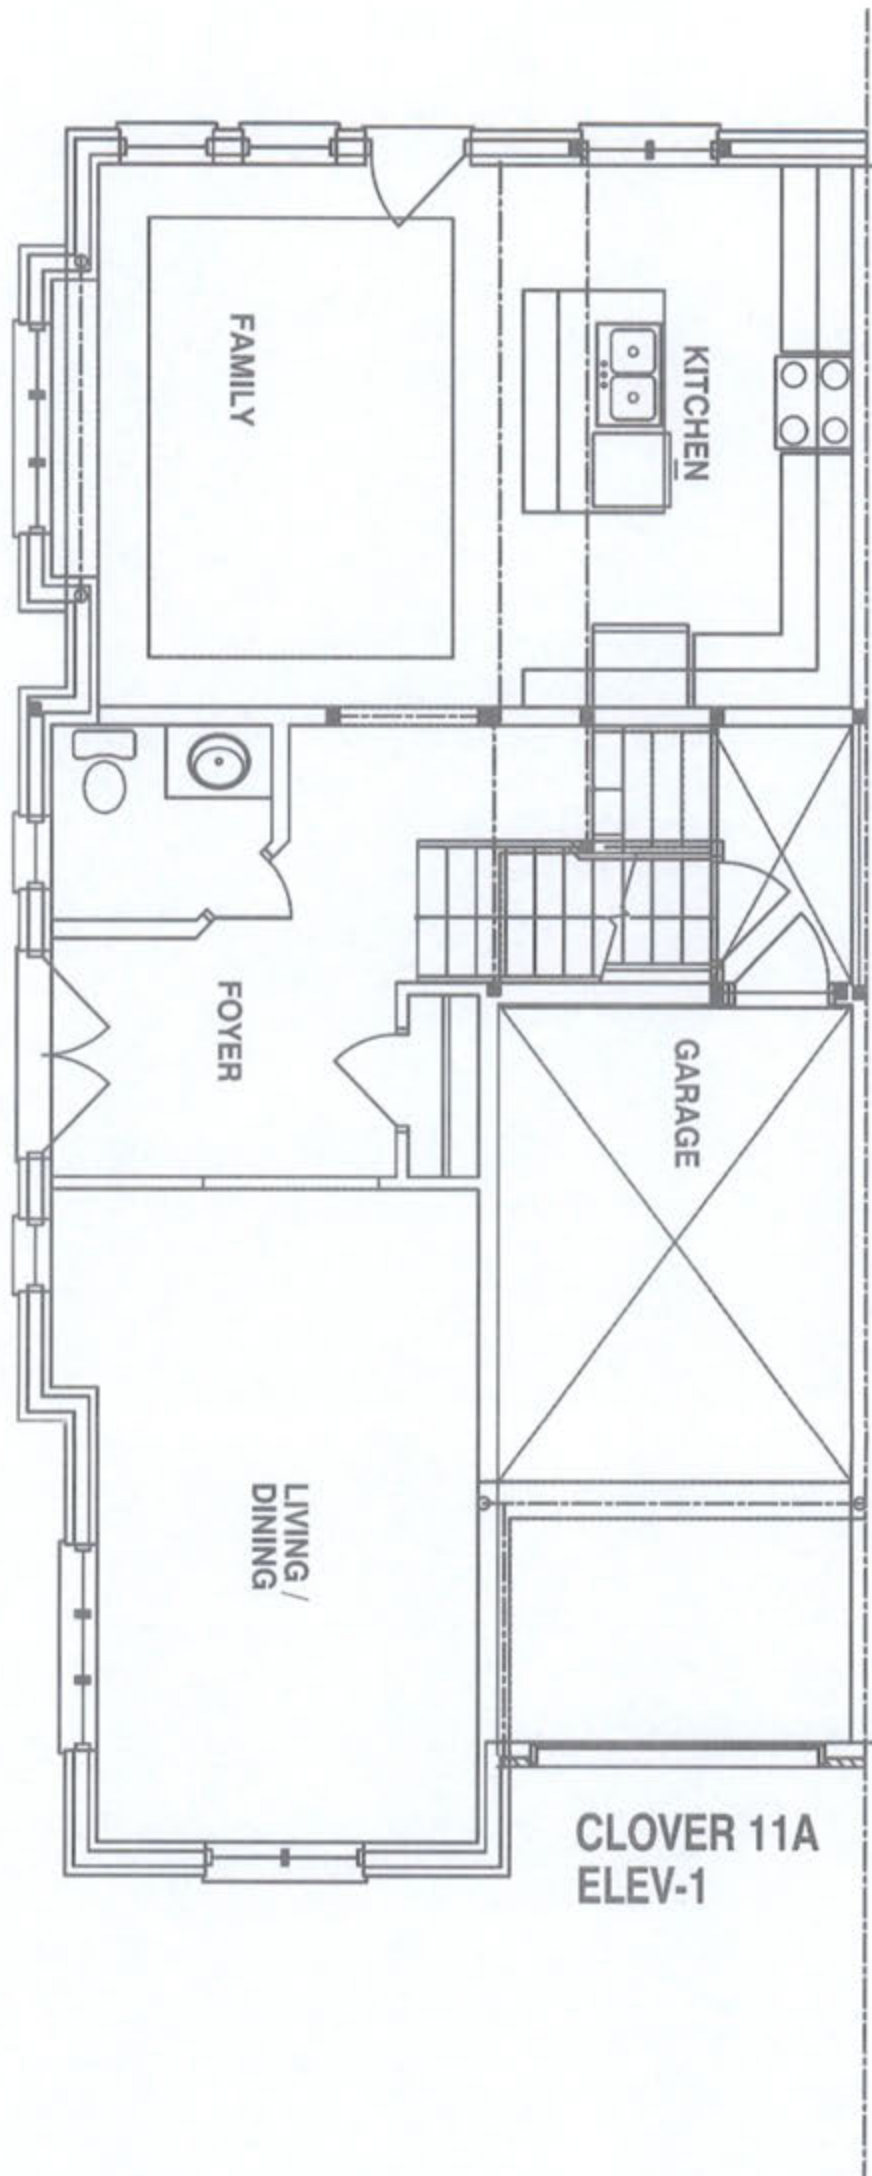

CITY OF BRAMPTON  
BUILDING DIVISION  
REVIEWED  
  
NOV 30 2018  
  
PLUMBING BY  
KOFI MORIEL



Client	GREENAPRK HOMES	<div><p>375 Finley Ave. Suite 202 - Ajax, Ontario L1S 2E2 Tel. 905.619.2300 - 905.420.5300 Fax 905.619.2375 Email: info@hvacdesigns.ca Web: www.hvacdesigns.ca Specializing in Residential Mechanical Design Services</p></div>	Sheet Title	
Project Name	MINNISALE HOMES CORP BRAMPTON, ONTARIO		FIRST FLOOR PLUMBING LAYOUT	
			Date	AUGUST 2018
			Scale	3/16" = 1'-0"
	CLOVER 11A      1880   sqft		LO#	79568

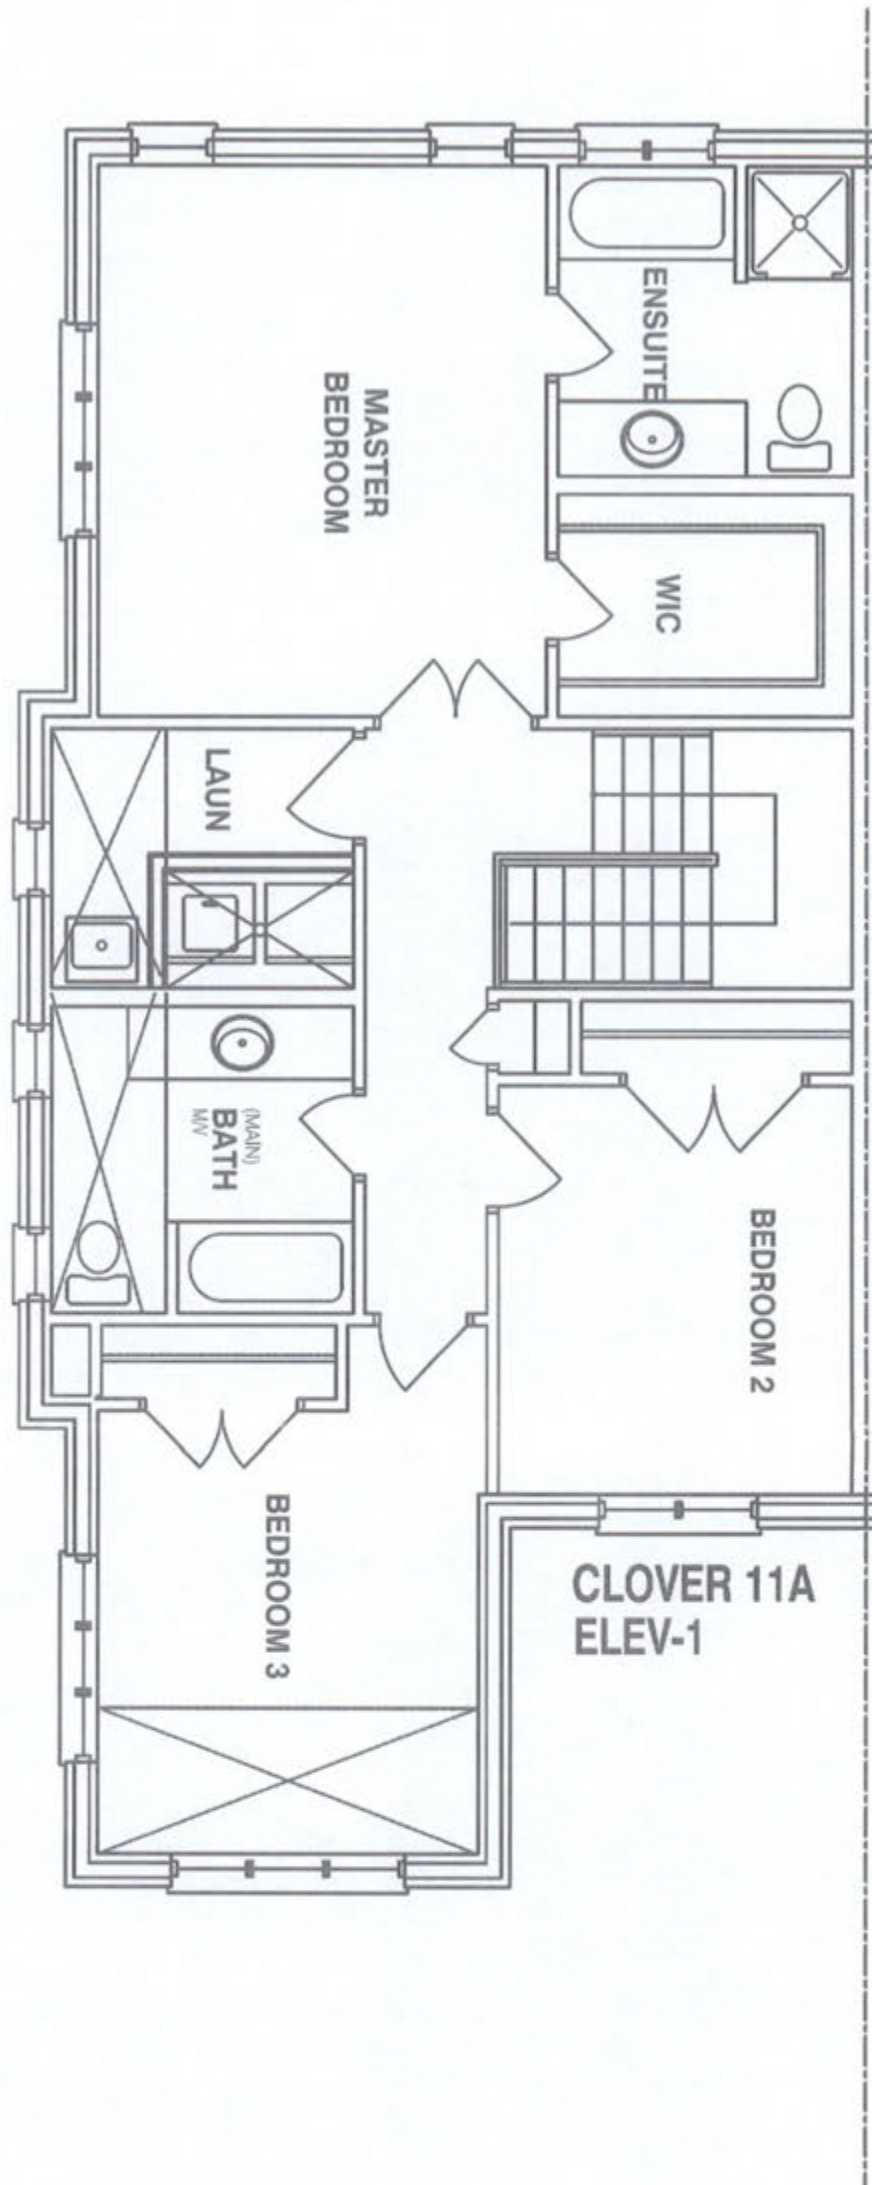

CITY OF BRAMPTON  
BUILDING DIVISION  
REVIEWED  
NOV 30 2018  
PLUMBING BY  
KOFI MORIEL



<p>Client GREENAPRK HOMES</p>	<p><b>HVACDESIGNS</b> <small>Inc.</small> 375 Finley Ave. Suite 202 - Ajax, Ontario L1S 2E2 Tel. 905.619.2300 - 905.420.5300 Fax 905.619.2375 Email: info@hvacdesigns.ca Web: www.hvacdesigns.ca Specializing in Residential Mechanical Design Services</p>		<p>Sheet Title SECOND FLOOR PLUMBING LAYOUT</p>
<p>Project Name MINNISALE HOMES CORP BRAMPTON, ONTARIO</p>			<p>Date AUGUST 2018</p> <p>Scale 3/16" = 1'-0"</p>
<p>CLOVER 11A      1880 sqft</p>			<p>LO#      79568</p>