



**BRAMPTON**  
Flower City

Planning and Development Services  
Building Division  
8850 McLaughlin Road, Unit 1  
Brampton, ON L6Y 5T1

# WATER PIPE SIZING AND PLUMBING DATA SHEET

## CERTIFIED MODEL WITH ONE DWELLING UNIT

THIS TABLE IS APPLICABLE FOR A HOUSE AFTER DECEMBER 31, 2017

Builder Name: GREENPARK HOMES  
Certified Model Name: MILLWOOD 2 - Lot 32  
Optional Floor Layout:  
Application No.:



*SWhite*

The Ontario Building Code Div. B, 7.6.3 regulates size and capacity of pipes for a new house. Please enter the number of individual fixtures as listed and bathroom groups<sup>(6)</sup> or powder room groups<sup>(7)</sup> per floor. The fixture units and required minimum size of water service will automatically be calculated.

Description	Basement Floor	First Floor	Second Floor	Third Floor
	Qty.	Qty.	Qty.	Qty.
Bathroom group <sup>(6)</sup>	1		3	
Bidet				
Extra Shower			1	
Lav			2	
Bar Sink				
Powder room <sup>(7)</sup>		1		
Kitchen Sink		1		
Dishwasher		1		
Laundry Tub			1	
Washing Machine			1	
Hose Bib		2		

Total Fixture Units 30.7

Minimum Diametre of Water Service Pipe  
Required from the Property Line to the  
House (Inch)


1

### Notes:

- (1) A potable water system shall be designed, constructed and installed to conform to good engineering practice appropriate to the circumstances, such as that described in the ASHRAE Handbooks and ASPE Data Books.
- (2) No water system between the point of connection with the water service pipe or the water meter and the first branch that supplies a water heater that serves more than one fixture shall be less than ¾ in. in size.
- (3) The minimum water pressure at the entry to the building is 200 kPa, and the total maximum length of the water system is 90 m.
- (4) In a hot water distribution system of a developed length of more than 30 m from the HWT to the farthest fixture or supplying more than 4 storeys, the water temperature shall be maintained by, (a) recirculation, or (b) a self-regulating heat tracing system.
- (5) Where piping may be exposed to freezing conditions, it shall be protected from the effects of freezing.
- (6) A bathroom group consists of 1 water closet, 1 lavatory, and 1 bathtub (with or without showerhead)
- (7) A powder room group consists of 1 water closet and 1 lavatory.

PLEASE SEE  
NOTES AS THE  
OF THE REVIEW



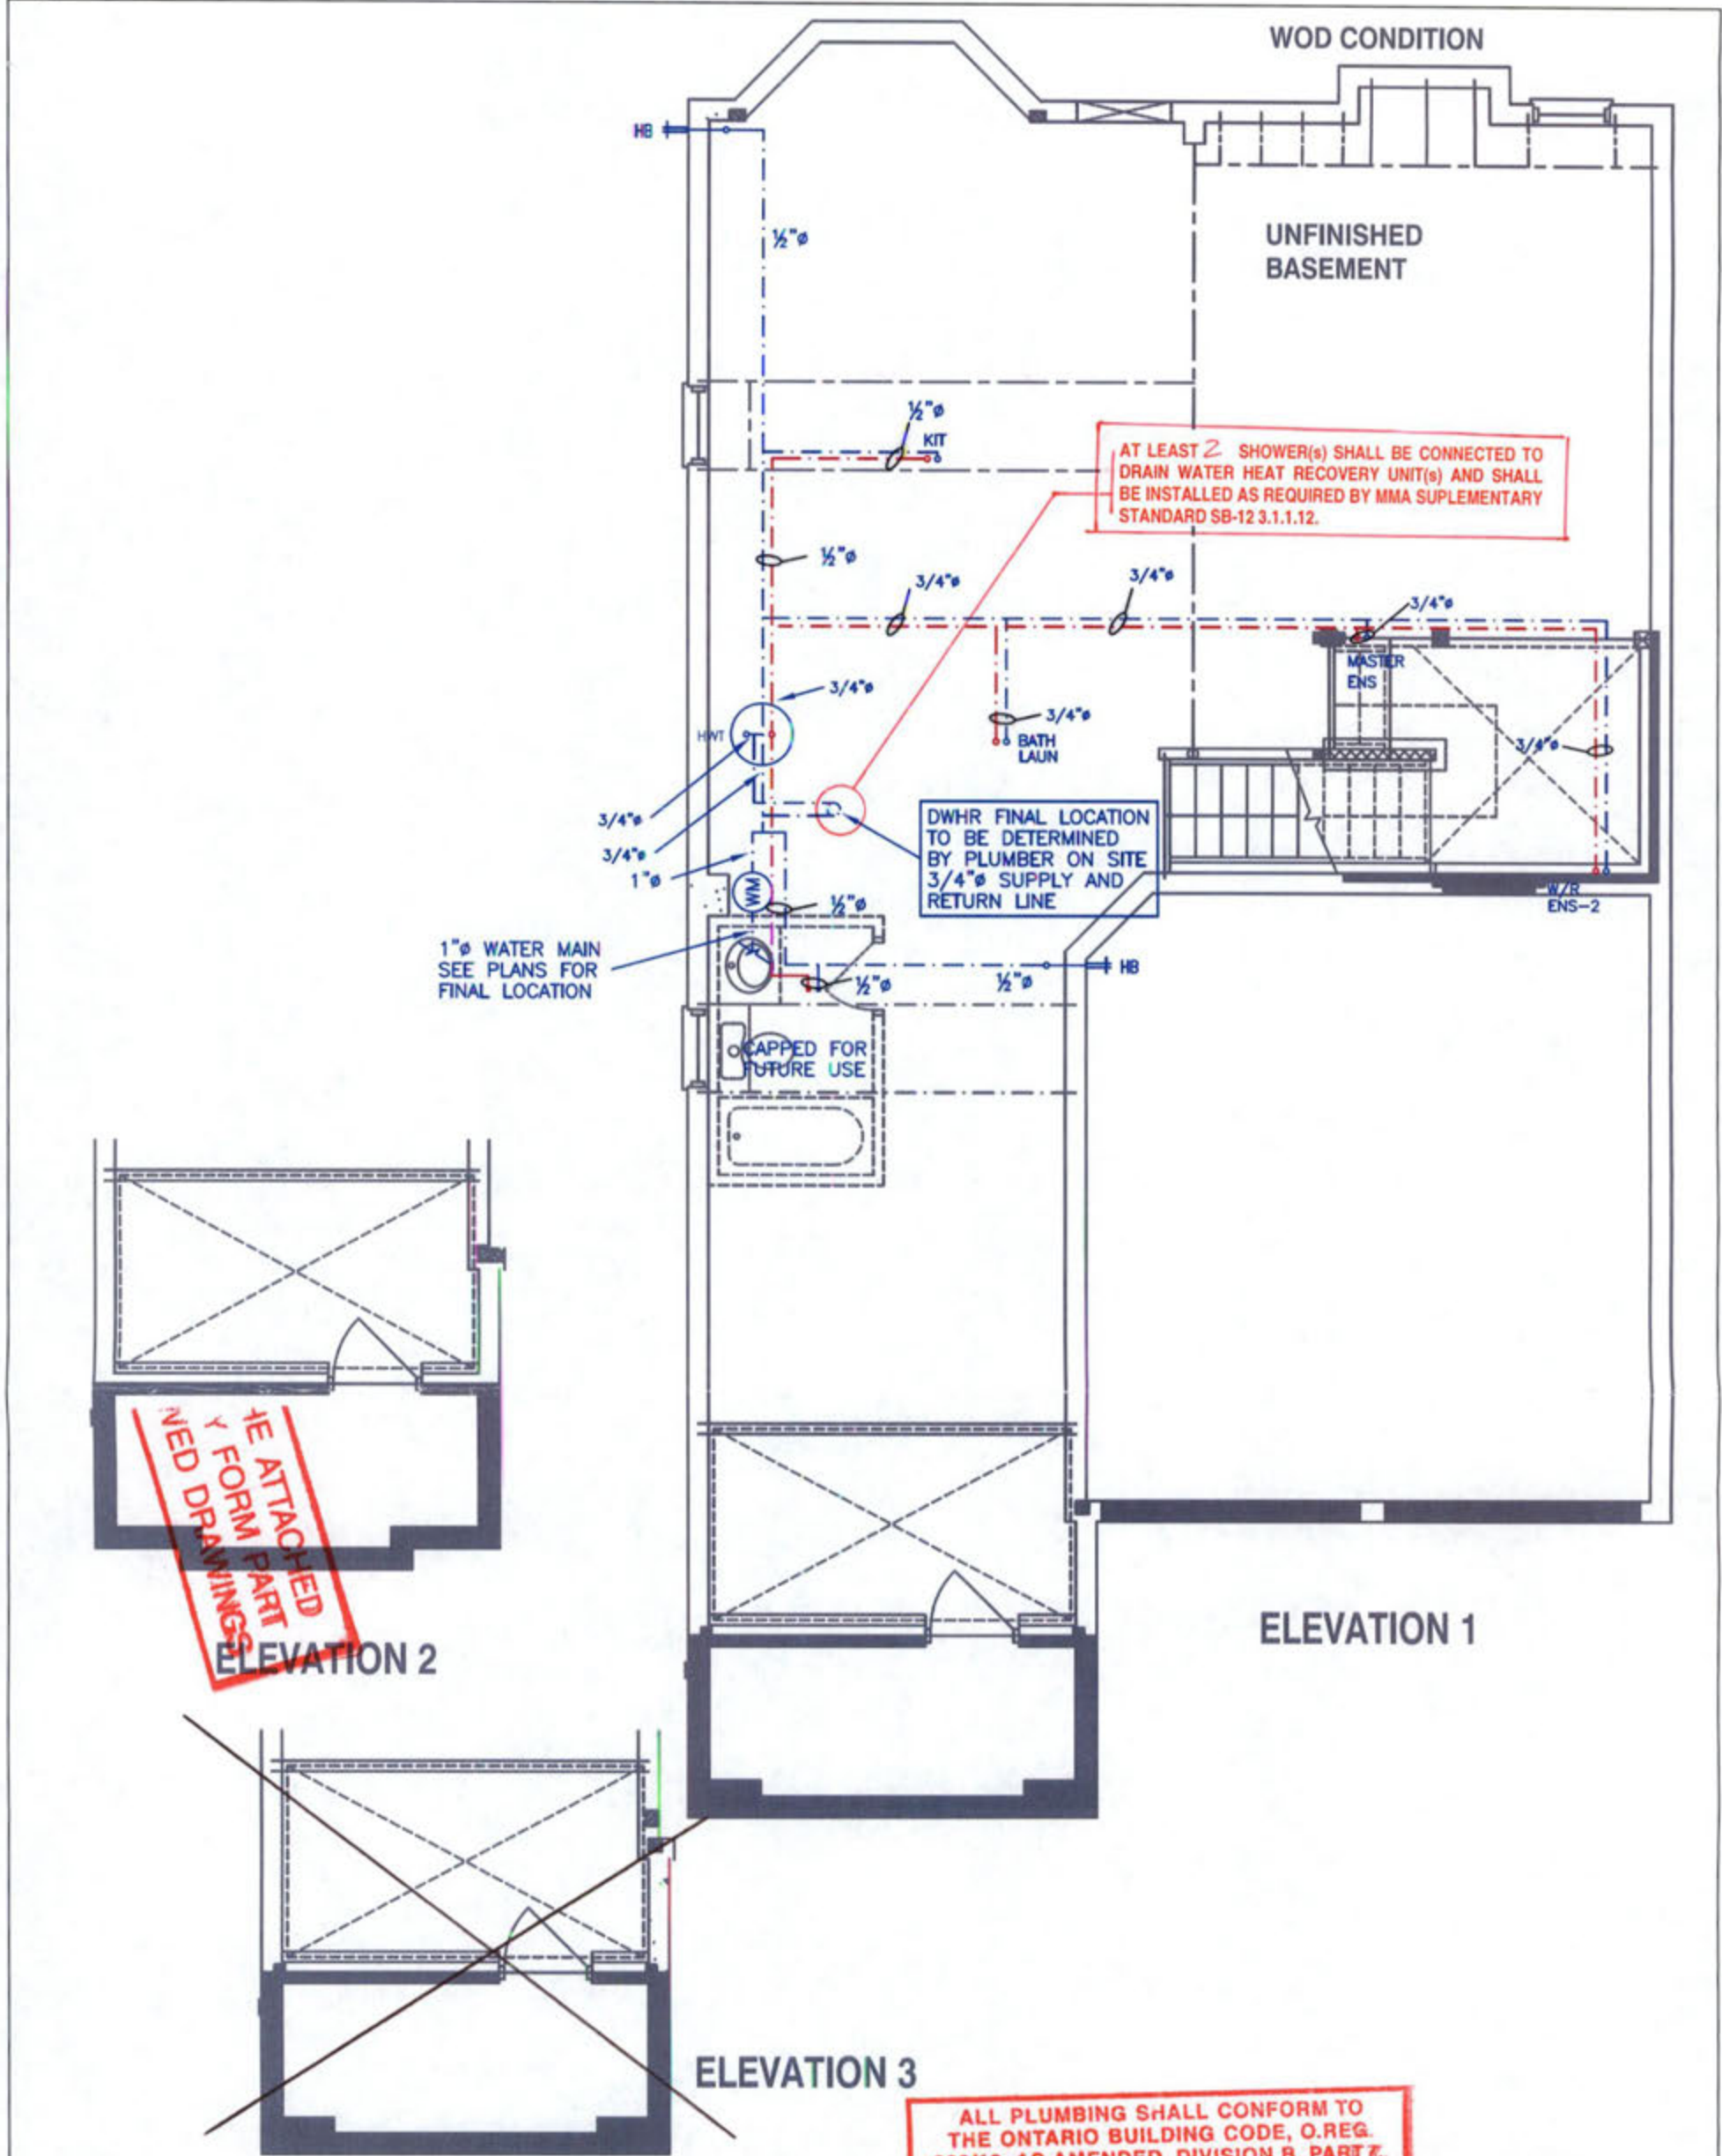

NOTES

1. DRAWINGS ARE TO BE PRINTED IN COLOUR
2. WHERE A 3/4" TUB SPOUT/ SPIGOT CONNECTION IS USED ON THE BATHTUB FAUCET THE WATER SUPPLY PIPE SHALL BE 3/4" TO THE BRANCH FOR THE BATHTUB
3. BASEMENT BATHROOM ROUGH-IN SHALL BE USED IN SIZING OF WATER PIPE
4. EXACT LOCATION OF ALL PLUMBING PIPING TO BE DETERMINED ON SITE


LEGEND

SYMBOL	DESCRIPTION (SEE PLAN FOR PIPE SIZING)
WM	WATER METER, PROVIDE SUPPLY PIPE SIZE/ Ø
HB	HOSE BIB
—	PROPOSED COLD WATER LINE & RISER
—	PROPOSED HOT WATER LINE & RISER
FD	FLOOR DRAIN




Client GREENAPRK HOMES	<b>HVACDESIGNS</b> 375 Finley Ave. Suite 202 - Ajax, Ontario L1S 2E2 Tel. 905.619.2300 - 905.420.5300 Fax 905.619.2375 Email: info@hvacdesigns.ca Web: www.hvacdesigns.ca Specializing in Residential Mechanical Design Services	CITY OF BRAMPTON BUILDING DIVISION REVIEWED NOV 20 2018 PLUMBING BY KOFI MORIEL	Sheet Title BASEMENT PLUMBING LAYOUT
Project Name LOT 32 MINNISALE HOMES CORP BRAMPTON, ONTARIO			Date AUGUST 2018
MILLWOOD 2 2654 sqft			Scale 3/16" = 1'-0"
			LO# 79581




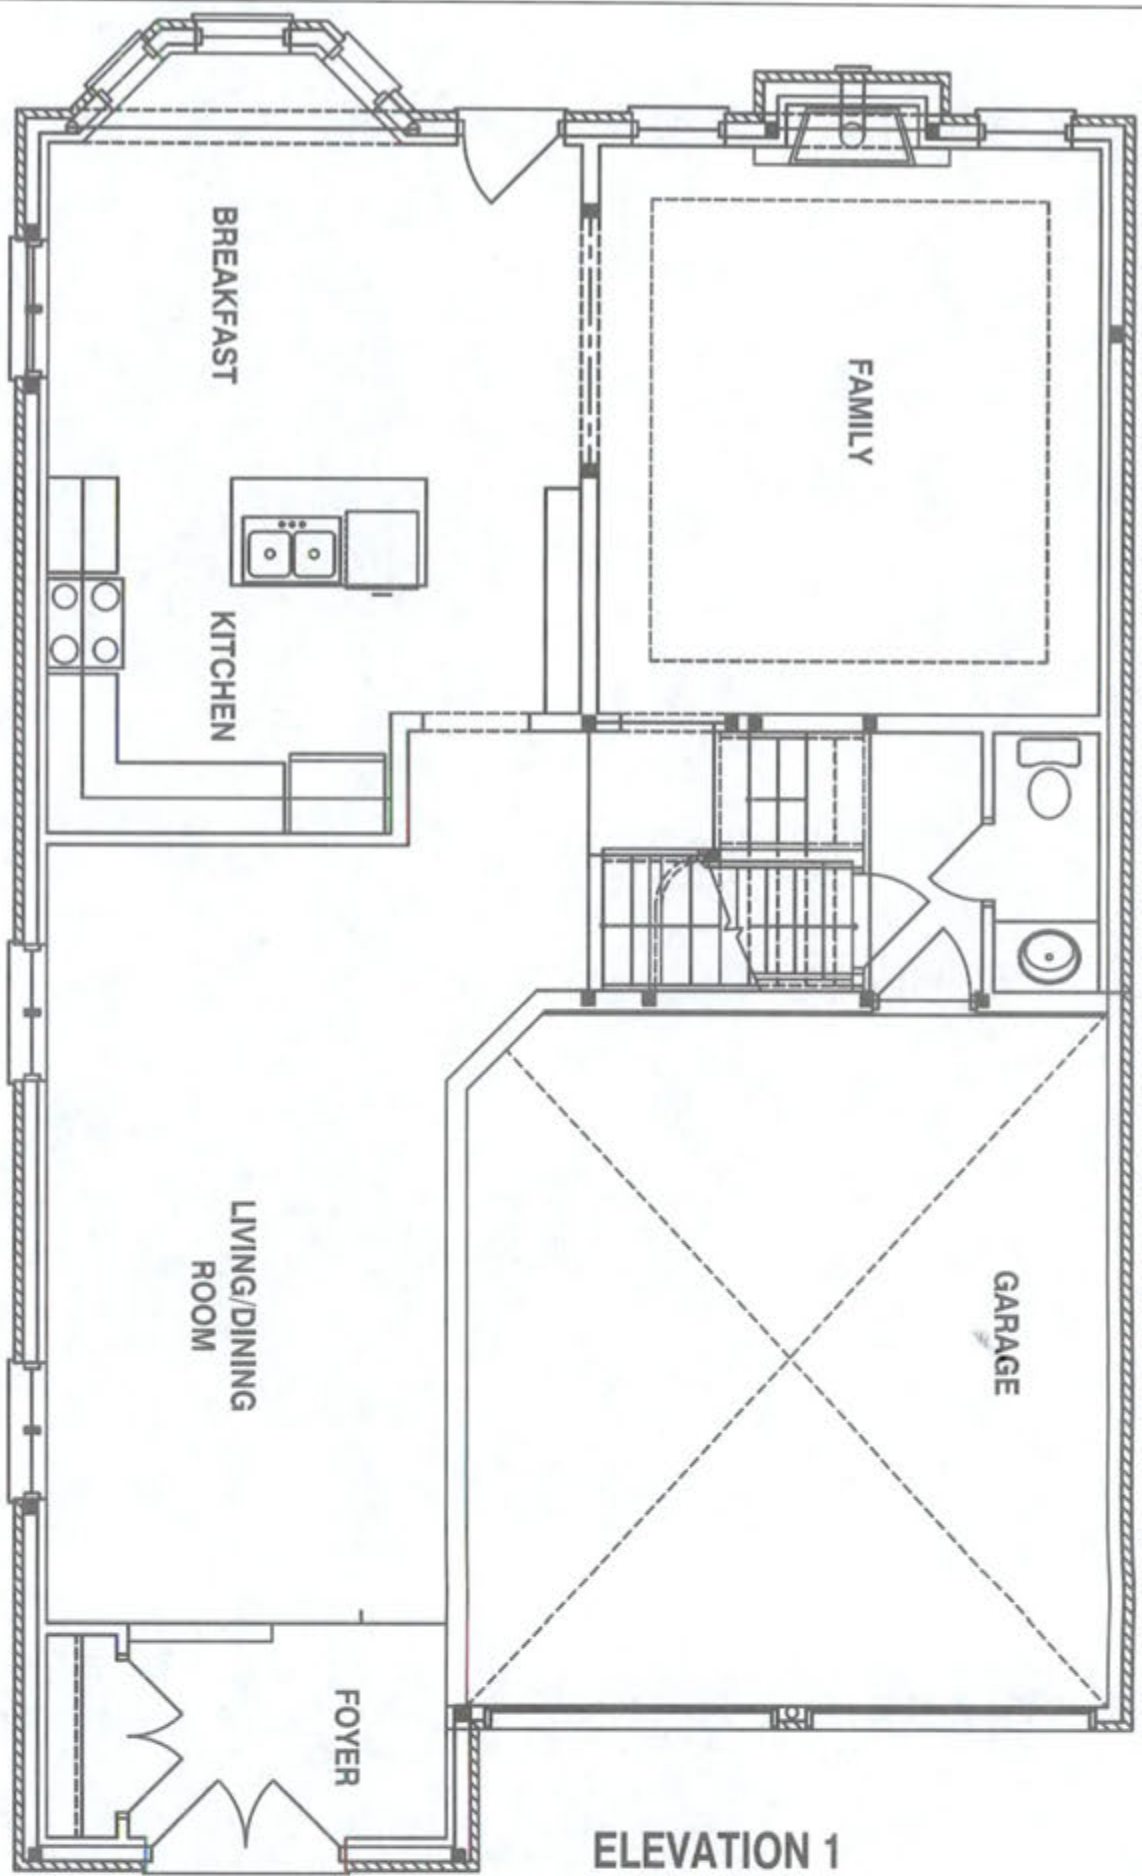

ELEVATION 1

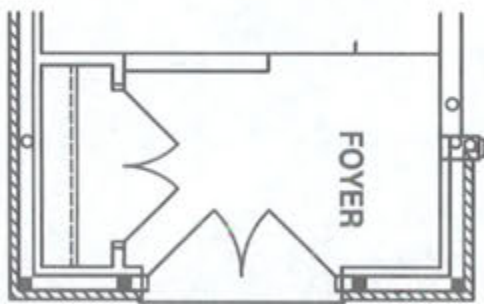

ELEVATION 2

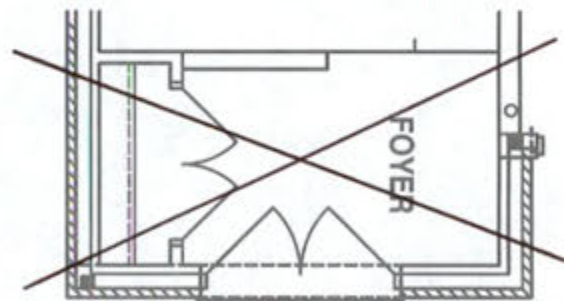


ELEVATION 3

CITY OF BRAMPTON  
BUILDING DIVISION  
REVIEWED  
NOV 20 2018  
PLUMBING BY  
KOFI MORIEL



<div>Client</div> <div>GREENAPRK HOMES</div> <div>Project Name</div> <div>LOT 32</div> <div>MINNISALE HOMES CORP</div> <div>BRAMPTON, ONTARIO</div> <div>MILLWOOD 2</div> <div>2654 sqft</div>	<div><b>HVACDESIGNS</b> LTD.</div> <div>375 Finley Ave. Suite 202 - Ajax, Ontario</div> <div>L1S 2E2 Tel. 905.619.2300 - 905.420.5300 Fax 905.619.2375</div> <div>Email: info@hvacdesigns.ca</div> <div>Web: www.hvacdesigns.ca</div> <div>Specializing in Residential Mechanical Design Services</div>	<div>Sheet Title</div> <div>FIRST FLOOR</div> <div>PLUMBING</div> <div>LAYOUT</div> <div>Date</div> <div>AUGUST 2018</div> <div>Scale</div> <div>3/16" = 1'-0"</div> <div>LO#</div> <div>79581</div>
--	---	--



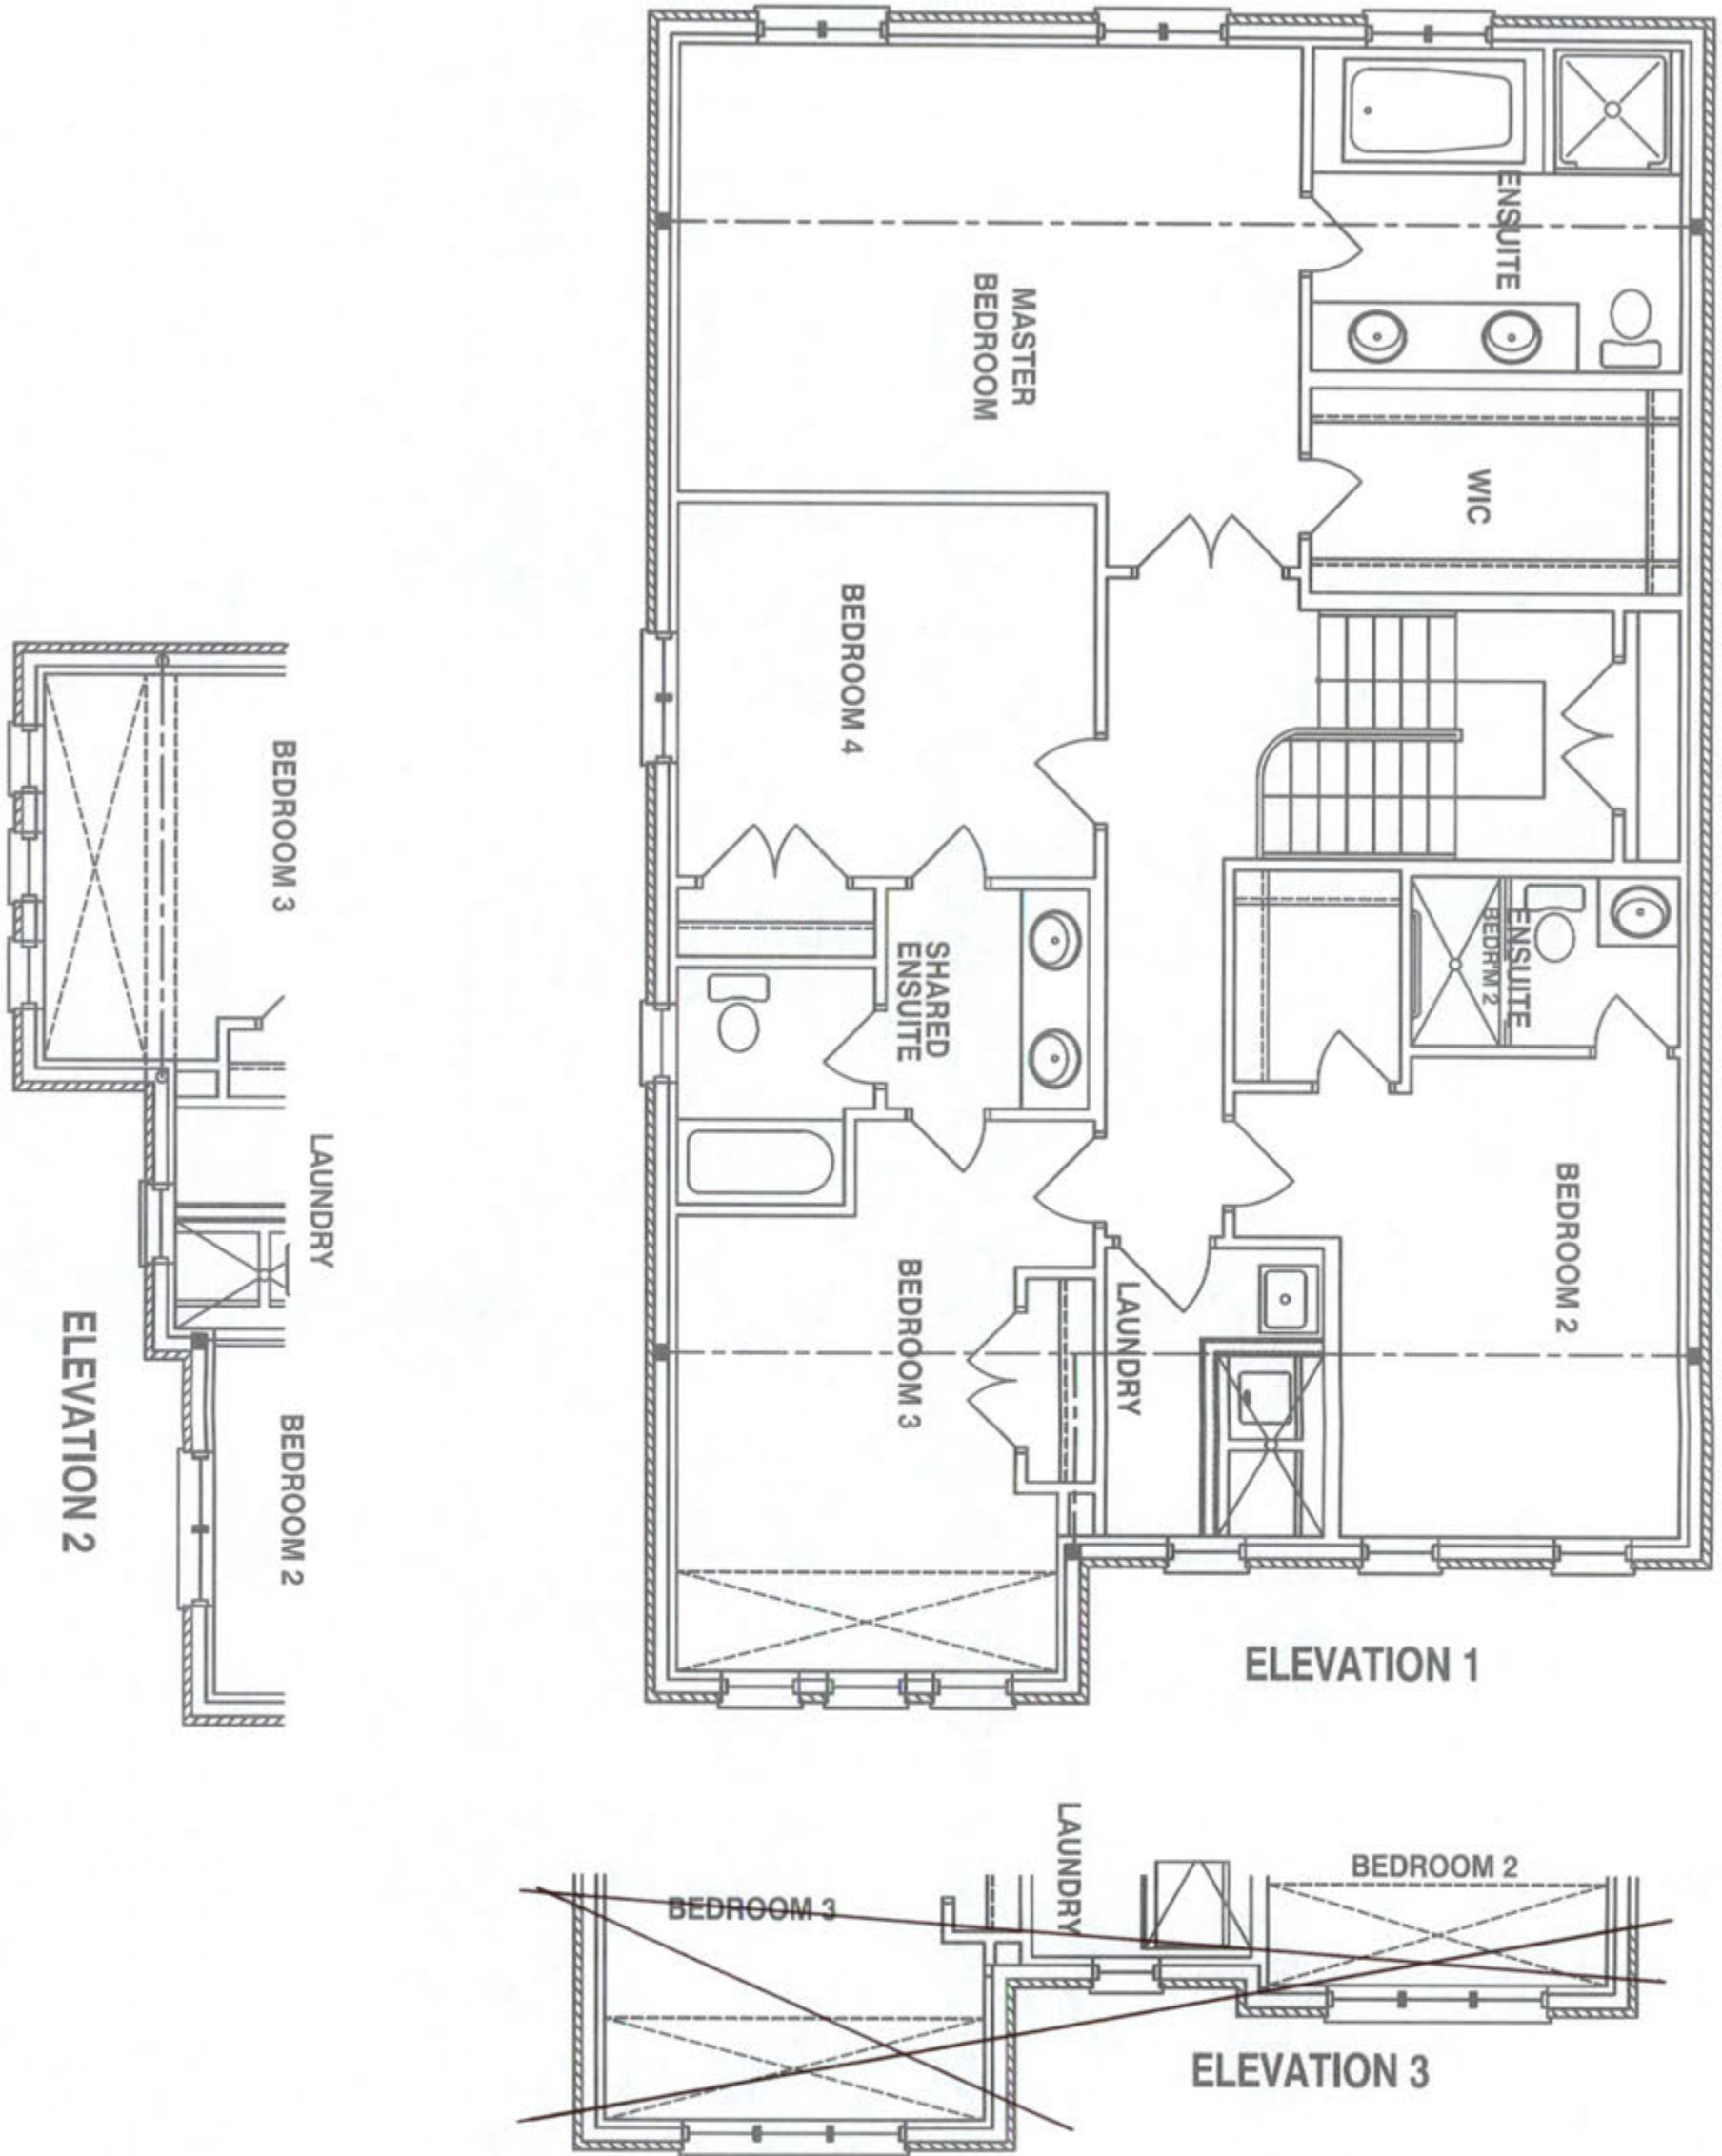

CITY OF BRAMPTON  
BUILDING DIVISION  
REVIEWED  
NOV 20 2018  
PLUMBING BY  
KOFI MORIEL



Client	GREENAPRK HOMES	 375 Finley Ave. Suite 202 - Ajax, Ontario L1S 2E2 Tel. 905.619.2300 - 905.420.5300 Fax 905.619.2375 Email: info@hvacdesigns.ca Web: www.hvacdesigns.ca Specializing in Residential Mechanical Design Services	Sheet Title SECOND FLOOR PLUMBING LAYOUT	
Project Name	LOT 32 MINNISALE HOMES CORP BRAMPTON, ONTARIO		Date	AUGUST 2018
MILLWOOD 2	2654 sqft		Scale	3/16" = 1'-0"
			LO#	79581