

SITE NAME: MINNISALE HOMES CORP
BUILDER: GREENPARK HOMES

OPT 4 BED **LOT 4**
TYPE: MILLWOOD 1 GFA: 2194

DATE: Aug-18
LO# 79582

WINTER NATURAL AIR CHANGE RATE 0.354
SUMMER NATURAL AIR CHANGE RATE 0.115

HEAT LOSS AT °F. 74
HEAT GAIN AT °F. 11

CSA-F280-12
SB-12 PACKAGE A1

ROOM USE	EXP. WALL	CLG. HT.	MBR	ENS	WIC	BED-2	BED-3	BED-4	BATH								
EXP. WALL	29		29	7	10	38	26	26	6								
CLG. HT.	10		10	9	9	9	9	10	9								
FACTORS																	
GRS.WALL AREA	LOSS	GAIN	290	63	90	342	234	260	54								
GLAZING	LOSS	GAIN															
NORTH	20.8	15.5	0	0	0	0	0	0	0								
EAST	20.8	41.0	32	665	1314	0	0	0	0								
SOUTH	20.8	24.4	0	0	0	0	0	0	0								
WEST	20.8	41.0	0	0	0	0	0	0	0								
SKYLT.	36.4	100.7	0	0	0	0	0	0	0								
DOORS	24.7	3.7	0	0	0	0	0	0	0								
NET EXPOSED WALL	4.4	0.6	258	1124	167	63	274	41	80								
NET EXPOSED BMT WALL ABOVE GR	3.5	0.5	0	0	0	0	0	0	0								
EXPOSED CLG	1.3	0.6	208	251	116	133	167	74	35								
NO ATTIC EXPOSED CLG	2.7	1.2	0	0	0	0	0	0	0								
EXPOSED FLOOR	2.5	0.4	0	0	0	0	0	0	0								
BASEMENT/CRAWL HEAT LOSS			0	0	0	0	0	0	0								
SLAB ON GRADE HEAT LOSS			0	0	0	0	0	0	0								
SUBTOTAL HT LOSS			2050	441	687	2194	2237	2119	333								
SUB TOTAL HT GAIN			1596	116	495	1063	1537	2129	78								
LEVEL FACTOR / MULTIPLIER	0.20	0.27		0.20	0.27	0.20	0.27	0.20	0.27								
AIR CHANGE HEAT LOSS			552	119	185	591	603	571	90								
AIR CHANGE HEAT GAIN			105	8	33	70	101	141	5								
DUCT LOSS			0	0	87	0	284	0	0								
DUCT GAIN			0	0	53	0	270	0	0								
HEAT GAIN PEOPLE	240		2	480	0	0	1	240	1								
HEAT GAIN APPLIANCES/LIGHTS				819	0	0	819	819	0								
TOTAL HT LOSS BTU/H			2602	560	940	2785	3124	2690	423								
TOTAL HT GAIN x 1.3 BTU/H			3901	159	754	2851	3858	4328	109								

CITY OF BRAMPTON
BUILDING DIVISION
REVIEWED BY: S. DESAI
NOV 23 2018
ATTACHED NOTES ARE PART
OF REVIEWED DRAWINGS
ALL WORK MUST COMPLY WITH OBC

ROOM USE	EXP. WALL	CLG. HT.	LV/DN	KT/PM	LAUN	WIR	FOY	WOC	BAS								
EXP. WALL	37		37	66	0	29	20	36	152								
CLG. HT.	10		10	10	9	11	11	9	9								
FACTORS																	
GRS.WALL AREA	LOSS	GAIN	370	680	0	319	220	324	1128								
GLAZING	LOSS	GAIN															
NORTH	20.8	15.5	0	0	0	0	0	0	0								
EAST	20.8	41.0	0	0	0	0	0	0	0								
SOUTH	20.8	24.4	0	0	0	0	0	0	0								
WEST	20.8	41.0	27	561	1108	0	0	0	0								
SKYLT.	36.4	100.7	0	0	0	0	0	0	0								
DOORS	24.7	3.7	0	0	0	0	0	0	0								
NET EXPOSED WALL	4.4	0.6	343	1494	222	600	2914	388	0								
NET EXPOSED BMT WALL ABOVE GR	3.5	0.5	0	0	0	0	0	0	0								
EXPOSED CLG	1.3	0.6	0	0	0	0	0	0	0								
NO ATTIC EXPOSED CLG	2.7	1.2	0	0	0	0	0	0	0								
EXPOSED FLOOR	2.5	0.4	0	0	0	0	0	0	0								
BASEMENT/CRAWL HEAT LOSS			0	0	0	0	0	0	0								
SLAB ON GRADE HEAT LOSS			0	0	0	0	0	0	0								
SUBTOTAL HT LOSS			2055	4303	297	1927	2003	880	6509								
SUB TOTAL HT GAIN			1330	3683	75	456	565	396	244								
LEVEL FACTOR / MULTIPLIER	0.30	0.41		0.30	0.41	0.20	0.27	0.30	0.41								
AIR CHANGE HEAT LOSS			836	1761	80	784	815	0	6976								
AIR CHANGE HEAT GAIN			88	243	5	30	37	0	42								
DUCT LOSS			0	0	38	0	0	0	0								
DUCT GAIN			0	0	90	0	0	0	0								
HEAT GAIN PEOPLE	240		0	0	0	0	0	0	0								
HEAT GAIN APPLIANCES/LIGHTS				819	0	0	0	0	0								
TOTAL HT LOSS BTU/H			2892	6064	415	2711	2818	880	13545								
TOTAL HT GAIN x 1.3 BTU/H			2908	6169	1266	632	782	515	373								

TOTAL HEAT GAIN BTU/H: 28861

TONS: 2.41

LOSS DUE TO VENTILATION LOAD BTU/H: 1593

STRUCTURAL HEAT LOSS: 42456

TOTAL COMBINED HEAT LOSS BTU/H: 44049

SITE NAME: MINNISSALE HOMES CORP
 BUILDER: GREENPARK HOMES

 OPT 4 BED
 TYPE: MILLWOOD 1

DATE: Aug-18

GFA: 2194 LO# 79582

 HEATING CFM 1131 COOLING CFM 1131
 TOTAL HEAT LOSS 42,456 TOTAL HEAT GAIN 28,625
 AIR FLOW RATE CFM 26.64 AIR FLOW RATE CFM 39.51

 furnace pressure 0.6
 furnace filter 0.05
 a/c coil pressure 0.2
 available pressure for s/a & r/a 0.35

 #GOODMAN
 GMEC960803BNA 60
 FAN SPEED LOW
 MEDLOW
 MEDIUM
 MEDIUM HIGH
 HIGH 1131

 AFUE = 96 %
 INPUT (BTU/H) = 60,000
 OUTPUT (BTU/H) = 57,600

 DESIGN CFM = 1131
 CFM @ 8" E.S.P.

TEMPERATURE RISE 47 °F

RUN COUNT	4th	3rd	2nd	1st	Bas
S/A	0	0	11	7	4
R/A	0	0	4	2	1

All S/A diffusers 4"x10" unless noted otherwise on layout.

All S/A runs 5"Ø unless noted otherwise on layout.

RUN #	1	2	3	4	5	6	7	9	10	11	12	13	14	15	16	17	18	19	21	22	23	24
ROOM NAME	MBR	MBR	ENS	BED-3	BED-4	BED-3	WIC	BED-4	BED-2	LAUN	LV/DN	LV/DN	KT/FM	KT/FM	KT/FM	BATH	W/R	FOY	BAS	BAS	BAS	BAS
RM LOSS MBH	1.30	1.30	0.56	1.56	1.34	1.56	0.96	1.34	2.78	0.41	1.45	1.45	2.02	2.02	2.02	0.42	2.71	2.82	3.61	3.61	3.61	3.61
CFM PER RUN HEAT	35	35	15	42	36	42	26	36	74	11	39	39	54	54	54	11	72	75	96	96	96	96
RM GAIN MBH	1.95	1.95	0.16	1.93	2.16	1.93	0.75	2.16	2.85	1.29	1.45	1.45	2.06	2.06	2.06	0.11	0.63	0.78	0.22	0.22	0.22	0.22
CFM PER RUN COOLING	77	77	6	76	85	76	30	85	113	51	57	57	81	81	81	4	25	31	9	9	9	9
ADJUSTED PRESSURE	0.17	0.17	0.17	0.17	0.16	0.17	0.17	0.16	0.15	0.17	0.17	0.17	0.16	0.16	0.16	0.17	0.17	0.17	0.16	0.16	0.16	0.16
ACTUAL DUCT LGH	36	35	34	29	42	37	31	38	51	21	20	23	19	28	31	31	31	25	30	26	10	17
EQUIVALENT LENGTH	150	150	190	130	170	140	150	140	130	160	150	160	130	120	140	190	130	120	140	140	140	170
TOTAL EFFECTIVE LENGTH	186	185	224	159	212	177	181	178	181	181	170	183	149	148	171	221	161	145	170	166	150	187
ADJUSTED PRESSURE	0.09	0.09	0.08	0.11	0.08	0.1	0.1	0.09	0.08	0.1	0.1	0.09	0.11	0.11	0.09	0.08	0.11	0.12	0.1	0.1	0.11	0.09
ROUND DUCT SIZE	5	5	4	5	6	5	4	6	6	4	5	5	5	5	5	4	5	5	6	6	6	6
HEATING VELOCITY (ft/min)	257	257	172	308	184	308	298	184	377	126	286	286	396	396	396	126	529	551	489	489	489	489
COOLING VELOCITY (ft/min)	565	565	69	558	433	558	344	433	576	585	419	419	595	595	595	46	184	228	46	46	46	46
OUTLET GRILL SIZE	3X10	3X10	3X10	3X10	4X10	3X10	3X10	4X10	4X10	3X10	3X10	3X10	3X10	3X10	3X10	3X10	3X10	3X10	4X10	4X10	4X10	4X10
TRUNK	A	A	A	C	B	C	B	B	D	C	C	B	D	D	A	A	D	B	D	A	C	B

RUN #	
ROOM NAME	
RM LOSS MBH	
CFM PER RUN HEAT	
RM GAIN MBH	
CFM PER RUN COOLING	
ADJUSTED PRESSURE	
ACTUAL DUCT LGH	
EQUIVALENT LENGTH	
TOTAL EFFECTIVE LENGTH	
ADJUSTED PRESSURE	
ROUND DUCT SIZE	
HEATING VELOCITY (ft/min)	
COOLING VELOCITY (ft/min)	
OUTLET GRILL SIZE	
TRUNK	

 CITY OF BRAMPTON
 BUILDING DIVISION
 REVIEWED BY: S. DESAI

NOV 23 2018

 ATTACHED NOTES ARE PART
 OF REVIEWED DRAWINGS
 ALL WORK MUST COMPLY WITH OBC

SUPPLY AIR TRUNK SIZE

TRUNK	STATIC	ROUND	RECT	VELOCITY
CFM	PRESS.	DUCT	DUCT	(ft/min)
TRUNK A	246	0.08	8.3	8
TRUNK B	308	0.08	9	10
TRUNK C	538	0.08	11.1	14
TRUNK D	350	0.08	9.5	10
TRUNK E	784	0.08	12.8	20
TRUNK F	0	0.00	0	0

RETURN AIR TRUNK SIZE

TRUNK	STATIC	ROUND	RECT	VELOCITY
CFM	PRESS.	DUCT	DUCT	(ft/min)
TRUNK G	0	0.06	0	0
TRUNK H	0	0.06	0	0
TRUNK I	0	0.06	0	0
TRUNK J	0	0.06	0	0
TRUNK K	0	0.06	0	0
TRUNK L	0	0.06	0	0
TRUNK O	0	0.06	0	0
TRUNK P	0	0.06	0	0
TRUNK Q	0	0.06	0	0
TRUNK R	0	0.06	0	0
TRUNK S	0	0.06	0	0
TRUNK T	0	0.06	0	0
TRUNK U	0	0.06	0	0
TRUNK V	0	0.06	0	0
TRUNK W	0	0.06	0	0
TRUNK X	1131	0.06	15.8	30
TRUNK Y	795	0.06	13.8	22
TRUNK Z	0	0.06	0	0
DROP	1131	0.06	15.8	24

RETURN AIR

1	2	3	4	5	6	7	8	9	10	11	12	13	14	15	16	17	18	19	20	21	22	23	24
AIR VOLUME	145	95	130	85	310	175	0	0	0	0	0	0	0	0	0	0	0	0	191	✓			
PLENUM PRESSURE	0.15	0.15	0.15	0.15	0.15	0.15	0.15	0.15	0.15	0.15	0.15	0.15	0.15	0.15	0.15	0.15	0.15	0.15	0.15				
ACTUAL DUCT LGH	43	58	47	57	25	24	1	1	1	1	1	1	1	1	1	1	1	1	14				
EQUIVALENT LENGTH	175	160	190	185	190	185	0	0	0	0	0	0	0	0	0	0	0	0	135				
TOTAL EFFECTIVE LH	218	218	237	242	215	209	1	1	1	1	1	1	1	1	1	1	1	1	149				
ADJUSTED PRESSURE	0.07	0.07	0.06	0.06	0.07	0.07	14.80	14.80	14.80	14.80	14.80	14.80	14.80	14.80	14.80	14.80	14.80	14.80	0.10				
ROUND DUCT SIZE	7	6	7	6	9.4	7.5	0	0	0	0	0	0	0	0	0	0	0	0	7.1				
INLET GRILL SIZE	8	8	8	8	8	8	0	0	0	0	0	0	0	0	0	0	0	0	8				
INLET GRILL SIZE	X	X	X	X	X	X	X	X	X	X	X	X	X	X	X	X	X	X	X				
INLET GRILL SIZE	14	14	14	14	30	14	0	0	0	0	0	0	0	0	0	0	0	0	14				

TYPE: MILLWOOD 1
SITE NAME: MINNISSALE HOMES CORP

LO # 79562
OPT 4 BED

RESIDENTIAL MECHANICAL VENTILATION DESIGN SUMMARY

COMBUSTION APPLIANCES 9.32.3.1(1)	
a) ☐	Direct vent (sealed combustion) only
b) ☐	Positive venting induced draft (except fireplaces)
c) ☐	Natural draft, B-vent or induced draft gas fireplace
d) ☐	Solid Fuel (including fireplaces)
e) ☐	No Combustion Appliances

HEATING SYSTEM	
☒	Forced Air
☐	Non Forced Air
☐	Electric Space Heat

HOUSE TYPE 9.32.1(2)	
☐	I Type a) or b) appliance only, no solid fuel
☐	II Type I except with solid fuel (including fireplaces)
☐	III Any Type c) appliance
☐	IV Type I, or II with electric space heat
☐	Other: Type I, II or IV no forced air

SYSTEM DESIGN OPTIONS O.N.H.W.P.	
☐	1 Exhaust only/Forced Air System
☐	2 HRV with Ducting/Forced Air System
☐	3 HRV Simplified/connected to forced air system
☐	4 HRV with Ducting/non forced air system
☐	Part 6 Design

TOTAL VENTILATION CAPACITY 9.32.3.3(1)	
Basement + Master Bedroom	2 @ 21.2 cfm 42.4 cfm
Other Bedrooms	3 @ 10.6 cfm 31.8 cfm
Kitchen & Bathrooms	4 @ 10.6 cfm 42.4 cfm
Other Rooms	4 @ 10.6 cfm 42.4 cfm
Table 9.32.3.A	TOTAL 159.0 cfm

PRINCIPAL VENTILATION CAPACITY REQUIRED 9.32.3.4(1)	
1 Bedroom	31.8 cfm
2 Bedroom	47.7 cfm
3 Bedroom	63.6 cfm
4 Bedroom	79.5 cfm
5 Bedroom	95.4 cfm
TOTAL	79.5 cfm

SUPPLEMENTAL VENTILATION CAPACITY 9.32.3.5	
Total Ventilation Capacity	159 cfm
Less Principal Ventil. Capacity	79.5 cfm
Required Supplemental Capacity	79.5 cfm

PRINCIPAL EXHAUST FAN CAPACITY	
Model: VANEE 65H	Location: BSMT
79.5 cfm	3.0 sones
☒	HVI Approved

PRINCIPAL EXHAUST HEAT LOSS CALCULATION	
CFM	ΔT °F
79.5 CFM	74 F
X	X
FACTOR	% LOSS
1.08	0.25

SUPPLEMENTAL FANS PANASONIC	
Location	Model
ENS	FV-05-11VK1
BATH	FV-05-11VK1
W/R	FV-05-11VK1
cfm	HVI
50	✓
50	✓
50	✓
Sones	
0.3	
0.3	
0.3	

HEAT RECOVERY VENTILATOR 9.32.3.11	
Model: VANEE 65H	
155 cfm high	64 cfm low
75 % Sensible Efficiency @ 32 deg F (0 deg C)	☒ HVI Approved

LOCATION OF INSTALLATION	
Lot:	Concession
Township	Plan:
Address	
Roll #	Building Permit #

BUILDER: GREENPARK HOMES	
Name:	
Address:	
City:	
Telephone #:	

INSTALLING CONTRACTOR	
Name:	
Address:	
City:	
Telephone #:	

DESIGNER CERTIFICATION	
I hereby certify that this ventilation system has been designed in accordance with the Ontario Building Code.	
Name:	HVAC Designs Ltd.
Signature:	<i>Michael O'Rourke</i>
HRAI #	001620
Date:	August-18

I REVIEW AND TAKE RESPONSIBILITY FOR THE DESIGN WORK AND AM QUALIFIED IN THE APPROPRIATE CATEGORY AS AN "OTHER DESIGNER" UNDER DIVISION C, 3.2.5 OF THE BUILDING CODE.
INDIVIDUAL BCIN: 19669 MICHAEL O'ROURKE

CITY OF BRAMPTON
BUILDING DIVISION
REVIEWED BY: S. DESAI
NOV 23 2018
ATTACHED NOTES ARE PART
OF REVIEWED DRAWINGS
ALL WORK MUST COMPLY WITH OBC

CSA F280-12 Residential Heat Loss and Heat Gain Calculations
Formula Sheet (For Air Leakage / Ventilation Calculation)

LO#: 79582

Model: MILLWOOD 1

Builder: GREENPARK HOMES

Date: 8/8/2018

Volume Calculation
House Volume

Level	Floor Area (ft²)	Floor Height (ft)	Volume (ft³)
Bsmt	992	9	8928
First	992	10	9920
Second	1202	9	10818
Third	0	9	0
Fourth	0	9	0
Total:			29,666.0 ft³
Total:			840.0 m³

Air Change & Delta T Data

WINTER NATURAL AIR CHANGE RATE	0.354
SUMMER NATURAL AIR CHANGE RATE	0.115

Design Temperature Difference

	T _{in} °C	T _{out} °C	ΔT °C	ΔT °F
Winter DTD _h	22	-19	41	74
Summer DTD _c	24	30	6	11

5.2.3.1 Heat Loss due to Air Leakage

$$HL_{airb} = LR_{airh} \times \frac{V_b}{3.6} \times DTD_h \times 1.2$$

$$0.354 \times 233.35 \times 41^\circ\text{C} \times 1.2 = 4089 \text{ W}$$

$$= 13952 \text{ Btu/h}$$

6.2.6 Sensible Gain due to Air Leakage

$$HG_{salb} = LR_{airc} \times \frac{V_b}{3.6} \times DTD_c \times 1.2$$

$$0.115 \times 233.35 \times 6^\circ\text{C} \times 1.2 = 197 \text{ W}$$

$$= 672 \text{ Btu/h}$$

5.2.3.2 Heat Loss due to Mechanical Ventilation

$$HL_{valrb} = PVC \times DTD_h \times 1.08 \times (1 - E)$$

$$80 \text{ CFM} \times 74^\circ\text{F} \times 1.08 \times 0.25 = 1593 \text{ Btu/h}$$

6.2.7 Sensible heat Gain due to Ventilation

$$HL_{valrb} = PVC \times DTD_h \times 1.08 \times (1 - E)$$

$$80 \text{ CFM} \times 11^\circ\text{F} \times 1.08 \times 0.25 = 236 \text{ Btu/h}$$

5.2.3.3 Calculation of Air Change Heat Loss for Each Room (Floor Multiplier Section)

$$HL_{airr} = \text{Level Factor} \times HL_{airbv} \times ((HL_{agcr} + HL_{bgcr}) + (HL_{agcleve} + HL_{bgcleve}))$$

Level	Level Factor (LF)	HL _{airbv} Air Leakage + Ventilation Heat Loss (Btu/h)	Level Conductive Heat Loss: (HL _{level})	Air Leakage Heat Loss Multiplier (LF x HL _{airbv} / HL _{level})
1	0.5	13,952	7,480	0.933
2	0.3		10,289	0.407
3	0.2		10,358	0.269
4	0		0	0.000
5	0		0	0.000

*HL_{airbv} = Air leakage heat loss + ventilation heat loss

*For a balanced or supply only ventilation system HL_{airve} = 0


HEAT LOSS AND GAIN SUMMARY SHEET

MODEL: MILLWOOD 1	OPT 4 BED	BUILDER: GREENPARK HOMES
SFQT: 2194	LO# 79582	SITE: MINNISSALE HOMES CORP

DESIGN ASSUMPTIONS

HEATING	°F	COOLING	°F
OUTDOOR DESIGN TEMP.	-2	OUTDOOR DESIGN TEMP.	86
INDOOR DESIGN TEMP.	72	INDOOR DESIGN TEMP. (MAX 75°F)	75

BUILDING DATA

ATTACHMENT:	DETACHED	# OF STORIES (+BASEMENT):	3
FRONT FACES:	EAST	ASSUMED (Y/N):	Y
AIR CHANGES PER HOUR:	3.57	ASSUMED (Y/N):	Y
AIR TIGHTNESS CATEGORY:	AVERAGE	ASSUMED (Y/N):	Y
WIND EXPOSURE:	SHELTERED	ASSUMED (Y/N):	Y
HOUSE VOLUME (ft³):	29666.0	ASSUMED (Y/N):	Y
INTERNAL SHADING:	BLINDS/CURTAINS	ASSUMED OCCUPANTS:	5
INTERIOR LIGHTING LOAD (Btu/h/ft²):	1.80	DC BRUSHLESS MOTOR (Y/N):	Y
FOUNDATION CONFIGURATION	BCIN_1	DEPTH BELOW GRADE:	6.0 ft
LENGTH: 44.0 ft	WIDTH: 32.0 ft	EXPOSED PERIMETER:	152.0 ft

2012 OBC - COMPLIANCE PACKAGE

Component

Ceiling with Attic Space Minimum RSI (R)-Value
Ceiling Without Attic Space Minimum RSI (R)-Value
Exposed Floor Minimum RSI (R)-Value
Walls Above Grade Minimum RSI (R)-Value
Basement Walls Minimum RSI (R)-Value
Below Grade Slab Entire surface > 600 mm below grade Minimum RSI (R)-Value
Edge of Below Grade Slab ≤ 600 mm Below Grade Minimum RSI (R)-Value
Heated Slab or Slab ≤ 600 mm below grade Minimum RSI (R)-Value
Windows and Sliding Glass Doors Maximum U-Value
Skylights Maximum U-Value
Space Heating Equipment Minimum AFUE
HRV Minimum Efficiency
Domestic Hot Water Heater Minimum EF

**CITY OF BRAMPTON
BUILDING DIVISION
REVIEWED BY: S. DESAI
NOV 23 2018**

**ATTACHED NOTES ARE PART
OF REVIEWED DRAWINGS
ALL WORK MUST COMPLY WITH OBC**

Compliance Package A1


Nominal	Min. Eff.
60	59.22
31	27.65
31	29.80
22	17.03
20 ci	21.12
-	-
10	10
10	11.13
0.28	-
0.49	-
0.96	-
75%	-
0.8	-

INDIVIDUAL BCIN: 19669
MICHAEL O'ROURKE

Michael O'Rourke


Residential Foundation Thermal Load Calculator

Supplemental tool for CAN/CSA-F280

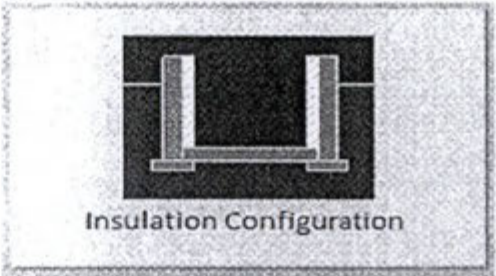Weather Station Description		
Province:	Ontario	
Region:	Brampton	
Site Description		
Soil Conductivity:	Normal conductivity: dry sand, loam, clay	
Water Table:	Normal (7-10 m, 23-33 ft)	
Foundation Dimensions		
Floor Length (m):	13.4	 Insulation Configuration
Floor Width (m):	9.8	
Exposed Perimeter (m):	0.0	
Wall Height (m):	2.7	
Depth Below Grade (m):	1.83	
Window Area (m ²):	0.3	
Door Area (m ²):	1.9	
Radiant Slab		
Heated Fraction of the Slab:	0	
Fluid Temperature (°C):	33	
Design Months		
Heating Month	1	
Foundation Loads		
Heating Load (Watts):		1527

TYPE: MILLWOOD 1
LO# 79582


OPT 4 BED

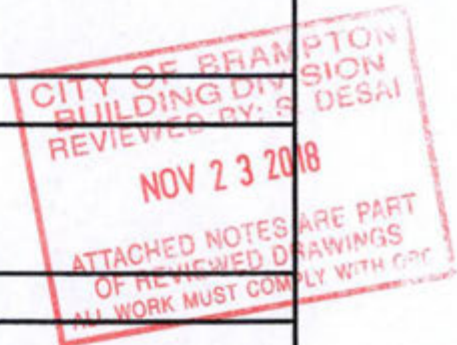

Air Infiltration Residential Load Calculator


Supplemental tool for CAN/CSA-F280

Weather Station Description			
Province:	Ontario		
Region:	Brampton		
Weather Station Location:	Open flat terrain, grass		
Anemometer height (m):	10		
Local Shielding			
Building Site:	Suburban, forest		
Walls:	Heavy		
Flue:	Heavy		
Highest Ceiling Height (m):	7.62		
Building Configuration			
Type:	Detached		
Number of Stories:	Two		
Foundation:	Full		
House Volume (m ³):	840.0		
Air Leakage/Ventilation			
Air Tightness Type:	Present (1961-) (3.57 ACH)		
Custom BDT Data:	ELA @ 10 Pa.	1119.8 cm ²	
	3.57	ACH @ 50 Pa	
Mechanical Ventilation (L/s):	Total Supply	Total Exhaust	
	37.5	37.5	
Flue Size			
Flue #:	#1	#2	#3 #4
Diameter (mm):	0	0	0 0
Natural Infiltration Rates			
Heating Air Leakage Rate (ACH/H):	0.354		
Cooling Air Leakage Rate (ACH/H):	0.115		

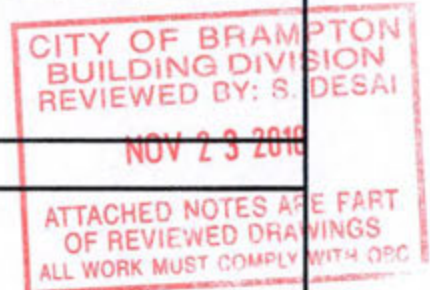TYPE: MILLWOOD 1
LO# 79582

OPT 4 BED

WOD CONDITION

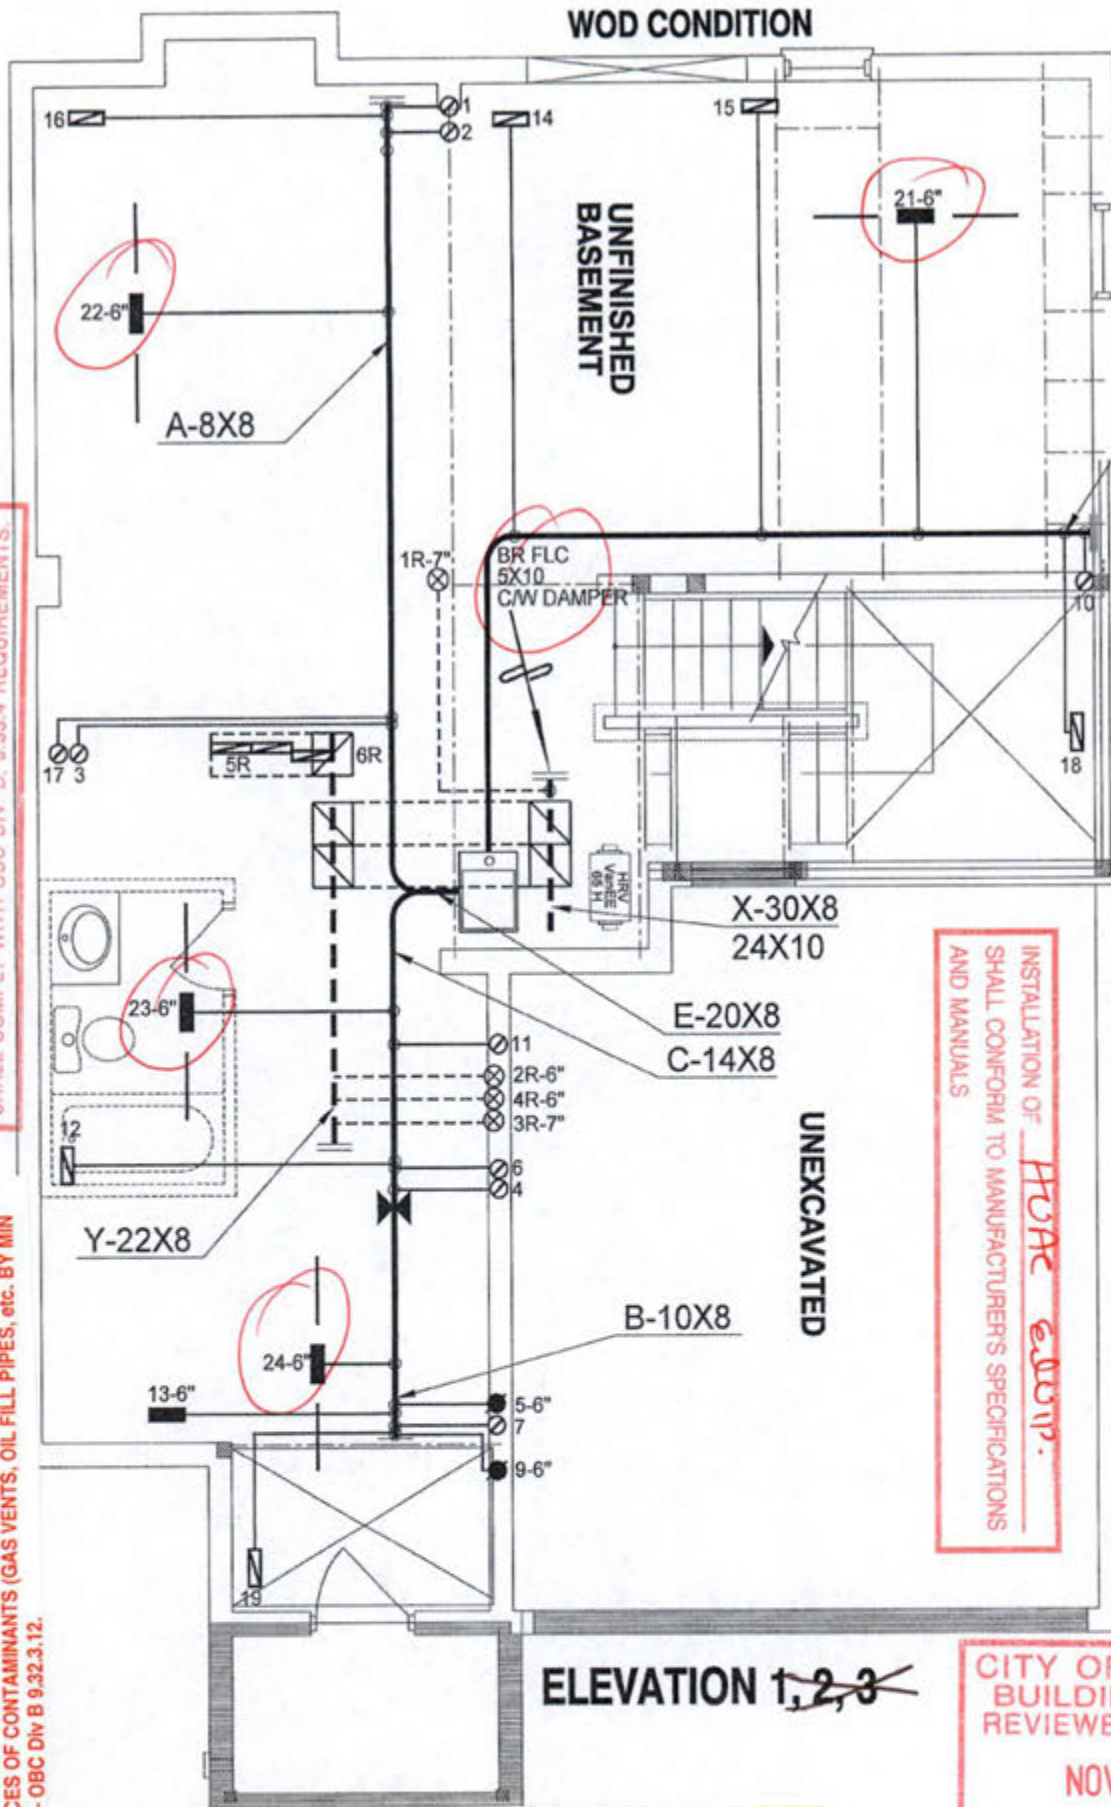

ELEVATION 1,2,3

INSTALLATION OF KITCHEN EXHAUST DUCT LARGER THAN 6" dia SHALL BE PRECEDED BY APPLICATION FOR REVISION OF DESIGN PER OBC PART 5 REQUIREMENTS. EXHAUST FAN SHALL DISCHARGE DIRECTLY TO OUTSIDE. CLOTHES DRYER EXHAUST SYSTEM SHALL COMPLY WITH OBC DIV B 9.32.1.2, 9.32.1.3 & 9.32.3 REQ'S. BALANCE THE RETURN AIRFLOW ON THE UPPER FLOOR TO MATCH THE SUPPLY. WHEN HRV IS USED AS PRINCIPAL EXHAUST FAN, THE CONTROLLER SHALL BE WIRED TO THE HRV UNIT AND INTERCONNECTED TO THE FURNACE FAN. THE FURNACE BLOWER MUST BE IN OPERATION WHEN THE HRV IS IN OPERATION. INSTALL ADDITIONAL S/A REGISTER AS REQUIRED IN ORDER TO ENSURE MIN 72deg F - OBC DIV B 9.33.3.1(1). UNDERCUT BY MIN 1" THE DOOR TO ANY ROOM WITHOUT RETURN AIR GRILLE. ENSURE RETURN AIR INTAKE SHALL BE CONNECTED TO THE MAIN R/A DUCT AT A HORIZONTAL DISTANCE OF MIN 6FT FROM THE CASING OF THE UNIT (HRAI DIGEST).

INSTALLATION OF HRV equip. SHALL CONFORM TO MANUFACTURER'S SPECIFICATIONS AND MANUALS

A HEAT RECOVERY VENTILATOR SHALL BE INSTALLED IN COMPLIANCE WITH OBC DIV. B, 6.2.1.6, 9.32.3.6(3), 9.32.3.11 AND HRAI DIGEST REQUIREMENTS.

CITY OF BRAMPTON
BUILDING DIVISION
REVIEWED BY: S. DESAI

NOV 23 2018 SS

ATTACHED NOTES ARE PART
OF REVIEWED DRAWINGS
ALL WORK MUST COMPLY WITH OBC

18-3332850000RR

CSA-F280-12
PACKAGE A1

I, MICHAEL CHURCH, HAVE REVIEWED AND TAKE RESPONSIBILITY FOR THE DESIGN WORK AND AM QUALIFIED UNDER DIVISION C, 1.1.1 OF THE BUILDING CODE.


HVAC LEGEND						3.	
SYMBOL	DESCRIPTION	SYMBOL	DESCRIPTION	SYMBOL	DESCRIPTION	2.	
—	FLOOR SUPPLY AIR GRILLE	—	6" SUPPLY AIR BOOT ABOVE	—	14"x8" RETURN AIR GRILLE	1.	
—	FLOOR SUPPLY AIR GRILLE 8" BOOT	—	SUPPLY AIR STACK FROM 2ND FLOOR	—	30"x8" RETURN AIR GRILLE	No.	Description Date
—	SUPPLY AIR BOOT ABOVE	—	6" SUPPLY AIR STACK 2ND FLOOR	—	FRA-FLOOR RETURN AIR GRILLE		
					REDUCER		

ALL DRAWINGS, CALCULATIONS AND SPECIFICATIONS ARE THE PROPERTY OF HVAC DESIGNS LTD. AND MAY NOT BE REPRODUCED, MODIFIED OR ALTERED WITHOUT EXPRESSED WRITTEN CONSENT. THE DRAWINGS ARE DATED AND USE OF THESE DRAWINGS AFTER ONE YEAR FROM THE DATED NOTED IS NOT AUTHORIZED. CONTRACTOR SHALL CHECK ALL CONDITIONS BEFORE PROCEEDING WITH WORK. LATEST MUNICIPAL APPROVED DRAWINGS ONLY TO BE USED DURING INSTALLATION OF HEATING SYSTEM. HVAC DESIGNS LTD. IS NOT LIABLE FOR ANY CLAIMS ARISING FROM UNAUTHORIZED USE OF THE DRAWINGS OR FROM ANY CHANGES TO ACCEPTED STANDARDS AND/OR THE ONTARIO BUILDING CODE.

Client		HVACDESIGNS LTD. 375 Finley Ave. Suite 202 - Ajax, Ontario L1S 2E2 Tel. 905.619.2300 - 905.420.5000 Fax 905.619.2375 Email: info@hvacdesigns.ca Web: www.hvacdesigns.ca Specializing in Residential Mechanical Design Services	HEAT LOSS 44049 BTU/H UNIT DATA		# OF RUNS S/A R/A FANS			Sheet Title		
GREENPARK HOMES			MAKE GOODMAN		3RD FLOOR				BASEMENT HEATING LAYOUT	
Project Name MINNISALE HOMES CORP. BRAMPTON, ONTARIO			MODEL GMEC96063BNA		2ND FLOOR		11	4		3
OPT 4 BED MILLWOOD 1			INPUT 60 MBTUH		1ST FLOOR		7	2		2
2194 sqft			OUTPUT 57.5 MBTUH		BASEMENT		4	1	0	Date AUG/2018
LOT 4		Installation to comply with the latest Ontario Building Code. All supply branch outlets shall be equipped with a manual balancing damper. Ductwork which passes through the garage or unheated spaces shall be adequately insulated and be gas-proofed.	COOLING 2.5 TONS		ALL S/A DIFFUSERS 4 "x10" UNLESS NOTED OTHERWISE ON LAYOUT. ALL S/A RUNS 5"Ø UNLESS NOTED OTHERWISE ON LAYOUT. UNDERCUT DOORS 1" min. FOR R/A				Scale 3/16" = 1'-0"	
			FAN SPEED 1131 cfm @ 0.6" w.g.						BCIN# 19669	
									LO# 79582	


THIS INSTALLATION OF A GAS FIREPLACE IS REGULATED UNDER THE T.S.S.A. BY C.S.A. B149.1 NATURAL GAS AND PROPANE INSTALLATION CODE CALL ENBRIDGE FOR INSPECTION AT 1-800-785-1314

THE INSTALLATION OF CARBON MONOXIDE DETECTOR(S) SHALL COMPLY WITH OBC DIV. B, 9.33.4 REQUIREMENTS.
MECHANICAL VENTILATION SHALL BE PROVIDED IN CONFORMANCE WITH OBC DIV. B, 9.32.3 REQUIREMENTS.

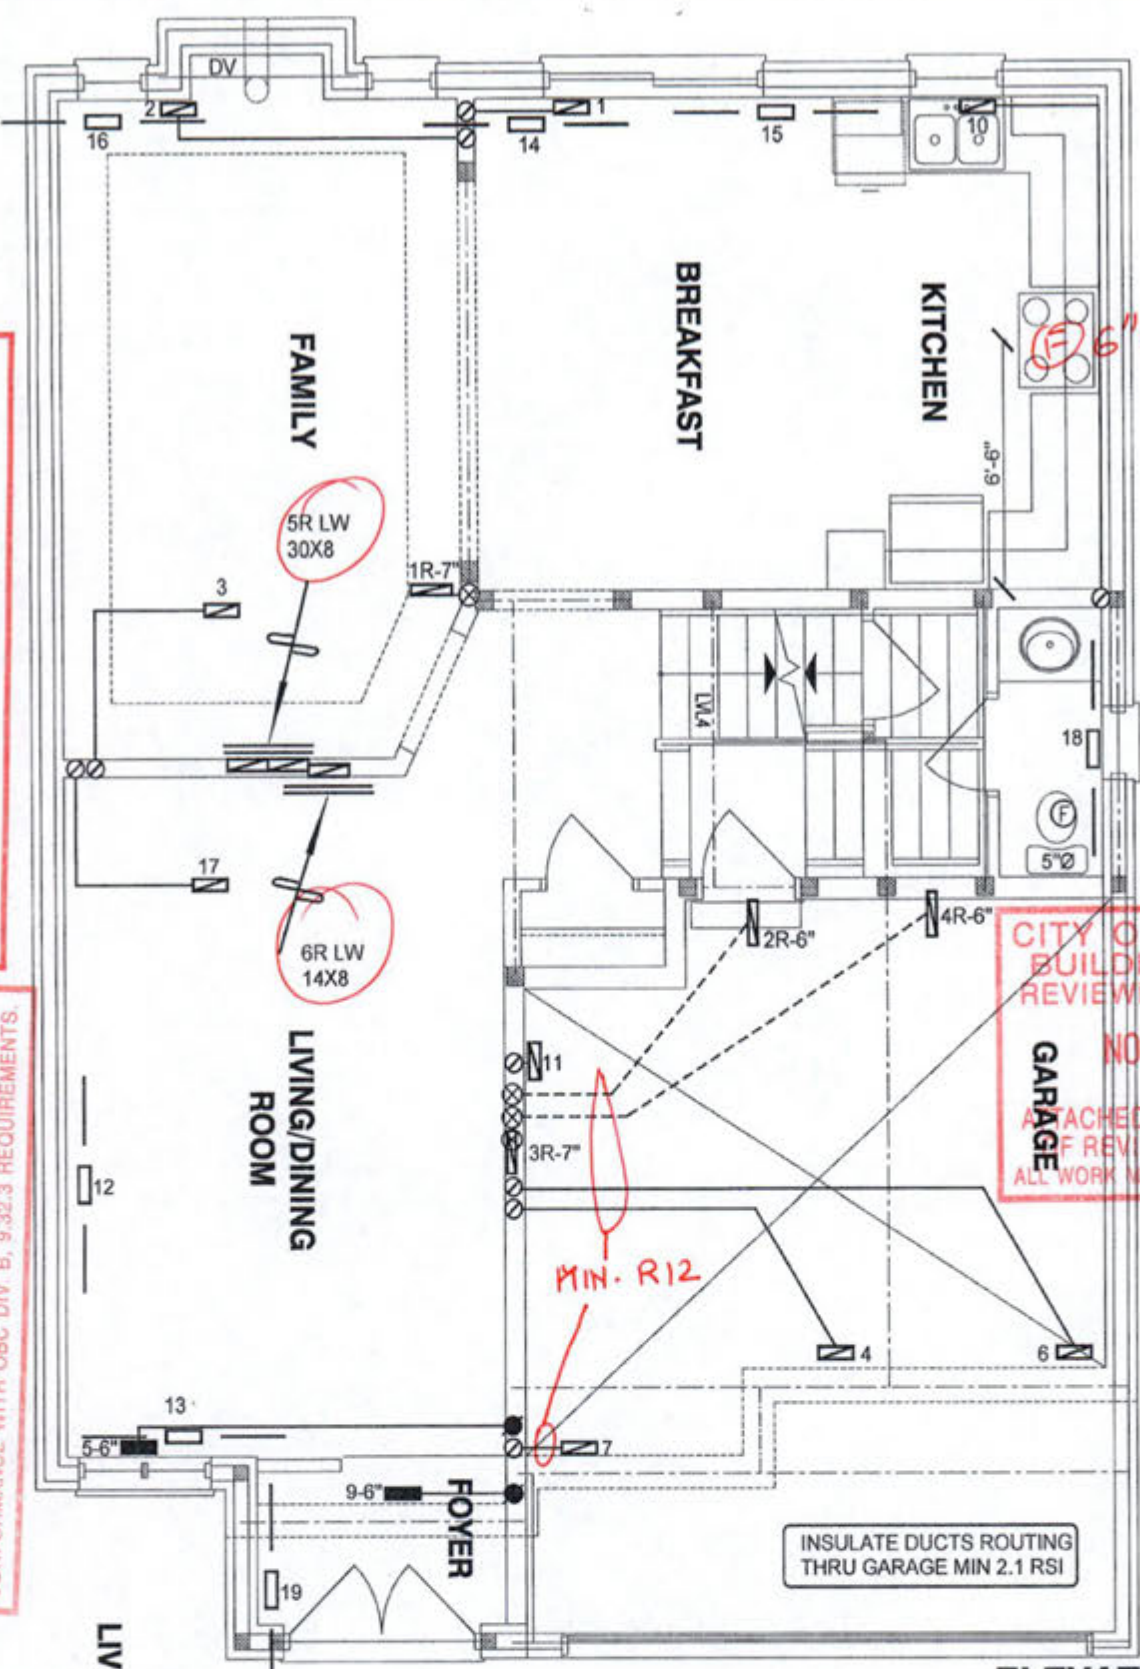


CITY OF BRAMPTON
BUILDING DIVISION
REVIEWED BY: S. DESAI
NOV 23 2018
ATTACHED NOTES ARE PART OF REVIEWED DRAWINGS
ALL WORK MUST COMPLY WITH OBC

ELEVATION 1

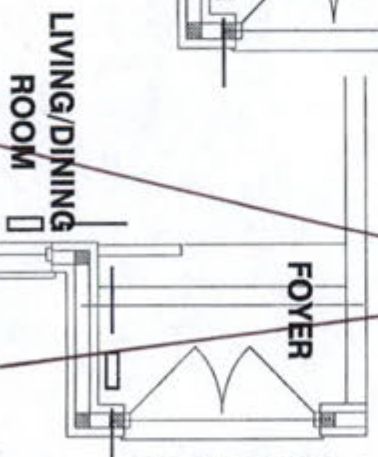

ELEVATION 2

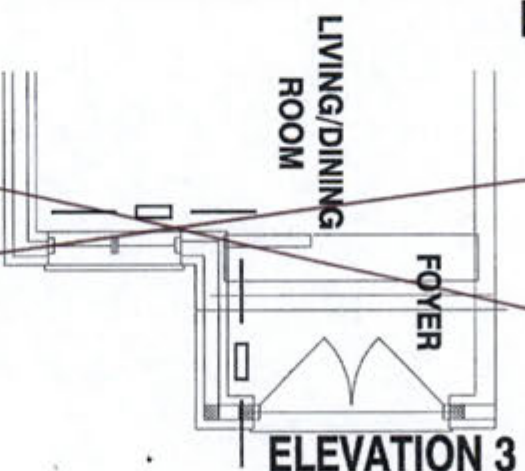

ELEVATION 3

CSA-F280-12
PACKAGE A1

1 MICHAEL O'ROURKE, DATE REVIEW AND TAKE RESPONSIBILITY FOR THE DESIGN WORK AND AS REQUIRED UNDER DIVISION C, 1.1.5 OF THE BUILDING CODE.
Michael O'Roourke
Michael O'Roourke, P.Eng. 2008
HVAC DESIGNS LTD.


HVAC LEGEND							
SYMBOL	DESCRIPTION	SYMBOL	DESCRIPTION	SYMBOL	DESCRIPTION	3.	
	FLOOR SUPPLY AIR GRILLE		8" SUPPLY AIR BOOT ABOVE		14" RETURN AIR GRILLE	2.	
	FLOOR SUPPLY AIR GRILLE 8" BOOT		SUPPLY AIR STACK FROM 2nd FLOOR		30" RETURN AIR GRILLE	1.	
	SUPPLY AIR BOOT ABOVE		8" SUPPLY AIR STACK 2nd FLOOR		FRA-FLOOR RETURN AIR GRILLE	No.	Description Date
					REDUCER	REVISIONS	

ALL DRAWINGS, CALCULATIONS AND SPECIFICATIONS ARE THE PROPERTY OF HVAC DESIGNS LTD. AND MAY NOT BE REPRODUCED, MODIFIED OR ALTERED WITHOUT EXPRESSED WRITTEN CONSENT. THE DRAWINGS ARE DATED AND USE OF THESE DRAWINGS AFTER ONE YEAR FROM THE DATED NOTED IS NOT AUTHORIZED. CONTRACTOR SHALL CHECK ALL CONDITIONS BEFORE PROCEEDING WITH WORK. LATEST MUNICIPAL APPROVED DRAWINGS ONLY TO BE USED DURING INSTALLATION OF HEATING SYSTEM. HVAC DESIGNS LTD. IS NOT LIABLE FOR ANY CLAIMS ARISING FROM UNAUTHORIZED USE OF THE DRAWINGS OR FROM ANY CHANGES TO ACCEPTED STANDARDS AND/OR THE ONTARIO BUILDING CODE.

Client GREENPARK HOMES Project Name MINNISALE HOMES CORP. BRAMPTON, ONTARIO OPT 4 BED MILLWOOD 1	HVACDESIGNS LTD. 375 Finley Ave. Suite 202 - Ajax, Ontario L1B 2E2 Tel. 905.619.2300 - 905.420.5200 Fax 905.619.2375 Email: info@hvacdsgns.ca Web: www.hvacdsgns.ca Specializing in Residential Mechanical Design Services Installation to comply with the latest Ontario Building Code. All supply branch outlets shall be equipped with a manual balancing damper. Ductwork which passes through the garage or unheated spaces shall be adequately insulated and be gas-proofed.	Sheet Title FIRST FLOOR HEATING LAYOUT Date AUG/2018 Scale 3/16" = 1'-0" BCIN# 19669 LO# 79582
---	---	---


MECHANICAL VENTILATION SHALL BE PROVIDED IN CONFORMANCE WITH OBC DIV. B, 9.32.3 REQUIREMENTS.

THE INSTALLATION OF CARBON MONOXIDE DETECTOR(S) SHALL COMPLY WITH OBC DIV. B, 9.33.4 REQUIREMENTS.

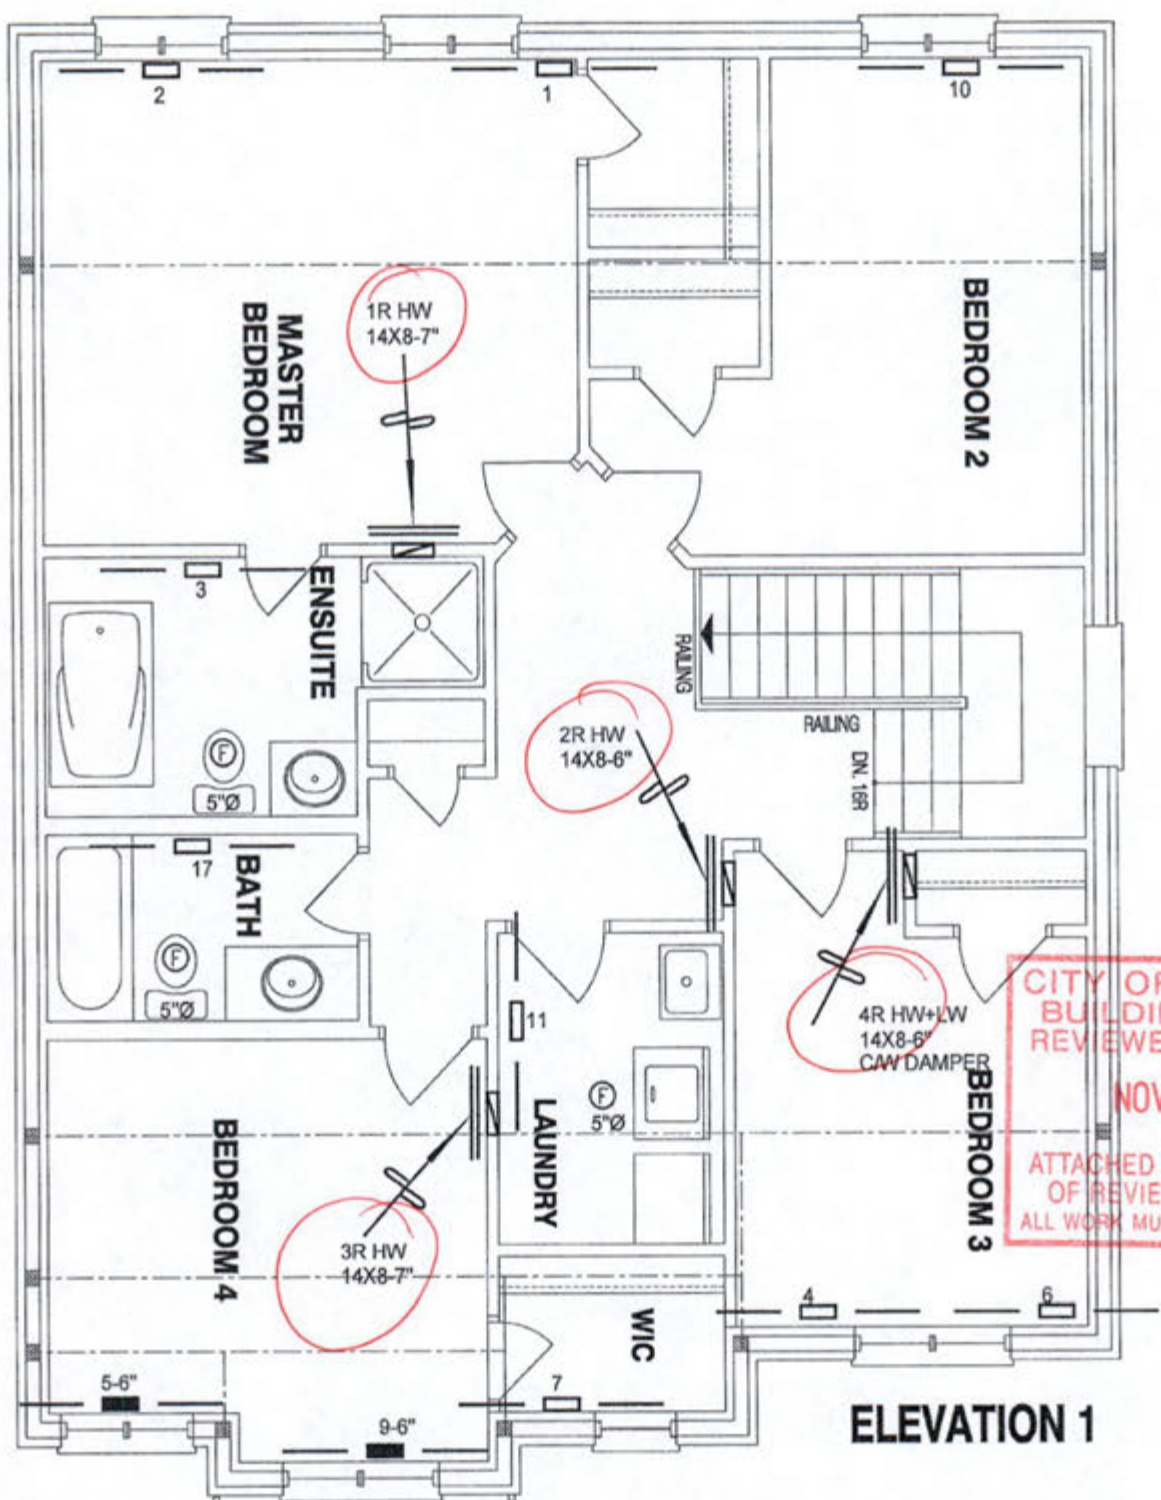


CITY OF BRAMPTON
BUILDING DIVISION
REVIEWED BY: S. DESAI
NOV 23 2018
ATTACHED NOTES ARE PART
OF REVIEWED DRAWINGS
ALL WORK MUST COMPLY WITH OBC

ELEVATION 1

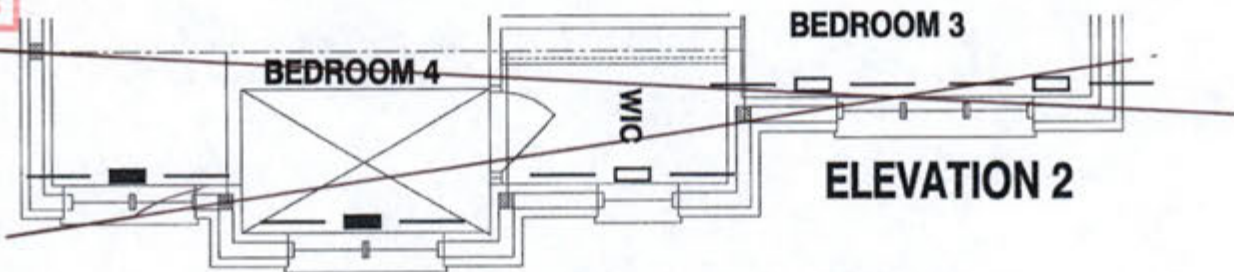

ELEVATION 2

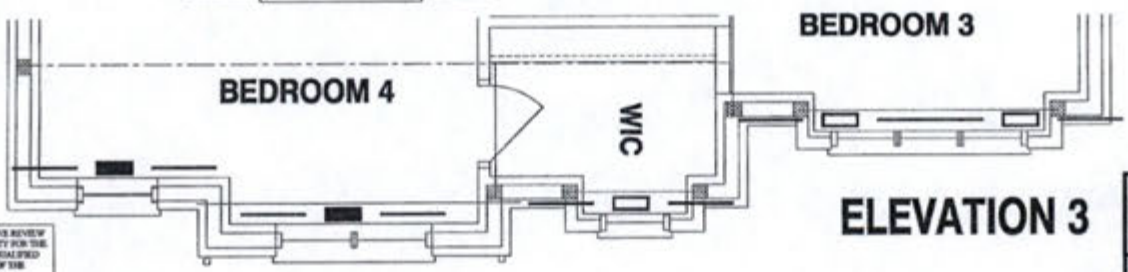

ELEVATION 3

CSA-F280-12
PACKAGE A1

I MICHAEL O'ROURKE HAVE REVIEWED AND TAKE RESPONSIBILITY FOR THE DESIGN WORK AND AM QUALIFIED UNDER DIVISION C, 3.3.3 OF THE BUILDING CODE.
Michael O'Rourke
MICHAEL O'ROURKE, P.Eng. (MECH)
HVAC DESIGNS LTD.

HVAC LEGEND							
	FLOOR SUPPLY AIR GRILLE		6" SUPPLY AIR BOOT ABOVE		14" RETURN AIR GRILLE		RETURN AIR STACK ABOVE
	FLOOR SUPPLY AIR GRILLE 6" BOOT		SUPPLY AIR STACK FROM 2nd FLOOR		20" RETURN AIR GRILLE		RETURN AIR STACK 2nd FLOOR
	SUPPLY AIR BOOT ABOVE		6" SUPPLY AIR STACK 2nd FLOOR		FRA FLOOR RETURN AIR GRILLE		REDUCER

ALL DRAWINGS, CALCULATIONS AND SPECIFICATIONS ARE THE PROPERTY OF HVAC DESIGNS LTD. AND MAY NOT BE REPRODUCED, MODIFIED OR ALTERED WITHOUT EXPRESSED WRITTEN CONSENT. THE DRAWINGS ARE DATED AND USE OF THESE DRAWINGS AFTER ONE YEAR FROM THE DATED NOTED IS NOT AUTHORIZED. CONTRACTOR SHALL CHECK ALL CONDITIONS BEFORE PROCEEDING WITH WORK. LATEST MUNICIPAL APPROVED DRAWINGS ONLY TO BE USED DURING INSTALLATION OF HEATING SYSTEM. HVAC DESIGNS LTD. IS NOT LIABLE FOR ANY CLAIMS ARISING FROM UNAUTHORIZED USE OF THE DRAWINGS OR FROM ANY CHANGES TO ACCEPTED STANDARDS AND/OR THE ONTARIO BUILDING CODE.

Client GREENPARK HOMES		HVAC DESIGNS LTD. 375 Finley Ave, Suite 202 - Ajax, Ontario L1S 2E2 Tel: 905.619.2300 - 905.420.5300 Fax 905.619.2375 Email: info@hvacdesigns.ca Web: www.hvacdesigns.ca Specializing in Residential Mechanical Design Services	Sheet Title SECOND FLOOR HEATING LAYOUT	
Project Name MINNISALE HOMES CORP. BRAMPTON, ONTARIO				
Date AUG/2018		Scale 3/16" = 1'-0"		
Installation to comply with the latest Ontario Building Code. All supply branch outlets shall be equipped with a manual balancing damper. Ductwork which passes through the garage or unheated spaces shall be adequately insulated and be gas-proofed.		BCIN# 19869		
OPT 4 BED MILLWOOD 1 2194 sqft		LO# 79582		