

SITE NAME: MINNISALE HOMES CORP
BUILDER: GREENPARK HOMES

LOT 22
TYPE: MILLWOOD 2

GFA: 2654

DATE: Oct-18
LOW #0881

WINTER NATURAL AIR CHANGE RATE 0.214
SUMMER NATURAL AIR CHANGE RATE 0.102

HEAT LOSS ΔT °F. 74
HEAT GAIN ΔT °F. 11

CSA-F280-12
SB-12 PACKAGE A1

ROOM USE			MBR			ENS			BED-2			BED-3			BED-4			BATH			ENS-2											
EXP. WALL			34			39			26			33			11			10			15											
CLG. HT.			10			9			9			10			9			9			9											
FACTORS																																
GRS.WALL AREA			LOSS			GAIN			340			291			234			330			99			90			135					
GLAZING			LOSS			GAIN			LOSS			GAIN			LOSS			GAIN			LOSS			GAIN			LOSS			GAIN		
NORTH			20.8	18.5	0	0	0	0	0	0	0	0	0	0	0	0	0	0	0	0	0	0	0	0	0	0	0	0	0			
EAST			20.8	41.0	0	0	0	0	0	0	0	0	0	20	418	821	30	823	1231	0	0	0	0	0	0	0	0	0	0			
SOUTH			20.8	24.4	0	0	0	0	10	208	244	0	0	0	0	0	0	0	0	12	249	293	8	166	195	8	166	195				
WEST			20.8	41.0	32	665	1314	12	249	493	0	0	0	0	0	0	0	0	0	0	0	0	0	0	0	0	0	0				
SKYL.T.			36.4	100.7	0	0	0	0	0	0	0	0	0	0	0	0	0	0	0	0	0	0	0	0	0	0	0	0				
DOORS			24.7	3.7	0	0	0	0	0	0	0	0	0	0	0	0	0	0	0	0	0	0	0	0	0	0	0	0				
NET EXPOSED WALL			4.4	0.6	308	1342	159	339	1041	154	214	932	138	300	1367	194	87	279	56	82	337	53	127	552	82	0	0	0				
NET EXPOSED BMT WALL ABOVE GR			3.5	0.5	0	0	0	0	0	0	0	0	0	0	0	0	0	0	0	0	0	0	0	0	0	0	0	0				
EXPOSED CLG			1.3	0.6	280	351	106	204	236	114	165	207	92	196	244	109	220	278	123	176	221	96	168	210	94	168	210	94				
NO ATTIC EXPOSED CLG			2.7	1.2	0	0	0	0	0	0	0	0	0	40	107	48	0	0	0	0	0	0	0	0	0	0	0	0				
EXPOSED FLOOR			2.5	0.4	0	0	0	0	0	0	165	411	61	0	0	0	0	0	0	0	0	0	168	418	62	168	418	62				
BASEMENT CRAWL HEAT LOSS					0		0		0	0	0		0		0		0		0		0	0		0		0		0				
SLAB ON GRADE HEAT LOSS					0		0		0	0	0		0		0		0		0		0	0		0		0		0				
SUBTOTAL HT LOSS					2358		1764		1965		2282		904		744							1348										
SUB TOTAL HT GAIN							1689		1006		1112		1082		472		348					433										
LEVEL FACTOR / MULTIPLIER			0.20	0.23			0.20	0.23		0.20	0.23		0.20	0.23		0.20	0.23		0.20	0.23		0.20	0.23									
AIR CHANGE HEAT LOSS					541		482		421		524		208		171							310										
AIR CHANGE HEAT GAIN							111		67		74		165		31		23					29										
DUCT LOSS					0		0		282		0		0		0		0					168										
DUCT GAIN					0		0		205		0		0		0		0					45										
HEAT GAIN PEOPLE			240	2	480	0	0	1	240	1	240	1	240	1	240	0	0					0	0									
HEAT GAIN APPLIANCES/LIGHTS					627		627		627		627		627		627		627					0	0									
TOTAL HT LOSS BTU/H					2899		2167		2568		2806		1112		915							1824										
TOTAL HT GAIN x 1.3 BTU/H					3752		2208		2936		3320		1781		1295							640										

ROOM USE	EXP. WALL	CLG. HT.	LIV	KITCH	LAIN	WR	POY	MUD	WUB	BAS
38	10	38	10	38	10	12	27	17	16	138
FACTORS										
GRS.WALL AREA	LOSS	GAIN	380	780	72	132	270	187	144	828
GLAZING	LOSS	GAIN								
NORTH	20.8	18.5	0	0	0	0	0	0	0	0
EAST	20.8	41.0	0	0	10	258	410	0	0	0
SOUTH	20.8	24.4	40	821	0	0	0	10	208	244
WEST	20.8	41.0	0	0	0	0	0	0	0	0
SKYL.T.	36.4	100.7	0	0	0	0	0	0	0	0
DOORS	24.7	3.7	0	0	20	483	73	0	0	0
NET EXPOSED WALL	4.4	0.6	340	1485	685	2908	444	82	270	40
NET EXPOSED BMT WALL ABOVE GR	3.5	0.5	0	0	0	0	0	0	0	0
EXPOSED CLG	1.3	0.6	0	0	138	160	71	0	0	0
NO ATTIC EXPOSED CLG	2.7	1.2	0	0	0	0	0	0	0	0
EXPOSED FLOOR	2.5	0.4	0	0	0	0	0	0	0	0
BASEMENT CRAWL HEAT LOSS			0	0	0	0	0	0	0	0
SLAB ON GRADE HEAT LOSS			0	0	0	0	0	0	0	0
SUBTOTAL HT LOSS			2312	3083	167	729	2087	1221	126	4621
SUB TOTAL HT GAIN				3816		685	323	837	355	6776
LEVEL FACTOR / MULTIPLIER	0.30	0.37	0.30	0.37	0.30	0.37	0.30	0.37	0.30	0.37
AIR CHANGE HEAT LOSS	857		1884		230		274		482	
AIR CHANGE HEAT GAIN		79		233		38		21		35
DUCT LOSS	0		0		118		0		0	
DUCT GAIN		0		0		123		0		0
HEAT GAIN PEOPLE	240	0	0	0	0	0	0	0	0	0
HEAT GAIN APPLIANCES/LIGHTS			627	627		627		627		627
TOTAL HT LOSS BTU/H			3169	8967	1284	1765	467	1673	1241	13844
TOTAL HT GAIN x 1.3 BTU/H			2473	8689	1765	467	745	1866	482	769

TOTAL HEAT GAIN BTU/H: 29886

TONS: 2.47

LOSS DUE TO VENTILATION LOAD BTU/H: 1583

STRUCTURAL HEAT LOSS: 46432

TOTAL COMBINED HEAT LOSS BTU/H: 48025

ATTACHED NOTES ARE PART
OF REVIEWED DRAWINGS
NOV 27 2018
CITY OF BRAMPTON
BUILDING DIVISION
REVIEWED BY: S. HANNA

Michael O'Rourke

SITE NAME: MINNISALE HOMES CORP
 BUILDER: GREENPARK HOMES

 LCT 22
 TYPE: MILLWOOD 2

DATE: Oct-18

GFA: 2654 LOW 80551

 HEATING CFM 1131 COOLING CFM 1131
 TOTAL HEAT LOSS 46,432 TOTAL HEAT GAIN 29,369
 AIR FLOW RATE CFM 24.38 AIR FLOW RATE CFM 38.51

 furnace pressure 0.8
 furnace filter 0.05
 a/c coil pressure 0.2
 available pressure for s/a & r/a 0.35

 #GOODMAN
 GMEC900603BNA 80
 FAN SPEED LOW
 MEDLOW
 MEDIUM
 MEDIUM HIGH
 HIGH 1131

 AFUE = 96 %
 INPUT (BTU/H) = 60,000
 OUTPUT (BTU/H) = 57,600

 DESIGN CFM = 1131
 CFM @ 8" E.S.P.

RUN COUNT	4th	3rd	2nd	1st	Bas
S/A	0	0	11	7	4
R/A	0	0	4	2	1

All S/A diffusers 4"x10" unless noted otherwise on layout.

All S/A runs 5'Ø unless noted otherwise on layout.

 plenum pressure s/a 0.18
 max s/a dif press. loss 0.02
 min adjusted pressure s/a 0.15
 r/a pressure 0.17
 r/a grille press. Loss 0.02
 adjusted pressure r/a 0.15

TEMPERATURE RISE 47 °F

RUN #	1	2	4	5	6	7	8	9	10	11	12	14	15	16	17	18	19	20	21	22	23	24
ROOM NAME	MBR	ENS	BED-2	BED-3	BED-4	BATH	BED-2	BED-3	MBR	ENS-2	LIV	KT/FM	KT/FM	KT/FM	LAUN	W/R	FOY	MUD	BAS	BAS	BAS	BAS
RM LOSS MBH	1.45	2.16	1.33	1.40	1.11	0.91	1.33	1.40	1.45	1.82	3.17	2.32	2.32	2.32	1.29	1.01	2.86	1.87	3.77	3.77	3.77	3.77
CFM PER RUN HEAT	35	53	32	34	27	22	32	34	35	44	77	57	57	57	32	25	70	41	92	92	92	92
RM GAIN MBH	1.88	2.21	1.47	1.86	1.78	1.30	1.47	1.86	1.88	0.66	2.47	1.90	1.90	1.90	1.76	0.45	0.74	1.07	0.31	0.31	0.31	0.31
CFM PER RUN COOLING	72	85	57	64	69	50	57	64	72	25	95	73	73	73	68	17	29	41	12	12	12	12
ADJUSTED PRESSURE	0.17	0.16	0.17	0.17	0.17	0.17	0.17	0.17	0.17	0.17	0.16	0.17	0.17	0.17	0.17	0.17	0.17	0.17	0.16	0.16	0.16	0.16
ACTUAL DUCT LGH.	55	54	48	33	15	37	47	47	45	38	15	48	44	49	39	39	29	32	39	64	20	10
EQUIVALENT LENGTH	190	160	140	140	160	110	140	160	150	140	120	130	110	140	130	140	90	160	150	200	110	150
TOTAL EFFECTIVE LENGTH	245	214	186	173	175	147	187	207	195	178	135	178	154	189	169	179	119	192	189	264	130	160
ADJUSTED PRESSURE	0.07	0.08	0.09	0.1	0.1	0.12	0.09	0.08	0.09	0.1	0.12	0.1	0.11	0.09	0.1	0.1	0.14	0.09	0.09	0.06	0.12	0.1
ROUND DUCT SIZE	8	8	5	5	5	4	5	5	5	4	6	5	5	5	5	4	5	4	6	6	6	6
HEATING VELOCITY (ft/min)	178	270	235	250	198	252	235	250	178	505	363	419	419	419	235	287	514	470	469	469	469	469
COOLING VELOCITY (ft/min)	367	433	419	470	507	574	419	470	367	287	484	536	536	536	499	195	213	470	61	61	61	61
OUTLET GRILL SIZE	4X10	4X10	3X10	3X10	3X10	3X10	3X10	3X10	4X10	3X10	4X10	3X10	3X10	3X10	3X10	3X10	3X10	3X10	4X10	4X10	4X10	4X10
TRUNK	A	B	D	C	B	D	D	C	A	D	C	A	A	A	D	B	C	B	A	A	C	B

 RUN #
 ROOM NAME
 RM LOSS MBH
 CFM PER RUN HEAT
 RM GAIN MBH
 CFM PER RUN COOLING
 ADJUSTED PRESSURE
 ACTUAL DUCT LGH.
 EQUIVALENT LENGTH
 TOTAL EFFECTIVE LENGTH
 ADJUSTED PRESSURE
 ROUND DUCT SIZE
 HEATING VELOCITY (ft/min)
 COOLING VELOCITY (ft/min)
 OUTLET GRILL SIZE
 TRUNK

 CITY OF BRAMPTON
 BUILDING DIVISION
 REVIEWED BY: S. HANNA
 NOV 27 2018
 ATTACHED NOTES ARE PART
 OF REVIEWED DRAWINGS
 ALL WORK MUST COMPLY WITH

SUPPLY AIR TRUNK SIZE

TRUNK	CFM	STATIC PRESS.	ROUND DUCT	RECT DUCT	VELOCITY (ft/min)
TRUNK A	425	0.06	10.9	14	8
TRUNK B	663	0.06	12.9	20	8
TRUNK C	307	0.08	9	10	8
TRUNK D	469	0.08	10.6	14	8
TRUNK E	0	0.00	0	0	8
TRUNK F	0	0.00	0	0	8

RETURN AIR TRUNK SIZE

TRUNK	CFM	STATIC PRESS.	ROUND DUCT	RECT DUCT	VELOCITY (ft/min)
TRUNK G	0	0.00	0	0	8
TRUNK H	0	0.00	0	0	8
TRUNK I	0	0.00	0	0	8
TRUNK J	0	0.00	0	0	8
TRUNK K	0	0.00	0	0	8
TRUNK L	0	0.00	0	0	8
TRUNK M	0	0.07	0	0	8
TRUNK N	0	0.07	0	0	8
TRUNK O	0	0.07	0	0	8
TRUNK P	0	0.07	0	0	8
TRUNK Q	0	0.07	0	0	8
TRUNK R	0	0.07	0	0	8
TRUNK S	0	0.07	0	0	8
TRUNK T	0	0.07	0	0	8
TRUNK U	0	0.07	0	0	8
TRUNK V	0	0.07	0	0	8
TRUNK W	0	0.07	0	0	8
TRUNK X	1131	0.07	15.2	30	8
TRUNK Y	295	0.07	9.2	10	8
TRUNK Z	0	0.07	0	0	8
TRUNK DROP	1131	0.07	15.2	24	10

RETURN AIR

RUN #	1	2	3	4	5	6	7	8	9	10	11	12	14	15	16	17	18	19	20	21	22	23	24
AIR VOLUME	160	155	95	95	135	310	0	0	0	0	0	0	0	0	0	0	0	0	0	0	0	0	0
PLENUM PRESSURE	0.15	0.15	0.15	0.15	0.15	0.15	0.15	0.15	0.15	0.15	0.15	0.15	0.15	0.15	0.15	0.15	0.15	0.15	0.15	0.15	0.15	0.15	0.15
ACTUAL DUCT LGH.	58	43	42	48	38	15	1	1	1	1	1	1	1	1	1	1	1	1	1	1	1	1	1
EQUIVALENT LENGTH	150	135	175	175	145	135	0	0	0	0	0	0	0	0	0	0	0	0	0	0	0	0	0
TOTAL EFFECTIVE LH	208	178	217	223	183	150	1	1	1	1	1	1	1	1	1	1	1	1	1	1	1	1	1
ADJUSTED PRESSURE	0.07	0.08	0.07	0.07	0.08	0.10	14.80	14.80	14.80	14.80	14.80	14.80	14.80	14.80	14.80	14.80	14.80	14.80	14.80	14.80	14.80	14.80	14.80
ROUND DUCT SIZE	7.3	7	8	6	6.6	8.6	0	0	0	0	0	0	0	0	0	0	0	0	0	0	0	0	0
INLET GRILL SIZE	8	8	8	8	8	8	0	0	0	0	0	0	0	0	0	0	0	0	0	0	0	0	0
INLET GRILL SIZE	X	X	X	X	X	X	X	X	X	X	X	X	X	X	X	X	X	X	X	X	X	X	X
INLET GRILL SIZE	14	14	14	14	14	30	0	0	0	0	0	0	0	0	0	0	0	0	0	0	0	0	0

TYPE: MILLWOOD 2
SITE NAME: MINNISALE HOMES CORP

LO #: 80551
LOT 22

RESIDENTIAL MECHANICAL VENTILATION DESIGN SUMMARY
COMBUSTION APPLIANCES 9.32.3.1(1)
a) ☐ Direct vent (sealed combustion) only
b) ☐ Positive venting induced draft (except fireplaces)
c) ☐ Natural draft, B-vent or induced draft gas fireplace
d) ☐ Solid Fuel (including fireplaces)
e) ☐ No Combustion Appliances

HEATING SYSTEM
☒ Forced Air ☐ Non Forced Air
☐ Electric Space Heat

HOUSE TYPE 9.32.1(2)
☐ I Type a) or b) appliance only, no solid fuel
☐ II Type I except with solid fuel (including fireplaces)
☐ III Any Type c) appliance
☐ IV Type I, or II with electric space heat
☐ Other: Type I, II or IV no forced air

SYSTEM DESIGN OPTIONS O.N.H.W.P.
☐ 1 Exhaust only/Forced Air System
☐ 2 HRV with Ducting/Forced Air System
☐ 3 HRV Simplified/connected to forced air system
☐ 4 HRV with Ducting/non forced air system
☐ Part 6 Design

TOTAL VENTILATION CAPACITY 9.32.3.3(1)

Basement + Master Bedroom	2	@ 21.2 cfm	42.4	cfm
Other Bedrooms	3	@ 10.6 cfm	31.8	cfm
Kitchen & Bathrooms	5	@ 10.6 cfm	53	cfm
Other Rooms	6	@ 10.6 cfm	63.6	cfm
Table 9.32.3.A.		TOTAL	190.8	cfm

PRINCIPAL VENTILATION CAPACITY REQUIRED 9.32.3.4(1)

1 Bedroom	31.8	cfm
2 Bedroom	47.7	cfm
3 Bedroom	63.6	cfm
4 Bedroom	79.5	cfm
5 Bedroom	95.4	cfm
TOTAL	79.5	cfm

SUPPLEMENTAL VENTILATION CAPACITY 9.32.3.5.

Total Ventilation Capacity	190.8	cfm
Less Principal Ventil. Capacity	79.5	cfm
Required Supplemental Capacity	111.3	cfm

PRINCIPAL EXHAUST FAN CAPACITY
Model: VANE 65H Location: BSMT
79.5 cfm 3.0 sones ☒ HVI Approved

PRINCIPAL EXHAUST HEAT LOSS CALCULATION

CFM	ΔT °F	FACTOR	% LOSS
79.5 CFM	74 F	1.08	0.25

SUPPLEMENTAL FANS PANASONIC

Location	Model	cfm	HVI	Sones
ENS	FV-05-11VK1	50	✓	0.3
BATH	FV-05-11VK1	50	✓	0.3
ENS-2	FV-05-11VK1	50	✓	0.3
W/R	FV-05-11VK1	50	✓	0.3

HEAT RECOVERY VENTILATOR 9.32.3.11.
Model: VANE 65H
155 cfm high 64 cfm low
75 % Sensible Efficiency @ 32 deg F (0 deg C) ☒ HVI Approved

LOCATION OF INSTALLATION
Lot: Concession
Township: Plan:
Address: CITY OF BRAMPTON BUILDING DIVISION REVIEWED BY: S. HANNA
Roll #: Building Permit #
BUILDER: GREENPARK HOMES
Name: NOV 27 2010
Address: ATTACHED NOTES ARE PART OF REVIEWED DRAWINGS
City: ALL WORK MUST COMPLY WITH ORC
Telephone #: Fax #

INSTALLING CONTRACTOR
Name:
Address:
City:
Telephone #: Fax #:

DESIGNER CERTIFICATION
I hereby certify that this ventilation system has been designed in accordance with the Ontario Building Code.
Name: HVAC Designs Ltd.
Signature: *Michael O'Rourke*
HRAJ #: 001820
Date: October-18

CSA F280-12 Residential Heat Loss and Heat Gain Calculations
Formula Sheet (For Air Leakage / Ventilation Calculation)

LO#: 80551

Model: MILLWOOD 2

Builder: GREENPARK HOMES

Date: 10/31/2018

Volume Calculation
House Volume

Level	Floor Area (ft ²)	Floor Height (ft)	Volume (ft ³)
Bsmt	1148	9	10332
First	1148	10	11480
Second	1506	8	12048
Third	0	9	0
Fourth	0	9	0
Total:			33,860.0 ft ³
Total:			958.8 m ³

Air Change & Delta T Data

WINTER NATURAL AIR CHANGE RATE	0.314
SUMMER NATURAL AIR CHANGE RATE	0.102

Design Temperature Difference				
	T _{in} °C	T _{out} °C	ΔT °C	ΔT °F
Winter DTD _h	22	-19	41	74
Summer DTD _c	24	30	6	11

5.2.3.1 Heat Loss due to Air Leakage

$$HL_{airb} = LR_{airh} \times \frac{V_b}{3.6} \times DTD_h \times 1.2$$

$$0.314 \times 266.34 \times 41^\circ\text{C} \times 1.2 = 4143 \text{ W}$$

$$= 14134 \text{ Btu/h}$$

6.2.6 Sensible Gain due to Air Leakage

$$HG_{snlb} = LR_{airc} \times \frac{V_b}{3.6} \times DTD_c \times 1.2$$

$$0.102 \times 266.34 \times 6^\circ\text{C} \times 1.2 = 199 \text{ W}$$

$$= 680 \text{ Btu/h}$$

5.2.3.2 Heat Loss due to Mechanical Ventilation

$$HL_{vairb} = PVC \times DTD_h \times 1.08 \times (1 - E)$$

$$80 \text{ CFM} \times 74^\circ\text{F} \times 1.08 \times 0.25 = 1593 \text{ Btu/h}$$

6.2.7 Sensible heat Gain due to Ventilation

$$HL_{vairb} = PVC \times DTD_h \times 1.08 \times (1 - E)$$

$$80 \text{ CFM} \times 11^\circ\text{F} \times 1.08 \times 0.25 = 236 \text{ Btu/h}$$

5.2.3.3 Calculation of Air Change Heat Loss for Each Room (Floor Multiplier Section)

$$HL_{air-r} = \text{Level Factor} \times HL_{airbv} \times ((HL_{agcr} + HL_{bgcr}) \div (HL_{agclevel} + HL_{bgclevel}))$$

Level	Level Factor (LF)	HL _{airbv} Air Leakage + Ventilation Heat Loss (Btu/h)	Level Conductive Heat Loss: (HL _{clevel})	Air Leakage Heat Loss Multiplier (LF x HL _{airbv} / HL _{clevel})
1	0.5	14,134	8,018	0.881
2	0.3		11,442	0.371
3	0.2		12,313	0.230
4	0		0	0.000
5	0		0	0.000

*HL_{airbv} = Air leakage heat loss + ventilation heat loss

*For a balanced or supply only ventilation system HL_{airve} = 0

CITY OF BRAMPTON
 BUILDING DIVISION
 REVIEWED BY: S. HANNA
 NOV 27 2018
 ATTACHED NOTES ARE PART
 OF REVIEWED DRAWINGS
 ALL WORK MUST COMPLY WITH OBC

HEAT LOSS AND GAIN SUMMARY SHEET

MODEL: MILLWOOD 2	LOT 22	BUILDER: GREENPARK HOMES
SFQT: 2654	LO# 80551	SITE: MINNISALE HOMES CORP

DESIGN ASSUMPTIONS

HEATING	*F	COOLING	*F
OUTDOOR DESIGN TEMP.	-2	OUTDOOR DESIGN TEMP.	86
INDOOR DESIGN TEMP.	72	INDOOR DESIGN TEMP. (MAX 75°F)	75

BUILDING DATA

ATTACHMENT:	DETACHED	# OF STORIES (+BASEMENT):	3
FRONT FACES:	SOUTH	ASSUMED (Y/N):	Y
AIR CHANGES PER HOUR:	3.57	ASSUMED (Y/N):	Y
AIR TIGHTNESS CATEGORY:	AVERAGE	ASSUMED (Y/N):	Y
WIND EXPOSURE:	SHELTERED	ASSUMED (Y/N):	Y
HOUSE VOLUME (ft³):	33860.0	ASSUMED (Y/N):	Y
INTERNAL SHADING:	BLINDS/CURTAINS	ASSUMED OCCUPANTS:	5
INTERIOR LIGHTING LOAD (Btu/h/ft²):	1.65	DC BRUSHLESS MOTOR (Y/N):	Y
FOUNDATION CONFIGURATION	BCIN_1	DEPTH BELOW GRADE:	6.0 ft
LENGTH: 46.0 ft	WIDTH: 31.0 ft	EXPOSED PERIMETER:	138.0 ft

2012 OBC - COMPLIANCE PACKAGE
Component

Ceiling with Attic Space Minimum RSI (R)-Value
Ceiling Without Attic Space Minimum RSI (R)-Value
Exposed Floor Minimum RSI (R)-Value
Walls Above Grade Minimum RSI (R)-Value
Basement Walls Minimum RSI (R)-Value
Below Grade Slab Entire surface > 600 mm below grade Minimum RSI (R)-Value
Edge of Below Grade Slab ≤ 600 mm Below Grade Minimum RSI (R)-Value
Heated Slab or Slab ≤ 600 mm below grade Minimum RSI (R)-Value
Windows and Sliding Glass Doors Maximum U-Value
Skylights Maximum U-Value
Space Heating Equipment Minimum AFUE
HRV Minimum Efficiency
Domestic Hot Water Heater Minimum EF

CITY OF BRAMPTON
BUILDING DIVISION
REVIEWED BY: S. HANNA
NOV 27 2018
ATTACHED NOTES ARE PART
OF REVIEWED DRAWINGS
ALL WORK MUST COMPLY WITH OBC

Compliance Package
A1

Nominal	Min. Eff.
60	59.22
31	27.65
31	29.80
22	17.03
20 ci	21.12
-	-
10	10
10	11.13
0.28	-
0.49	-
0.96	-
75%	-
0.8	-

INDIVIDUAL BCIN: 19669

MICHAEL O'ROURKE

Air Infiltration Residential Load Calculator

Supplemental tool for CAN/CSA-F280

Weather Station Description				
Province:	Ontario			
Region:	Brampton			
Weather Station Location:	Open flat terrain, grass			
Anemometer height (m):	10			
Local Shielding				
Building Site:	Suburban, forest			
Walls:	Heavy			
Flue:	Heavy			
Highest Ceiling Height (m):	6.40			
Building Configuration				
Type:	Detached			
Number of Stories:	Two			
Foundation:	Full			
House Volume (m ³):	958.8			
Air Leakage/Ventilation				
Air Tightness Type:	Present (1961-) (3.57 ACH)			
Custom BDT Data:	ELA @ 10 Pa. 3.57	1278.1 cm ² ACH @ 50 Pa		
Mechanical Ventilation (L/s):	Total Supply 37.5	Total Exhaust 37.5		
Flue Size				
Flue #:	#1	#2	#3	#4
Diameter (mm):	0	0	0	0
Natural Infiltration Rates				
Heating Air Leakage Rate (ACH/H):	0.314			
Cooling Air Leakage Rate (ACH/H):	0.102			


TYPE: MILLWOOD 2
LO# 80551

LOT 22



Residential Foundation Thermal Load Calculator

Supplemental tool for CAN/CSA-F280

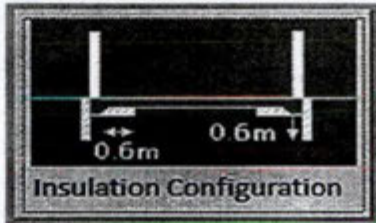Weather Station Description		
Province:	Ontario	
Region:	Brampton	
Site Description		
Soil Conductivity:	Normal conductivity: dry sand, loam, clay	
Water Table:	Normal (7-10 m, 23-33 ft)	
Foundation Dimensions		
Length (m):	0.3	 Insulation Configuration
Width (m):	4.6	
Exposed Perimeter (m):	4.9	
Radiant Slab		
Heated Fraction of the Slab:	0	
Fluid Temperature (°C):	33	
Design Months		
Heating Month:	1	
Results		
Heating Load (Watts):	37	


TYPE: MILLWOOD 2
LO# 80551

LOT 22




Residential Foundation Thermal Load Calculator


Supplemental tool for CAN/CSA-F280

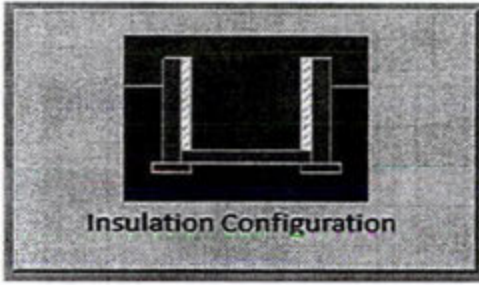Weather Station Description		
Province:	Ontario	
Region:	Brampton	
Site Description		
Soil Conductivity:	Normal conductivity: dry sand, loam, clay	
Water Table:	Normal (7-10 m, 23-33 ft)	
Foundation Dimensions		
Floor Length (m):	14.0	 Insulation Configuration
Floor Width (m):	9.4	
Exposed Perimeter (m):	42.1	
Wall Height (m):	2.7	
Depth Below Grade (m):	1.83	
Window Area (m ²):	1.4	
Door Area (m ²):	3.7	
Radiant Slab		
Heated Fraction of the Slab:	0	
Fluid Temperature (°C):	33	
Design Months		
Heating Month	1	
Foundation Loads		
Heating Load (Watts):	1354	

TYPE: MILLWOOD 2
LO# 80551

LOT 22

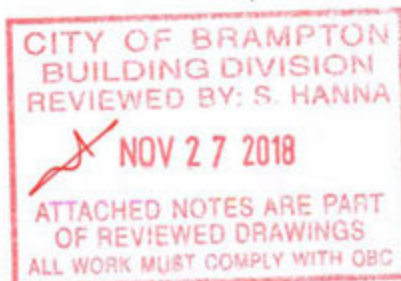

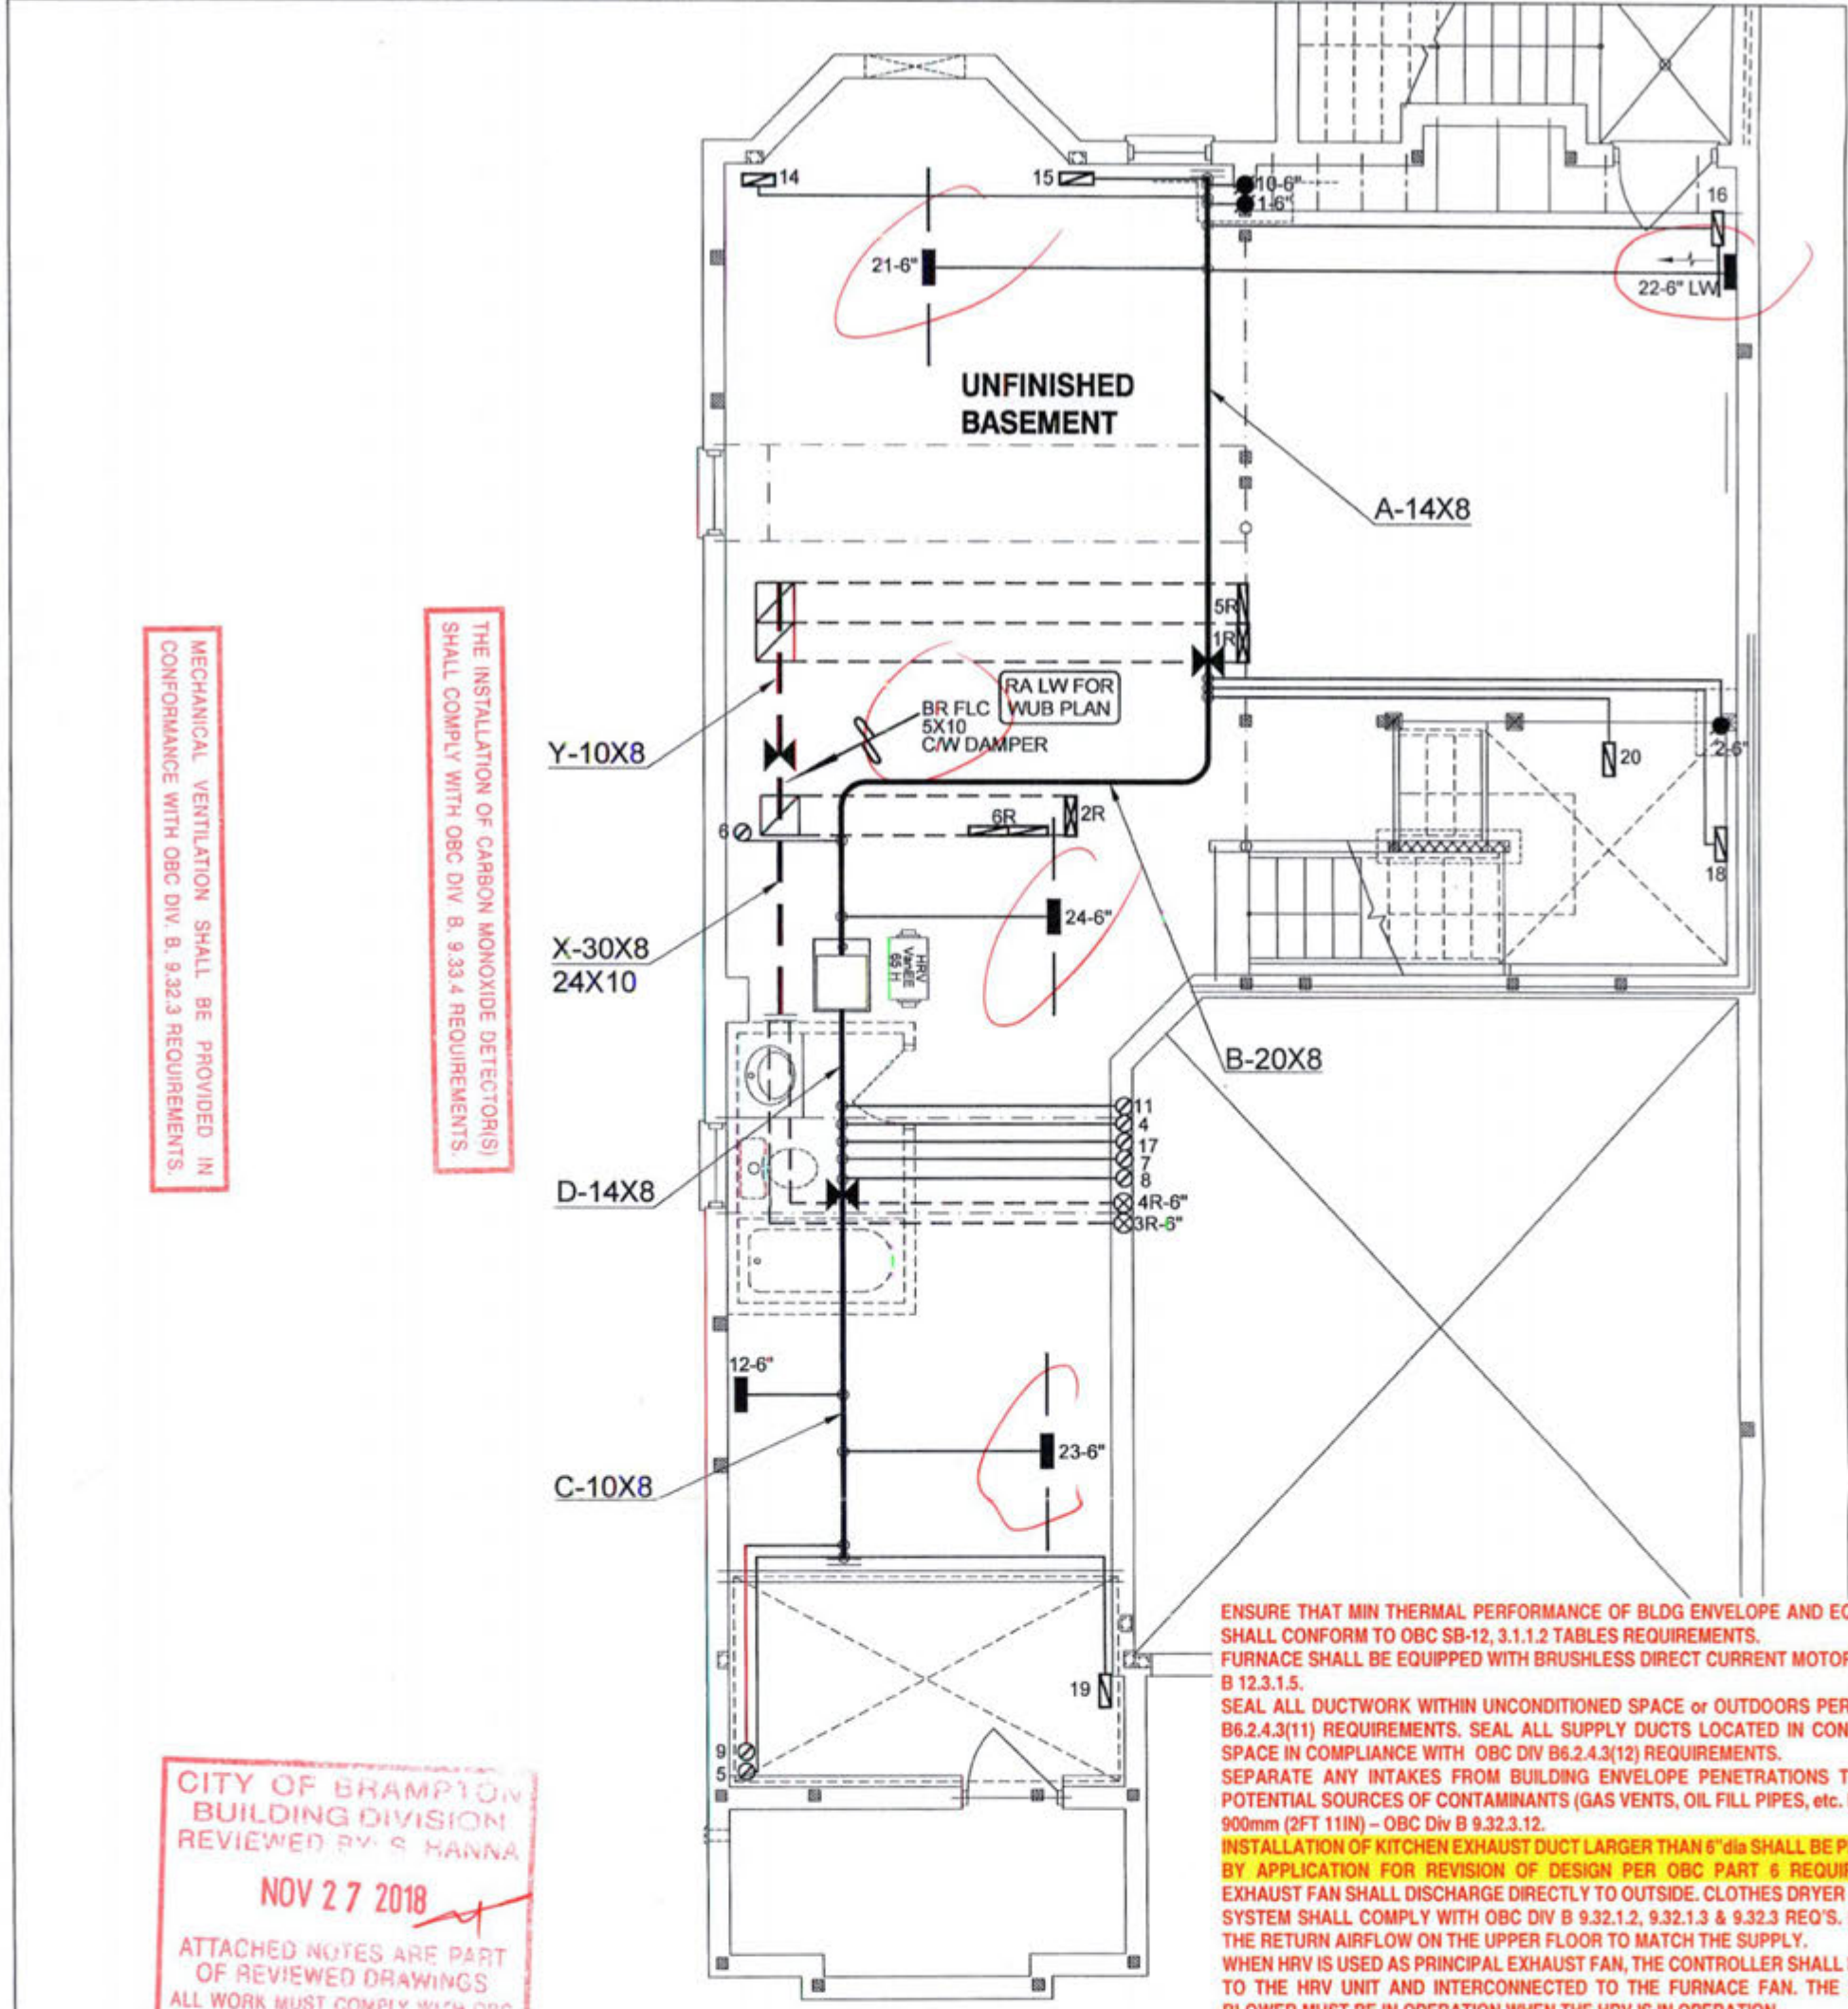

MECHANICAL VENTILATION SHALL BE PROVIDED IN CONFORMANCE WITH OBC DIV. B. 9.32.3 REQUIREMENTS.

THE INSTALLATION OF CARBON MONOXIDE DETECTOR(S) SHALL COMPLY WITH OBC DIV. B. 9.32.4 REQUIREMENTS.

CITY OF BRAMPTON
BUILDING DIVISION
REVIEWED BY S. HANNA
NOV 27 2018
ATTACHED NOTES ARE PART
OF REVIEWED DRAWINGS
ALL WORK MUST COMPLY WITH OBC

INSTALLATION OF HVAC EQUIPMENTS
SHALL CONFORM TO MANUFACTURER'S SPECIFICATIONS
AND MANUALS

ENSURE THAT MIN THERMAL PERFORMANCE OF BLDG ENVELOPE AND EQUIPMENT SHALL CONFORM TO OBC SB-12, 3.1.1.2 TABLES REQUIREMENTS. FURNACE SHALL BE EQUIPPED WITH BRUSHLESS DIRECT CURRENT MOTOR OBC DIV B 12.3.1.5. SEAL ALL DUCTWORK WITHIN UNCONDITIONED SPACE or OUTDOORS PER OBC DIV B6.2.4.3(11) REQUIREMENTS. SEAL ALL SUPPLY DUCTS LOCATED IN CONDITIONED SPACE IN COMPLIANCE WITH OBC DIV B6.2.4.3(12) REQUIREMENTS. SEPARATE ANY INTAKES FROM BUILDING ENVELOPE PENETRATIONS THAT ARE POTENTIAL SOURCES OF CONTAMINANTS (GAS VENTS, OIL FILL PIPES, etc. BY MIN 900mm (2FT 11IN) - OBC Div B 9.32.3.12. INSTALLATION OF KITCHEN EXHAUST DUCT LARGER THAN 6" dia SHALL BE PRECEDED BY APPLICATION FOR REVISION OF DESIGN PER OBC PART 6 REQUIREMENTS. EXHAUST FAN SHALL DISCHARGE DIRECTLY TO OUTSIDE. CLOTHES DRYER EXHAUST SYSTEM SHALL COMPLY WITH OBC DIV B 9.32.1.2, 9.32.1.3 & 9.32.3 REQ'S. BALANCE THE RETURN AIRFLOW ON THE UPPER FLOOR TO MATCH THE SUPPLY. WHEN HRV IS USED AS PRINCIPAL EXHAUST FAN, THE CONTROLLER SHALL BE WIRED TO THE HRV UNIT AND INTERCONNECTED TO THE FURNACE FAN. THE FURNACE BLOWER MUST BE IN OPERATION WHEN THE HRV IS IN OPERATION. INSTALL ADDITIONAL S/A REGISTER AS REQUIRED IN ORDER TO ENSURE MIN 72degF - OBC DIV B 9.32.3.1(1). UNDERCUT BY MIN 1" THE DOOR TO ANY ROOM WITHOUT RETURN AIR GRILLE. ENSURE RETURN AIR INTAKE SHALL BE CONNECTED TO THE MAIN R/A DUCT AT A HORIZONTAL DISTANCE OF MIN 6FT FROM THE CASING OF THE UNIT (HRAI DIGEST).

WUB
CSA-F280-12
LOT 22 PACKAGE A1

I MICHAEL OROURKE HAVE REVIEWED AND TAKE RESPONSIBILITY FOR THE DESIGN WORK AND AM QUALIFIED UNDER DIVISION C, 3.2.3 OF THE BUILDING CODE.
Michael O'Rourke, BCIN 19669
HVAC DESIGNS LTD.

HVAC LEGEND						REVISIONS	
SYMBOL	DESCRIPTION	SYMBOL	DESCRIPTION	SYMBOL	DESCRIPTION	No.	Description
	FLOOR SUPPLY AIR GRILLE		6" SUPPLY AIR BOOT ABOVE		14"x8" RETURN AIR GRILLE	3.	
	FLOOR SUPPLY AIR GRILLE 6" BOOT		SUPPLY AIR STACK FROM 2nd FLOOR		30"x8" RETURN AIR GRILLE	2.	
	SUPPLY AIR BOOT ABOVE		6" SUPPLY AIR STACK 2nd FLOOR		FRA- FLOOR RETURN AIR GRILLE	1.	
					REDUCER	No.	Description

ALL DRAWINGS, CALCULATIONS AND SPECIFICATIONS ARE THE PROPERTY OF HVAC DESIGNS LTD. AND MAY NOT BE REPRODUCED, MODIFIED OR ALTERED WITHOUT EXPRESSED WRITTEN CONSENT. THE DRAWINGS ARE DATED AND USE OF THESE DRAWINGS AFTER ONE YEAR FROM THE DATED NOTED IS NOT AUTHORIZED. CONTRACTOR SHALL CHECK ALL CONDITIONS BEFORE PROCEEDING WITH WORK. LATEST MUNICIPAL APPROVED DRAWINGS ONLY TO BE USED DURING INSTALLATION OF HEATING SYSTEM. HVAC DESIGNS LTD. IS NOT LIABLE FOR ANY CLAIMS ARISING FROM UNAUTHORIZED USE OF THE DRAWINGS OR FROM ANY CHANGES TO ACCEPTED STANDARDS AND/OR THE ONTARIO BUILDING CODE.

Client

GREENPARK HOMES

Project Name

MINNISALE HOMES CORP.

BRAMPTON, ONTARIO

LOT 22
MILLWOOD 2

2654 sqft

HVACDESIGNS LTD.

375 Finley Ave. Suite 202 - Ajax, Ontario
L1S 2E2 Tel. 905.619.2300 - 905.420.5300 Fax 905.619.2375
Email: info@hvacdsgns.ca
Web: www.hvacdsgns.ca
Specializing in Residential Mechanical Design Services

Installation to comply with the latest Ontario Building Code. All supply branch outlets shall be equipped with a manual balancing damper. Ductwork which passes through the garage or unheated damper shall be adequately insulated and be gas-proofed.

HEAT LOSS 48025 BTU/H
UNIT DATA

MAKE	GOODMAN
MODEL	GMEC960603BNA
INPUT	60 MBTUH
OUTPUT	57.6 MBTUH
COOLING	2.5 TONS
FAN SPEED	1131 cfm @ 0.6" w.c.

OF RUNS S/A R/A FANS

3RD FLOOR			
2ND FLOOR	11	4	3
1ST FLOOR	7	2	2
BASEMENT	4	1	0

ALL S/A DIFFUSERS 4" x 10" UNLESS NOTED OTHERWISE ON LAYOUT. ALL S/A RUNS 5" UNLESS NOTED OTHERWISE ON LAYOUT. UNDERCUT DOORS 1" min. FOR R/A

Sheet Title

BASEMENT HEATING LAYOUT

Date OCT/2018

Scale 3/16" = 1'-0"


BCIN# 19669

LO# 80551

THIS INSTALLATION OF A GAS FIREPLACE IS REGULATED UNDER THE T.S.S.A. BY C.S.A. B149.1 NATURAL GAS AND PROPANE INSTALLATION CODE CALL ENBRIDGE FOR INSPECTION AT 1-800-785-1314

CITY OF BRAMPTON
BUILDING DIVISION
REVIEWED BY: S. HANNA
NOV 27 2018
ATTACHED NOTES ARE PART
OF REVIEWED DRAWINGS
ALL WORK MUST COMPLY WITH OBC

I MICHAEL O'BRIEN HAVE REVIEWED AND TAKE RESPONSIBILITY FOR THE DESIGN WORK AND AM QUALIFIED UNDER DIVISION C, 3.3.3 OF THE BUILDING CODE.
Michael O'Brien, BCIN 19669
HVAC DESIGNS LTD.

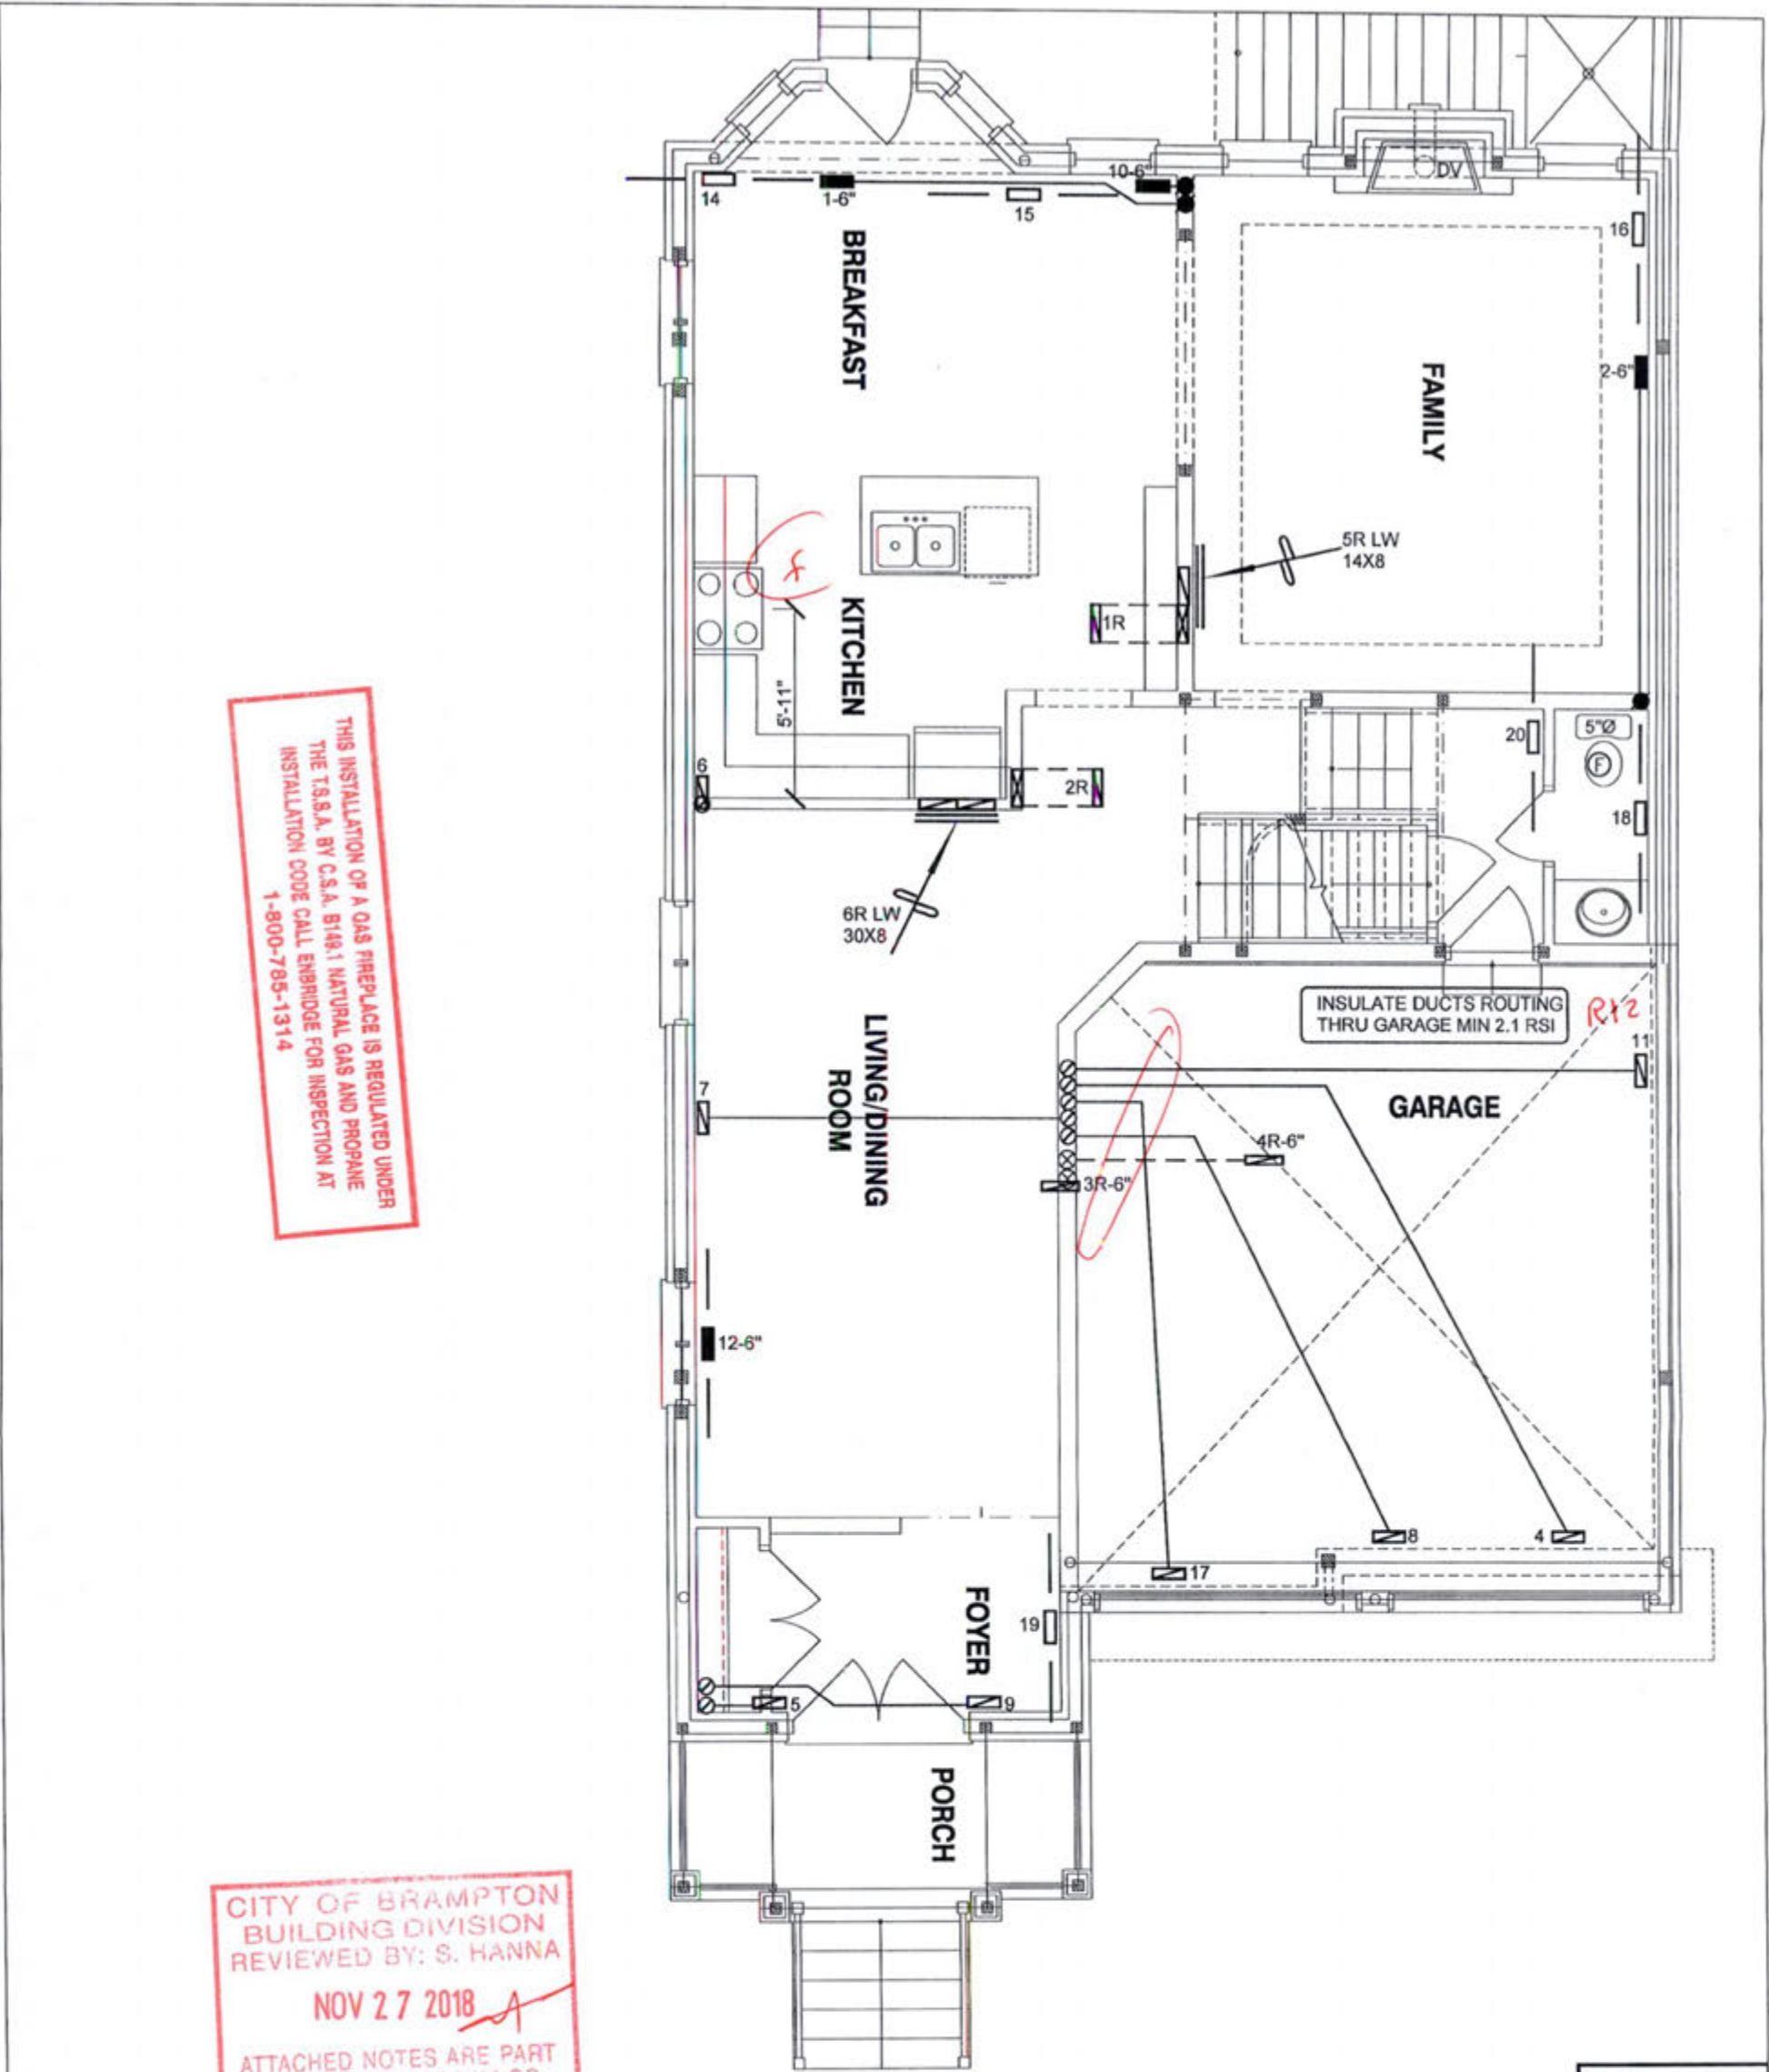


WUB
CSA-F280-12
LOT 22 PACKAGE A1

HVAC LEGEND						3.	
SYMBOL	DESCRIPTION	SYMBOL	DESCRIPTION	SYMBOL	DESCRIPTION	SYMBOL	DESCRIPTION
	FLOOR SUPPLY AIR GRILLE		6" SUPPLY AIR BOOT ABOVE		14"x8" RETURN AIR GRILLE		RETURN AIR STACK ABOVE
	FLOOR SUPPLY AIR GRILLE 6" BOOT		SUPPLY AIR STACK FROM 2nd FLOOR		30"x8" RETURN AIR GRILLE		RETURN AIR STACK 2nd FLOOR
	SUPPLY AIR BOOT ABOVE		6" SUPPLY AIR STACK 2nd FLOOR		FRA- FLOOR RETURN AIR GRILLE		REDUCER
						No.	Description
						Date	

ALL DRAWINGS, CALCULATIONS AND SPECIFICATIONS ARE THE PROPERTY OF HVAC DESIGNS LTD. AND MAY NOT BE REPRODUCED, MODIFIED OR ALTERED WITHOUT EXPRESSED WRITTEN CONSENT. THE DRAWINGS ARE DATED AND USE OF THESE DRAWINGS AFTER ONE YEAR FROM THE DATED NOTE IS NOT AUTHORIZED. CONTRACTOR SHALL CHECK ALL CONDITIONS BEFORE PROCEEDING WITH WORK. LATEST MUNICIPAL APPROVED DRAWINGS ONLY TO BE USED DURING INSTALLATION OF HEATING SYSTEM. HVAC DESIGNS LTD. IS NOT LIABLE FOR ANY CLAIMS ARISING FROM UNAUTHORIZED USE OF THE DRAWINGS OR FROM ANY CHANGES TO ACCEPTED STANDARDS AND/OR THE ONTARIO BUILDING CODE.

Client GREENPARK HOMES		 375 Finley Ave. Suite 202 - Ajax, Ontario L1S 2E2 Tel. 905.619.2300 - 905.420.5300 Fax 905.619.2375 Email: info@hvacdesigns.ca Web: www.hvacdesigns.ca Specializing in Residential Mechanical Design Services Installation to comply with the latest Ontario Building Code. All supply branch outlets shall be equipped with a manual balancing damper. Ductwork which passes through the garage or unheated spaces shall be adequately insulated and be gas-proofed.	Sheet Title FIRST FLOOR HEATING LAYOUT	
Project Name MINNISALE HOMES CORP. BRAMPTON, ONTARIO			Date OCT/2018	Scale 3/16" = 1'-0"
LOT 22 MILLWOOD 2 2654 sqft		BCIN# 19669		
		LO#	80551	

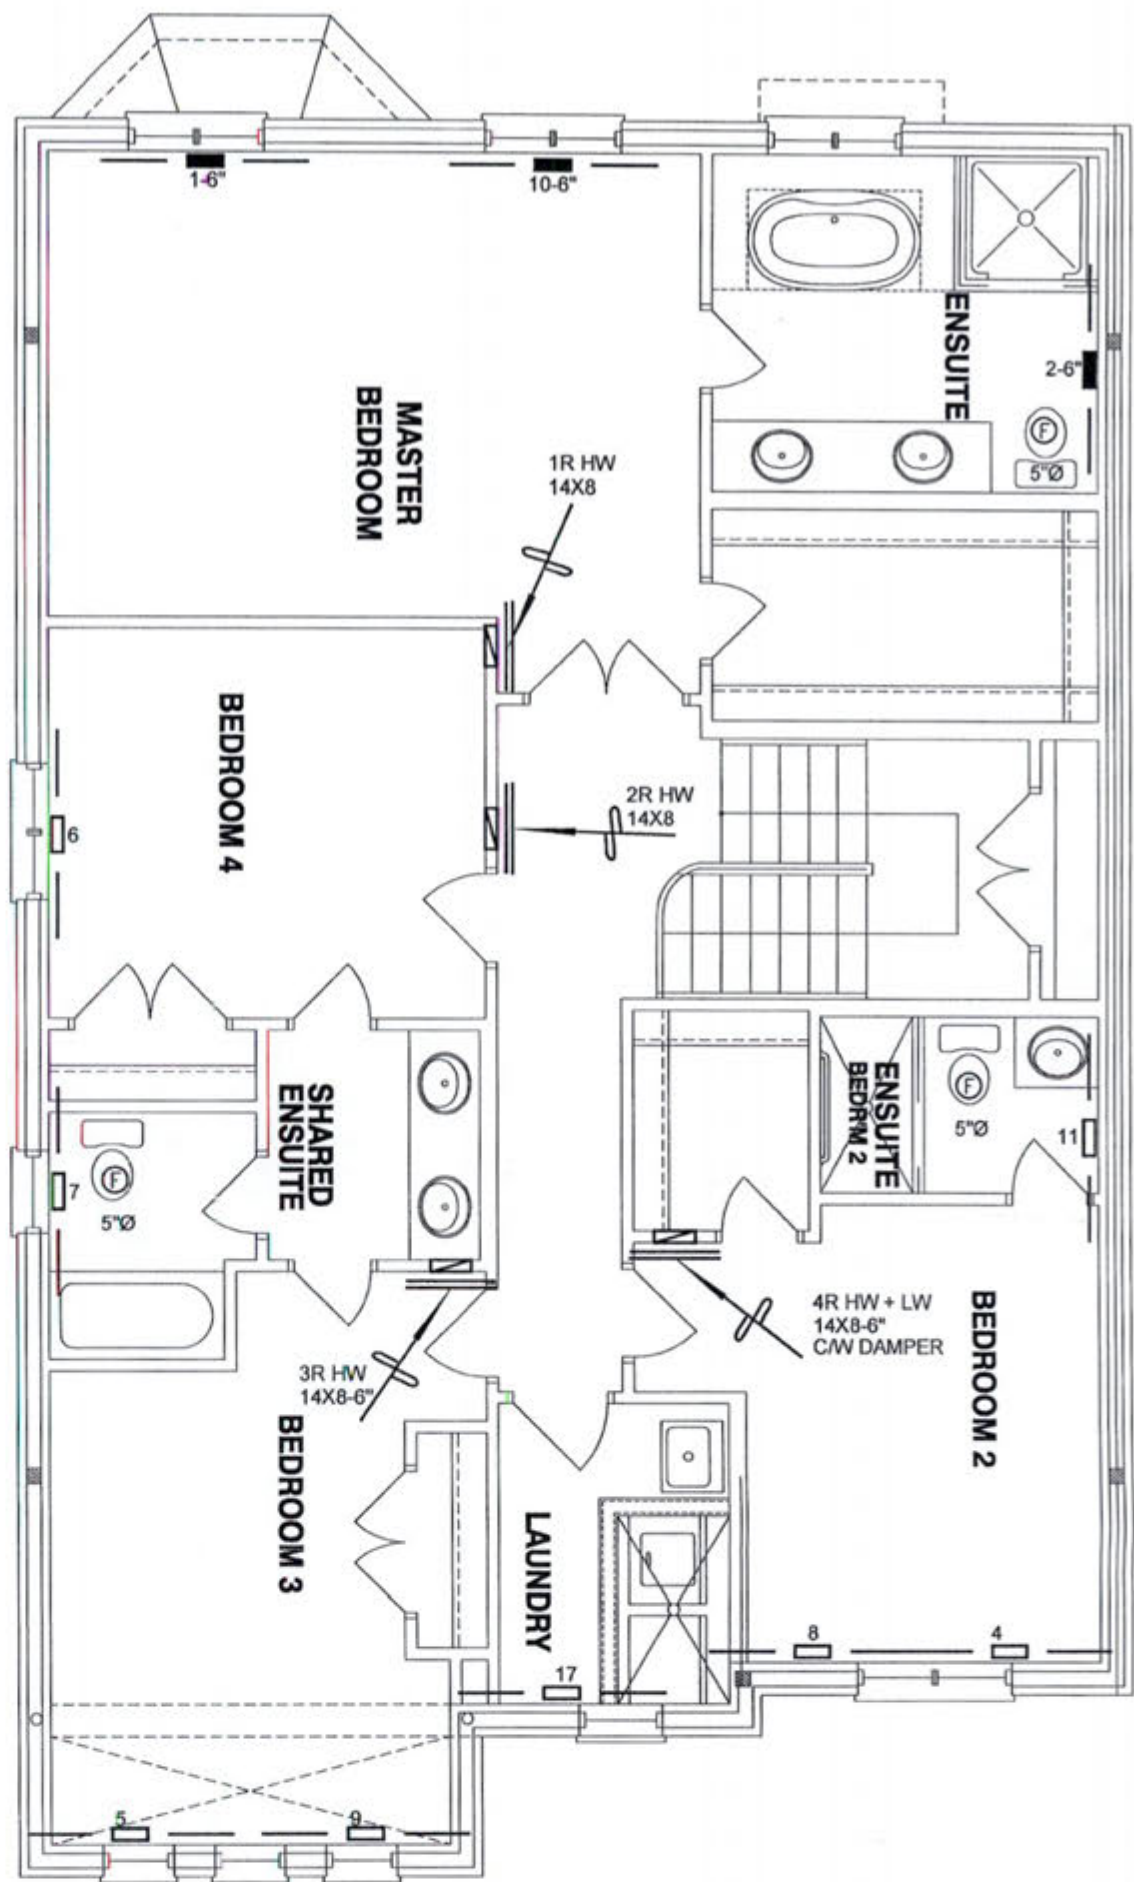

CITY OF BRAMPTON
BUILDING DIVISION
NOV 27 2018
ATTACHED NOTES ARE PART
OF REVIEWED DRAWINGS
ALL WORK MUST COMPLY WITH OBC

WUB
CSA-F280-12
LOT 22 PACKAGE A1

I MICHAEL OROURKE HAVE REVIEWED
AND TAKE RESPONSIBILITY FOR THE
DESIGN WORK AND AM QUALIFIED
UNDER DIVISION C, 12.5 OF THE
BUILDING CODE.
Michael O'Rourke, P.Eng. 19669
HVAC DESIGNS LTD.

HVAC LEGEND								3.	
SYMBOL	DESCRIPTION	SYMBOL	DESCRIPTION	SYMBOL	DESCRIPTION	SYMBOL	DESCRIPTION	2.	
	FLOOR SUPPLY AIR GRILLE		6" SUPPLY AIR BOOT ABOVE		14"x8" RETURN AIR GRILLE		RETURN AIR STACK ABOVE	1.	
	FLOOR SUPPLY AIR GRILLE 6" BOOT		SUPPLY AIR STACK FROM 2nd FLOOR		30"x8" RETURN AIR GRILLE		RETURN AIR STACK 2nd FLOOR	No.	Description Date
	SUPPLY AIR BOOT ABOVE		6" SUPPLY AIR STACK 2nd FLOOR		FRA- FLOOR RETURN AIR GRILLE		REDUCER	REVISIONS	

ALL DRAWINGS, CALCULATIONS AND SPECIFICATIONS ARE THE PROPERTY OF HVAC DESIGNS LTD. AND MAY NOT BE REPRODUCED, MODIFIED OR ALTERED WITHOUT EXPRESSED WRITTEN CONSENT. THE DRAWINGS ARE DATED AND USE OF THESE DRAWINGS AFTER ONE YEAR FROM THE DATED NOTED IS NOT AUTHORIZED. CONTRACTOR SHALL CHECK ALL CONDITIONS BEFORE PROCEEDING WITH WORK. LATEST MUNICIPAL APPROVED DRAWINGS ONLY TO BE USED DURING INSTALLATION OF HEATING SYSTEM. HVAC DESIGNS LTD. IS NOT LIABLE FOR ANY CLAIMS ARISING FROM UNAUTHORIZED USE OF THE DRAWINGS OR FROM ANY CHANGES TO ACCEPTED STANDARDS AND/OR THE ONTARIO BUILDING CODE.

Client GREENPARK HOMES		 375 Finley Ave. Suite 202 - Ajax, Ontario L1S 2E2 Tel. 905.619.2300 - 905.420.5300 Fax 905.619.2375 Email: info@hvacdesigns.ca Web: www.hvacdesigns.ca Specializing in Residential Mechanical Design Services Installation to comply with the latest Ontario Building Code. All supply branch outlets shall be equipped with a manual balancing damper. Ductwork which passes through the garage or unheated spaces shall be adequately insulated and be gas-proofed.	Sheet Title SECOND FLOOR HEATING LAYOUT	
Project Name MINNISALE HOMES CORP. BRAMPTON, ONTARIO			Date OCT/2018	
LOT 22 MILLWOOD 2			Scale 3/16" = 1'-0"	
2654 sqft			BCIN# 19669	
			LO# 80551	