

SITE NAME: MINNISALE HOMES CORP
BUILDER: GREENPARK HOMES

LOT 28
TYPE: MILLWOOD 2

GFA: 2554

DATE: Aug-18
LOF 79551

WINTER NATURAL AIR CHANGE RATE 0.354
SUMMER NATURAL AIR CHANGE RATE 0.115

HEAT LOSS AT °F. 74
HEAT GAIN AT °F. 11

CSA-F280-12
SB-12 PACKAGE A1

ROOM USE			MBR		ENS		BED-2		BED-3		BED-4		BATH						ENS-2					
EXP. WALL			34		29		26		33		11		10						15					
CLG. HT.			10		9		9		10		9		9						9					
FACTORS																								
GRS.WALL AREA	LOSS	GAIN	340		261		234		339		99		90						135					
GLAZING	LOSS	GAIN			LOSS GAIN		LOSS GAIN		LOSS GAIN		LOSS GAIN		LOSS GAIN						LOSS GAIN					
NORTH	20.8	15.5	0	0	0	0	0	0	0	0	0	0	0	0	0	0	0	0	0	0	0	0	0	0
EAST	20.8	41.0	0	0	0	0	0	0	0	0	0	0	0	0	0	0	0	0	0	0	0	0	0	0
SOUTH	20.8	24.4	0	0	0	0	0	0	0	0	0	12	249	293	8	166	195			0	0	0	0	0
WEST	20.8	41.0	32	665	1314	12	249	493	0	0	0	0	0	0	0	0	0	0	0	0	0	0	0	0
SKYLT.	36.4	100.7	0	0	0	0	0	0	0	0	0	0	0	0	0	0	0	0	0	0	0	0	0	0
DOORS	24.7	3.7	0	0	0	0	0	0	0	0	0	0	0	0	0	0	0	0	0	0	0	0	0	0
NET EXPOSED WALL	4.4	0.6	308	1342	199	249	1085	161	214	932	138	300	1307	194	87	379	66	82	357	53	135	688	87	
NET EXPOSED BMT WALL ABOVE GR	3.5	0.5	0	0	0	0	0	0	0	0	0	0	0	0	0	0	0	0	0	0	0	0	0	0
EXPOSED CLG	1.3	0.6	280	351	156	204	256	114	165	207	92	196	244	109	220	276	123	176	221	98	168	210	94	
NO ATTIC EXPOSED CLG	2.7	1.2	0	0	0	0	0	0	0	0	0	40	107	48	0	0	0	0	0	0	0	0	0	0
EXPOSED FLOOR	2.5	0.4	0	0	0	0	0	0	165	411	61	0	0	0	0	0	0	0	0	0	163	418	62	
BASEMENT/CRAWL HEAT LOSS					0						0			0			0						0	
SLAB ON GRADE HEAT LOSS					0						0			0			0						0	
SUBTOTAL HT LOSS			2358		1590		1965		2282		904		744				1217							
SUB TOTAL HT GAIN					1669		767		1112		1582		472		346				243					
LEVEL FACTOR / MULTIPLIER	0.20	0.28			0.20		0.28		0.20		0.28		0.20		0.28		0.20		0.28					
AIR CHANGE HEAT LOSS			653		440		544		632		260		206				337							
AIR CHANGE HEAT GAIN					133		61		88		126		37		27				19					
DUCT LOSS			0		0		251		0		0		0		0		165							
DUCT GAIN					0		207		0		0		0		0		26							
HEAT GAIN PEOPLE	240	2	440		0		1		240		1		240		0		0		0					
HEAT GAIN APPLIANCES/LIGHTS			627		627		627		627		627		627		627		0							
TOTAL HT LOSS BTUH			3010		2030		2761		2914		1154		950				1709							
TOTAL HT GAIN x 1.3 BTUH			3761		1892		2957		3347		1789		1301				375							

ROOM USE	EXP. WALL	CLG. HT.	LIV	KT/PM	LAUN	WIR	FOY	MUD	WOD	BAS
			38	78	8	12	27	17	50	154
			10	10	9	11	10	11	9	9
FACTORS	LOSS	GAIN	LOSS	GAIN	LOSS	GAIN	LOSS	GAIN	LOSS	GAIN
GRS.WALL AREA	20.8	15.5	0	0	0	0	0	0	0	0
GLAZING	20.8	41.0	0	0	0	0	0	0	0	0
NORTH	20.8	24.4	40	831	976	0	0	0	0	0
EAST	20.8	41.0	0	0	0	0	0	0	0	0
SOUTH	20.8	41.0	0	0	0	0	0	0	0	0
WEST	20.8	41.0	0	0	0	0	0	0	0	0
SKYL.T.	36.4	100.7	0	0	0	0	0	0	0	0
DOORS	24.7	3.7	0	0	0	0	0	0	0	0
NET EXPOSED WALL	4.4	0.6	340	1481	220	688	2993	444	293	1029
NET EXPOSED BMT WALL ABOVE GR	3.5	0.5	0	0	0	0	0	0	0	0
EXPOSED CLG	1.3	0.6	0	0	0	0	0	0	0	0
NO ATTIC EXPOSED CLG	2.7	1.2	0	0	0	0	0	0	0	0
EXPOSED FLOOR	2.5	0.4	0	0	0	0	0	0	0	0
BASEMENT/CRAWL HEAT LOSS			0	0	0	0	0	0	0	0
SLAB ON GRADE HEAT LOSS			0	0	0	0	0	0	0	0
SUBTOTAL HT LOSS			2312		1196		5083		3516	
SUB TOTAL HT GAIN				1196		3516		5083		3516
LEVEL FACTOR / MULTIPLIER	0.30	0.44			0.30	0.44			0.30	0.44
AIR CHANGE HEAT LOSS			1023		2249		265		265	
AIR CHANGE HEAT GAIN				95		279		46		7
DUCT LOSS			0		0		122		0	
DUCT GAIN				0		0		124		0
HEAT GAIN PEOPLE	240	0		0	0	0	0	0	0	0
HEAT GAIN APPLIANCES/LIGHTS				627		627		627		627
TOTAL HT LOSS BTUH			3326		7332		1344		830	
TOTAL HT GAIN x 1.3 BTUH				2493		6748		1776		120

ATTACHED NOTES ARE PART
OF THE REVIEWED DRAWINGS
ALL WORK MUST BE COMPLETED BY
JAN 23 2019
CITY OF BRAMPTON
BUILDING DIVISION
REVIEWED BY: S. HANNA

TOTAL HEAT GAIN BTUH: 29751 TONS: 2.40 LOSS DUE TO VENTILATION LOAD BTUH: 1593 STRUCTURAL HEAT LOSS: 48196 TOTAL COMBINED HEAT LOSS BTUH: 49688

SITE NAME: MINNISSALE HOMES CORP
BUILDER: GREENPARK HOMES

TYPE: MILLWOOD 2

DATE: Aug-18

GFA: 2654 LO# 79581

HEATING CFM 1131 COOLING CFM 1131
TOTAL HEAT LOSS 48,106 TOTAL HEAT GAIN 28,515
AIR FLOW RATE CFM 23.51 AIR FLOW RATE CFM 39.66

furnace pressure 0.6
furnace filter 0.05
a/c coil pressure 0.2
available pressure for s/a & r/a 0.35

#GOODMAN
GMCC980603BNA 60
FAN SPEED LOW
MEDLOW
MEDIUM
MEDIUM HIGH
HIGH 1131

AFUE = 96 %
INPUT (BTU/H) = 60,000
OUTPUT (BTU/H) = 57,600

DESIGN CFM = 1131
CFM @ 6" E.S.P.

RUN COUNT	4th	3rd	2nd	1st	Bas
S/A	0	0	11	7	4
R/A	0	0	4	2	1

All S/A diffusers 4"x10" unless noted otherwise on layout.
All S/A runs 5"Ø unless noted otherwise on layout.

plenum pressure s/a 0.16 r/a pressure 0.17
max s/a dif press. loss 0.02 r/a grille press. Loss 0.02
min adjusted pressure s/a 0.16 adjusted pressure r/a 0.15

RUN #	1	2	4	5	6	7	8	9	10	11	12	14	15	16	17	18	19	20	21	22	23	24
ROOM NAME	MBR	ENS	BED-2	BED-3	BED-4	BATH	BED-2	BED-3	MBR	ENS-2	LIV	KT/FM	KT/FM	KT/FM	LAUN	WR	FOY	MUD	BAS	BAS	BAS	BAS
RM LOSS MBH	1.51	2.03	1.38	1.46	1.15	0.95	1.38	1.46	1.51	1.71	3.34	2.44	2.44	2.44	1.34	0.83	3.01	1.76	3.99	3.99	3.99	3.99
CFM PER RUN HEAT	35	48	32	34	27	22	32	34	35	40	78	57	57	57	32	20	71	41	94	94	94	94
RM GAIN MBH	1.89	1.89	1.48	1.67	1.79	1.30	1.48	1.67	1.89	0.37	2.49	1.92	1.92	1.92	1.78	0.12	0.75	1.07	0.28	0.28	0.28	0.28
CFM PER RUN COOLING	75	75	59	66	71	52	59	66	75	15	99	76	76	76	70	5	30	42	11	11	11	11
ADJUSTED PRESSURE	0.17	0.17	0.17	0.17	0.17	0.17	0.17	0.17	0.17	0.17	0.16	0.17	0.17	0.17	0.17	0.17	0.17	0.17	0.16	0.16	0.16	0.16
ACTUAL DUCT LGH	55	54	46	33	15	37	47	47	45	38	15	48	44	49	39	39	29	32	39	39	20	10
EQUIVALENT LENGTH	190	160	140	140	160	110	140	160	150	140	120	130	110	140	130	140	90	160	150	160	110	150
TOTAL EFFECTIVE LENGTH	245	214	186	173	175	147	187	207	195	178	135	178	154	189	169	179	119	192	189	199	130	160
ADJUSTED PRESSURE	0.07	0.08	0.09	0.1	0.1	0.12	0.09	0.08	0.09	0.1	0.12	0.1	0.11	0.09	0.1	0.1	0.14	0.09	0.09	0.08	0.12	0.1
ROUND DUCT SIZE	6	6	5	5	5	4	5	5	5	4	6	5	5	5	5	4	5	4	6	6	6	6
HEATING VELOCITY (ft/min)	178	245	235	250	198	252	235	250	257	459	398	419	419	419	235	229	521	470	479	479	479	479
COOLING VELOCITY (ft/min)	382	382	433	485	521	597	433	485	551	172	505	558	558	558	514	57	220	482	56	56	56	56
OUTLET GRILL SIZE	4X10	4X10	3X10	3X10	3X10	3X10	3X10	3X10	3X10	3X10	4X10	3X10	3X10	3X10	3X10	3X10	3X10	3X10	4X10	4X10	4X10	4X10
TRUNK	A	B	D	C	B	D	D	C	A	D	C	A	A	A	D	B	C	B	A	A	C	B

RUN #	1	2	4	5	6	7	8	9	10	11	12	14	15	16	17	18	19	20	21	22	23	24
ROOM NAME	MBR	ENS	BED-2	BED-3	BED-4	BATH	BED-2	BED-3	MBR	ENS-2	LIV	KT/FM	KT/FM	KT/FM	LAUN	WR	FOY	MUD	BAS	BAS	BAS	BAS
RM LOSS MBH	1.51	2.03	1.38	1.46	1.15	0.95	1.38	1.46	1.51	1.71	3.34	2.44	2.44	2.44	1.34	0.83	3.01	1.76	3.99	3.99	3.99	3.99
CFM PER RUN HEAT	35	48	32	34	27	22	32	34	35	40	78	57	57	57	32	20	71	41	94	94	94	94
RM GAIN MBH	1.89	1.89	1.48	1.67	1.79	1.30	1.48	1.67	1.89	0.37	2.49	1.92	1.92	1.92	1.78	0.12	0.75	1.07	0.28	0.28	0.28	0.28
CFM PER RUN COOLING	75	75	59	66	71	52	59	66	75	15	99	76	76	76	70	5	30	42	11	11	11	11
ADJUSTED PRESSURE	0.17	0.17	0.17	0.17	0.17	0.17	0.17	0.17	0.17	0.17	0.16	0.17	0.17	0.17	0.17	0.17	0.17	0.17	0.16	0.16	0.16	0.16
ACTUAL DUCT LGH	55	54	46	33	15	37	47	47	45	38	15	48	44	49	39	39	29	32	39	39	20	10
EQUIVALENT LENGTH	190	160	140	140	160	110	140	160	150	140	120	130	110	140	130	140	90	160	150	160	110	150
TOTAL EFFECTIVE LENGTH	245	214	186	173	175	147	187	207	195	178	135	178	154	189	169	179	119	192	189	199	130	160
ADJUSTED PRESSURE	0.07	0.08	0.09	0.1	0.1	0.12	0.09	0.08	0.09	0.1	0.12	0.1	0.11	0.09	0.1	0.1	0.14	0.09	0.09	0.08	0.12	0.1
ROUND DUCT SIZE	6	6	5	5	5	4	5	5	5	4	6	5	5	5	5	4	5	4	6	6	6	6
HEATING VELOCITY (ft/min)	178	245	235	250	198	252	235	250	257	459	398	419	419	419	235	229	521	470	479	479	479	479
COOLING VELOCITY (ft/min)	382	382	433	485	521	597	433	485	551	172	505	558	558	558	514	57	220	482	56	56	56	56
OUTLET GRILL SIZE	4X10	4X10	3X10	3X10	3X10	3X10	3X10	3X10	3X10	3X10	4X10	3X10	3X10	3X10	3X10	3X10	3X10	3X10	4X10	4X10	4X10	4X10
TRUNK	A	B	D	C	B	D	D	C	A	D	C	A	A	A	D	B	C	B	A	A	C	B

CITY OF BRAMPTON
BUILDING DIVISION
REVIEWED BY: S. HANNA

JAN 23 2019

ATTACHED NOTES ARE PART
OF REVIEWED DRAWINGS
ALL WORK MUST COMPLY WITH OBC

SUPPLY AIR TRUNK SIZE

TRUNK					STATIC		ROUND		RECT		VELOCITY		TRUNK					STATIC		ROUND		RECT		VELOCITY							
CFM					PRESS.		DUCT		DUCT		(ft/min)		CFM					PRESS.		DUCT		DUCT		(ft/min)							
TRUNK A	429	0.07	10.6	14	x	8	552	TRUNK G	0	0.00	0	0	x	8	0	TRUNK H	0	0.00	0	0	x	8	0	TRUNK I	0	0.00	0	0	x	8	0
TRUNK B	659	0.07	12.4	18	x	8	659	TRUNK J	0	0.00	0	0	x	8	0	TRUNK K	0	0.00	0	0	x	8	0	TRUNK L	0	0.00	0	0	x	8	0
TRUNK C	311	0.08	9.1	10	x	8	560																								
TRUNK D	469	0.08	10.6	14	x	8	603																								
TRUNK E	0	0.00	0	0	x	8	0																								
TRUNK F	0	0.00	0	0	x	8	0																								

RETURN AIR TRUNK SIZE

	TRUNK	STATIC	ROUND	RECT			VELOCITY
	CFM	PRESS.	DUCT	DUCT			(ft/min)
TRUNK O	0	0.07	0	0	x	8	0
TRUNK P	0	0.07	0	0	x	8	0
TRUNK Q	0	0.07	0	0	x	8	0
TRUNK R	0	0.07	0	0	x	8	0
TRUNK S	0	0.07	0	0	x	8	0
TRUNK T	0	0.07	0	0	x	8	0
TRUNK U	0	0.07	0	0	x	8	0
TRUNK V	0	0.07	0	0	x	8	0
TRUNK W	0	0.07	0	0	x	8	0
TRUNK X	1131	0.07	15.2	30	x	8	679
TRUNK Y	290	0.07	9.1	10	x	8	522
TRUNK Z	0	0.07	0	0	x	8	0
DROP	1131	0.07	15.2	24	x	10	679

RETURN AIR

1	2	3	4	5	6	7	8	9	10	11	12	14	15	16	17	18	19	20	21	22	23	24
0	0	0	0	0	0	0	0	0	0	0	0	0	0	0	0	0	0	0	0	0	0	0
155	155	95	95	135	310	0	0	0	0	0	0	0	0	0	0	0	0	0	0	0	0	0
0.15	0.15	0.15	0.15	0.15	0.15	0.15	0.15	0.15	0.15	0.15	0.15	0.15	0.15	0.15	0.15	0.15	0.15	0.15	0.15	0.15	0.15	0.15
58	43	42	48	38	15	1	1	1	1	1	1	1	1	1	1	1	1	1	1	1	1	1
150	135	175	175	145	135	0	0	0	0	0	0	0	0	0	0	0	0	0	0	0	0	0
208	178	217	223	183	150	1	1	1	1	1	1	1	1	1	1	1	1	1	1	1	1	1
0.07	0.08	0.07	0.07	0.08	0.10	14.80	14.80	14.80	14.80	14.80	14.80	14.80	14.80	14.80	14.80	14.80	14.80	14.80	14.80	14.80	14.80	14.80
7.2	7	6	6	6.6	8.6	0	0	0	0	0	0	0	0	0	0	0	0	0	0	0	0	0
8	8	8	8	8	8	0	0	0	0	0	0	0	0	0	0	0	0	0	0	0	0	0
X	X	X	X	X	X	X	X	X	X	X	X	X	X	X	X	X	X	X	X	X	X	X
14	14	14	14	14	30	0	0	0	0	0	0	0	0	0	0	0	0	0	0	0	0	0

TYPE: MILLWOOD 2
SITE NAME: MINNISALE HOMES CORP

LO # 79581

RESIDENTIAL MECHANICAL VENTILATION DESIGN SUMMARY

COMBUSTION APPLIANCES		9.32.3.1(1)
a) ☐	Direct vent (sealed combustion) only	
b) ☐	Positive venting induced draft (except fireplaces)	
c) ☐	Natural draft, B-vent or induced draft gas fireplace	
d) ☐	Solid Fuel (including fireplaces)	
e) ☐	No Combustion Appliances	

HEATING SYSTEM	
☒	Forced Air
☐	Non Forced Air
☐	Electric Space Heat

HOUSE TYPE		9.32.1(2)
☐	I Type a) or b) appliance only, no solid fuel	
☐	II Type I except with solid fuel (including fireplaces)	
☐	III Any Type c) appliance	
☐	IV Type I, or II with electric space heat	
☐	Other: Type I, II or IV no forced air	

SYSTEM DESIGN OPTIONS		O.N.H.W.P.
☐	1 Exhaust only/Forced Air System	
☐	2 HRV with Ducting/Forced Air System	
☒	3 HRV Simplified/connected to forced air system	
☐	4 HRV with Ducting/on forced air system	
☐	Part 6 Design	

TOTAL VENTILATION CAPACITY		9.32.3.3(1)
Basement + Master Bedroom	2 @ 21.2 cfm	42.4 cfm
Other Bedrooms	3 @ 10.6 cfm	31.8 cfm
Kitchen & Bathrooms	5 @ 10.6 cfm	53 cfm
Other Rooms	6 @ 10.6 cfm	63.6 cfm
Table 9.32.3.A.	TOTAL	190.8 cfm

PRINCIPAL VENTILATION CAPACITY REQUIRED		9.32.3.4.(1)
1 Bedroom	31.8	cfm
2 Bedroom	47.7	cfm
3 Bedroom	63.6	cfm
4 Bedroom	79.5	cfm
5 Bedroom	95.4	cfm
TOTAL	79.5	cfm

SUPPLEMENTAL VENTILATION CAPACITY		9.32.3.5.
Total Ventilation Capacity	190.8	cfm
Less Principal Ventil. Capacity	79.5	cfm
Required Supplemental Capacity	111.3	cfm

PRINCIPAL EXHAUST FAN CAPACITY	
Model:	VANEE 65H
Location:	BSMT
79.5 cfm	3.0 sones
☒ HVI Approved	

PRINCIPAL EXHAUST HEAT LOSS CALCULATION	
CFM	ΔT °F
79.5 CFM	74 F
X	X
FACTOR	% LOSS
1.08	0.25
X	X

SUPPLEMENTAL FANS		PANASONIC	
Location	Model	cfm	HVI
ENS	FV-05-11VK1	50	✓
BATH	FV-05-11VK1	50	✓
ENS-2	FV-05-11VK1	50	✓
WR	FV-05-11VK1	50	✓

HEAT RECOVERY VENTILATOR		9.32.3.11.
Model:	VANEE 65H	
155 cfm high	64 cfm low	
75 % Sensible Efficiency	☒ HVI Approved	
@ 32 deg F (0 deg C)		

LOCATION OF INSTALLATION	
Lot:	Concession
Township	Plan:
Address	
Roll #	Building Permit #

BUILDER:	
GREENPARK HOMES	
Name:	
Address:	
City:	
Telephone #:	Fax #:

INSTALLING CONTRACTOR	
Name:	
Address:	
City:	
Telephone #:	Fax #:

DESIGNER CERTIFICATION	
I hereby certify that this ventilation system has been designed in accordance with the Ontario Building Code.	
Name:	HVAC Designs Ltd.
Signature:	<i>Michael O'Rourke</i>
HRAJ #	001820
Date:	August-18

I REVIEW AND TAKE RESPONSIBILITY FOR THE DESIGN WORK AND AM QUALIFIED IN THE APPROPRIATE CATEGORY AS AN "OTHER DESIGNER" UNDER DIVISION C, 3.2.6 OF THE BUILDING CODE.
INDIVIDUAL BCIN: 19669 *Michael O'Rourke* MICHAEL O'ROURKE

CSA F280-12 Residential Heat Loss and Heat Gain Calculations
Formula Sheet (For Air Leakage / Ventilation Calculation)

LO#: 79581

Model: MILLWOOD 2

Builder: GREENPARK HOMES

Date: 8/8/2018

Volume Calculation
House Volume

Level	Floor Area (ft ²)	Floor Height (ft)	Volume (ft ³)
Bsmt	1148	9	10332
First	1148	10	11480
Second	1506	9	13554
Third	0	9	0
Fourth	0	9	0
Total:			35,366.0 ft ³
Total:			1001.5 m ³

Air Change & Delta T Data

WINTER NATURAL AIR CHANGE RATE	0.354
SUMMER NATURAL AIR CHANGE RATE	0.115

Design Temperature Difference

	Tin °C	Tout °C	ΔT °C	ΔT °F
Winter DTDh	22	-19	41	74
Summer DTDc	24	30	6	11

5.2.3.1 Heat Loss due to Air Leakage

$$HL_{airb} = LR_{airh} \times \frac{V_b}{3.6} \times DTD_h \times 1.2$$

$$0.354 \times 278.18 \times 41^\circ\text{C} \times 1.2 = 4875 \text{ W}$$

$$= 16633 \text{ Btu/h}$$

6.2.6 Sensible Gain due to Air Leakage

$$HG_{salb} = LR_{airc} \times \frac{V_b}{3.6} \times DTD_c \times 1.2$$

$$0.115 \times 278.18 \times 6^\circ\text{C} \times 1.2 = 235 \text{ W}$$

$$= 802 \text{ Btu/h}$$

5.2.3.2 Heat Loss due to Mechanical Ventilation

$$HL_{vaib} = PVC \times DTD_h \times 1.08 \times (1 - E)$$

$$80 \text{ CFM} \times 74^\circ\text{F} \times 1.08 \times 0.25 = 1593 \text{ Btu/h}$$

6.2.7 Sensible heat Gain due to Ventilation

$$HL_{vaib} = PVC \times DTD_h \times 1.08 \times (1 - E)$$

$$80 \text{ CFM} \times 11^\circ\text{F} \times 1.08 \times 0.25 = 236 \text{ Btu/h}$$


5.2.3.3 Calculation of Air Change Heat Loss for Each Room (Floor Multiplier Section)

$$HL_{airr} = \text{Level Factor} \times HL_{airbv} \times ((HL_{agcr} + HL_{bgcr}) + (HL_{agcleve} + HL_{bgcleve}))$$

Level	Level Factor (LF)	HLairbv Air Leakage + Ventilation Heat Loss (Btu/h)	Level Conductive Heat Loss: (HL _{level})	Air Leakage Heat Loss Multiplier (LF x HLairbv / HLlevel)
1	0.5	16,633	7,649	1.087
2	0.3		11,278	0.442
3	0.2		12,017	0.277
4	0		0	0.000
5	0		0	0.000

*HLairbv = Air leakage heat loss + ventilation heat loss

*For a balanced or supply only ventilation system HLairve = 0

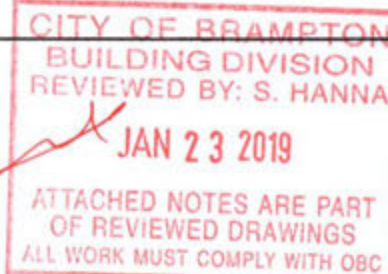

HEAT LOSS AND GAIN SUMMARY SHEET

MODEL: MILLWOOD 2

BUILDER: GREENPARK HOMES

SFQT: 2654

LO# 79581

SITE: MINNISSALE HOMES CORP

DESIGN ASSUMPTIONS

HEATING	*F	COOLING	*F
OUTDOOR DESIGN TEMP.	-2	OUTDOOR DESIGN TEMP.	86
INDOOR DESIGN TEMP.	72	INDOOR DESIGN TEMP. (MAX 75°F)	75

BUILDING DATA

ATTACHMENT:	DETACHED	# OF STORIES (+BASEMENT):	3
FRONT FACES:	EAST	ASSUMED (Y/N):	Y
AIR CHANGES PER HOUR:	3.57	ASSUMED (Y/N):	Y
AIR TIGHTNESS CATEGORY:	AVERAGE	ASSUMED (Y/N):	Y
WIND EXPOSURE:	SHELTERED	ASSUMED (Y/N):	Y
HOUSE VOLUME (ft³):	35366.0	ASSUMED (Y/N):	Y
INTERNAL SHADING:	BLINDS/CURTAINS	ASSUMED OCCUPANTS:	5
INTERIOR LIGHTING LOAD (Btu/h/ft²):	1.65	DC BRUSHLESS MOTOR (Y/N):	Y
FOUNDATION CONFIGURATION	BCIN_1	DEPTH BELOW GRADE:	6.0 ft
LENGTH: 46.0 ft	WIDTH: 31.0 ft	EXPOSED PERIMETER:	154.0 ft

2012 OBC - COMPLIANCE PACKAGE
Component

Ceiling with Attic Space Minimum RSI (R)-Value
Ceiling Without Attic Space Minimum RSI (R)-Value
Exposed Floor Minimum RSI (R)-Value
Walls Above Grade Minimum RSI (R)-Value
Basement Walls Minimum RSI (R)-Value
Below Grade Slab Entire surface > 600 mm below grade Minimum RSI (R)-Value
Edge of Below Grade Slab ≤ 600 mm Below Grade Minimum RSI (R)-Value
Heated Slab or Slab ≤ 600 mm below grade Minimum RSI (R)-Value
Windows and Sliding Glass Doors Maximum U-Value
Skylights Maximum U-Value
Space Heating Equipment Minimum AFUE
HRV Minimum Efficiency
Domestic Hot Water Heater Minimum EF

CITY OF BRAMPTON
BUILDING DIVISION
REVIEWED BY: S. HANNA
JAN 23 2019
ATTACHED NOTES ARE PART
OF REVIEWED DRAWINGS
ALL WORK MUST COMPLY WITH OBC

Compliance Package A1

Nominal	Min. Eff.
60	59.22
31	27.65
31	29.80
22	17.03
20 ci	21.12
-	-
10	10
10	11.13
0.28	-
0.49	-
0.96	-
75%	-
0.8	-


INDIVIDUAL BCIN: 19669


MICHAEL O'ROURKE



Residential Foundation Thermal Load Calculator

Supplemental tool for CAN/CSA-F280

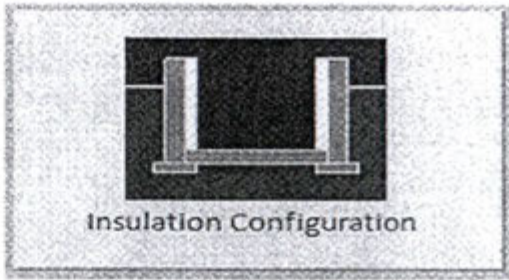
Weather Station Description		
Province:	Ontario	
Region:	Brampton	
Site Description		
Soil Conductivity:	Normal conductivity: dry sand, loam, clay	
Water Table:	Normal (7-10 m, 23-33 ft)	
Foundation Dimensions		
Floor Length (m):	14.0	 Insulation Configuration
Floor Width (m):	9.4	
Exposed Perimeter (m):	0.0	
Wall Height (m):	2.7	
Depth Below Grade (m):	1.83	
Window Area (m ²):	1.4	
Door Area (m ²):	1.9	
Radiant Slab		
Heated Fraction of the Slab:	0	
Fluid Temperature (°C):	33	
Design Months		
Heating Month	1	
Foundation Loads		
Heating Load (Watts):		1537

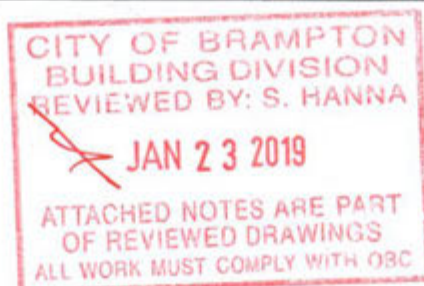TYPE: MILLWOOD 2
LO# 79581


Air Infiltration Residential Load Calculator

Supplemental tool for CAN/CSA-F280


Weather Station Description				
Province:	Ontario			
Region:	Brampton			
Weather Station Location:	Open flat terrain, grass			
Anemometer height (m):	10			
Local Shielding				
Building Site:	Suburban, forest			
Walls:	Heavy			
Flue:	Heavy			
Highest Ceiling Height (m):	7.62			
Building Configuration				
Type:	Detached			
Number of Stories:	Two			
Foundation:	Full			
House Volume (m ³):	1001.5			
Air Leakage/Ventilation				
Air Tightness Type:	Present (1961-) (3.57 ACH)			
Custom BDT Data:	ELA @ 10 Pa.	1335.0 cm ²		
	3.57	ACH @ 50 Pa		
Mechanical Ventilation (L/s):	Total Supply	Total Exhaust		
	37.5	37.5		
Flue Size				
Flue #:	#1	#2	#3	#4
Diameter (mm):	0	0	0	0
Natural Infiltration Rates				
Heating Air Leakage Rate (ACH/H):	0.354			
Cooling Air Leakage Rate (ACH/H):	0.115			

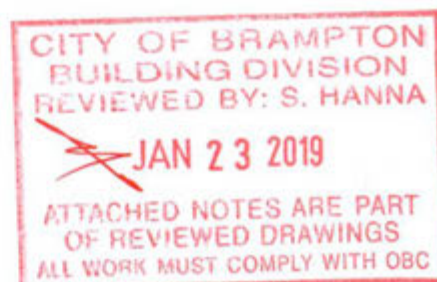TYPE: MILLWOOD 2
LO# 79581


ENSURE THAT MIN THERMAL PERFORMANCE OF BLDG ENVELOPE AND EQUIPMENT SHALL CONFORM TO OBC SB-12.3.1.1.2 TABLES REQUIREMENTS. FURNACE SHALL BE EQUIPPED WITH BRUSHLESS DIRECT CURRENT MOTOR OBC DIV B 12.3.1.5. SEAL ALL DUCTWORK WITH UNCONDITIONED SPACE or OUTDOORS PER OBC DIV B6.2.4.3(11) REQUIREMENTS. SEAL ALL SUPPLY DUCTS LOCATED IN CONDITIONED SPACE IN COMPLIANCE WITH OBC DIV B6.2.4.3(12) REQUIREMENTS. SEPARATE ANY INTAKES FROM BUILDING ENVELOPE PENETRATIONS THAT ARE POTENTIAL SOURCES OF CONTAMINANTS (GAS VENTS, OIL FILL PIPES, etc. BY MIN 900mm (2FT 11IN) - OBC Div B 9.32.3.12. INSTALLATION OF KITCHEN EXHAUST DUCT LARGER THAN 6" dia SHALL BE PRECEDED BY APPLICATION FOR REVISION OF DESIGN PER OBC PART 6 REQUIREMENTS. EXHAUST FAN SHALL DISCHARGE DIRECTLY TO OUTSIDE. CLOTHES DRYER EXHAUST SYSTEM SHALL COMPLY WITH OBC DIV B 9.32.1.2, 9.32.1.3 & 9.32.3 REQ'S. BALANCE THE RETURN AIRFLOW ON THE UPPER FLOOR TO MATCH THE SUPPLY. WHEN HRV IS USED AS PRINCIPAL EXHAUST FAN, THE CONTROLLER SHALL BE WIRED TO THE HRV UNIT AND INTERCONNECTED TO THE FURNACE FAN. THE FURNACE BLOWER MUST BE IN OPERATION WHEN THE HRV IS IN OPERATION. INSTALL ADDITIONAL S/A REGISTER AS REQUIRED IN ORDER TO ENSURE MIN 72degF UNDERCUT BY MIN 1" THE DOOR TO ANY ROOM WITHOUT RETURN AIR GRILLE. ENSURE RETURN AIR INTAKE SHALL BE CONNECTED TO THE MAIN R/A DUCT AT A HORIZONTAL DISTANCE OF MIN 6FT FROM THE CASING OF THE UNIT (HRAI DIGEST).

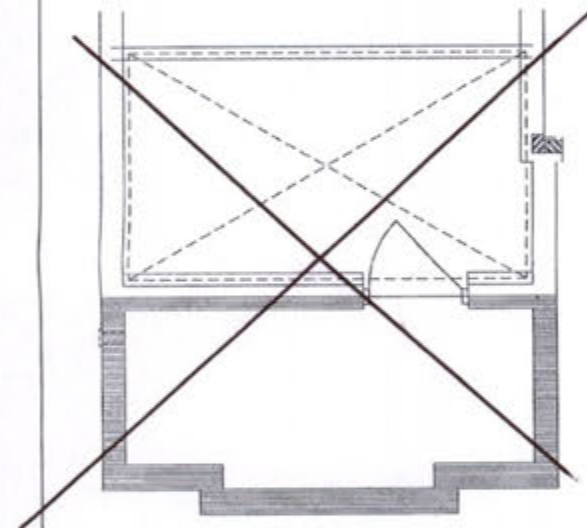

ELEVATION 2

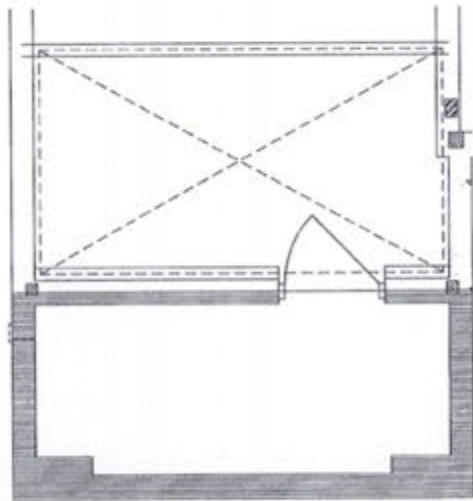

ELEVATION 3

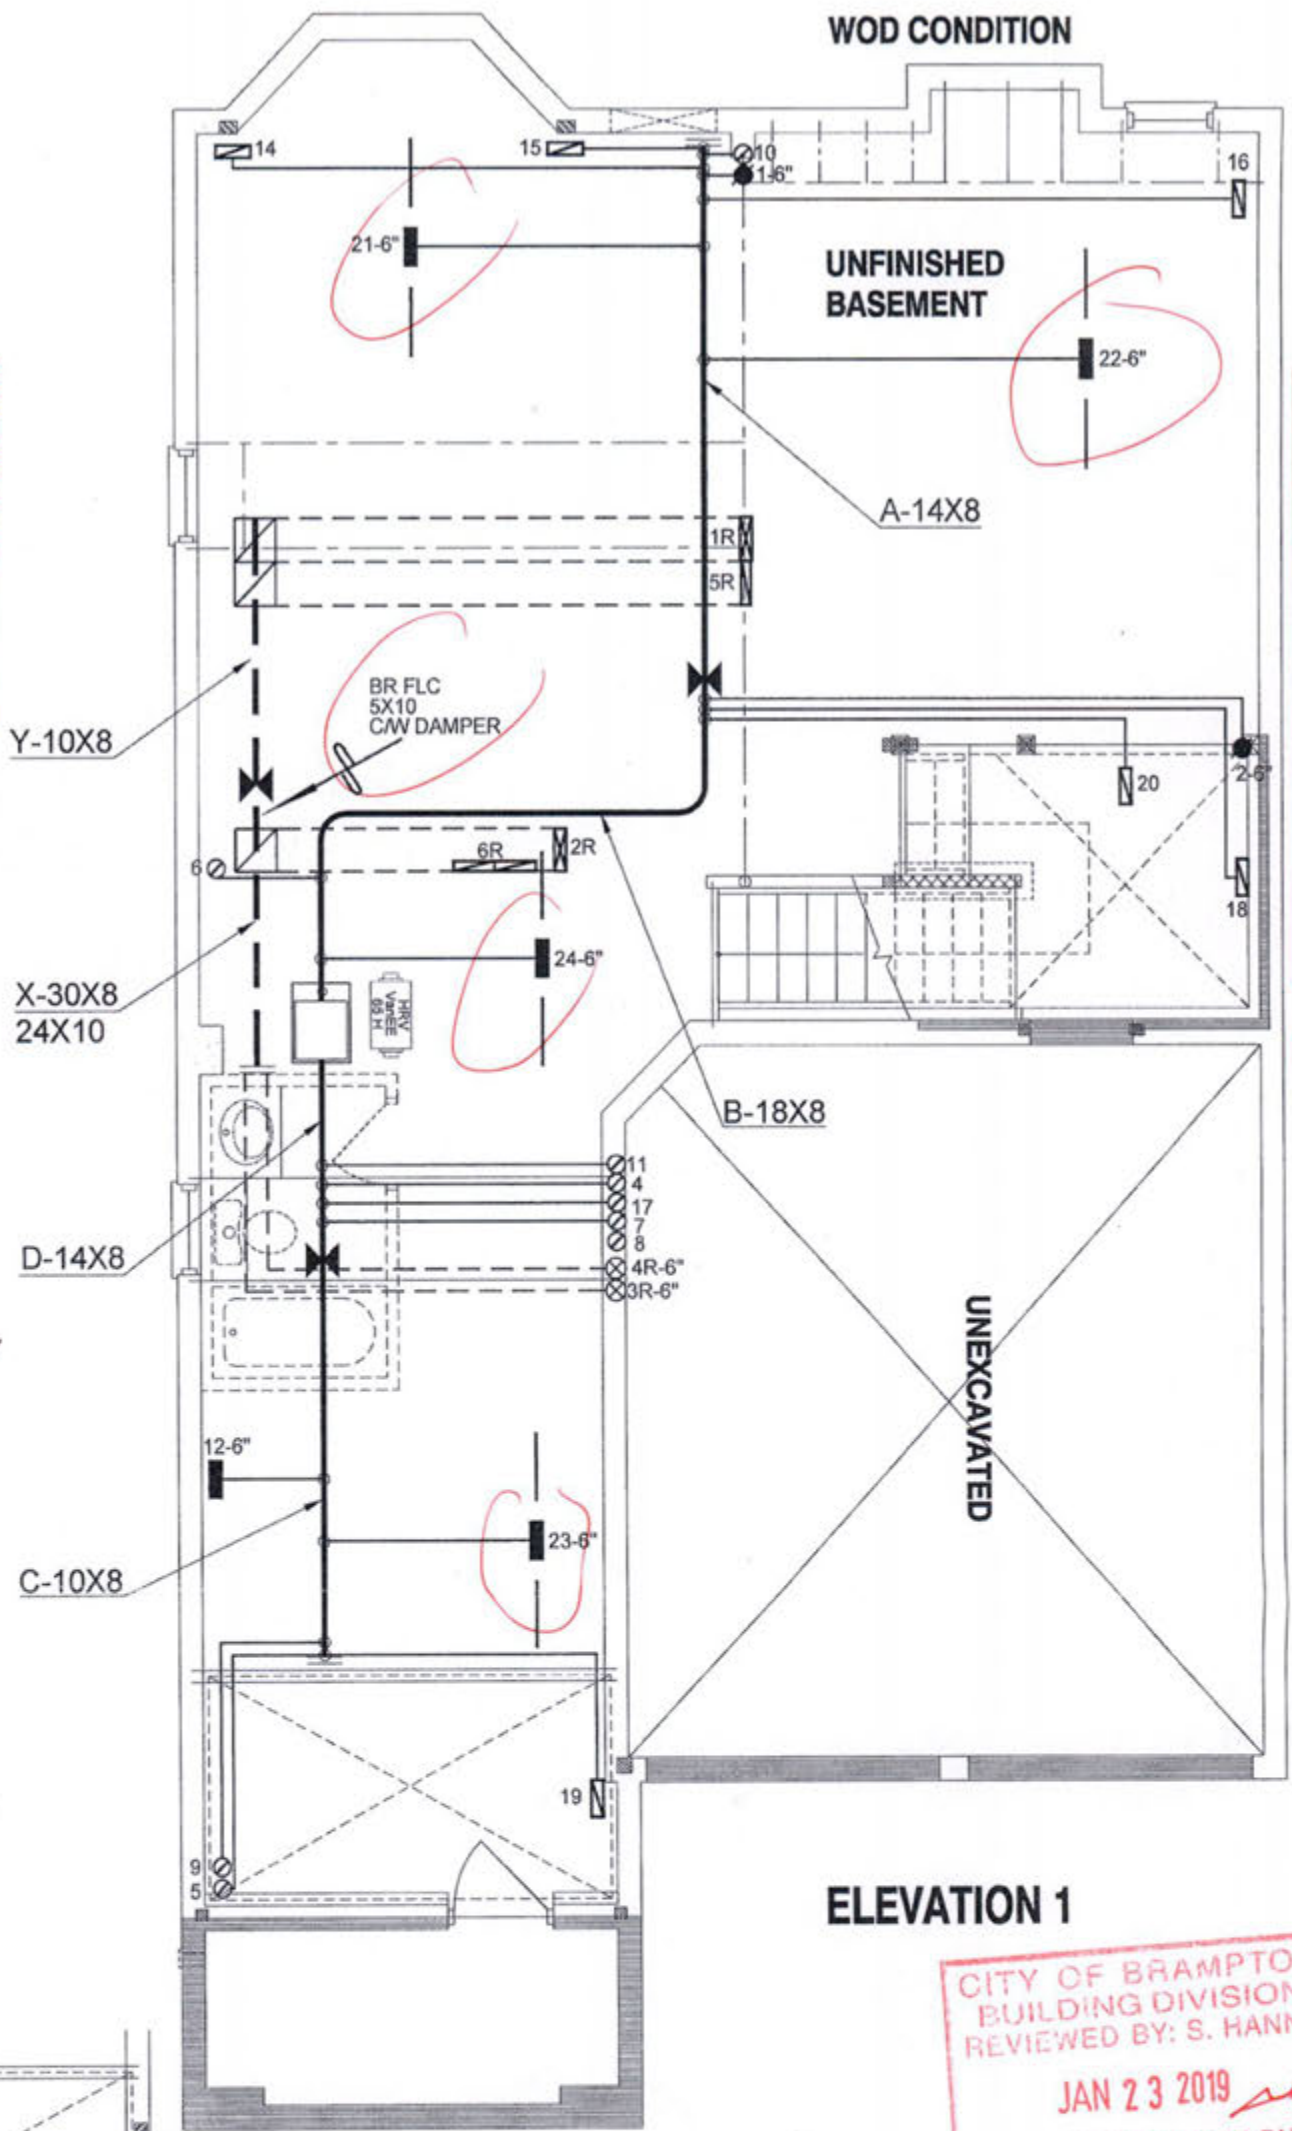

ELEVATION 1

CITY OF BRAMPTON
BUILDING DIVISION
REVIEWED BY: S. HANNA
JAN 23 2019
ATTACHED NOTES ARE PART
OF REVIEWED DRAWINGS
ALL WORK MUST COMPLY WITH OBC

INSTALLATION OF HVAC EQUIPMENTS
SHALL CONFORM TO MANUFACTURER'S SPECIFICATIONS
AND MANUALS

CSA-F280-12
PACKAGE A1

HVAC LEGEND

SYMBOL	DESCRIPTION	SYMBOL	DESCRIPTION	SYMBOL	DESCRIPTION	SYMBOL	DESCRIPTION
	FLOOR SUPPLY AIR GRILLE		6" SUPPLY AIR BOOT ABOVE		14"x8" RETURN AIR GRILLE		RETURN AIR STACK ABOVE
	FLOOR SUPPLY AIR GRILLE 6" BOOT		SUPPLY AIR STACK 2nd FLOOR		30"x8" RETURN AIR GRILLE		RETURN AIR STACK 2nd FLOOR
	SUPPLY AIR BOOT ABOVE		6" SUPPLY AIR STACK 2nd FLOOR		FRA- FLOOR RETURN AIR GRILLE		REDUCER

No.	Description	Date
1.		
2.		
3.		


ALL DRAWINGS, CALCULATIONS AND SPECIFICATIONS ARE THE PROPERTY OF HVAC DESIGNS LTD. © AND MAY NOT BE REPRODUCED, MODIFIED OR ALTERED WITHOUT EXPRESSED WRITTEN CONSENT. THE DRAWINGS ARE DATED AND USE OF THESE DRAWINGS AFTER ONE YEAR FROM THE DATED NOTED IS NOT AUTHORIZED. CONTRACTOR SHALL CHECK ALL CONDITIONS BEFORE PROCEEDING WITH WORK. LATEST MUNICIPAL APPROVED DRAWINGS ONLY TO BE USED DURING INSTALLATION OF HEATING SYSTEM. HVAC DESIGNS LTD. IS NOT LIABLE FOR ANY CLAIMS ARISING FROM UNAUTHORIZED USE OF THE DRAWINGS OR FROM ANY CHANGES TO ACCEPTED STANDARDS AND/OR THE ONTARIO BUILDING CODE.

Client
GREENPARK HOMES
Project Name
MINNISALE HOMES CORP.
BRAMPTON, ONTARIO
LOT 28
MILLWOOD 2 **2654 sqft**

HVAC DESIGNS LTD.
375 Finley Ave. Suite 202 - Ajax, Ontario
L1S 2E2 Tel. 905.619.2300 - 905.420.5300 Fax 905.619.2375
Email: info@hvacdsgns.ca
Web: www.hvacdsgns.ca
Specializing in Residential Mechanical Design Services
Installation to comply with the latest Ontario Building Code. All supply branch outlets shall be equipped with a manual balancing damper. Ductwork which passes through the garage or unheated spaces shall be adequately insulated and be gas-proofed.

HEAT LOSS	49698 BTU/H	# OF RUNS	S/A	R/A	FANS
UNIT DATA		3RD FLOOR			
MAKE	GOODMAN	2ND FLOOR	11	4	3
MODEL	GMEC960603BNA-60	1ST FLOOR	7	2	2
INPUT	60 MBTUH	BASEMENT	4	1	0
OUTPUT	57.6 MBTUH	ALL S/A DIFFUSERS 4 "x10" UNLESS NOTED OTHERWISE ON LAYOUT. ALL S/A RUNS 5" UNLESS NOTED OTHERWISE ON LAYOUT. UNDERCUT DOORS 1" min. FOR R/A			
COOLING	2.5 TONS				
FAN SPEED	1131 cfm @ 0.6" w.c.				


Sheet Title	BASEMENT HEATING LAYOUT
Date	AUG/2018
Scale	3/16" = 1'-0"
BCIN#	19669
LO#	79581

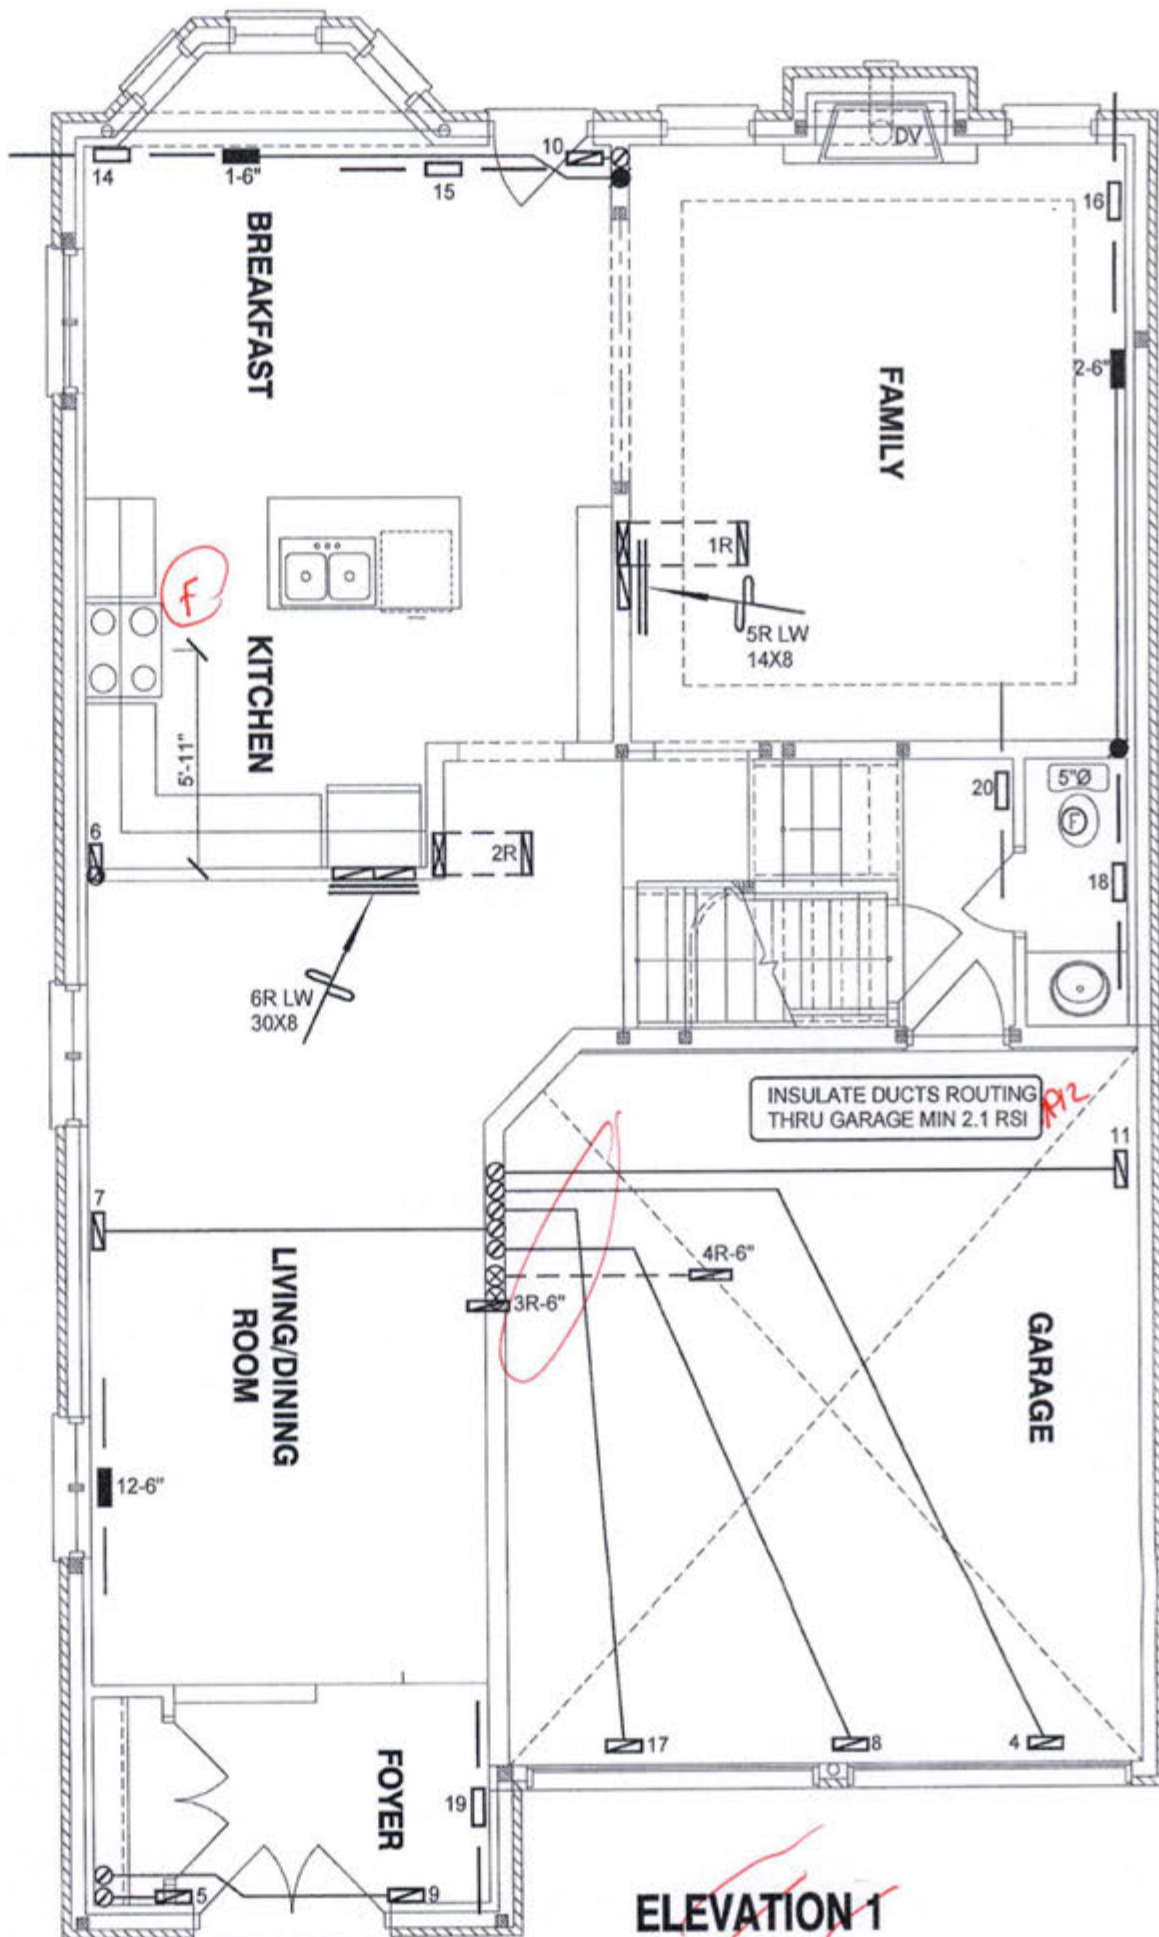


THIS INSTALLATION OF A GAS FIREPLACE IS REGULATED UNDER THE T.S.A. BY C.S.A. B149.1 NATURAL GAS AND PROPANE INSTALLATION CODE CALL ENBRIDGE FOR INSPECTION AT 1-800-783-1314

CITY OF BRAMPTON
BUILDING DIVISION
REVIEWED BY: S. HANNA
JAN 23 2019
ATTACHED NOTES ARE PART
OF REVIEWED DRAWINGS
ALL WORK MUST COMPLY WITH OBC

ELEVATION 1

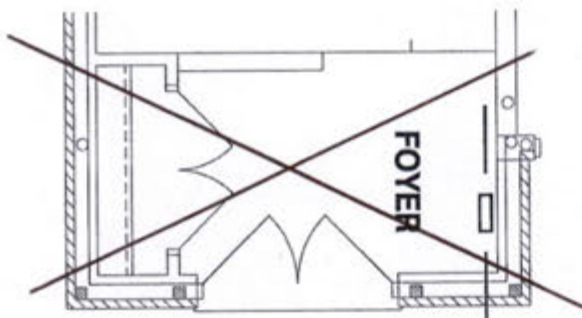

ELEVATION 2

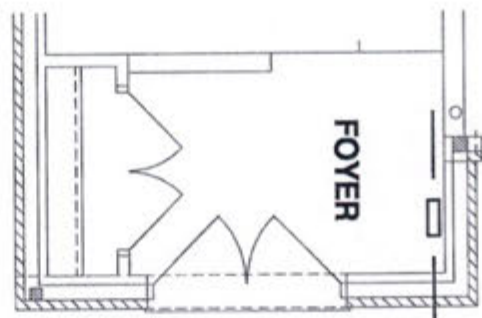

ELEVATION 3

CSA-F280-12
PACKAGE A1

I HEREBY CERTIFY THAT I HAVE REVIEWED AND TAKE RESPONSIBILITY FOR THE DESIGN WORK AND AM QUALIFIED UNDER DIVISION C, 32.5 OF THE BUILDING CODE.
Michael O'Rourke, O.C.S.A. 19669
HVAC DESIGNS LTD.

HVAC LEGEND								3.	
— □ —	FLOOR SUPPLY AIR GRILLE	— ■ —	6" SUPPLY AIR BOOT ABOVE	— ▨ —	14"x8" RETURN AIR GRILLE	— ▩ —	RETURN AIR STACK ABOVE	2.	
— ■ —	FLOOR SUPPLY AIR GRILLE 6" BOOT	○	SUPPLY AIR STACK FROM 2nd FLOOR	— ▨ —	30"x8" RETURN AIR GRILLE	— ▩ —	RETURN AIR STACK 2nd FLOOR	1.	
— ▨ —	SUPPLY AIR BOOT ABOVE	●	6" SUPPLY AIR STACK 2nd FLOOR	— ▨ —	FRA- FLOOR RETURN AIR GRILLE	— ▩ —	REDUCER	No.	Description
								Date	


REVISIONS

ALL DRAWINGS, CALCULATIONS AND SPECIFICATIONS ARE THE PROPERTY OF HVAC DESIGNS LTD. AND MAY NOT BE REPRODUCED, MODIFIED OR ALTERED WITHOUT EXPRESSED WRITTEN CONSENT. THE DRAWINGS ARE DATED AND USE OF THESE DRAWINGS AFTER ONE YEAR FROM THE DATED NOTED IS NOT AUTHORIZED. CONTRACTOR SHALL CHECK ALL CONDITIONS BEFORE PROCEEDING WITH WORK. LATEST MUNICIPAL APPROVED DRAWINGS ONLY TO BE USED DURING INSTALLATION OF HEATING SYSTEM. HVAC DESIGNS LTD. IS NOT LIABLE FOR ANY CLAIMS ARISING FROM UNAUTHORIZED USE OF THE DRAWINGS OR FROM ANY CHANGES TO ACCEPTED STANDARDS AND/OR THE ONTARIO BUILDING CODE.

Client
GREENPARK HOMES
Project Name
**MINNISALE HOMES CORP.
BRAMPTON, ONTARIO**
LOT 28
MILLWOOD 2 **2654 sqft**

HVAC DESIGNS LTD.
375 Finley Ave. Suite 202 - Ajax, Ontario
L1S 2E2 Tel. 905.619.2300 - 905.420.5300 Fax 905.619.2375
Email: info@hvacdsgns.ca
Web: www.hvacdsgns.ca
Specializing in Residential Mechanical Design Services
Installation to comply with the latest Ontario Building Code. All supply branch outlets shall be equipped with a manual balancing damper. Ductwork which passes through the garage or unheated spaces shall be adequately insulated and be gas-proofed.

Sheet Title
**FIRST FLOOR
HEATING
LAYOUT**
Date **AUG/2018**
Scale **3/16" = 1'-0"**
BCIN# **19669**
LO# **79581**

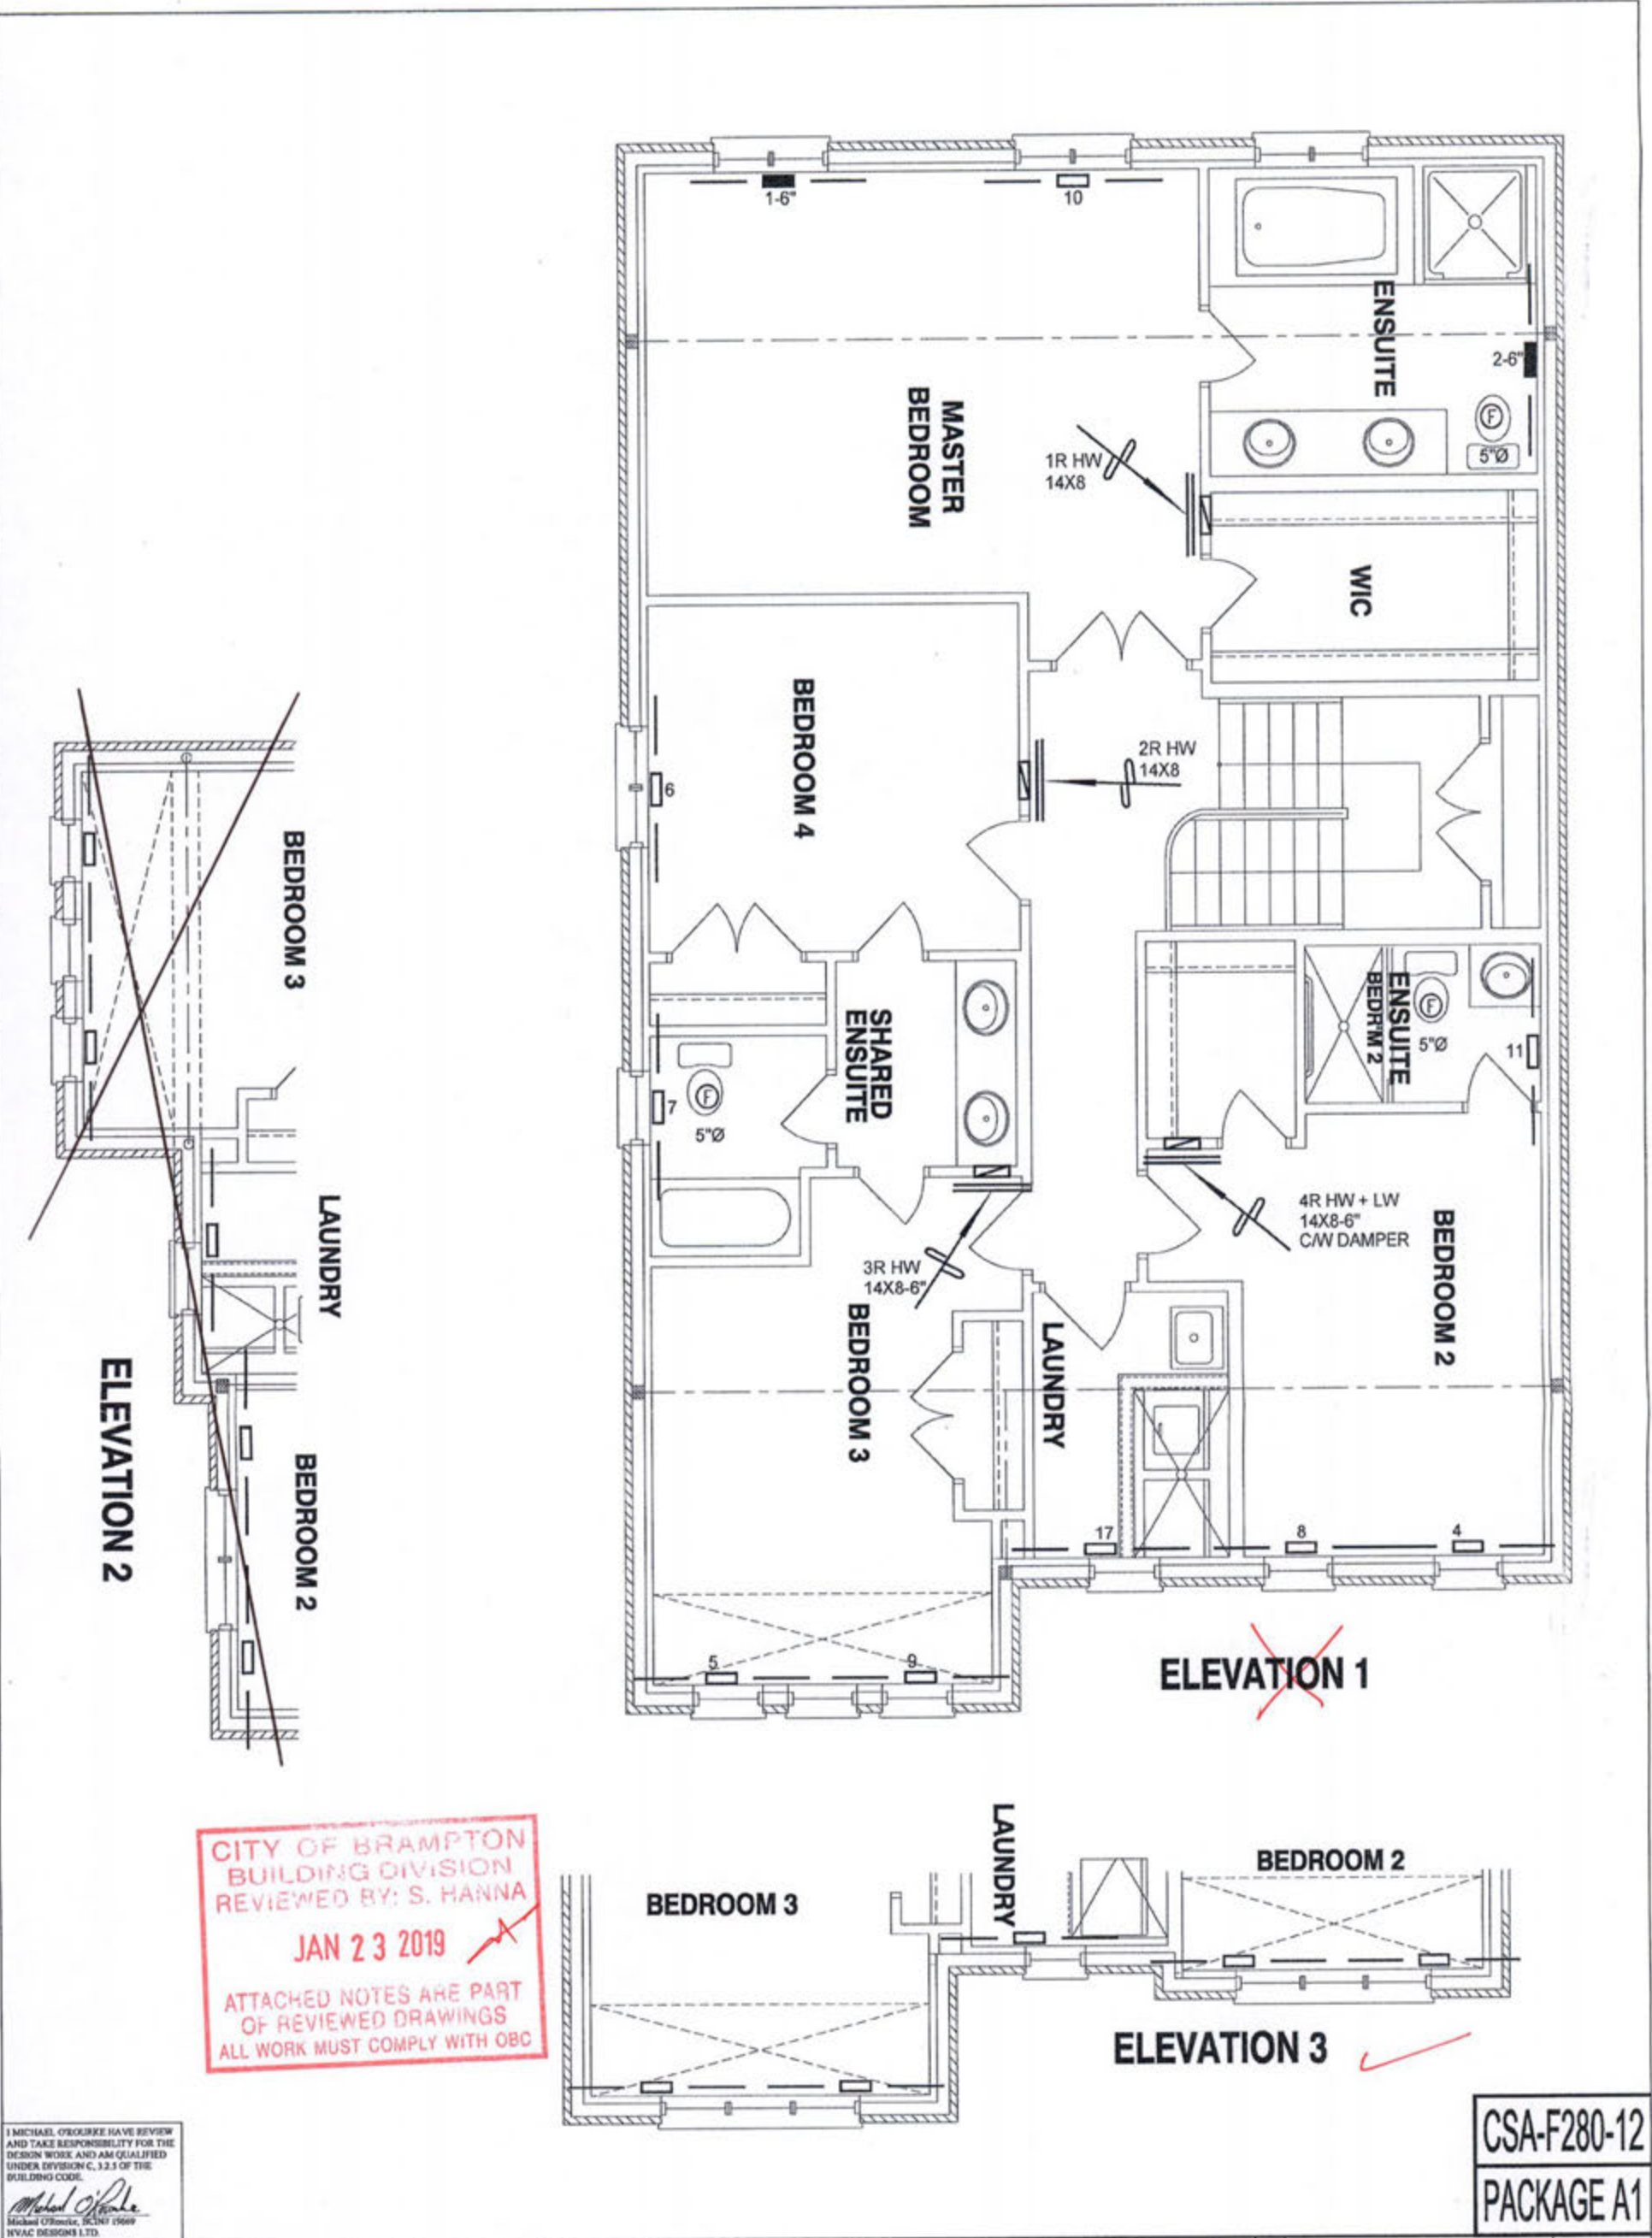

I MICHAEL O'BROCKIE HAVE REVIEWED AND TAKE RESPONSIBILITY FOR THE DESIGN WORK AND AM QUALIFIED UNDER DIVISION C, 3.2.3 OF THE BUILDING CODE.
Michael O'Brockie
Michael O'Brockie, BCIN# 19669
HVAC DESIGNS LTD.

CSA-F280-12
PACKAGE A1

HVAC LEGEND								REVISIONS	
SYMBOL	DESCRIPTION	SYMBOL	DESCRIPTION	SYMBOL	DESCRIPTION	SYMBOL	DESCRIPTION	No.	Date
	FLOOR SUPPLY AIR GRILLE		6" SUPPLY AIR BOOT ABOVE		14"x8" RETURN AIR GRILLE		RETURN AIR STACK ABOVE	3.	
	FLOOR SUPPLY AIR GRILLE 6" BOOT		SUPPLY AIR STACK FROM 2nd FLOOR		30"x8" RETURN AIR GRILLE		RETURN AIR STACK 2nd FLOOR	2.	
	SUPPLY AIR BOOT ABOVE		6" SUPPLY AIR STACK 2nd FLOOR		FRA- FLOOR RETURN AIR GRILLE		REDUCER	1.	
								No.	Description

ALL DRAWINGS, CALCULATIONS AND SPECIFICATIONS ARE THE PROPERTY OF HVAC DESIGNS LTD. AND MAY NOT BE REPRODUCED, MODIFIED OR ALTERED WITHOUT EXPRESSED WRITTEN CONSENT. THE DRAWINGS ARE DATED AND USE OF THESE DRAWINGS AFTER ONE YEAR FROM THE DATED NOTED IS NOT AUTHORIZED. CONTRACTOR SHALL CHECK ALL CONDITIONS BEFORE PROCEEDING WITH WORK. LATEST MUNICIPAL APPROVED DRAWINGS ONLY TO BE USED DURING INSTALLATION OF HEATING SYSTEM. HVAC DESIGNS LTD. IS NOT LIABLE FOR ANY CLAIMS ARISING FROM UNAUTHORIZED USE OF THE DRAWINGS OR FROM ANY CHANGES TO ACCEPTED STANDARDS AND/OR THE ONTARIO BUILDING CODE.

Client

GREENPARK HOMES

Project Name

MINNISALE HOMES CORP.
BRAMPTON, ONTARIO

LOT 28

MILLWOOD 2 2654 sqft

HVACDESIGNS LTD.

375 Finley Ave. Suite 202 - Ajax, Ontario
L1S 2E2 Tel. 905.619.2300 - 905.420.5300 Fax 905.619.2375
Email: info@hvacdsgns.ca
Web: www.hvacdsgns.ca
Specializing in Residential Mechanical Design Services

Installation to comply with the latest Ontario Building Code. All supply branch outlets shall be equipped with a manual balancing damper. Ductwork which passes through the garage or unheated spaces shall be adequately insulated and be gas-proofed.

Sheet Title

**SECOND FLOOR
HEATING
LAYOUT**

Date **AUG/2018**

Scale **3/16" = 1'-0"**

BCIN# 19669

LO# **79581**