

SITE NAME: MINNISALE HOMES CORP
BUILDER: GREENPARK HOMES

TYPE: MILLWOOD 3

GFA: 2622

DATE: Aug-18
LO# 79584

WINTER NATURAL AIR CHANGE RATE 0.382
SUMMER NATURAL AIR CHANGE RATE 0.124

HEAT LOSS ΔT °F. 74
HEAT GAIN ΔT °F. 11

CSA-F280-12
SB-12 PACKAGE A1

ROOM USE	EXP. WALL	CLG. HT.	MBR	ENS	WIC	BED-2	BED-3	BED-4	BATH	ENS-2
			37	23	8	10	24	41	8	15
			9	9	9	9	9	9	9	9
GRS.WALL AREA	FACTORS		333	297	72	90	216	389	72	135
GLAZING	LOSS GAIN		LOSS GAIN	LOSS GAIN	LOSS GAIN	LOSS GAIN	LOSS GAIN	LOSS GAIN	LOSS GAIN	LOSS GAIN
NORTH	20.8 15.5	0 0 0	0 0 0	0 0 0	0 0 0	8 186 124	0 0 0	0 0 0	0 0 0	0 0 0
EAST	20.8 41.0	0 0 0	0 0 0	0 0 0	0 0 0	0 0 0	17 353 698	21 436 862	0 0 0	17 353 698
SOUTH	20.8 24.4	23 478 561	0 0 0	0 0 0	0 0 0	0 0 0	0 0 0	0 0 0	0 0 0	0 0 0
WEST	20.8 41.0	34 706 1396	13 270 534	0 0 0	0 0 0	0 0 0	0 0 0	0 0 0	0 0 0	0 0 0
SKYL.T.	36.4 100.7	0 0 0	0 0 0	0 0 0	0 0 0	0 0 0	0 0 0	0 0 0	0 0 0	0 0 0
DOORS	24.7 3.7	0 0 0	0 0 0	0 0 0	0 0 0	0 0 0	0 0 0	0 0 0	0 0 0	0 0 0
NET EXPOSED WALL	4.4 0.6	276 1203 178	194 845 125	72 314 47	82 357 53	199 867 129	348 1516 225	72 314 47	116 514 76	0 0 0
NET EXPOSED BENT WALL ABOVE GR	3.5 0.5	0 0 0	0 0 0	0 0 0	0 0 0	0 0 0	0 0 0	0 0 0	0 0 0	0 0 0
EXPOSED CLG	1.3 0.6	306 383 171	132 165 74	60 75 33	180 226 100	204 256 114	281 352 157	240 301 134	66 83 37	0 0 0
NO ATTIC EXPOSED CLG	2.7 1.2	0 0 0	0 0 0	0 0 0	0 0 0	0 0 0	16 43 19	0 0 0	0 0 0	0 0 0
EXPOSED FLOOR	2.5 0.4	0 0 0	0 0 0	0 0 0	0 0 0	0 0 0	16 40 6	0 0 0	0 0 0	0 0 0
BASEMENT/CRAWL HEAT LOSS		0	0	0	0	0	0	0	0	0
SLAB ON GRADE HEAT LOSS		0	0	0	0	0	0	0	0	0
SUBTOTAL HT LOSS		2770	1281	389	749	1059	2387	615	560	811
SUB TOTAL HT GAIN		2306	732	80	277	965	1258	180	0.20 0.32	303
LEVEL FACTOR / MULTIPLIER	0.20 0.32									53
AIR CHANGE HEAT LOSS	883		408	124	239	497	761	196	125	86
AIR CHANGE HEAT GAIN	151		48	5	18	63	83	12	0	0
DUCT LOSS	0		0	0	0	206	315	81	1378	1236
DUCT GAIN	0		0	0	0	184	216	19		
HEAT GAIN PEOPLE	240	2	480	0	0	1	240	1	0	0
HEAT GAIN APPLIANCES/LIGHTS		569	0	0	569	569	569	0		
TOTAL HT LOSS BTU/H		3653	1689	513	988	2261	3463	892		
TOTAL HT GAIN x 1.3 BTU/H		4557	1016	111	1435	2627	3889	275		

ROOM USE	EXP. WALL	CLG. HT.	LIV	KIT	FAM	WR	FOY	WOB	BAS
			46	35	43	0	29	154	31
			10	10	10	10	14	9	9
GRS.WALL AREA	FACTORS		460	350	430	0	406	1386	140
GLAZING	LOSS GAIN		LOSS GAIN	LOSS GAIN	LOSS GAIN	LOSS GAIN	LOSS GAIN	LOSS GAIN	LOSS GAIN
NORTH	20.8 15.5	0 0 0	0 0 0	0 0 0	0 0 0	0 0 0	0 0 0	64 1330 990	0 0 0
EAST	20.8 41.0	54 1122 2217	0 0 0	0 0 0	0 0 0	0 0 0	5 104 205	0 0 0	0 0 0
SOUTH	20.8 24.4	0 0 0	0 0 0	0 0 0	0 0 0	0 0 0	0 0 0	0 0 0	3 62 73
WEST	20.8 41.0	0 0 0	57 1184 2340	33 686 1355	0 0 0	0 0 0	0 0 0	0 0 0	0 0 0
SKYL.T.	36.4 100.7	0 0 0	0 0 0	0 0 0	0 0 0	0 0 0	0 0 0	0 0 0	0 0 0
DOORS	24.7 3.7	20 493 73	8 197 29	0 0 0	0 0 0	0 0 0	45 1109 164	20 493 73	0 0 0
NET EXPOSED WALL	4.4 0.6	386 1682 249	285 1242 184	397 1730 258	0 0 0	354 1551 230	1302 5673 841	0 0 0	0 0 0
NET EXPOSED BENT WALL ABOVE GR	3.5 0.5	0 0 0	0 0 0	0 0 0	0 0 0	0 0 0	0 0 0	0 0 0	140 490 73
EXPOSED CLG	1.3 0.6	0 0 0	0 0 0	0 0 0	0 0 0	0 0 0	0 0 0	0 0 0	0 0 0
NO ATTIC EXPOSED CLG	2.7 1.2	0 0 0	30 81 35	10 27 12	0 0 0	0 0 0	0 0 0	0 0 0	0 0 0
EXPOSED FLOOR	2.5 0.4	351 874 130	0 0 0	0 0 0	10 25 4	0 0 0	0 0 0	0 0 0	0 0 0
BASEMENT/CRAWL HEAT LOSS		0	0	0	0	0	0	2185	1482
SLAB ON GRADE HEAT LOSS		0	0	0	0	0	0	9680	2034
SUBTOTAL HT LOSS		4171	2704	2442	1623	25	2765	1904	146
SUB TOTAL HT GAIN		2669	2599	1623	0.30 0.42	4	600	0.50 0.73	8526
LEVEL FACTOR / MULTIPLIER	0.30 0.42								134
AIR CHANGE HEAT LOSS	1762		1142	1032	11	1168	39	0	0
AIR CHANGE HEAT GAIN	175		169	106	0	0	121	0	0
DUCT LOSS	593		0	0	4	393	0	0	0
DUCT GAIN	341		0	0	0	0	0	0	0
HEAT GAIN PEOPLE	240	0	0	0	0	0	0	0	0
HEAT GAIN APPLIANCES/LIGHTS		569	569	569	569	569	569	9680	10660
TOTAL HT LOSS BTU/H		6526	3846	3474	2888	39	4326	2475	264
TOTAL HT GAIN x 1.3 BTU/H		4879	4325	2888	6	1727			

ATTACHED NOTES ARE PART
OF REVIEWED DRAWINGS
REVIEWED BY: S. DESAI
NOV 26 2018

TOTAL HEAT GAIN BTU/H:

31345

TONS: 2.61

LOSS DUE TO VENTILATION LOAD BTU/H: 1593

STRUCTURAL HEAT LOSS: 53289

TOTAL COMBINED HEAT LOSS BTU/H: 54881

Michael O'Rourke

SITE NAME: MINNISSALE HOMES CORP
BUILDER: GREENPARK HOMES

TYPE: MILLWOOD 3

DATE: Aug-18

GFA: 2622 LO# 79584

HEATING CFM 1131 COOLING CFM 1131
TOTAL HEAT LOSS 53,289 TOTAL HEAT GAIN 31,109
AIR FLOW RATE CFM 21.22 AIR FLOW RATE CFM 36.36

furnace pressure 0.6
furnace filter 0.05
a/c coil pressure 0.2
available pressure for s/a & r/a 0.35

#GOODMAN
GMCC960603BNA 60
FAN SPEED LOW
MEDLOW
MEDIUM
MEDIUM HIGH
HIGH 1131

AFUE = 96 %
INPUT (BTU/H) = 60,000
OUTPUT (BTU/H) = 57,600

DESIGN CFM = 1131
CFM @ .8" E.S.P.

TEMPERATURE RISE 47 °F

RUN COUNT	4th	3rd	2nd	1st	Bas
S/A	0	0	10	7	6
R/A	0	0	4	2	1

All S/A diffusers 4"x10" unless noted otherwise on layout.

All S/A runs 5"Ø unless noted otherwise on layout.

RUN #	1	2	3	4	5	6	7	8	10	11	12	13	14	15	16	18	19	21	22	23	24
ROOM NAME	MBR	ENS	W/C	BED-2	BED-3	BED-4	BATH	BED-4	MBR	ENS-2	LIV	LIV	KIT	KIT	FAM	W/R	FOY	BAS	BAS	BAS	BAS
RM LOSS MBH	1.83	1.69	0.51	0.99	2.26	1.73	0.89	1.73	1.83	1.38	3.26	3.26	1.92	1.92	3.47	0.04	4.33	3.37	3.37	3.37	3.37
CFM PER RUN HEAT	39	36	11	21	48	37	19	37	39	29	69	69	41	41	74	1	92	72	72	72	72
RM GAIN MBH	2.28	1.01	0.11	1.44	2.63	1.54	0.27	1.54	2.28	1.24	2.44	2.44	2.16	2.16	2.99	0.01	1.73	0.47	0.47	0.47	0.47
CFM PER RUN COOLING	83	37	4	52	96	56	10	56	83	45	89	89	79	79	109	0	63	17	17	17	17
ADJUSTED PRESSURE	0.16	0.17	0.17	0.17	0.16	0.17	0.17	0.17	0.16	0.17	0.16	0.16	0.17	0.17	0.15	0.17	0.16	0.17	0.17	0.17	0.17
ACTUAL DUCT LGH	60	35	15	30	41	66	14	70	46	48	45	20	32	25	45	17	47	26	37	46	23
EQUIVALENT LENGTH	130	140	200	130	160	170	160	160	150	180	130	140	150	150	150	120	150	180	140	140	160
TOTAL EFFECTIVE LENGTH	190	175	215	160	201	236	174	230	196	228	175	160	182	175	195	137	197	186	177	186	183
ADJUSTED PRESSURE	0.09	0.1	0.08	0.11	0.08	0.07	0.1	0.07	0.08	0.08	0.09	0.1	0.09	0.1	0.08	0.13	0.08	0.09	0.1	0.09	0.09
ROUND DUCT SIZE	6	4	4	5	6	5	4	5	6	4	6	6	5	5	6	4	6	5	5	5	5
HEATING VELOCITY (ft/min)	199	413	126	154	245	272	218	272	199	333	352	352	301	301	377	11	469	529	529	529	529
COOLING VELOCITY (ft/min)	423	424	46	382	489	411	115	411	423	516	454	454	580	580	556	0	321	125	125	125	125
OUTLET GRILL SIZE	4X10	3X10	3X10	3X10	4X10	3X10	3X10	3X10	4X10	3X10	4X10	4X10	3X10	3X10	4X10	3X10	4X10	3X10	3X10	3X10	3X10
TRUNK	A	B	B	D	D	C	D	C	B	C	D	D	B	B	A	D	C	B	B	A	D

RUN #	25	26
ROOM NAME	BAS	BAS
RM LOSS MBH	3.37	3.37
CFM PER RUN HEAT	72	72
RM GAIN MBH	0.47	0.47
CFM PER RUN COOLING	17	17
ADJUSTED PRESSURE	0.17	0.17
ACTUAL DUCT LGH	48	31
EQUIVALENT LENGTH	150	160
TOTAL EFFECTIVE LENGTH	198	191
ADJUSTED PRESSURE	0.09	0.09
ROUND DUCT SIZE	5	5
HEATING VELOCITY (ft/min)	529	529
COOLING VELOCITY (ft/min)	125	125
OUTLET GRILL SIZE	3X10	3X10
TRUNK	C	C

CITY OF BRAMPTON
BUILDING DIVISION
REVIEWED BY: S. DESAI
NOV 26 2018
ATTACHED NOTES ARE PART
OF REVIEWED DRAWINGS
ALL WORK MUST COMPLY WITH CBC

SUPPLY AIR TRUNK SIZE										RETURN AIR TRUNK SIZE															
	TRUNK	STATIC	ROUND	RECT			VELOCITY			TRUNK	STATIC	ROUND	RECT			VELOCITY			TRUNK	STATIC	ROUND	RECT			VELOCITY
	CFM	PRESS.	DUCT	DUCT			(ft/min)			CFM	PRESS.	DUCT	DUCT			(ft/min)			CFM	PRESS.	DUCT	DUCT			(ft/min)
TRUNK A	185	0.08	7.5	6	X	8	555	TRUNK G	0	0.00	0	0	X	8	0	TRUNK O	0	0.05	0	0	X	8	0	0	0
TRUNK B	497	0.08	10.8	14	X	8	639	TRUNK H	0	0.00	0	0	X	8	0	TRUNK P	0	0.05	0	0	X	8	0	0	0
TRUNK C	339	0.07	9.7	12	X	8	509	TRUNK I	0	0.00	0	0	X	8	0	TRUNK Q	0	0.05	0	0	X	8	0	0	0
TRUNK D	638	0.07	12.3	18	X	8	638	TRUNK J	0	0.00	0	0	X	8	0	TRUNK R	0	0.05	0	0	X	8	0	0	0
TRUNK E	0	0.00	0	0	X	8	0	TRUNK K	0	0.00	0	0	X	8	0	TRUNK S	0	0.05	0	0	X	8	0	0	0
TRUNK F	0	0.00	0	0	X	8	0	TRUNK L	0	0.00	0	0	X	8	0	TRUNK T	0	0.05	0	0	X	8	0	0	0
RETURN AIR #	1	2	3	4	5	6										BR									
AIR VOLUME	75	145	95	155	120	330	0	0	0	0	0	0	0	0	0	211									
PLENUM PRESSURE	0.15	0.15	0.15	0.15	0.15	0.15	0.15	0.15	0.15	0.15	0.15	0.15	0.15	0.15	0.15	0.15									
ACTUAL DUCT LGH	49	59	52	45	42	34	1	1	1	1	1	1	1	1	1	14									
EQUIVALENT LENGTH	225	185	135	180	230	175	0	0	0	0	0	0	0	0	0	145									
TOTAL EFFECTIVE LH	274	244	187	225	272	209	1	1	1	1	1	1	1	1	1	159									
ADJUSTED PRESSURE	0.05	0.06	0.08	0.07	0.05	0.07	14.80	14.80	14.80	14.80	14.80	14.80	14.80	14.80	14.80	0.09									
ROUND DUCT SIZE	6	7.3	5.8	7.2	7.1	9.6	0	0	0	0	0	0	0	0	0	7.6									
INLET GRILL SIZE	8	8	8	8	8	8	0	0	0	0	0	0	0	0	0	8									
	X	X	X	X	X	X	X	X	X	X	X	X	X	X	X	X									
INLET GRILL SIZE	14	14	14	14	14	30	0	0	0	0	0	0	0	0	0	24									

TYPE: MILLWOOD 3
 SITE NAME: MINNISSALE HOMES CORP

LO # 79584

RESIDENTIAL MECHANICAL VENTILATION DESIGN SUMMARY

COMBUSTION APPLIANCES		9.32.3.1(1)
a)	☒ Direct vent (sealed combustion) only	
b)	☐ Positive venting induced draft (except fireplaces)	
c)	☐ Natural draft, B-vent or induced draft gas fireplace	
d)	☐ Solid Fuel (including fireplaces)	
e)	☐ No Combustion Appliances	

HEATING SYSTEM	
☒ Forced Air	☐ Non Forced Air
☐ Electric Space Heat	

HOUSE TYPE		9.32.1(2)
☒ I	Type a) or b) appliance only, no solid fuel	
☐ II	Type I except with solid fuel (including fireplaces)	
☐ III	Any Type c) appliance	
☐ IV	Type I, or II with electric space heat	
☐	Other: Type I, II or IV no forced air	

SYSTEM DESIGN OPTIONS		O.N.H.W.P.
☐ 1	Exhaust only/Forced Air System	
☐ 2	HRV with Ducting/Forced Air System	
☒ 3	HRV Simplified/connected to forced air system	
☐ 4	HRV with Ducting/non forced air system	
☐	Part 6 Design	

TOTAL VENTILATION CAPACITY		9.32.3.3(1)
Basement + Master Bedroom	2 @ 21.2 cfm	42.4 cfm
Other Bedrooms	3 @ 10.6 cfm	31.8 cfm
Kitchen & Bathrooms	5 @ 10.6 cfm	53 cfm
Other Rooms	4 @ 10.6 cfm	42.4 cfm
Table 9.32.3.A.	TOTAL	169.6 cfm

PRINCIPAL VENTILATION CAPACITY REQUIRED		9.32.3.4(1)
1 Bedroom	31.8	cfm
2 Bedroom	47.7	cfm
3 Bedroom	63.6	cfm
4 Bedroom	79.5	cfm
5 Bedroom	95.4	cfm
TOTAL	79.5	cfm

SUPPLEMENTAL VENTILATION CAPACITY		9.32.3.6.
Total Ventilation Capacity	109.6	cfm
Less Principal Ventil. Capacity	79.5	cfm
Required Supplemental Capacity	90.1	cfm

PRINCIPAL EXHAUST FAN CAPACITY	
Model: VANEE 65H	Location: BSMT
79.5 cfm	3.0 sones
☒ HVI Approved	

PRINCIPAL EXHAUST HEAT LOSS CALCULATION					
CFM	ΔT °F	FACTOR			% LOSS
79.5 CFM	X 74 F	X 1.08	X		0.25

SUPPLEMENTAL FANS		PANASONIC		
Location	Model	cfm	HVI	Sones
ENS	FV-05-11VK1	50	☒	0.3
BATH	FV-05-11VK1	50	☒	0.3
ENS-2	FV-05-11VK1	50	☒	0.3
W/R	FV-05-11VK1	50	☒	0.3

HEAT RECOVERY VENTILATOR		9.32.3.11.
Model: VANEE 65H		
155 cfm high	64 cfm low	
75 % Sensible Efficiency	☒ HVI Approved	
@ 32 deg F (0 deg C)		

LOCATION OF INSTALLATION	
Lot:	Concession
Township	Plan:
Address	
Roll #	Building Permit #

BUILDER:	
Name:	GREENPARK HOMES
Address:	CITY OF BRAMPTON
City:	BUILDING DIVISION
Telephone #:	REVIEWED BY: S. DESAI
	NOV 26 2018

INSTALLING CONTRACTOR	
Name:	
Address:	
City:	
Telephone #:	Fax #:

DESIGNER CERTIFICATION	
I hereby certify that this ventilation system has been designed in accordance with the Ontario Building Code.	
Name:	HVAC Designs Ltd.
Signature:	<i>Michael O'Rourke</i>
HRAI #	001820
Date:	August-18

CSA F280-12 Residential Heat Loss and Heat Gain Calculations
Formula Sheet (For Air Leakage / Ventilation Calculation)

LO#: 79584

Model: MILLWOOD 3

Builder: GREENPARK HOMES

Date: 8/9/2018

Volume Calculation
House Volume

Level	Floor Area (ft²)	Floor Height (ft)	Volume (ft³)
Bsmt	962	9	8658
First	1332	10	13320
Second	1290	9	11610
Third	0	9	0
Fourth	0	9	0
Total:			33,588.0 ft³
Total:			951.1 m³

Air Change & Delta T Data

WINTER NATURAL AIR CHANGE RATE	0.382
SUMMER NATURAL AIR CHANGE RATE	0.124

Design Temperature Difference

	Tin °C	Tout °C	ΔT °C	ΔT °F
Winter DTDh	22	-19	41	74
Summer DTDc	24	30	6	11

5.2.3.1 Heat Loss due to Air Leakage

$$HL_{airb} = LR_{airh} \times \frac{V_b}{3.6} \times DTD_h \times 1.2$$

$$0.382 \times 264.20 \times 41^\circ\text{C} \times 1.2 = 4997 \text{ W}$$

$$= 17051 \text{ Btu/h}$$

6.2.6 Sensible Gain due to Air Leakage

$$HG_{salb} = LR_{airc} \times \frac{V_b}{3.6} \times DTD_c \times 1.2$$

$$0.124 \times 264.20 \times 6^\circ\text{C} \times 1.2 = 241 \text{ W}$$

$$= 821 \text{ Btu/h}$$

5.2.3.2 Heat Loss due to Mechanical Ventilation

$$HL_{valrb} = PVC \times DTD_h \times 1.08 \times (1 - E)$$

$$80 \text{ CFM} \times 74^\circ\text{F} \times 1.08 \times 0.25 = 1593 \text{ Btu/h}$$

6.2.7 Sensible heat Gain due to Ventilation

$$HL_{valrb} = PVC \times DTD_h \times 1.08 \times (1 - E)$$

$$80 \text{ CFM} \times 11^\circ\text{F} \times 1.08 \times 0.25 = 236 \text{ Btu/h}$$

5.2.3.3 Calculation of Air Change Heat Loss for Each Room (Floor Multiplier Section)

$$HL_{airr} = \text{Level Factor} \times HL_{airbv} \times ((HL_{agcr} + HL_{bgcr}) + (HL_{agclel} + HL_{bgclel}))$$

Level	Level Factor (LF)	HLairve Air Leakage + Ventilation Heat Loss (Btu/h)	Level Conductive Heat Loss: (HL _{level})	Air Leakage Heat Loss Multiplier (LF x HLairbv / HLlevel)
1	0.5	17,051	11,715	0.728
2	0.3		12,067	0.424
3	0.2		10,699	0.319
4	0		0	0.000
5	0		0	0.000

*HLairbv = Air leakage heat loss + ventilation heat loss

*For a balanced or supply only ventilation system HLairve = 0

CITY OF BRAMPTON
BUILDING DIVISION
REVIEWED BY: S. DESAI
NOV 26 2018
58
ATTACHED NOTES ARE PART
OF REVIEWED DRAWINGS
ALL WORK MUST COMPLY WITH OBC

HEAT LOSS AND GAIN SUMMARY SHEET

MODEL: MILLWOOD 3	BUILDER: GREENPARK HOMES
SFQT: 2622	SITE: MINNISSALE HOMES CORP
LO# 79584	

DESIGN ASSUMPTIONS

HEATING	°F	COOLING	°F
OUTDOOR DESIGN TEMP.	-2	OUTDOOR DESIGN TEMP.	86
INDOOR DESIGN TEMP.	72	INDOOR DESIGN TEMP. (MAX 75°F)	75

BUILDING DATA

ATTACHMENT:	DETACHED	# OF STORIES (+BASEMENT):	3
FRONT FACES:	EAST	ASSUMED (Y/N):	Y
AIR CHANGES PER HOUR:	3.57	ASSUMED (Y/N):	Y
AIR TIGHTNESS CATEGORY:	AVERAGE	ASSUMED (Y/N):	Y
WIND EXPOSURE:	SHELTERED	ASSUMED (Y/N):	Y
HOUSE VOLUME (ft³):	33588.0	ASSUMED (Y/N):	Y
INTERNAL SHADING:	BLINDS/CURTAINS	ASSUMED OCCUPANTS:	5
INTERIOR LIGHTING LOAD (Btu/h/ft²):	1.27	DC BRUSHLESS MOTOR (Y/N):	Y
FOUNDATION CONFIGURATION	BCIN_1	DEPTH BELOW GRADE:	4.5 ft
LENGTH: 47.0 ft	WIDTH: 31.0 ft	EXPOSED PERIMETER:	31.0 ft
WOB INSULATION CONFIGURATION	SCB_9	WOB EXPOSED PERIMETER	125.0 ft

2012 OBC - COMPLIANCE PACKAGE

Component

Ceiling with Attic Space Minimum RSI (R)-Value
Ceiling Without Attic Space Minimum RSI (R)-Value
Exposed Floor Minimum RSI (R)-Value
Walls Above Grade Minimum RSI (R)-Value
Basement Walls Minimum RSI (R)-Value
Below Grade Slab Entire surface > 600 mm below grade Minimum RSI (R)-Value
Edge of Below Grade Slab ≤ 600 mm Below Grade Minimum RSI (R)-Value
Heated Slab or Slab ≤ 600 mm below grade Minimum RSI (R)-Value
Windows and Sliding Glass Doors Maximum U-Value
Skylights Maximum U-Value
Space Heating Equipment Minimum AFUE
HRV Minimum Efficiency
Domestic Hot Water Heater Minimum EF

**CITY OF BRAMPTON
BUILDING DIVISION
REVIEWED BY: S. DESAI**

NOV 26 2018

**ATTACHED NOTES ARE PART
OF REVIEWED DRAWINGS
ALL WORK MUST COMPLY WITH OBC**

Compliance Package A1


Nominal	Min. Eff.
60	59.22
31	27.65
31	29.80
22	17.03
20 ci	21.12
-	-
10	10
10	11.13
0.28	-
0.49	-
0.96	-
75%	-
0.8	-

INDIVIDUAL BCIN: 19669
MICHAEL O'ROURKE

Michael O'Rourke

Residential Foundation Thermal Load Calculator


Supplemental tool for CAN/CSA-F280

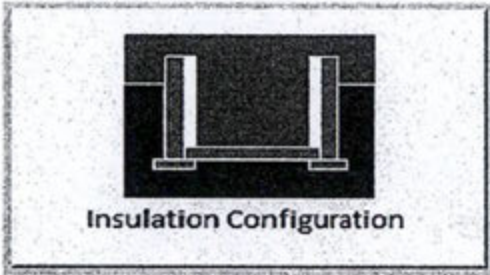Weather Station Description		
Province:	Ontario	
Region:	Brampton	
Site Description		
Soil Conductivity:	Normal conductivity: dry sand, loam, clay	
Water Table:	Normal (7-10 m, 23-33 ft)	
Foundation Dimensions		
Floor Length (m):	17.4	 Insulation Configuration
Floor Width (m):	9.4	
Exposed Perimeter (m):	9.4	
Wall Height (m):	2.7	
Depth Below Grade (m):	1.28	
Window Area (m ²):	0.3	
Door Area (m ²):	0.0	
Radiant Slab		
Heated Fraction of the Slab:	0	CITY OF BRAMPTON BUILDING DIVISION REVIEWED BY: S. DESAI NOV 26 2018 ATTACHED NOTES ARE PART OF REVIEWED DRAWINGS ALL WORK MUST COMPLY WITH OBC
Fluid Temperature (°C):	33	
Design Months		
Heating Month	1	
Foundation Loads		
Heating Load (Watts):	434	

TYPE: MILLWOOD 3
LO# 79584

Residential Foundation Thermal Load Calculator

Supplemental tool for CAN/CSA-F280

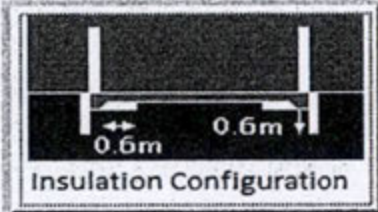Weather Station Description		
Province:	Ontario	
Region:	Brampton	
Site Description		
Soil Conductivity:	Normal conductivity: dry sand, loam, clay	
Water Table:	Normal (7-10 m, 23-33 ft)	
Foundation Dimensions		
Length (m):	14.3	 Insulation Configuration
Width (m):	9.4	
Exposed Perimeter (m):	38.1	
Radiant Slab		
Heated Fraction of the Slab:	0	CITY OF BRAMPTON BUILDING DIVISION REVIEWED BY: S. DESAI NOV 26 2018 ATTACHED NOTES ARE PART OF REVIEWED DRAWINGS ALL WORK MUST COMPLY WITH OBC
Fluid Temperature (°C):	33	
Design Months		
Heating Month	1	
Results		
Heating Load (Watts):		640

TYPE: MILLWOOD 3
LO# 79584

Air Infiltration Residential Load Calculator

Supplemental tool for CAN/CSA-F280


Weather Station Description			
Province:	Ontario		
Region:	Brampton		
Weather Station Location:	Open flat terrain, grass		
Anemometer height (m):	10		
Local Shielding			
Building Site:	Suburban, forest		
Walls:	Heavy		
Flue:	Heavy		
Highest Ceiling Height (m):	8.53		
Building Configuration			
Type:	Detached		
Number of Stories:	Two		
Foundation:	Full		
House Volume (m ³):	951.1		
Air Leakage/Ventilation			
Air Tightness Type:	Present (1961-) (3.57 ACH)		
Custom BDT Data:	ELA @ 10 Pa.	1267.9 cm ²	
	3.57	ACH @ 50 Pa	
Mechanical Ventilation (L/s):	Total Supply	Total Exhaust	
	37.5	37.5	
Flue Size			
Flue #:	#1	#2	#3 #4
Diameter (mm):	0	0	0 0
Natural Infiltration Rates			
Heating Air Leakage Rate (ACH/H):	0.382		
Cooling Air Leakage Rate (ACH/H):	0.124		

CITY OF BRAMPTON
BUILDING DIVISION
REVIEWED BY: S. DESAI
NOV 26 2018
ATTACHED NOTES ARE PART
OF REVIEWED DRAWINGS
ALL WORK MUST COMPLY WITH OBC

TYPE: MILLWOOD 3
LO# 79584

ENSURE THAT MIN THERMAL PERFORMANCE OF BLDG ENVELOPE AND EQUIPMENT SHALL CONFORM TO OBC SB-12, 3.1.1.2 TABLES REQUIREMENTS. FURNACE SHALL BE EQUIPPED WITH BRUSHLESS DIRECT CURRENT MOTOR OBC DIV B 12.3.1.5. SEAL ALL DUCTWORK WITHIN UNCONDITIONED SPACE or OUTDOORS PER OBC DIV B6.2.4.3(11) REQUIREMENTS. SEAL ALL SUPPLY DUCTS LOCATED IN CONDITIONED SPACE IN COMPLIANCE WITH OBC DIV B6.2.4.3(12) REQUIREMENTS. SEPARATE ANY INTAKES FROM BUILDING ENVELOPE PENETRATIONS THAT ARE POTENTIAL SOURCES OF CONTAMINANTS (GAS VENTS, OIL FILL PIPES, etc. BY MIN 900mm (2FT 11IN) - OBC Div B 9.32.3.12.

INSTALLATION OF KITCHEN EXHAUST DUCT LARGER THAN 6" dia SHALL BE PRECEDED BY APPLICATION FOR REVISION OF DESIGN PER OBC PART 6 REQUIREMENTS. EXHAUST FAN SHALL DISCHARGE DIRECTLY TO OUTSIDE. CLOTHES DRYER EXHAUST SYSTEM SHALL COMPLY WITH OBC DIV B 9.32.1.2, 9.32.1.3 & 9.32.3 REQ'S. BALANCE THE RETURN AIRFLOW ON THE UPPER FLOOR TO MATCH THE SUPPLY. WHEN HRV IS USED AS PRINCIPAL EXHAUST FAN, THE CONTROLLER SHALL BE WIRED TO THE HRV UNIT AND INTERCONNECTED TO THE FURNACE FAN. THE FURNACE BLOWER MUST BE IN OPERATION WHEN THE HRV IS IN OPERATION. INSTALL ADDITIONAL S/A REGISTER AS REQUIRED IN ORDER TO ENSURE MIN 72degF - OBC DIV B 9.33.3.1(1). THE DOOR TO ANY ROOM WITHOUT RETURN AIR GRILLE, UNDERCUT BY MIN 1" THE RETURN AIR INTAKE SHALL BE CONNECTED TO THE MAIN R/A DUCT AT A HORIZONTAL DISTANCE OF MIN 6FT FROM THE CASING OF THE UNIT (HRAIDIGEST).

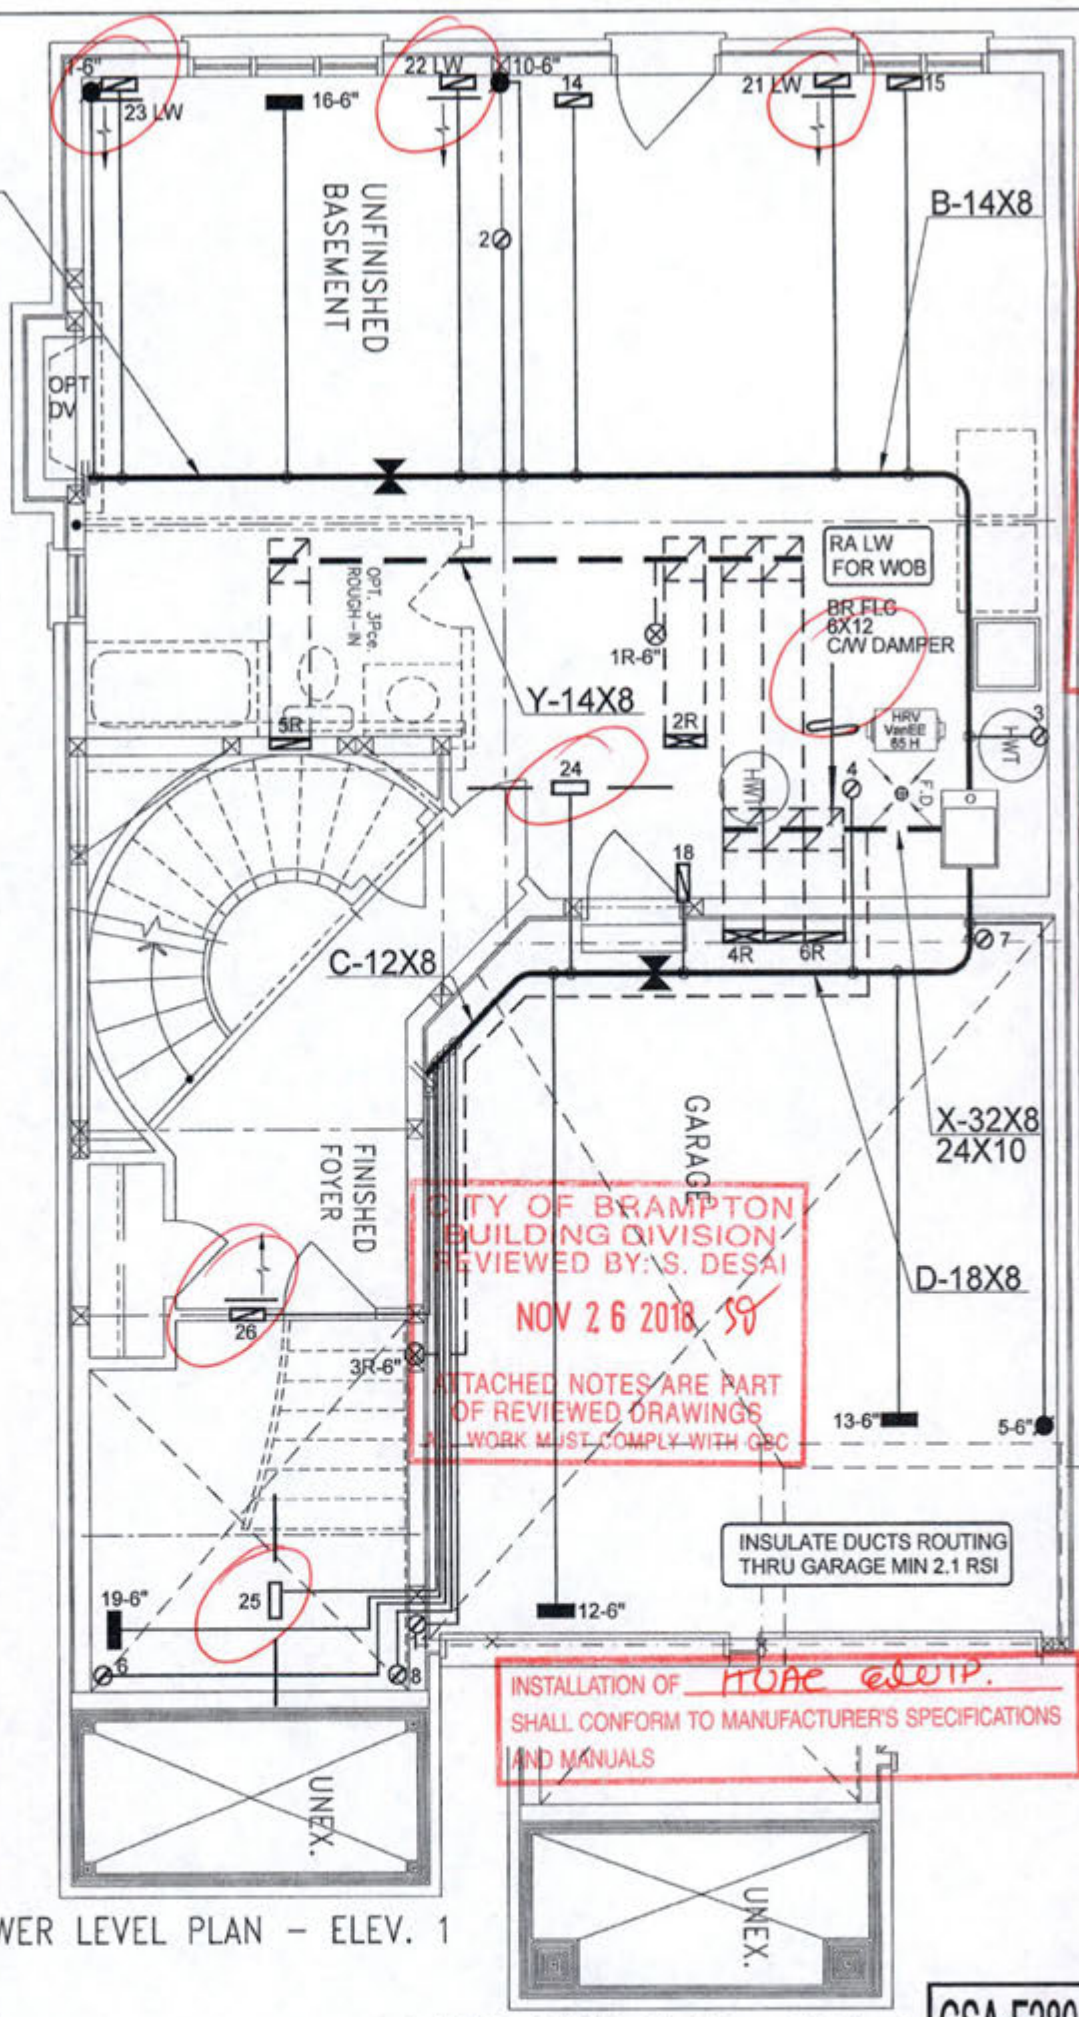

A HEAT RECOVERY VENTILATOR SHALL BE INSTALLED IN COMPLIANCE WITH OBC DIV. B, 6.2.1.6, 9.32.3.6(3), 9.32.3.11 AND HRAIDIGEST REQUIREMENTS.

THE INSTALLATION OF CARBON MONOXIDE DETECTOR(S) SHALL COMPLY WITH OBC DIV. B, 9.33.4 REQUIREMENTS.

MECHANICAL VENTILATION SHALL BE PROVIDED IN CONFORMANCE WITH OBC DIV. B, 9.32.3 REQUIREMENTS.

LOWER LEVEL PLAN - ELEV. 1

LOWER LEVEL PLAN - ELEV. 2

CSA-F280-12
PACKAGE A1

I MICHAEL O'ROURKE HAVE REVIEW AND TAKE RESPONSIBILITY FOR THE DESIGN WORK AND AM QUALIFIED UNDER DIVISION C, 3.2.5 OF THE BUILDING CODE.
Michael O'Rourke
Michael O'Rourke, BCIN# 19669
HVAC DESIGNS LTD.

HVAC LEGEND					
SYMBOL	DESCRIPTION	SYMBOL	DESCRIPTION	SYMBOL	DESCRIPTION
	FLOOR SUPPLY AIR GRILLE		6" SUPPLY AIR BOOT ABOVE		14" R/A RETURN AIR GRILLE
	FLOOR SUPPLY AIR GRILLE 6" BOOT		SUPPLY AIR STACK FROM 2nd FLOOR		20" R/A RETURN AIR GRILLE
	SUPPLY AIR BOOT ABOVE		8" SUPPLY AIR STACK 2nd FLOOR		FRA - FLOOR RETURN AIR GRILLE
					REDUCER
ALL DRAWINGS, CALCULATIONS AND SPECIFICATIONS ARE THE PROPERTY OF HVAC DESIGNS LTD. AND MAY NOT BE REPRODUCED, MODIFIED OR ALTERED WITHOUT EXPRESSED WRITTEN CONSENT. THE DRAWINGS ARE DATED AND USE OF THESE DRAWINGS AFTER ONE YEAR FROM THE DATED NOTED IS NOT AUTHORIZED. CONTRACTOR SHALL CHECK ALL CONDITIONS BEFORE PROCEEDING WITH WORK. LATEST MUNICIPAL APPROVED DRAWINGS ONLY TO BE USED DURING INSTALLATION OF HEATING SYSTEM. HVAC DESIGNS LTD. IS NOT LIABLE FOR ANY CLAIMS ARISING FROM UNAUTHORIZED USE OF THE DRAWINGS OR FROM ANY CHANGES TO ACCEPTED STANDARDS AND/OR THE ONTARIO BUILDING CODE.					
Client		Project Name		Sheet Title	
GREENPARK HOMES		MINNISALE HOMES CORP. BRAMPTON, ONTARIO		BASEMENT HEATING LAYOUT	
MILLWOOD 3		2622 sqft		Date AUG/2018	
				Scale 3/16" = 1'-0"	
				BCIN# 19669	
				LO# 79584	


HEAT LOSS 54881 BTU/H UNIT DATA		# OF RUNS S/A R/A FANS	
MAKE GOODMAN		3RD FLOOR	
MODEL GMEC960803BNA-60		2ND FLOOR	
INPUT 60 MBTUH		1ST FLOOR	
OUTPUT 57.6 MBTUH		BASEMENT	
COOLING 2.5 TONS			
FAN SPEED 1131 cfm @ 0.5" w.c.			

Installation to comply with the latest Ontario Building Code. All supply branch outlets shall be equipped with a manual balancing damper. Ductwork which passes through the garage or unheated spaces shall be adequately insulated and be gas-proofed.

CITY OF BRAMPTON
BUILDING DIVISION
REVIEWED BY: S. DESAI
NOV 26 2018
ATTACHED NOTES ARE PART
OF REVIEWED DRAWINGS
ALL WORK MUST COMPLY WITH OBC

THIS INSTALLATION OF A GAS FIREPLACE IS REGULATED UNDER
THE T.S.S.A. BY C.S.A. B149.1 NATURAL GAS AND PROPANE
INSTALLATION CODE CALL ENBRIDGE FOR INSPECTION AT
1-800-785-1314

MECHANICAL VENTILATION SHALL BE PROVIDED IN
CONFORMANCE WITH OBC DIV. B, 9.32.3 REQUIREMENTS.

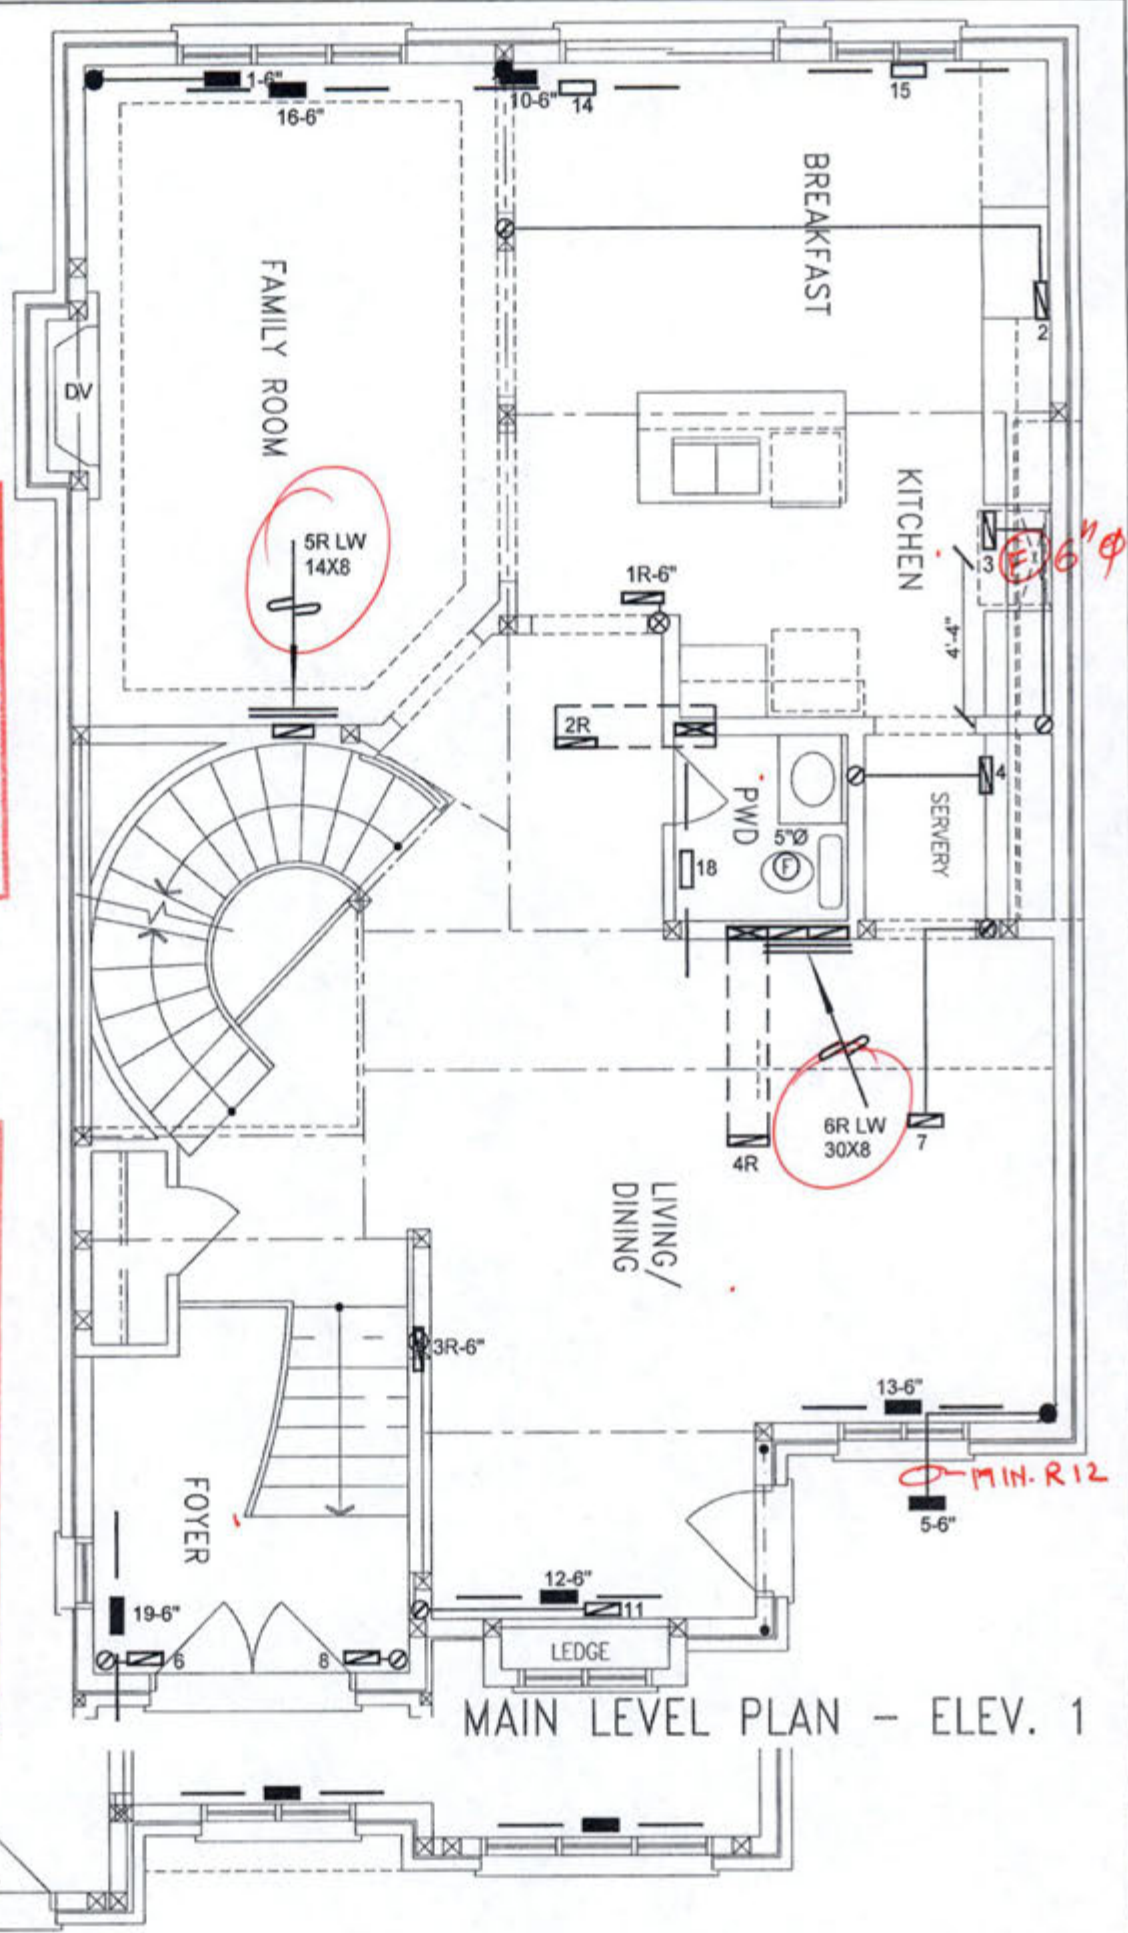

MAIN LEVEL PLAN - ELEV. 1

I MICHAEL O'ROURKE HAVE REVIEW
AND TAKE RESPONSIBILITY FOR THE
DESIGN WORK AND AM QUALIFIED
UNDER DIVISION C, 3.2.5 OF THE
BUILDING CODE.
Michael O'Rourke
Michael O'Rourke, BCIN# 19669
HVAC DESIGNS LTD.

MAIN LEVEL PLAN - ELEV. 2

THE INSTALLATION OF CARBON MONOXIDE DETECTOR(S)
SHALL COMPLY WITH OBC DIV. B, 9.33.4 REQUIREMENTS.

CSA-F280-12
PACKAGE A1

HVAC LEGEND					
	FLOOR SUPPLY AIR GRILLE		8" SUPPLY AIR BOOT ABOVE		14" RETURN AIR GRILLE
	FLOOR SUPPLY AIR GRILLE 6" BOOT		SUPPLY AIR STACK FROM 2nd FLOOR		36" RETURN AIR GRILLE
	SUPPLY AIR BOOT ABOVE		8" SUPPLY AIR STACK 2nd FLOOR		FRA FLOOR RETURN AIR GRILLE
					RETURN AIR STACK 2nd FLOOR
					REDUCER

ALL DRAWINGS, CALCULATIONS AND SPECIFICATIONS ARE THE PROPERTY OF HVAC DESIGNS LTD. AND MAY NOT BE REPRODUCED, MODIFIED OR ALTERED WITHOUT EXPRESSED WRITTEN CONSENT. THE DRAWINGS ARE DATED AND USE OF THESE DRAWINGS AFTER ONE YEAR FROM THE DATED NOTED IS NOT AUTHORIZED. CONTRACTOR SHALL CHECK ALL CONDITIONS BEFORE PROCEEDING WITH WORK. LATEST MUNICIPAL APPROVED DRAWINGS ONLY TO BE USED DURING INSTALLATION OF HEATING SYSTEM. HVAC DESIGNS LTD. IS NOT LIABLE FOR ANY CLAIMS ARISING FROM UNAUTHORIZED USE OF THE DRAWINGS OR FROM ANY CHANGES TO ACCEPTED STANDARDS AND/OR THE ONTARIO BUILDING CODE.

Client
GREENPARK HOMES

Project Name
**MINNISALE HOMES CORP.
BRAMPTON, ONTARIO**

MILLWOOD 3 2622 sqft

HVAC DESIGNS LTD.
375 Finley Ave. Suite 202 - Ajax, Ontario
L1S 2E2 Tel: 905.619.2300 - 905.420.5300 Fax 905.619.2375
Email: info@hvacedesigns.ca
Web: www.hvacedesigns.ca
Specializing in Residential Mechanical Design Services

Installation to comply with the latest Ontario Building Code. All supply branch outlets shall be equipped with a manual balancing damper. Ductwork which passes through the garage or unheated spaces shall be adequately insulated and be gas-proofed.


Sheet Title
**FIRST FLOOR
HEATING
LAYOUT**

Date
AUG/2018


Scale
3/16" = 1'-0"

BCIN# 19669

LO# 79584

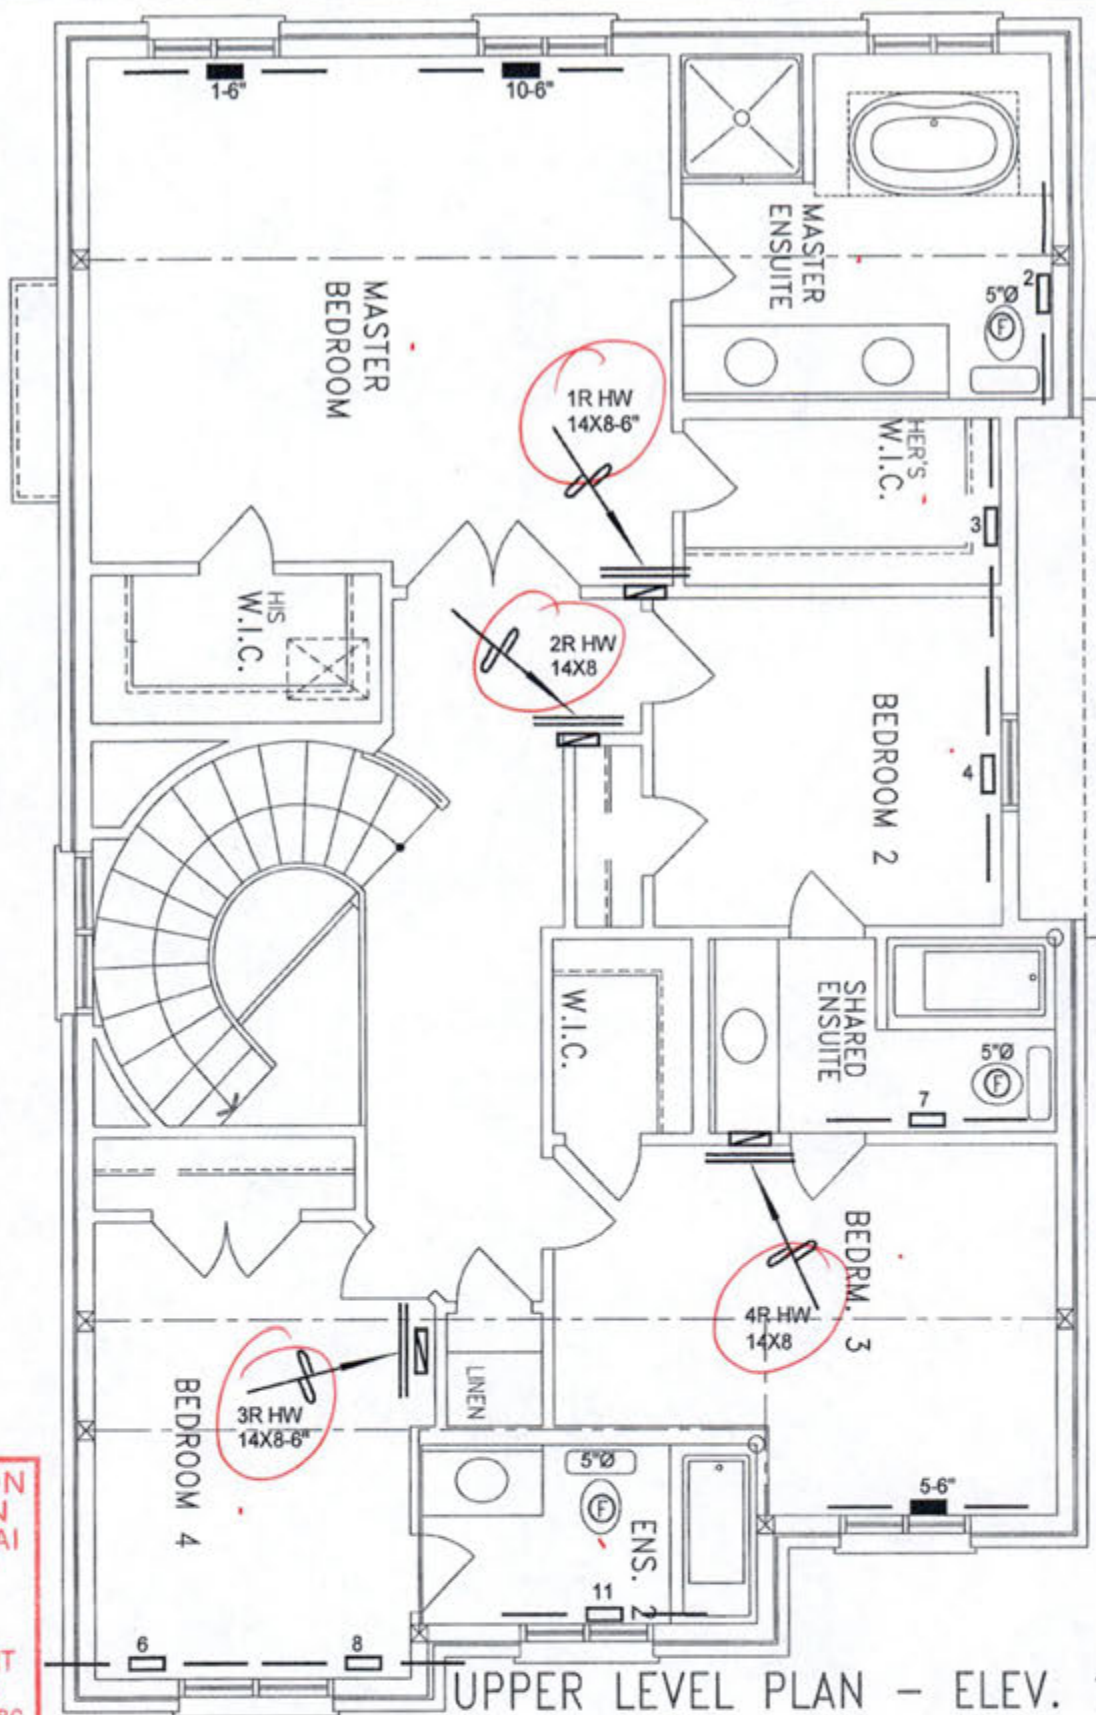

UPPER LEVEL PLAN - ELEV. 1

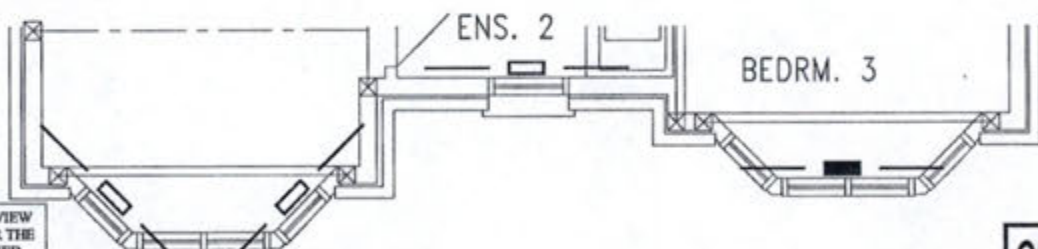

UPPER LEVEL PLAN - ELEV. 2

CSA-F280-12
PACKAGE A1

I MICHAEL O'ROURKE HAVE REVIEWED AND TAKE RESPONSIBILITY FOR THE DESIGN WORK AND AM QUALIFIED UNDER DIVISION C, 3.2.5 OF THE BUILDING CODE.

Michael O'Rourke
Michael O'Rourke, BCIN# 19669
HVAC DESIGNS LTD.

HVAC LEGEND						3.	
SYMBOL	DESCRIPTION	SYMBOL	DESCRIPTION	SYMBOL	DESCRIPTION	2.	
	FLOOR SUPPLY AIR GRILLE		6" SUPPLY AIR BOOT ABOVE		14" RETURN AIR GRILLE		
	FLOOR SUPPLY AIR GRILLE 6" BOOT		SUPPLY AIR STACK FROM 2nd FLOOR		30" RETURN AIR GRILLE		
	SUPPLY AIR BOOT ABOVE		6" SUPPLY AIR STACK 2nd FLOOR		FRA-FLOOR RETURN AIR GRILLE		

ALL DRAWINGS, CALCULATIONS AND SPECIFICATIONS ARE THE PROPERTY OF HVAC DESIGNS LTD. AND MAY NOT BE REPRODUCED, MODIFIED OR ALTERED WITHOUT EXPRESSED WRITTEN CONSENT. THE DRAWINGS ARE DATED AND USE OF THESE DRAWINGS AFTER ONE YEAR FROM THE DATED NOTED IS NOT AUTHORIZED. CONTRACTOR SHALL CHECK ALL CONDITIONS BEFORE PROCEEDING WITH WORK. LATEST MUNICIPAL APPROVED DRAWINGS ONLY TO BE USED DURING INSTALLATION OF HEATING SYSTEM. HVAC DESIGNS LTD. IS NOT LIABLE FOR ANY CLAIMS ARISING FROM UNAUTHORIZED USE OF THE DRAWINGS OR FROM ANY CHANGES TO ACCEPTED STANDARDS AND/OR THE ONTARIO BUILDING CODE.

Client GREENPARK HOMES		HVACDESIGNS LTD. 375 Finley Ave. Suite 202 - Ajax, Ontario L1S 2E2 Tel. 905.619.2300 - 905.420.5300 Fax 905.619.2375 Email: info@hvacdesigns.ca Web: www.hvacdesigns.ca Specializing in Residential Mechanical Design Services	Sheet Title SECOND FLOOR HEATING LAYOUT	
Project Name MINNISALE HOMES CORP. BRAMPTON, ONTARIO			Date AUG/2018	Scale 3/16" = 1'-0"
MILLWOOD 3		Installation to comply with the latest Ontario Building Code. All supply branch outlets shall be equipped with a manual balancing damper. Ductwork which passes through the garage or unheated spaces shall be adequately insulated and be gas-proofed.	BCIN# 19669	
2622 sqft			LO# 79584	