

CONSTRUCTION SUMMARY

Mountainview Heights (G) - Russell Gardens Building Ltd.

PURCHASERS: MECNUN KARAYIGIT and YANLI ZHANG

TEL:

LOT / PHASE Block 202 TH 1 / 2	REG. PLAN # 62M-1238	HOUSE TYPE Highgrove 5E Elev 3		
-----------------------------------	-------------------------	-----------------------------------	--	--

CABINETRY ACCESSORIES

1 - PANTRY UNIT UPGRADE - TO GO FROM 300MM TO 600MM DEEP - PRICE IS PER FOOT - STANDARD 18Apr19 Note:	
1 - KITCHEN CABINETRY UPPER - FULL DEPTH ABOVE FRIDGE - WITH GABLES - 600MM - PRICE IS EACH - STANDARD 18Apr19 Note:	
1 - KITCHEN CABINETRY BASE - PIE CUT CORNER CABINET - BASE CABINETRY - STANDARD 18Apr19 Note:	

CERAMIC TILE

1 - TILE - UPGRADE 2 FLOOR TILE - - KITCHEN 18Apr19 Note:	
1 - TILE - UPGRADE 1 WALL TILE - - ENSUITE WALL TILE - SHOWER 18Apr19 Note:	
1 - TILE - UPGRADE 1 WALL TILE - - ENSUITE TUB - SURROUND 18Apr19 Note:	
1 - TILE - UPGRADE 1 FLOOR TILE - - ENSUITE BATHROOM - FLOOR 18Apr19 Note:	

ELECTRICAL

1 - ABOVE KITCHEN ISLAND - ADD LIGHT AND SWITCH - NO FIXTURE INCLUDED 18Apr19 Note:	
--	--

PLUMBING

1 - WASHROOM - 3 PIECE ROUGH-IN IN BASEMENT 01Apr19 Note:	
--	--

PROMOTIONAL

1 - LESS BALANCE OF CREDIT FROM PURCHASER EXTRA SHEET IN OFFER 18Apr19 Note:	
1 - PARTIAL REDEMPTION OF PROMOTIONAL PACKAGE \$6860.00 BALANCE FORWARD TO BE USED AT A LATER DATE. ORIGINAL PROMOTIONAL PACKAGE OF \$7500.00 AS PER SCHEDULE PE 01Apr19 Note:	

STAIRS AND RAILINGS

1 - STAIRCASE - 1-¾" COLONIAL PICKETS 18Apr19 Note:	
--	--

EXTRAS AS PER OFFER

Five (5) White Appliances as per PE Appliances Worksheet Note:	
The Purchaser acknowledges that the Purchase Price is inclusive of all credits and promotional packages available at the time of purchase. Worksheet Note:	
The Vendor agrees that notwithstanding any other term or provision in this Agreement included in the Purchase Price and in addition to those items detailed in Schedule GP to the Agreement of Purchase and Sale, the Purchaser is entitled to a credit of Sev Worksheet Note:	

RECEIVED APR 25 2019

Purchasers:

MECNUN KARAYIGIT & YANLI ZHANG

Telephone Res. / Bus:

/

Decor Advisor:

Candace Forza

Lock Date:

18-Apr-19

Property:

Block 202 TH 1

Project:

Russell Gardens Building Ltd.

Model and Elevation:

Highgrove 5E Elev 3

Plan #:

62M-1238

Layout Changes:

☐ Yes ☒ No

Sketch Attached:

☒ Yes ☐ No

Exterior Colour Scheme:

1. Cabinetry

	Style and Colour	Hardware
Kitchen / Breakfast	HASTING CHOCOLATE	2003
Laundry Room	ELISSE	Standard
Powder Room	CONTINENTAL 350 PLATINUM SILVER	1004
Master Ensuite Bathroom	CONTINENTAL 823 DRIFTWOOD	2002
Shared Ensuite	EVEREST WHITE	2002
	N/A	N/A
	N/A	N/A
	N/A	N/A
	N/A	N/A

Appliances:

Built In Appliances

☐ Yes ☒ No

Slide In Stove

☐ Yes ☒ No

Dishwasher Cabinet

☐ Closed ☒ Open

41" Upper Cabinets

☒ Yes ☐ No

Please NOTE: Standard Cabinet Height is 30"

Stove Opening

NOTE: If not specified, opening will be set to builder's standard opening of approximately 30" width

Fridge Opening

NOTE: If not specified, opening will be set to builder's standard opening of approximately 37" width x 74" height

** Refer to Construction Summary

2. Counters

	Counter	Edge
Kitchen / Breakfast	LAMINATE-CALCUTTA MARBLE 4925K-07	
Laundry Room	N/A	
Powder Room	LAMINATE-PEARL SOAPSTONE 4886-38	
Master Ensuite Bathroom	LAMINATE-WHITE CARRARA 4924-38	
Shared Ensuite	LAMINATE-WHITE CARRARA 4924-38	
	N/A	
	N/A	
	N/A	
	N/A	

** Refer to Construction Summary

Purchasers:

MECNUN KARAYIGIT & YANLI ZHANG

Telephone Res. / Bus:

/

Decor Advisor:

Candace Forza

Lock Date:

18-Apr-19

Property:

Block 202 TH 1

Project:

Russell Gardens Building Ltd.

Model and Elevation:

Highgrove 5E Elev 3

Plan #:

62M-1238

3. Ceramic Flooring

Entrance Vestibule	TILE-SIENA GREY-13X13	☐	At a 45 Threshold-If App.
Main Hall	LAMINATE	☐	metal strip where applicable
Kitchen / Breakfast	TILE-VERSAILLES CHATEAUX IVIRE-12X24	☐	
Laundry Room	TILE-BEACH LIGHT GREY-13X13	☐	
Powder Room	TILE-BEACH LIGHT GREY-13X13	☐	
Master Ensuite Bathroom	TILE-HARMONIE GRIS-8X24	☐	
Main Bathroom	TILE-ESSENZE GRIGIO-13X13	☐	
GARAGE ENTRY	TILE-BEACH LIGHT GREY-13X13	☐	
	N/A	☐	
	N/A	☐	
	N/A	☐	

** Refer to Construction Summary

4. Ceramic Wall Tile

Master Ensuite Bathroom	Selection	Describe
Tub Deck Wall	TILE-HARMONIE BLANC-8X24	
Tub Deck	N/A	
Tub Deck Skirt	N/A	
Shower Stall	TILE-HARMONIE BLANC-8X24	
Bathtub Enclosure Walls	N/A	
Main Bathroom	TILE-NATURELE GRIGIO-8X10	
GARAGE ENTRY	N/A	
	N/A	
	N/A	
	N/A	
Kitchen Backsplash	N/A	

** Refer to Construction Summary - STANDARD GROUT THROUGHOUT UNLESS SPECIFIED

5. Plumbing Fixtures

All Bathrooms

White

N/A

N/A

Whirlpool

N/A ☐ Yes ☒ No

Dishwasher Rough-In

☒ Yes ☐ No

Waterline for Fridge

☐ Yes ☒ No

** Refer to Construction Summary

6. Trim Carpentry

Interior Doors	Classique
Interior Trim	As Per Construction Specifications
Door Handles	As Per Construction Specifications
Exterior Front Door Handle	As Per Construction Specifications

** Refer to Construction Summary

Initials:

Purchasers:

MECNUN KARAYIGIT & YANLI ZHANG

Telephone Res. / Bus:

/

Decor Advisor:

Candace Forza

Lock Date:

18-Apr-19

Property:

Block 202 TH 1

Project:

Russell Gardens Building Ltd.

Model and Elevation:

Highgrove 5E Elev 3

Plan #:

62M-1238

7. Other Flooring

Main Hall	LAMINATE-PARK LANE - NEWCASTLE OAK DARK TL-EL3581
Living Room	LAMINATE-PARK LANE - NEWCASTLE OAK DARK TL-EL3581
Dining Room	LAMINATE-PARK LANE - NEWCASTLE OAK DARK TL-EL3581
Family Room	LAMINATE-PARK LANE - NEWCASTLE OAK DARK TL-EL3581
Den / Library / Study	N/A
Basement Landing(If Applies)	N/A
Lower Landing (If Applies)	LAMINATE-PARK LANE - NEWCASTLE OAK DARK TL-EL3581
Upper Landing	LAMINATE-PARK LANE - NEWCASTLE OAK DARK TL-EL3581
Upper Hall	CARPET-BEAULIEU - A4447 WEBSTER SDN - BROWN BAG 18924
Master Bedroom	CARPET-BEAULIEU - A4447 WEBSTER SDN - BROWN BAG 18924
Bedroom #2	CARPET-BEAULIEU - A4447 WEBSTER SDN - BROWN BAG 18924
Bedroom #3	CARPET-BEAULIEU - A4447 WEBSTER SDN - BROWN BAG 18924
Bedroom #4	CARPET-BEAULIEU - A4447 WEBSTER SDN - BROWN BAG 18924
Bedroom #5	N/A
	N/A
	N/A
	N/A
Underpad	TypeArea
	STANDARDSTANDARD

** Refer to Construction Summary

8. Railings and Pickets

Railing Type	AS PER CONSTRUCTION SPECIFICATIONS	Colour	TORLYS NEWCASTLE OAK DARK
Picket Type	1 3/4 PICKETS COLONIAL	Colour	TORLYS NEWCASTLE OAK DARK
Stringer / Riser	AS PER CONSTRUCTION SPECIFICATIO	Colour	TORLYS NEWCASTLE OAK DARK
Treads	AS PER CONSTRUCTION SPECIFICATIO	Colour	TORLYS NEWCASTLE OAK DARK
Red Oak Stairs with Semi Gloss Finish		☒ Yes ☐ No	

** Refer to Construction Summary

9. Wall Paint Flat Finish

Main & Upper Hall	25 OYSTER	Master Bedroom	25 OYSTER
Living Room	25 OYSTER	Bedroom #2	25 OYSTER
Dining Room	25 OYSTER	Bedroom #3	25 OYSTER
Kitchen / Breakfast	25 OYSTER	Bedroom #4	25 OYSTER
Family Room	25 OYSTER	Bedroom #5	N/A
Powder Room	25 OYSTER	Master Ensuite	25 OYSTER
Laundry Room	25 OYSTER	Main Bathroom	25 OYSTER
Den/Library	N/A		N/A
Trim Paint-Semi Gloss	BIRCH WHITE		N/A
	N/A		N/A
	N/A		N/A

Smooth Ceilings First Floor ☐ Yes ☒ No

** Refer to Construction Summary

Initials: 

Purchasers: MECNUN KARAYIGIT & YANLI ZHANG

Property: Block 202 TH 1

Telephone Res. / Bus: /

Project: Russell Gardens Building Ltd.

Decor Advisor: Candace Forza

Model and Elevation: Highgrove 5E Elev 3

Lock Date: 18-Apr-19

18-Apr-19

Plan #: 62M-1238

10. Plaster Mouldings and Medallions

Entrance Vestibule	N/A	N/A	Kitchen/Breakfast	N/A	N/A
Main Hall	N/A	N/A	Den/Library	N/A	N/A
Living Room	N/A	N/A	Lower Landing	N/A	N/A
Dining Room	N/A	N/A		N/A	N/A
Family Room	N/A	N/A		N/A	N/A

** Refer to Construction Summary

11. Fireplace

	Living Room			Family Room			Other Room - Specify		
	Purchased	As Per Plan	N/A	Purchased	As Per Plan	N/A	Purchased	As Per Plan	N/A
	☐	☐	☒	☐	☐	☒	☐	☐	☒
Fireplace Type	N/A			N/A			N/A		
Mantle Type	N/A			N/A			N/A		
Colour / Stain	N/A			N/A			N/A		
Surround	N/A			N/A			N/A		
Hearth	N/A			N/A			N/A		

** Refer to Construction Summary

12. Heating and Air Conditioning

Air Conditioning	NO	Gas Provisions Stove	NO
Gas Provisions Dryer	NO	Gas Provisions Barbecue	NO
Comment			

** Refer to Construction Summary

13. Electrical

Plugs and Switches	☒ White	DECOR	Above Kitchen Cabinet Light	☐ Yes ☒ No
Hood Fan	STANDARD WHITE		Below Kitchen Cabinet Light	☐ Yes ☒ No
Appliances	Built in Cooktop		Gas Stove	Microwave
	☐ Yes ☒ No	Built in Oven	☐ Yes ☒ No	☐ Yes ☒ No
		☐ Yes ☒ No		
Dishwasher Rough-in	Yes			

** Refer to Construction Summary

14. General Comments

** Refer to Construction Summary

Disclaimers and Notes

- Colours of all materials are as close as possible to builder's selection, but not necessarily identical due to variances in manufacturing.
- Any extras listed above are null and void unless accompanied by a separate invoice/amendment. Said invoice must be paid in full.
- The Purchaser agrees that this colour selection is final and that no changes will be permitted, unless required by the Vendor.
- The Purchaser acknowledges reading and accepting document which contains other miscellaneous disclaimers.


Signature:  Date: _____ Signature: _____ Date: _____

PROVIDE GABLE
WITH CUT-OUT
FOR ELECT. PLUG


SQUARE EDGE ISLAND

CT=
2146

CT=
1280

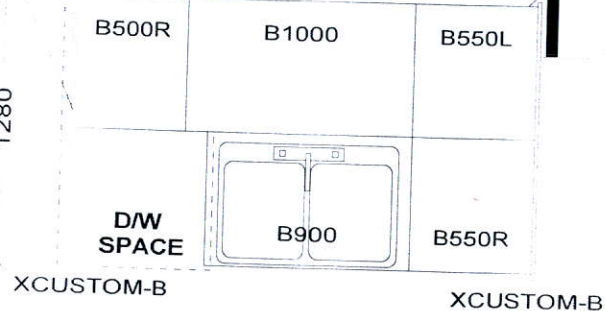


Full Depth Pantry
(24" Deep)

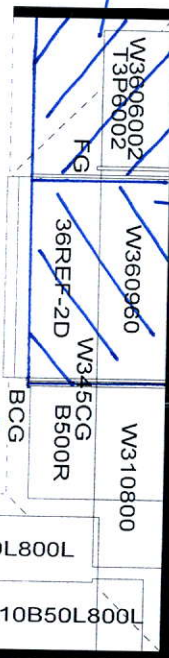


Full Depth
Fridge
Upper with
Gable
(24" Deep)


Base Tile
Cut Corner
Cabinet

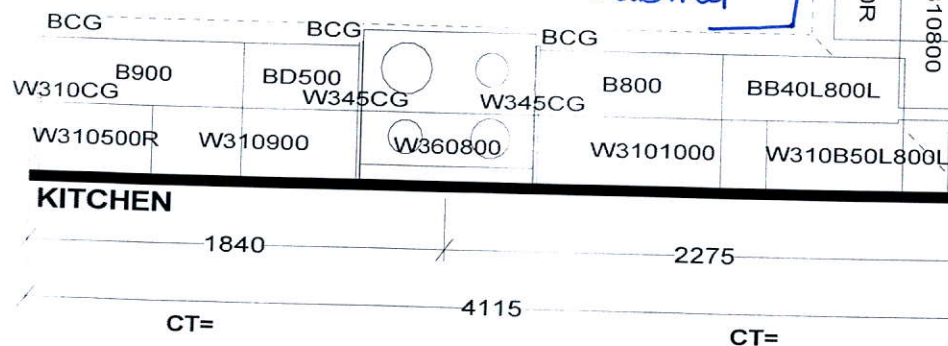


CT=
750
LAUNDRY

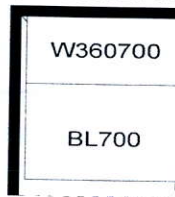


CT=
965
POWDER

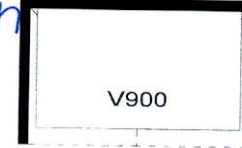

CT=
1524
(A) ENSUITE

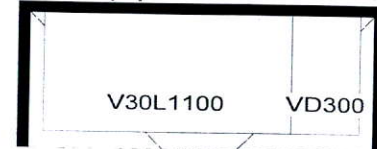

CT=
1727
(B) MAIN-BDRM.#3/4



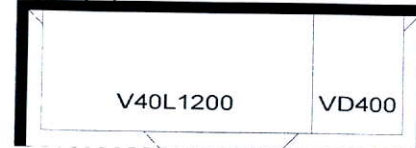


Selba Industries

W	WDTH	W	HGHT	W	CNT	FL	HGHT	DWY	H	ST	CENT	2X4	VENT	BOX	COVER
STANDARD FEATURES:															
1040MM HIGH UPPERS (9' Ceiling-No D/C Box)															
DUMMY DOORS															
D/W SPACE															
LAMINATE KITCHEN & VANITY COUNTERTOPS															
This drawing is the intellectual property of SELBA INDUSTRIES INC. and is an original design which must not be released or copied unless applicable fee has been paid or job order placed.								H A B C G F E D		JOB NUMBER: BUILDER: GREENPARK SITE NAME: RUSSEL GARDENS MODEL: HIGHGROVE 5EX ELEV 1,2,3,3A,3B LOT #: DESIGNER: KS DATE: SEPT 13.17					

AVAILABLE IN BLOCK: 200, 201, 202, 203, 204, 205, 206,
207, 208, 209, 210, 211, 212, 216, 217 & 218

AVAILABLE IN BLOCK: 200, 201, 202, 203, 204, 205, 206,
207, 208, 209, 210, 211, 212, 216, 217 & 218

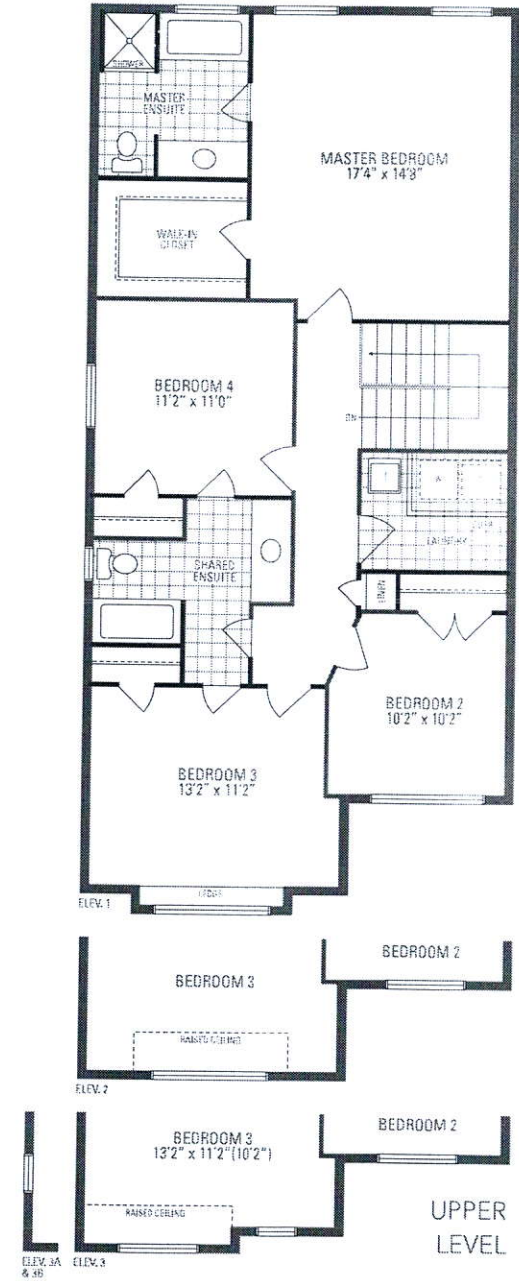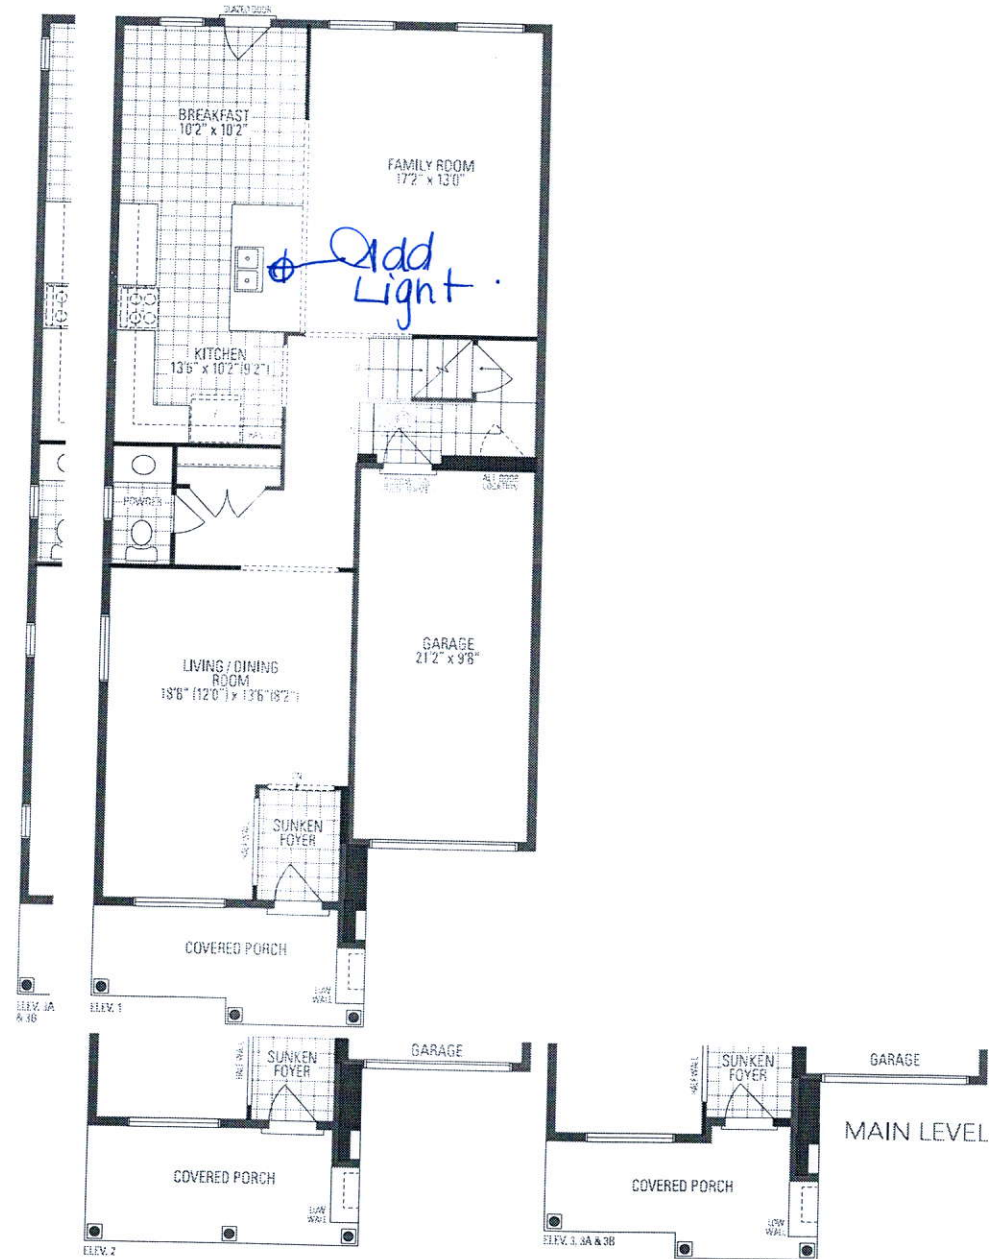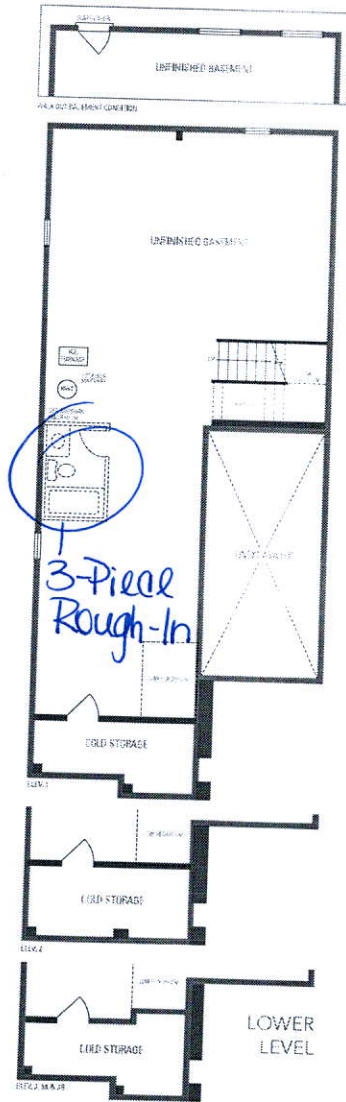

Orientation of home may be reversed and purchaser agrees to accept the same. Steps and porches may vary along exterior entrance ways due to grading variance. Actual usable floor space may vary from the stated floor area. All renderings are artist's concept. Dimensions, specifications and architectural detailing subject to minor modifications. Final location of sump pump is based on site conditions. Roofline and adjoining model types may vary due to siting. E & D.E. LED Highgrove SE • Copyright Sept. 2017