

CONSTRUCTION SUMMARY

Mountainview Heights (G) - Russell Gardens Building Ltd.

PURCHASERS: UZAIR AYMAN AMIR and ABDUR RAHMAN AMIR

TEL: RES.: 416-798-4151

LOT / PHASE 77 / 2	REG. PLAN # 62M-1238	HOUSE TYPE Rosewood 11 Elev 2		
-----------------------	-------------------------	----------------------------------	--	--

ELECTRICAL

1 - POT LIGHT - EXTERIOR - SOFFIT MOUNT - REGULAR VOLTAGE 01May19 Note:	
1 - PLUG - ELECTRICAL PLUG - TO BE INSTALLED OVER FIREPLACE 01May19 Note:	
1 - LIGHT AND SWITCH - NO FIXTURE INCLUDED - LIVING ROOM 01May19 Note:	
1 - 200 AMP ELECTRICAL SERVICE 01May19 Note:	

PROMOTIONAL




1 - PARTIAL REDEMPTION OF PROMOTIONAL PACKAGE \$1,500 BALANCE FORWARD \$18,500 TO BE USED AT A LATER DATE. ORIGINAL PROMOTIONAL PACKAGE OF \$20,000 AS PER SCHEDULE PE 01May19 Note:	
--------------------------------------------------------------------------------------------------------------------------------------------------------------------------------------------	--

EXTRAS AS PER OFFER

The Purchaser acknowledges that the Purchase Price is inclusive of all credits and promotional packages available at the time of purchase. Worksheet Note:	
The Vendor agrees that notwithstanding any other term or provision in this Agreement included in the Purchase Price and in addition to those items detailed in Schedule GP to the Agreement of Purchase and Sale, the Purchaser is entitled to a credit of Two Worksheet Note:	

This Document is Extremely Time Sensitive - Printed 1 May 19 at 13:11

Greenpark GROUP

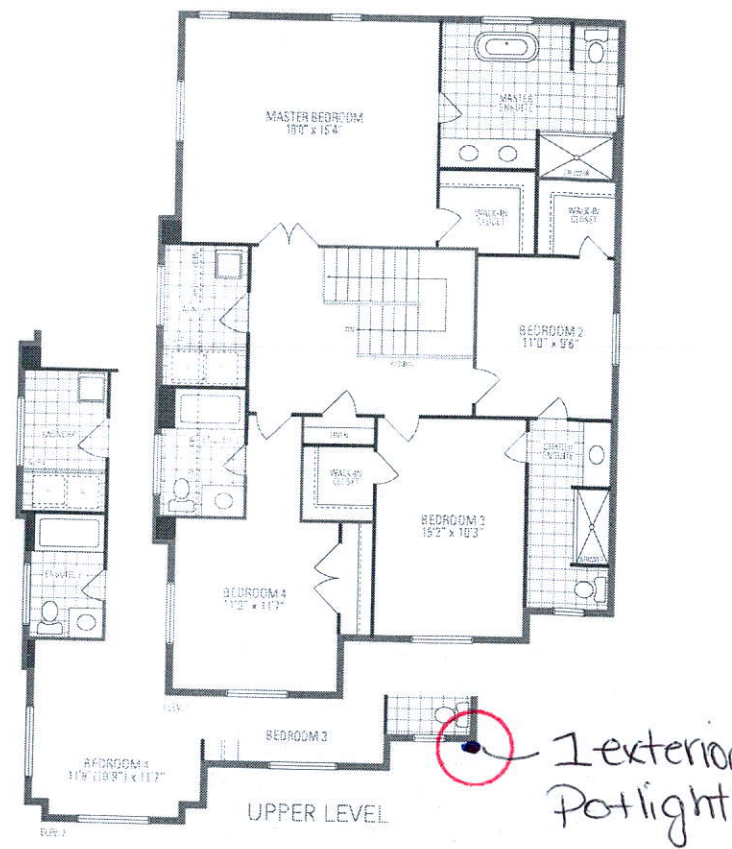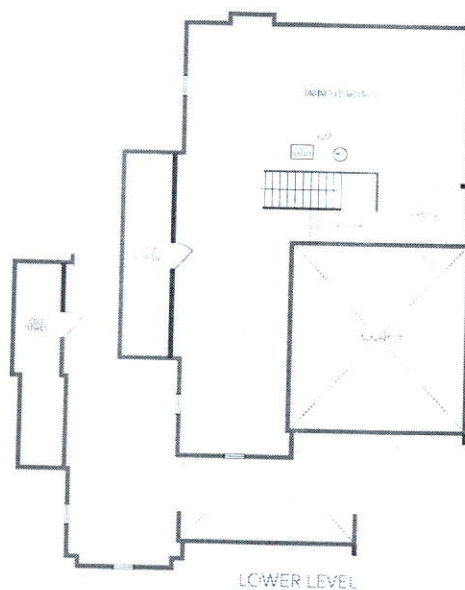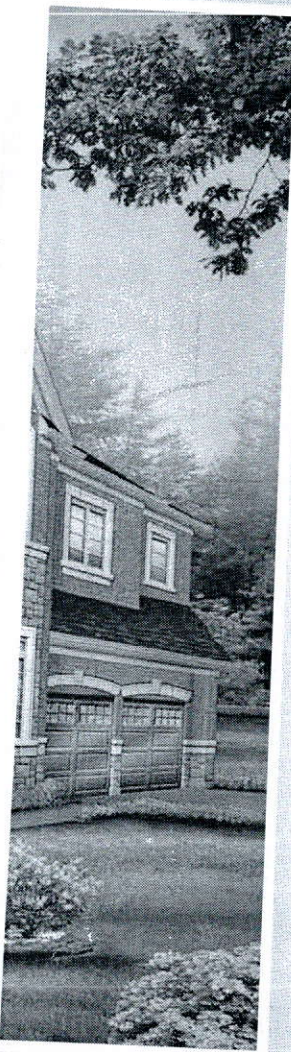

ROSEWOOD 11  
2,617 sq.ft.

Optimization of home may be reviewed and purchaser agrees to accept the same. Steps and porches may vary at any exterior entrance ways due to grading variance. Actual usable floor space may vary from the stated floor area. All renderings are artistic concepts. Dimensions, specifications and references are all subject to minor modifications. Final location of sump pump is based on the construction. Routine and adjoining model types may vary due to design. E. & J.E. Rosewood 11 • Copyright Sept. 2017