


PEAKS c/b's LOT

BLACK-OUT

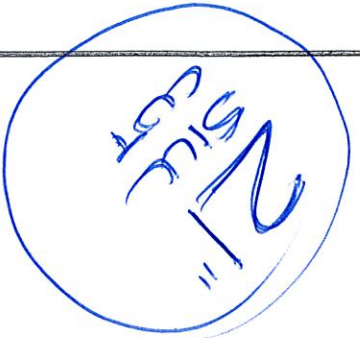

7200 FOOTING
FOR DECK LOT
CARET. B-20114

SIGNATURE OF ENGINEER

[Handwritten signature]

ONE RISER

STORM CONNECTION	VALVE AND CHAMBER	2.0%	PROP. SWALE	AIR-CONDITIONING UNIT	FF	FINISHED FLOOR ELEVATION
SANITARY CONNECTION	STREET LIGHT		PROPOSED 3:1 SLOPE	TELECOM. JUNCTION BOX	TS	TOP OF FOUNDATION WALL
WATER CONNECTION	VALVE AND BOX	*	ENGINEERED FILL LOT	SUMP PUMP	FW	FINISHED BASEMENT SLAB
H — DOUBLE CONNECTION	SANITARY MANHOLE	⊗	TRANSFORMER	CLAY LINER	UF	UNDERSIDE OF FOOTING
HO — DOUBLE CATCH BASIN	STORM MANHOLE	⊗	CABLE TV PEDESTAL	EXTERIOR DOOR LOCATION	UF-R	UNDERSIDE OF FOOTING @ REVERSE PLAN
CATCH BASIN	COMMUNITY MAIL BOX	⊗	BELL PEDESTAL	EXTERIOR DOOR LOCATION	WOB	WALK-OUT BASEMENT
HYDRANT	DOWNSPOUT LOCATION	⊗	HYDRO METER	GRADE PERMITTING	WOD	WALK-OUT DECK
		⊗	2.0% MINIMUM	PROPOSED GRADE	x 100.00	PROPOSED GRADE

GREENYORK HOMES

LOT 4

Drawn by:	MT	Checked by:	MS
Scale:	1:250	Date:	JAN 2019
Project #:	17-25		

The undersigned has reviewed and takes responsibility for this design, and has the qualifications and meets the requirements set out in the Ontario Building Code to

[illegible]