

CONSTRUCTION SUMMARY

Mountainview Heights (G) - Russell Gardens Building Ltd.

RECEIVED MAY 22 2019

PURCHASERS: RAHIM RAJANI and SHAMSA RAJANI

TEL: RES.: 416-841-6841

LOT / PHASE 168 / 2	REG. PLAN # 62M-1238	HOUSE TYPE Sawmill 1 Elev 1		
------------------------	-------------------------	--------------------------------	--	--




ELECTRICAL

1 - LIGHT AND SWITCH - NO FIXTURE INCLUDED - LIVING ROOM 22May19 Note:	
1 - LIGHT - EXTERIOR WITH INTERIOR SWITCH 22May19 Note:	
1 - PLUG - ELECTRICAL PLUG - TO BE INSTALLED OVER FIREPLACE 22May19 Note:	
1 - 200 AMP ELECTRICAL SERVICE 22May19 Note:	


PROMOTIONAL

1 - PARTIAL REDEMPTION OF PROMOTIONAL PACKAGE \$1,505 BALANCE FORWARD \$20,995 TO BE USED AT A LATER DATE. ORIGINAL PROMOTIONAL PACKAGE OF \$22,500 AS PER SCHEDULE PE 22May19 Note:	
--	--

This Document is Extremely Time Sensitive - Printed 22 May 19 at 10:07

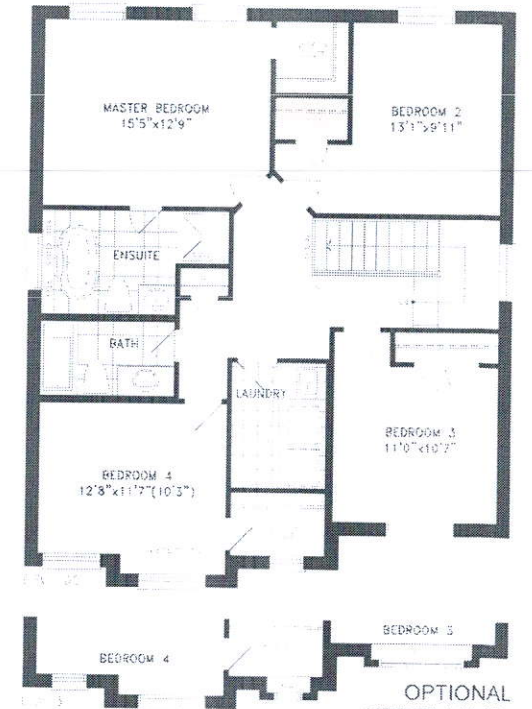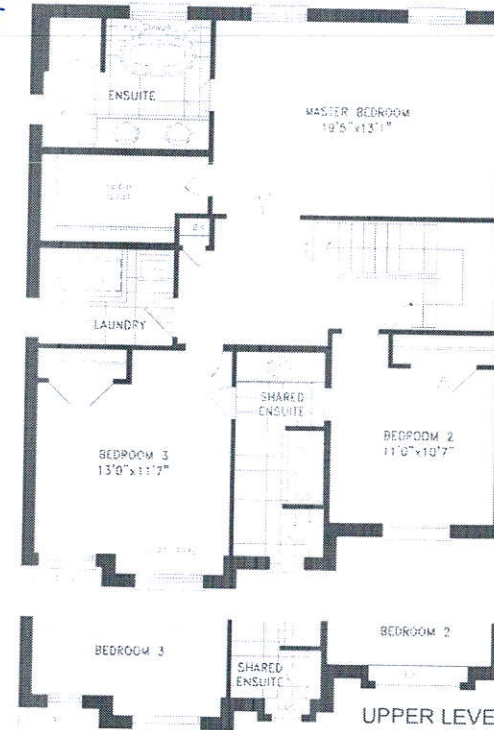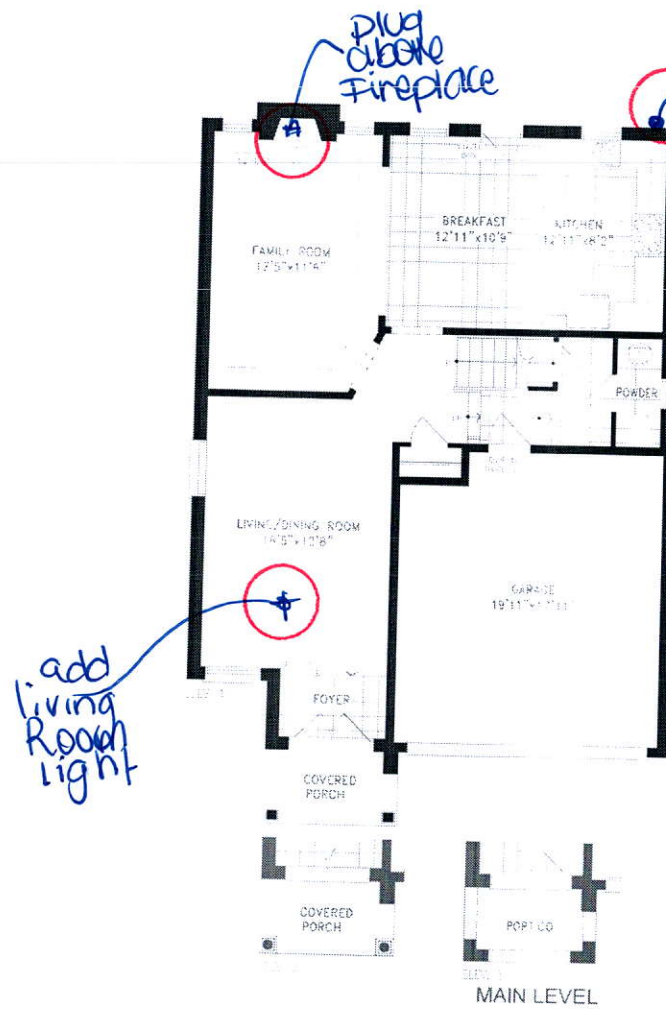

OPTIONAL
UPPER LEVEL
4 BEDROOM

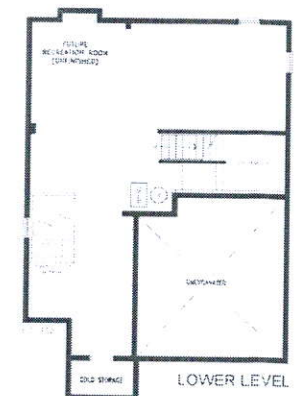

SAWMILL 1
2,247 SQ.FT.