

CONSTRUCTION SUMMARY

Georgian Estate Collection - Tiburtino Buildup Corp.

PURCHASER: Danilo VARAKLIC TEL: RES.: 647-637-4894 BUS.: 905-829-3538

LOT / PHASE 9 / 1	REG. PLAN # 20M-1210	HOUSE TYPE Georgian One Elev A		
----------------------	-------------------------	-----------------------------------	--	--

ELECTRICAL

1 - MASTER EBDROOM- 3 WAY SWITCH 25Jun19 Note:	
1 - FAMILY ROOM POTLIGHTS TO BE ON DIMMER SWITCH 25Jun19 Note:	
1 - PLUG - ELECTRICAL PLUG - ADD TO ISLAND 25Jun19 Note:	
1 - STANDARD PORCH LIGHT TO BE CENTERED IN PORCH CEILING 25Jun19 Note:	
1 - POT LIGHT - SHOWER POT LIGHT- SHARED ENSUITE 2/3 TUB 25Jun19 Note:	
3 - LIGHT AND SWITCH - NO FIXTURE INCLUDED- BEDROOM 5 ENSUITE, BEDROOM 4 ENSUITE AND SHARED 2/3 ENSUITE- SEE SKETCH 25Jun19 Note:	
7 - POT LIGHT - LED - BASEMENT REC ROOM INSTALLATION- SEE SKETCH 25Jun19 Note:	
1 - REC ROOM- ADD ROUGH IN ELECTRICAL FOR FUTURE WET BAR DISHWASHER AND FRIDGE- SEE SKETCH 25Jun19 Note:	
3 - PLUG - ELECTRICAL PLUG- ADD PLUG 5 FT FROM FLOOR FOR TV- FAMILY ROOM, REC ROOM, MASTER BEDROOM- SEE SKETCH 25Jun19 Note:	
1 - DELETE STANDARD MAIN HALL LIGHTS- FIRST FLOOR AND REC ROOM- SEE SKETCH 25Jun19 Note:	
1 - ABOVE KITCHEN ISLAND - ADD LIGHT AND SWITCH - NO FIXTURE INCLUDED- 2 LIGHTS TOTAL ABOVE ISLAND SEE SKETCH 25Jun19 Note:	
1 - LIGHT AND SWITCH - NO FIXTURE INCLUDED - LIVING ROOM 25Jun19 Note:	

FIREPLACE AND ACCESSORIES

1 - FIREPLACE - GAS - DIRECT VENT - INCLUDES MARBLE SURROUND AND PAINT GRADE MANTEL- REC ROOM SEE SKETCH 25Jun19 Note:	
1 - GAS LINE ROUGH-IN FOR BARBECUE - FIRST FLOOR 25Jun19 Note:	

PLUMBING

1 - ALL EXTERIOR HOSE BIBS TO BE FROST FREE- FRONT AND BACK 25Jun19 Note:	
1 - REC ROOM- ADD ROUGH IN PLUMBING FOR FUTURE WET BAR- SEE SKETCH 25Jun19 Note:	


PROMOTIONAL

1 - PARTIAL REDEMPTION OF PROMOTIONAL PACKAGE \$9,600 BALANCE FORWARD \$30,400 TO BE USED AT A LATER DATE. ORIGINAL PROMOTIONAL PACKAGE OF \$40,000 25Jun19 Note:	
--	--

This Document is Extremely Time Sensitive - Printed 25 Jun 19 at 17:24

RECEIVED JUN 26 2019


LOT 9 "TIBURTINO"

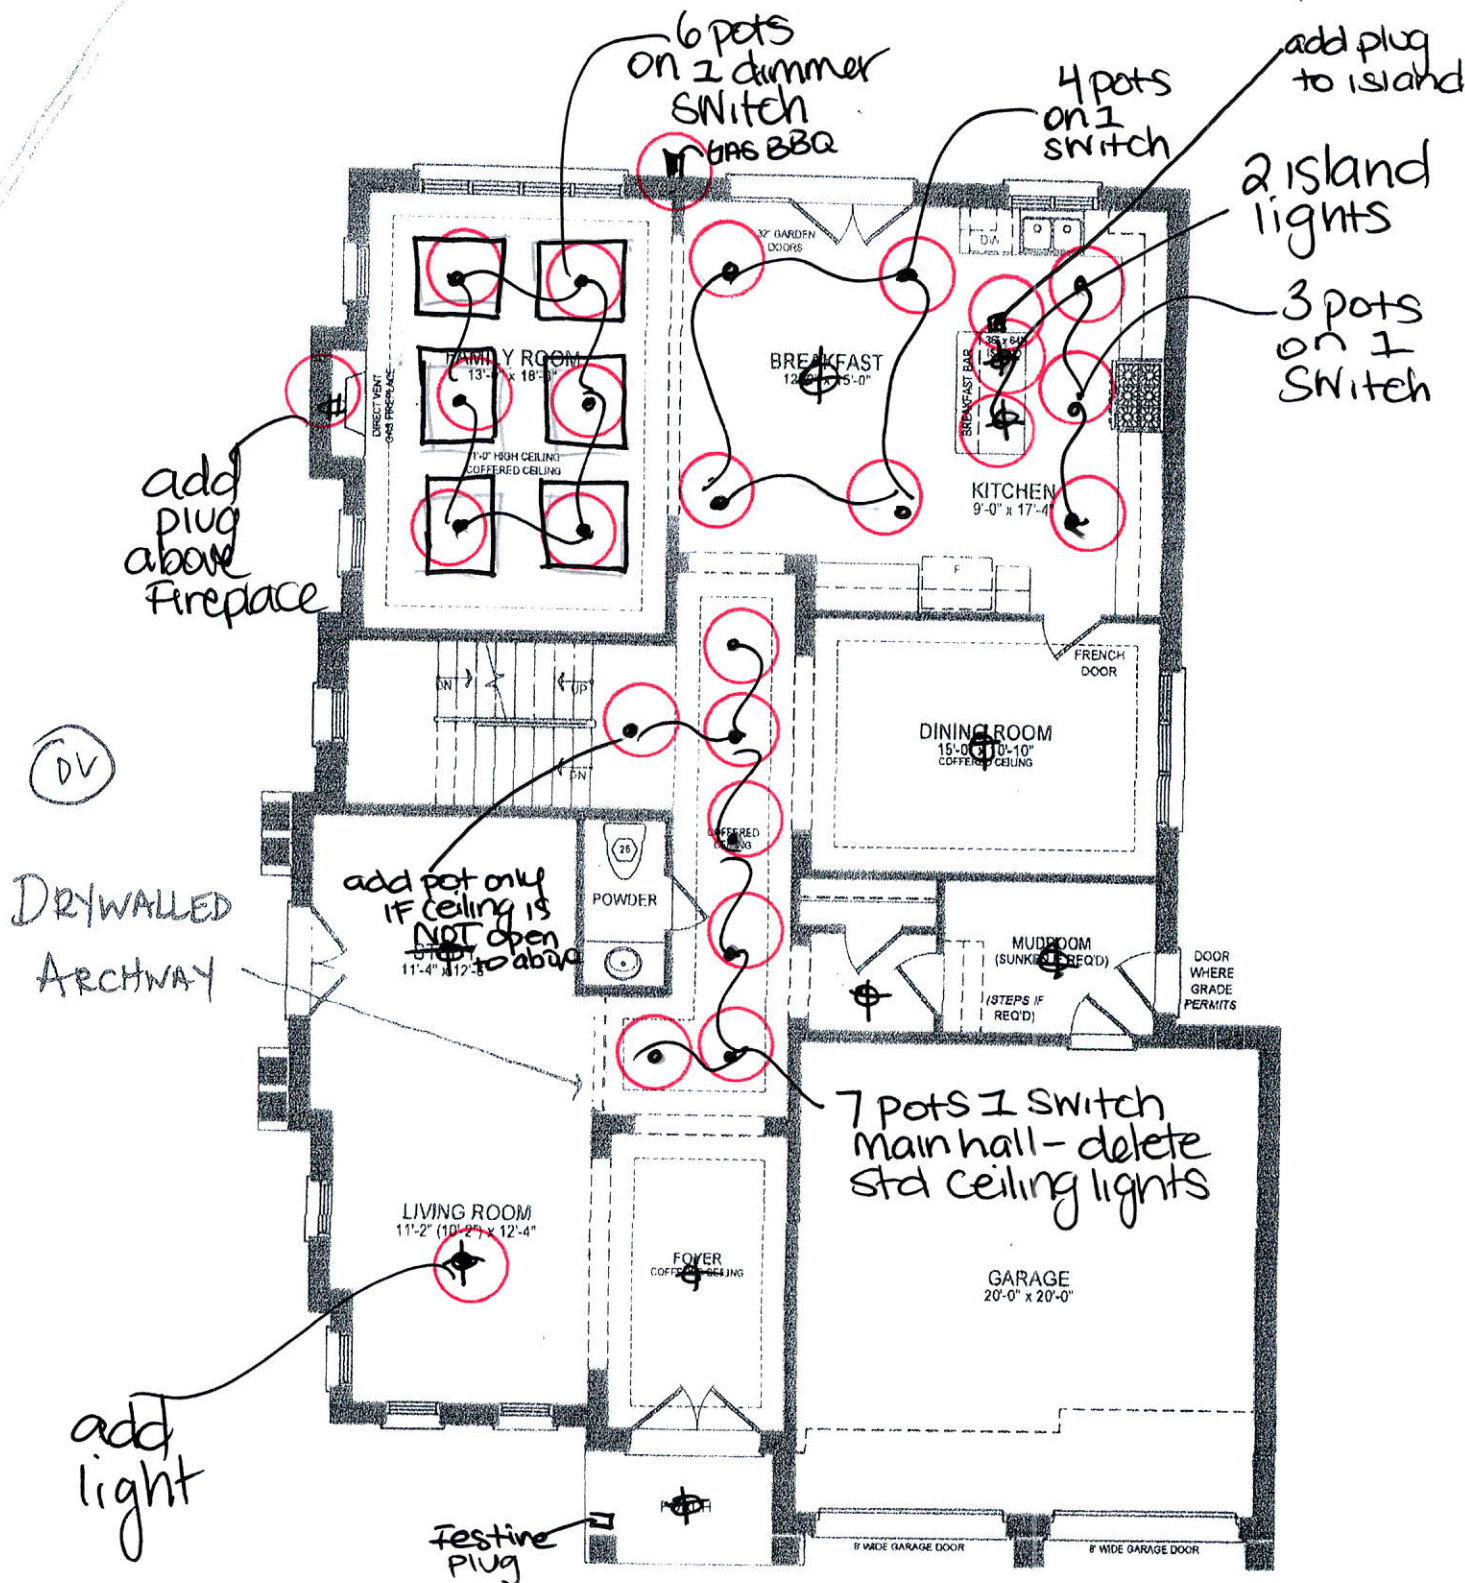


GEORGIAN 1 - ELEV. A
LOT 9 - PURCHASER CHANGES

DATED - MAY 13, 2019

Dancer

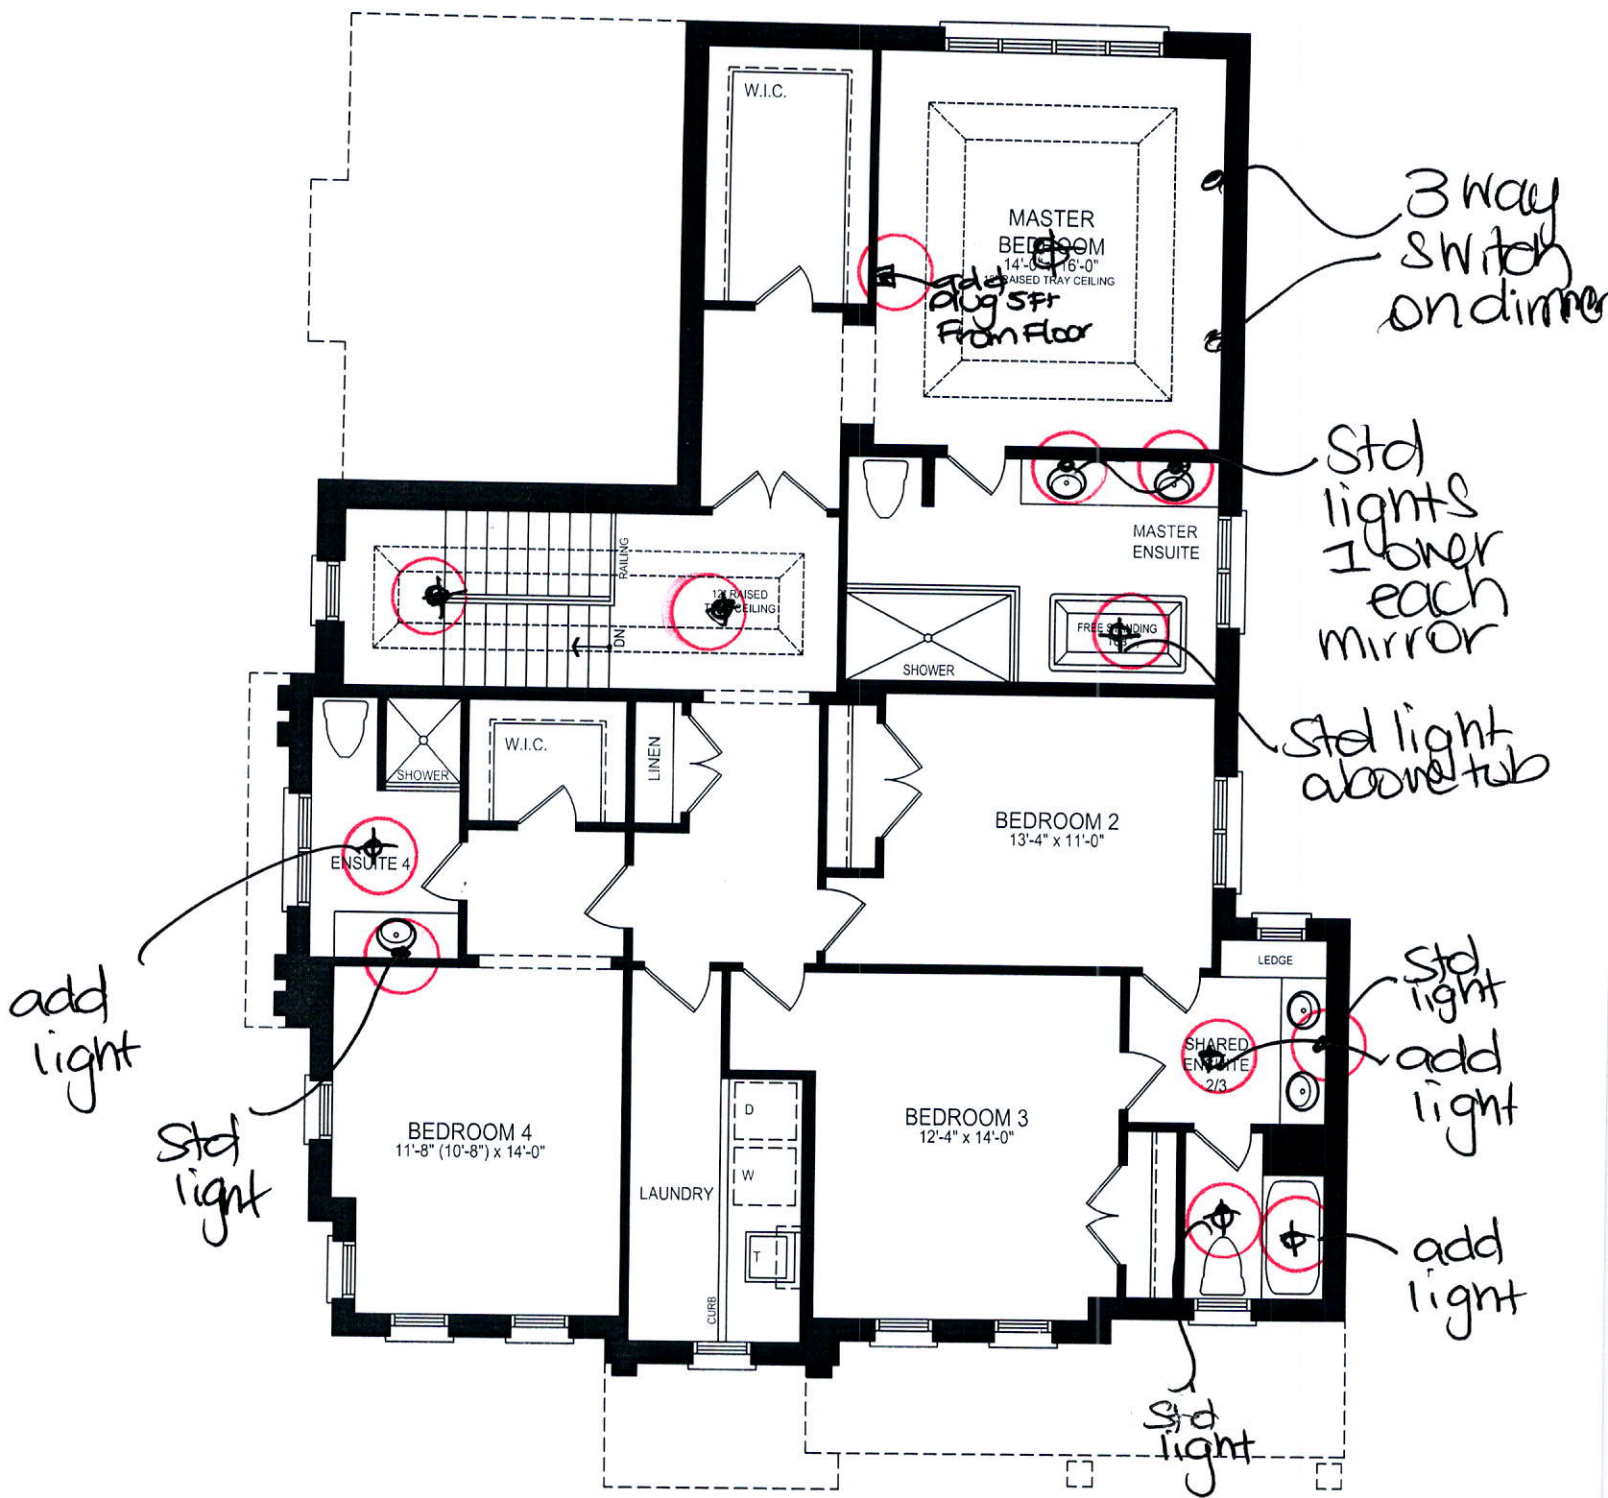

GEORGIAN 1 UPPER LEVEL EA
 REVISED 08.10.18

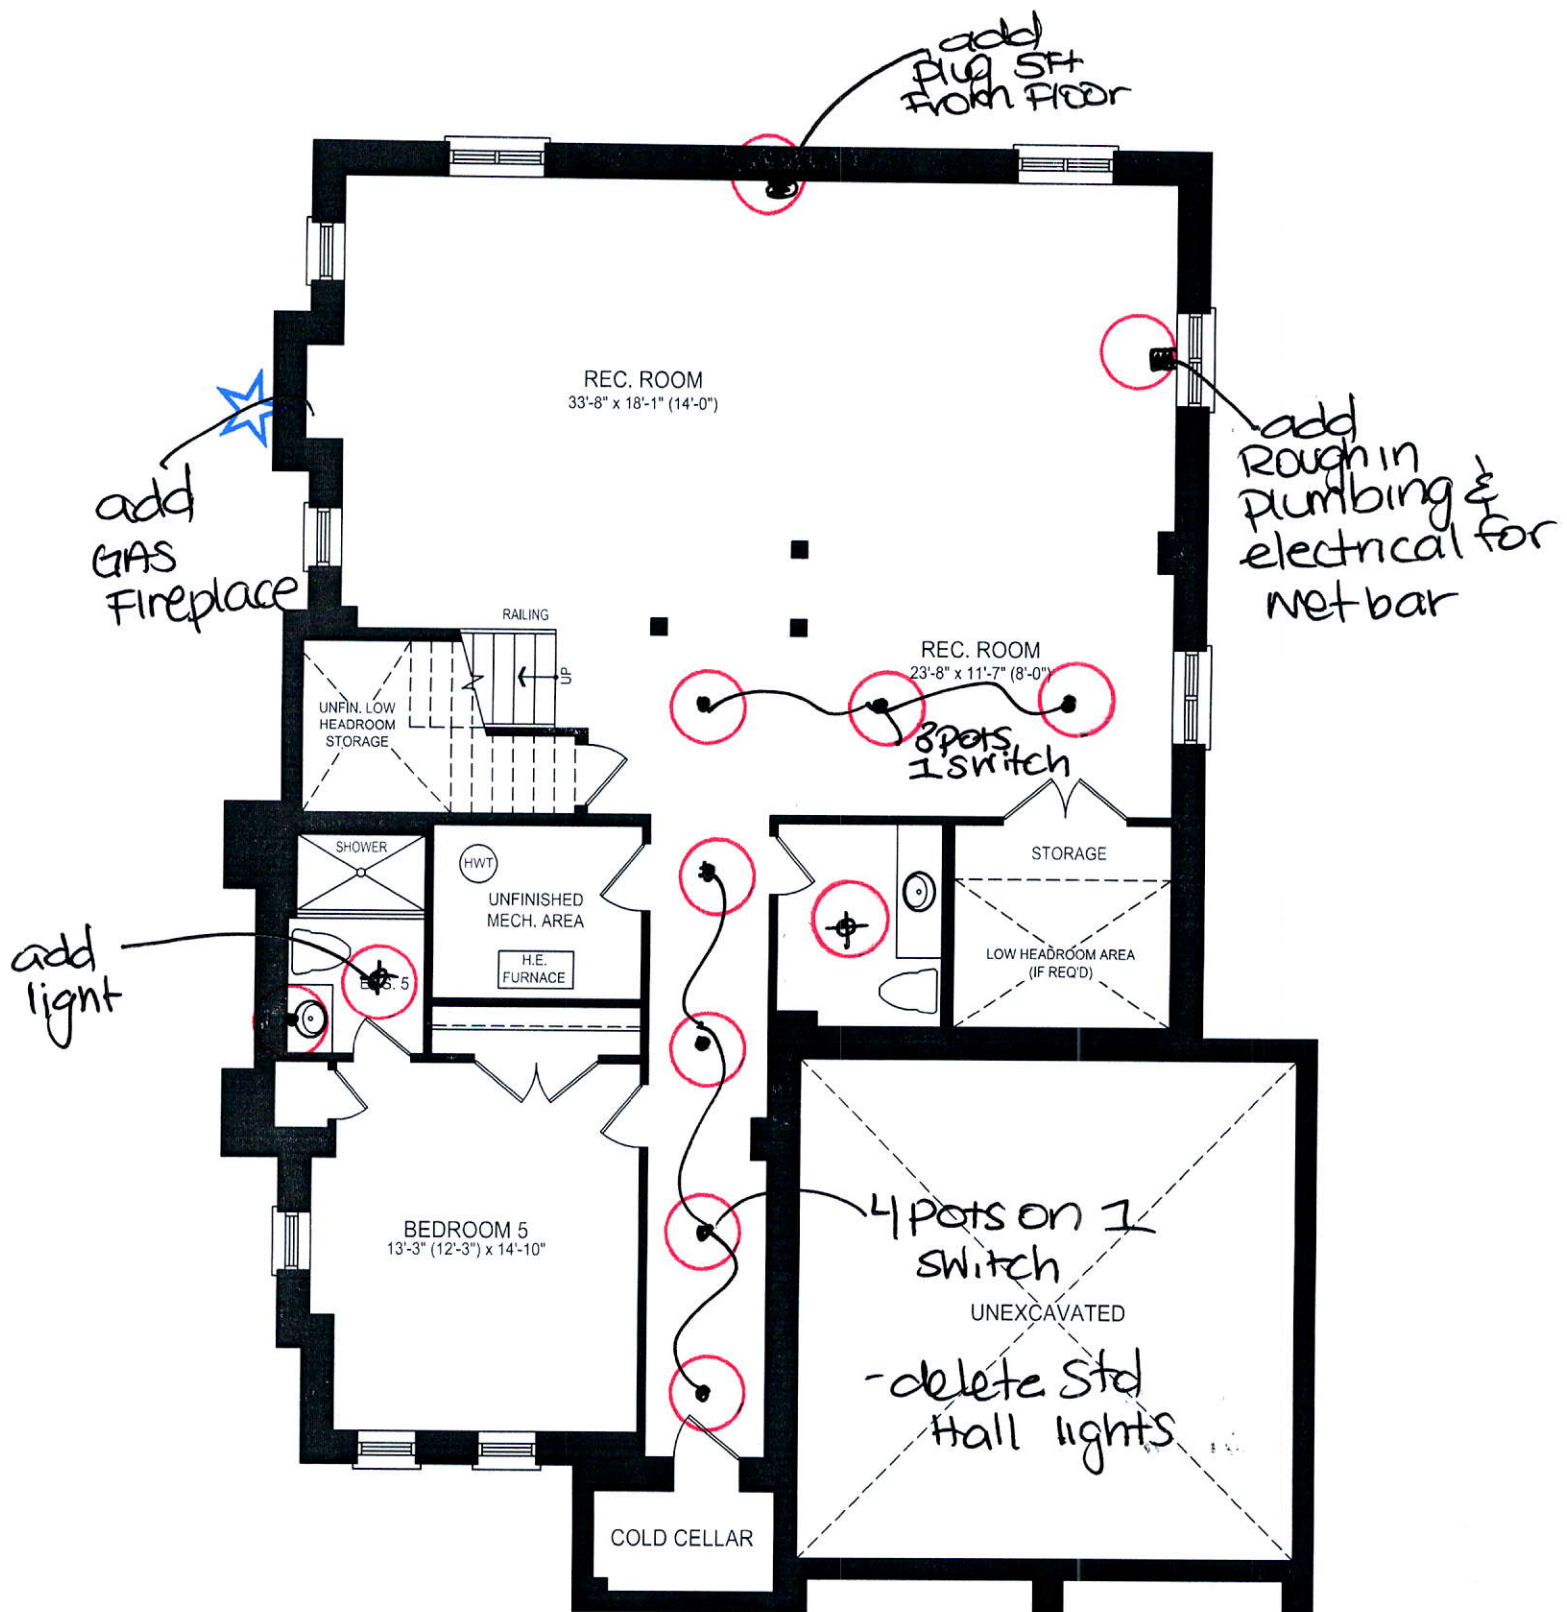

GEORGIAN 1 LOWER LEVEL EA
REVISED 08.10.18