

CONSTRUCTION SUMMARY

Sharon Village 2 - Secondo Vales Estates Inc.

RECEIVED JUL 1 1 2019

PURCHASERS: CHRISTOPHER REECE and NATASHA PRYSZLAK

TEL: RES.: 416-897-9065

LOT / PHASE 8 / 2	REG. PLAN # 65M-4626	HOUSE TYPE Pinebrook 2 Elev 2		
----------------------	-------------------------	----------------------------------	--	--

MIRRORS AND GLASS

1 - FRAMELESS GLASS SHOWER ENCLOSURE - MASTER ENSUITE - WITH CHROME KNOB 11Jul19 Note:	
---	--

PROMOTIONAL




1 - PARTIAL REDEMPTION OF PROMOTIONAL PACKAGE \$3,000 BALANCE FORWARD \$12,000 TO BE USED AT A LATER DATE. ORIGINAL PROMOTIONAL PACKAGE OF \$15,000 AS PER SCHEDULE PE. 11Jul19 Note:	
---	--

EXTRAS AS PER OFFER

The Vendor agrees that notwithstanding any other term or provision in this Agreement included in the Purchase Price and in addition to those items detailed in Schedule GP to the Agreement of Purchase and Sale, the Purchaser is entitled to a credit of Fi Worksheet Note:	
--	--

This Document is Extremely Time Sensitive - Printed 11 Jul 19 at 11:33

PINEBROOK 2 | 3,045 SQ.FT.

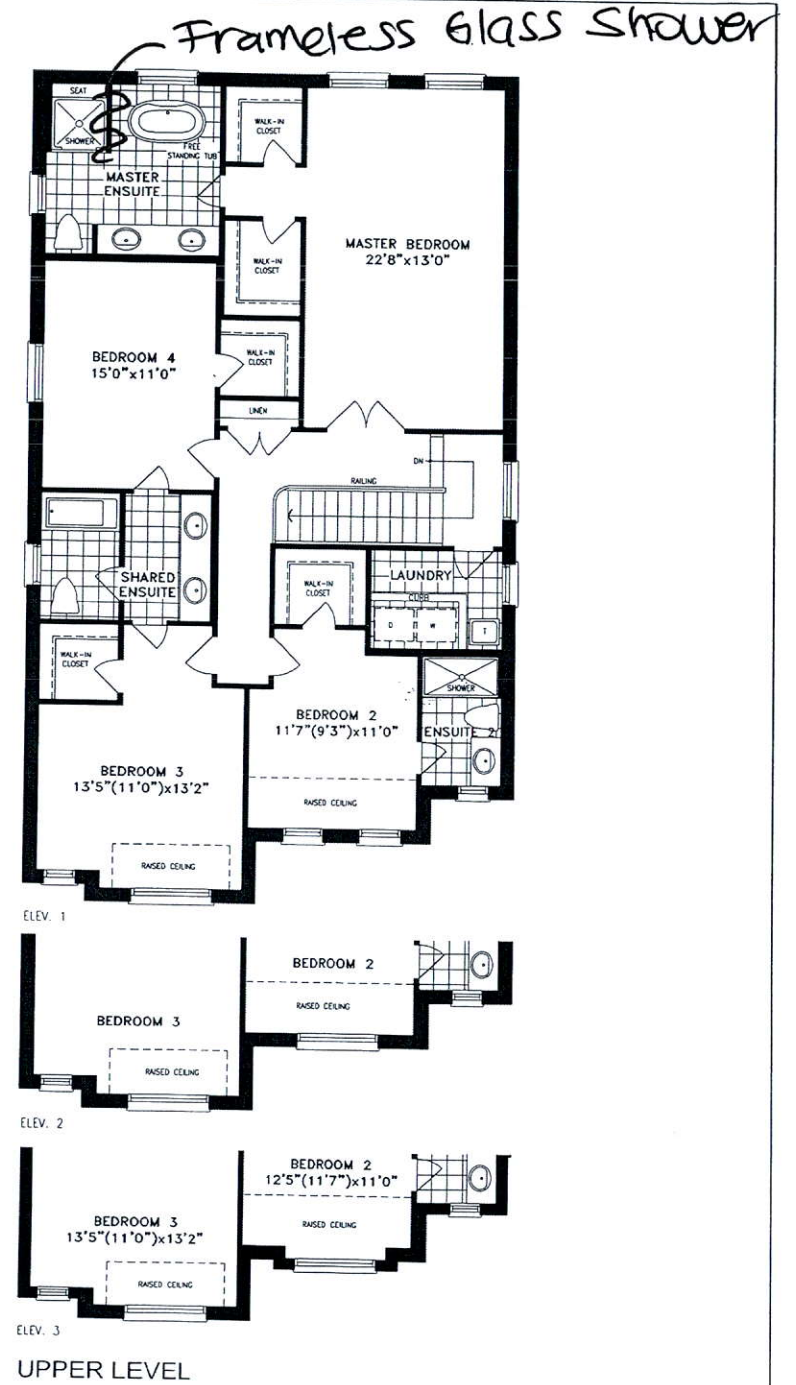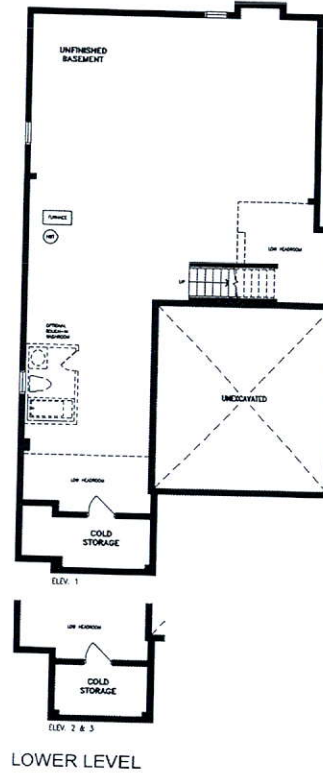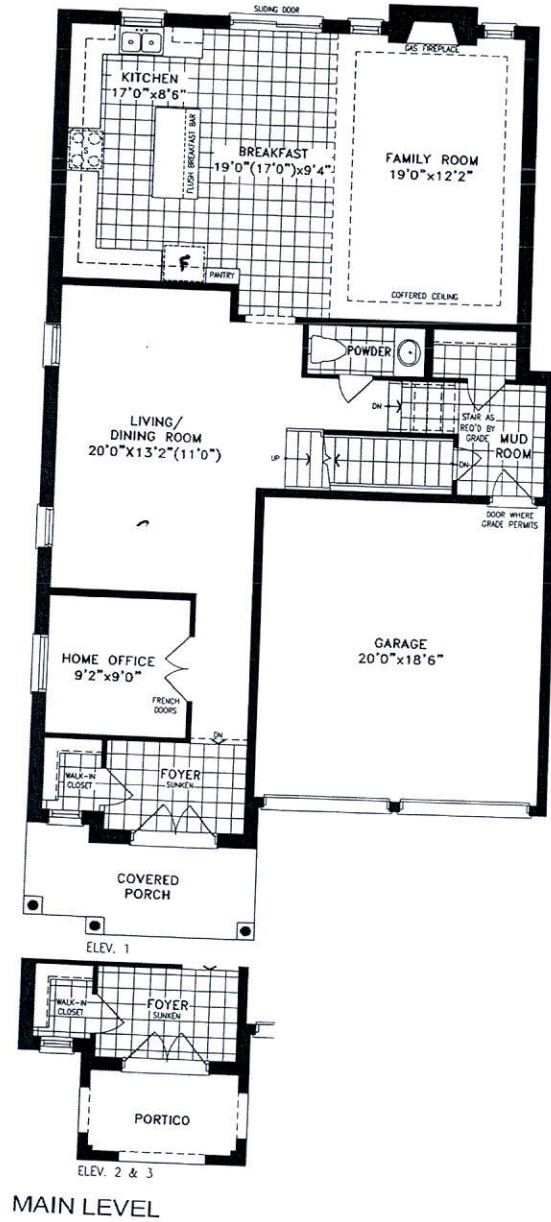

Orientation of home may be reversed and purchaser agrees to accept the same. Steps and porches may vary at any exterior entrance ways due to grading variance. Actual usable floor space may vary from the stated floor areas. All renderings are artist's concept. Dimensions, specifications and architectural detailing subject to modifications. Roofline and adjoining model types may vary due to siting. E. & O. E. May 2018