

CONSTRUCTION SUMMARY
Mayfield Village 2 (G) - Minnisale Homes Corp.

PURCHASER: SHAKIRA DANEWALIA TEL: RES.: 905-458-3344 BUS.: 647-625-7205

LOT / PHASE 38L / 2	REG. PLAN # 43M-2060	HOUSE TYPE Hemlock 4 Elev 1		
------------------------	-------------------------	--------------------------------	--	--

CABINETRY

1 - VANITY - ENSUITE BATHROOM - UPGRADE 3 26Sep19 Note:	
1 - VANITY - POWDER ROOM - UPGRADE 3 26Sep19 Note:	
1 - VANITY - MAIN BATHROOM - UPGRADE 3 26Sep19 Note:	
1 - CABINETRY - KITCHEN - LIGHT VALENCE 26Sep19 Note:	

CABINETRY ACCESSORIES

1 - KITCHEN CABINETRY UPPER - FULL DEPTH ABOVE FRIDGE - WITH GABLES - 600MM - PRICE IS EACH - STANDARD 26Sep19 Note:	
1 - KITCHEN CABINETRY UPPER - GLASS DOOR - GLK340 CORD GLASS - FINISHED INTERIOR - FITS TALL UPPER CABINETS ONLY - PRICE IS PER DOOR - STANDARD 26Sep19 Note:	
1 - KITCHEN CABINETRY UPPER - ANGLED CORNER CABINET - FITS TALL UPPER CABINETS - PER UNIT - STANDARD 26Sep19 Note:	
1 - KITCHEN CABINETRY BASE - PIE CUT CORNER CABINET - BASE CABINETRY - STANDARD 26Sep19 Note:	

CERAMIC TILE

1 - TILE - UPGRADE 1 FLOOR TILE - - SIDE ENTRANCE 26Sep19 Note:	
1 - TILE - UPGRADE 1 FLOOR TILE - - POWDER ROOM 26Sep19 Note:	
1 - TILE - UPGRADE 1 FLOOR TILE - - KITCHEN 26Sep19 Note:	
1 - TILE - UPGRADE 1 FLOOR TILE - - FOYER 26Sep19 Note:	

COUNTER TOP

1 - HARD SURFACE COUNTERTOP - ENSUITE BATHROOM VANITY WITH TECO SINK 26Sep19 Note:	
1 - HARD SURFACE COUNTERTOP - MAIN BATHROOM VANITY WITH TECO SINK 26Sep19 Note:	
1 - HARD SURFACE COUNTERTOP - POWER ROOM VANITY WITH TECO SINK 26Sep19 Note:	

ELECTRICAL

1 - LIGHT AND SWITCH - NO FIXTURE INCLUDED - LIVING ROOM 26Sep19 Note:	
---------------------------------------------------------------------------	--

HARDWOOD FLOORING

1 - LAMINATE - SECOND FLOOR COMPLETE 26Sep19 Note:	
-------------------------------------------------------	--

RECEIVED SEP 26 2019

CONSTRUCTION SUMMARY
Mayfield Village 2 (G) - Minnisale Homes Corp.

PURCHASER: SHAKIRA DANEWALIA TEL: RES.: 905-458-3344 BUS.: 647-625-7205

LOT / PHASE 38L / 2	REG. PLAN # 43M-2060	HOUSE TYPE Hemlock 4 Elev 1		
------------------------	-------------------------	--------------------------------	--	--

1 - LAMINATE -UPGRADE SERIES IN LIEU OF STANDARD LAMINATE 26Sep19 Note:	
----------------------------------------------------------------------------	--

PROMOTIONAL

1 - LESS BALANCE OF CREDIT FROM PURCHASER EXTRA SHEET IN OFFER 26Sep19 Note:	
---------------------------------------------------------------------------------	--

STAIRS AND RAILINGS

1 - V GROOVE HANDRAIL 26Sep19 Note:	
1 - STAINED HANDRAIL, TREADS, RISERS AND STRINGER EXCLUDING PICKETS (FOR IRON PICKETS) - STANDARD STAIRCASE - PRICE IS PER SET 26Sep19 Note:	
1 - EUROLINE 1 BLACK IRON PICKETS 26Sep19 Note:	

EXTRAS AS PER OFFER

(0) The Vendor agrees that notwithstanding any other term or provision in this Agreement included in the Purchase Price and in addition to those items detailed in Schedule GP to the Agreement of Purchase and Sale, the Purchaser is entitled to a credit of Worksheet Note:	
Five (5) White Appliances as per PE Appliances Worksheet Note:	
The Purchaser acknowledges that the Purchase Price is inclusive of all credits and promotional packages available at the time of purchase. Worksheet Note:	

This Document is Extremely Time Sensitive - Printed 26 Sep 19 at 15:23

Purchaser:SHAKIRA DANEWALIA

Property: 38L

Telephone Res. / Bus: (905) 458-3344 / (647) 625-7205

Project: Minnisale Homes Corp.

Decor Advisor: Natalie Mancuso

Model and Elevation: Hemlock 4 Elev 1

Lock Date: 26-Sep-19

26-Sep-19

Plan #: 43M-2060

Layout Changes: ☐ Yes ☒ No

Sketch Attached: ☒ Yes ☐ No

Exterior Colour Scheme:

1. Cabinetry

	Style and Colour	Hardware
Kitchen / Breakfast	CONTINENTAL 352 WILD MUSHROOM	446SA
Laundry Room	ELISSE	Standard
Powder Room	LEGACY L662XZ4	431SA
Master Ensuite Bathroom	LEGACY L662XZ4	431SA
Main Bathroom	LEGACY L662XZ4	431SA

Appliances:

Built In Appliances ☐ Yes ☒ No

Slide In Stove ☐ Yes ☒ No

Dishwasher Cabinet

☐ Closed ☒ Open

41" Upper Cabinets ☒ Yes ☐ No

Please NOTE: Standard Cabinet Height is 30"

Stove Opening

NOTE: If not specified, opening will be set to builder's standard opening of approximately 30" width

Fridge Opening

NOTE: If not specified, opening will be set to builder's standard opening of approximately 37" width x 74" height

** Refer to Construction Summary

2. Counters

	Counter	Edge
Kitchen / Breakfast	LAMINATE-WHITE CARRARA 4924-38	
Laundry Room	N/A	
Powder Room	QUARTZITE- MATARAZZO	#300
Master Ensuite Bathroom	QUARTZITE- MATARAZZO	#300
Main Bathroom	QUARTZ- VIRGINIA	#300

** Refer to Construction Summary

Initial: 

Purchaser:SHAKIRA DANEWALIA

Telephone Res. / Bus: (905) 458-3344 / (647) 625-7205

Decor Advisor: Natalie Mancuso

Lock Date: 26-Sep-19

Property: 38L

Project: Minnisale Homes Corp.

Model and Elevation: Hemlock 4 Elev 1

Plan #: 43M-2060

3. Ceramic Flooring		At a 45 Threshold-If App.	
Entrance Vestibule	TILE- ANDE SABBIA 12X24	<input type="checkbox"/>	Metal Strip Where Applic.
Main Hall	LAMINATE	<input type="checkbox"/>	
Kitchen / Breakfast	TILE- ANDE SABBIA 12X24	<input type="checkbox"/>	
Laundry Room	TILE- CEMENTI WHITE 12X12	<input type="checkbox"/>	
Powder Room	TILE- ANDE SABBIA 12X24	<input type="checkbox"/>	
Master Ensuite Bathroom	TILE- CEMENTI WHITE 12X12	<input type="checkbox"/>	
Main Bathroom	TILE- CEMENTI WHITE 12X12	<input type="checkbox"/>	
SIDE HALL/LANDING	TILE- ANDE SABBIA 12X24	<input type="checkbox"/>	
		<input type="checkbox"/>	
		<input type="checkbox"/>	
		<input type="checkbox"/>	

** Refer to Construction Summary

4. Ceramic Wall Tile		Describe	
Master Ensuite Bathroom	Selection		
Tub Deck Wall	TILE-CARRARA MATTE (MH125) 8X10		
Tub Deck			
Tub Deck Skirt			
Shower Stall	TILE-CARRARA MATTE (MH125) 8X10		
Bathtub Enclosure Walls			
Main Bathroom	TILE-CARRARA MATTE (MH125) 8X10		
SIDE HALL/LANDING			
Kitchen Backsplash			

** Refer to Construction Summary - STANDARD GROUT THROUGHOUT UNLESS SPECIFIED

5. Plumbing Fixtures

All Bathrooms

White

Whirlpool

Yes

No

Dishwasher Rough-In

Yes

No

Waterline for Fridge

Yes

No

** Refer to Construction Summary

6. Trim Carpentry	
Interior Doors	CARRARA-SMOOTH
Interior Trim	2 3/4" CASING WITH 4 1/4" BASEBOARD - COLONIAL
Door Handles	As Per Construction Specifications
Exterior Front Door Handle	As Per Construction Specifications

** Refer to Construction Summary

Initial: S.D

Purchaser:

SHAKIRA DANEWALIA

Telephone Res. / Bus:

(905) 458-3344 / (647) 625-7205

Decor Advisor:

Natalie Mancuso

Lock Date:

26-Sep-19

Property: 38L

Project: Minnisale Homes Corp.

Model and Elevation: Hemlock 4 Elev 1

Plan #: 43M-2060

7. Other Flooring

Main Hall

LAMINATE- TORLYS- FJORD- HALVAR OAK- TL-NEUM03

Living Room

LAMINATE- TORLYS- FJORD- HALVAR OAK- TL-NEUM03

Dining Room

LAMINATE- TORLYS- FJORD- HALVAR OAK- TL-NEUM03

Family Room

LAMINATE- TORLYS- FJORD- HALVAR OAK- TL-NEUM03

Den / Library / Study

Basement Landing(If Applies)

Lower Landing (If Applies)

TILE- ANDE SABBIA 12X24

Upper Landing

LAMINATE- TORLYS- FJORD- HALVAR OAK- TL-NEUM03

Upper Hall

LAMINATE- TORLYS- FJORD- HALVAR OAK- TL-NEUM03

Master Bedroom

LAMINATE- TORLYS- FJORD- HALVAR OAK- TL-NEUM03

Bedroom #2

LAMINATE- TORLYS- FJORD- HALVAR OAK- TL-NEUM03

Bedroom #3

LAMINATE- TORLYS- FJORD- HALVAR OAK- TL-NEUM03

Bedroom #4

LAMINATE- TORLYS- FJORD- HALVAR OAK- TL-NEUM03

Bedroom #5

Underpad

Type

Area

** Refer to Construction Summary

8. Railings and Pickets

Railing Type

V-GROOVE

Picket Type

EUROLINE 1

Stringer / Riser

AS PER CONSTRUCTION SPECIFICATIO

Treads

AS PER CONSTRUCTION SPECIFICATIO

Colour

MIRAGE- HUDSON

Colour

BLACK

Colour

MIRAGE- HUDSON

Colour

MIRAGE- HUDSON

Red Oak Stairs with Semi Gloss Finish

☒ Yes

☐ No

** Refer to Construction Summary

9. Wall Paint Flat Finish

Main & Upper Hall

43 BIRCH WHITE

Living Room

43 BIRCH WHITE

Dining Room

43 BIRCH WHITE

Kitchen / Breakfast

43 BIRCH WHITE

Family Room

43 BIRCH WHITE

Powder Room

43 BIRCH WHITE

Laundry Room

43 BIRCH WHITE

Den/Library

Trim Paint-Semi Gloss

43 BIRCH WHITE

Master Bedroom

43 BIRCH WHITE

Bedroom #2

43 BIRCH WHITE

Bedroom #3

43 BIRCH WHITE

Bedroom #4

43 BIRCH WHITE

Bedroom #5

Master Ensuite

43 BIRCH WHITE

Main Bathroom

43 BIRCH WHITE

Smooth Ceilings First Floor

☐ Yes

☒ No

** Refer to Construction Summary

Initial: S.D

Page 3 of 4

Printed 9/26/2019 15:23:38

Purchaser: SHAKIRA DANEWALIA
Telephone Res. / Bus: (905) 458-3344 / (647) 625-7205
Decor Advisor: Natalie Mancuso
Lock Date: 26-Sep-19

Property: 38L

Project: Minnisale Homes Corp.

Model and Elevation: Hemlock 4 Elev 1

Plan #: 43M-2060

10. Plaster Mouldings and Medallions

Entrance Vestibule

Main Hall

Living Room

Dining Room

Family Room

Kitchen/Breakfast

Den/Library

Lower Landing

** Refer to Construction Summary

11. Fireplace

Living Room

Purchased

As Per Plan

N/A

Family Room

Purchased

As Per Plan

N/A

Other Room - Specify

Purchased

As Per Plan

N/A

Fireplace Type

Mantle Type

Colour / Stain

Surround

Hearth

** Refer to Construction Summary

12. Heating and Air Conditioning

Air Conditioning

NO

Gas Provisions Dryer

NO

Gas Provisions Stove

NO

Gas Provisions Barbecue

NO

Comment

** Refer to Construction Summary

13. Electrical

Plugs and Switches

☒ White

DECOR

Hood Fan

STANDARD WHITE

Appliances

Built in Cooktop

☐ Yes ☒ No

Built in Oven

☐ Yes ☒ NoAbove Kitchen Cabinet Light ☐ Yes ☒ NoBelow Kitchen Cabinet Light ☐ Yes ☒ No

Gas Stove

☐ Yes ☒ No

Microwave

☐ Yes ☒ No

Dishwasher Rough-in

Yes

** Refer to Construction Summary


14. General Comments

** Refer to Construction Summary

Disclaimers and Notes

- Colours of all materials are as close as possible to builder's selection, but not necessarily identical due to variances in manufacturing.
- Any extras listed above are null and void unless accompanied by a separate invoice/amendment. Said invoice must be paid in full.
- The Purchaser agrees that this colour selection is final and that no changes will be permitted, unless required by the Vendor.
- The Purchaser acknowledges reading and accepting document which contains other miscellaneous disclaimers.

Signature: Shakira DanewaliaDate: 26/19/2019

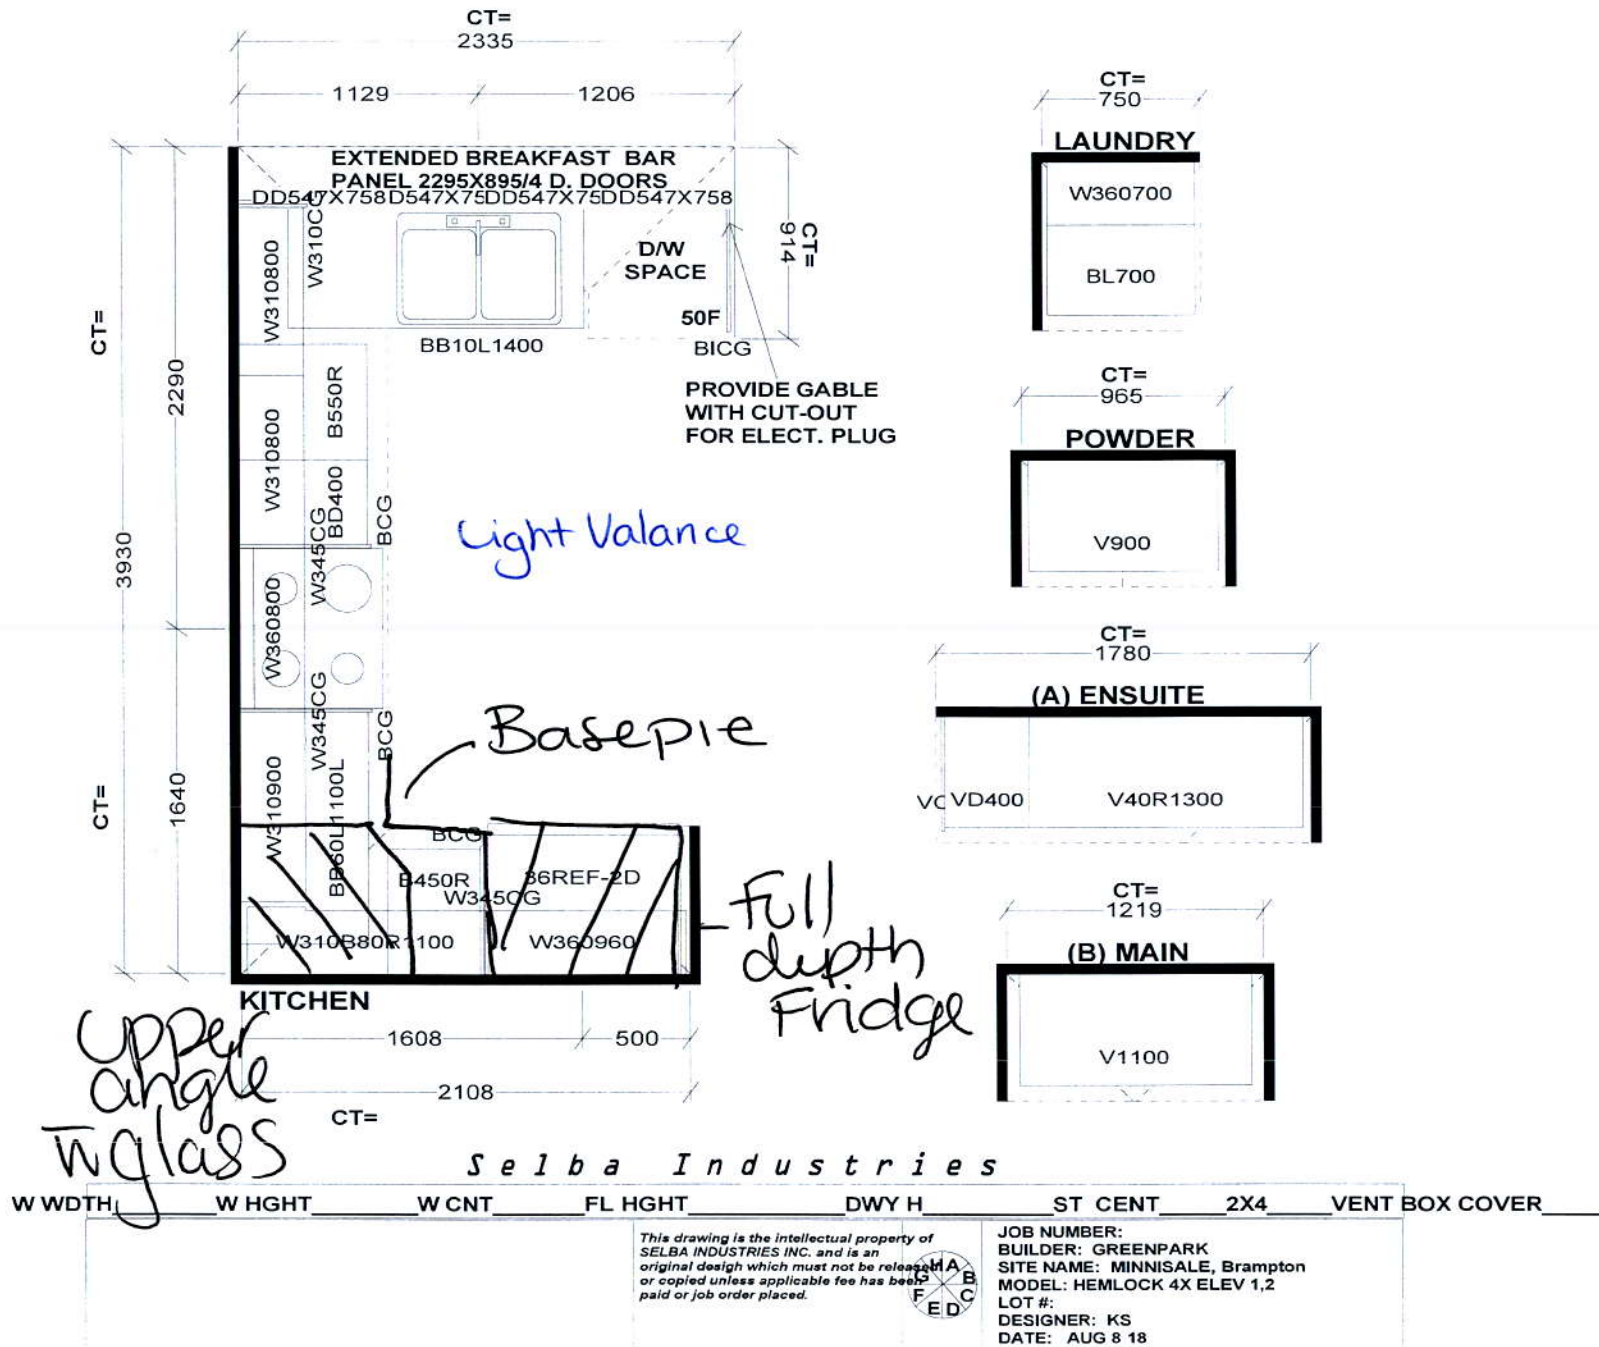

ELEV. 1

BREAKFAST
11'6" x 8'7"

KITCHEN
12'0" x 6'11"

DINING ROOM
12'10" x 11'0"

LIVING ROOM
10'11" x 8'4"

FAMILY ROOM
13'11" x 13'1"

GARAGE
19'11" x 11'3" (10'3")

FOYER

COVERED PORCH

POWDER

BATH

BUTTER-BREAKFAST BAR

SLIDING DOOR

UP

DN

HALF WALL

ALF WALL

ALTERNATE
10'0" x 11'0" (10'0" x 11'0")

ALTERNATE
10'0" x 11'0" (10'0" x 11'0")

COVERED PORCH

LIVING ROOM

GARAGE

MAIN LEVEL

ELEV. 2

FUTURE RECREATION ROOM (UNDESIGNED)

PIPE ROUTING IN WALL/CEILING

WATER SHUT-OFF

DOOR

LOW HEADROOM

UNEXCAVATED

LOWER LEVEL

COLD STORAGE

ELEV. 1

ELEV. 2

MASTER BEDROOM
14'11" x 11'11"

BEDROOM 2
10'11" x 8'8"

BEDROOM 3
9'0" x 8'4"

BEDROOM 4
8'11" x 8'3"

BATH

LAUNDRY

WALK-IN CLOSET

ENCL. 1

ENCL. 2

ENCL. 3

ENCL. 236

UPPER LEVEL

Orientation of home may be reversed and purchaser agrees to accept the same. Steps and porches may vary at any exterior entrance ways due to grading variance. Actual usable floor space may vary from the stated floor areas. All renderings are artist's concept. Dimensions, specifications and architectural detailing subject to modifications. Roofline and adjoining model types may vary due to siting. E. & O. E. June 2018