

# SURVEYOR'S REAL PROPERTY REPORT

## PART 1

PLAN OF LOTS 1, 2, 3, 4 AND 5  
PLAN 43M-2060  
CITY OF BRAMPTON  
REGIONAL MUNICIPALITY OF PEEL

SCALE 1:300

10m 5m 0 10m 20metres

R-PE SURVEYING LTD., O.L.S.  
METRIC

DISTANCES SHOWN ON THIS PLAN ARE IN METRES AND CAN  
BE CONVERTED TO FEET BY DIVIDING BY 0.3048.

## PART 2 (SURVEY REPORT)

REGISTERED EASEMENTS AND/OR RIGHT-OF-WAYS: LOTS 1 TO 5 ARE  
SUBJECT TO AN EASEMENT AS SET OUT IN PR1279464.  
THIS PLAN DOES NOT CERTIFY COMPLIANCE WITH ZONING BY-LAWS

## SURVEYOR'S CERTIFICATE


I CERTIFY THAT:

1. THIS SURVEY AND PLAN ARE CORRECT AND IN ACCORDANCE  
WITH THE SURVEYS ACT, THE SURVEYORS ACT AND THE LAND  
TITLES ACT AND THE REGULATIONS MADE UNDER THEM.
2. THE SURVEY WAS COMPLETED ON THE 6<sup>th</sup> DAY OF JUNE, 2019.

DATE: July 15, 2019.

T. SINGH  
ONTARIO LAND SURVEYOR

MAYFIELD ROAD (REGIONAL ROAD No. 14)  
PART OF LOT 17, CONCESSION 4,  
EAST OF HURONTARIO STREET

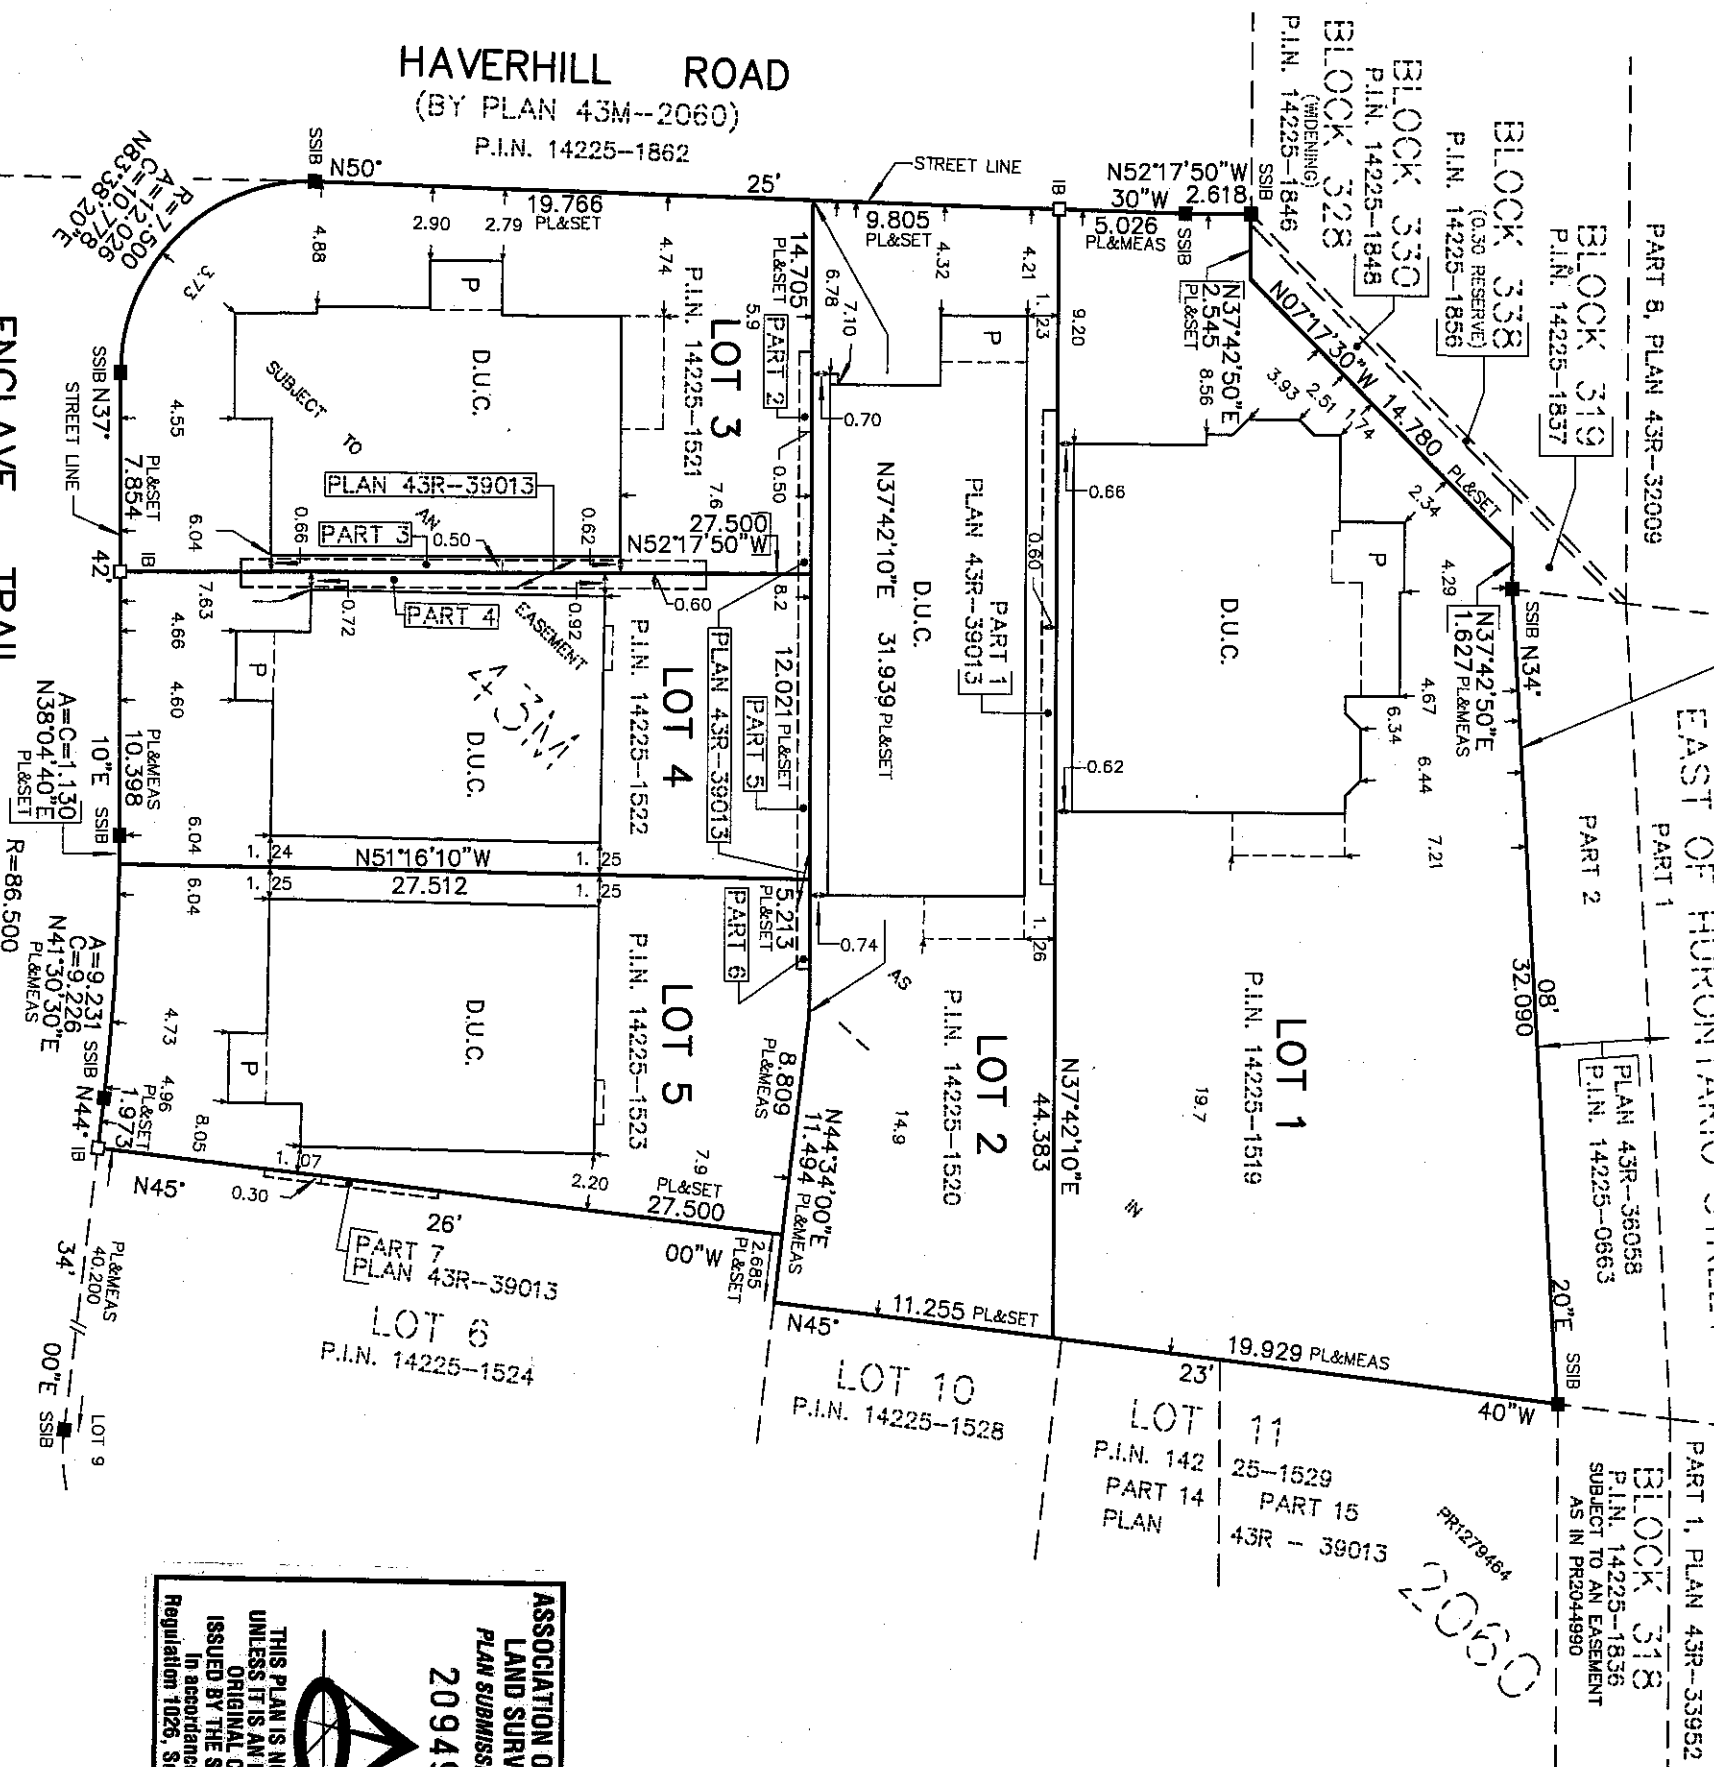

## NOTES

- DENOTES MONUMENT SET
- DENOTES MONUMENT FOUND
- IB DENOTES IRON BAR
- SSIB DENOTES SHORT STANDARD IRON BAR
- D.U.C. DENOTES DWELLING UNDER CONSTRUCTION
- P.L.N. DENOTES PROPERTY IDENTIFIER NUMBER
- P DENOTES PORCH
- PL DENOTES PLAN 43M-2060

ENCLAVE TRAIL  
(BY PLAN 43M-2060)  
P.L.N. 14225-1864

ALL FOUND MONUMENTS BY J. D. BARNES  
SURVEYING, O.L.S.  
ALL TIES TO CONCRETE FOUNDATIONS.  
BEARINGS ARE GRID AND ARE REFERRED TO THE  
NORTHEASTERLY LIMIT OF HAVERHILL ROAD AS  
SHOWN ON PLAN 43M-2060 HAVING A BEARING  
OF N50°25'30\"W.



R-PE SURVEYING LTD.

ONTARIO LAND SURVEYORS

643 Christie Road, Suite 7

Woodbridge, Ontario L4L 8A3

Tel. (416) 635-5000 Fax (416) 635-5001

Tel. (905) 264-0881 Fax (905) 264-2099

Website: www.r-pe.ca


DRAWN: V.H.

JOB No. 19-060

CHECKED: G.Y./T.S.

CAD FILE No. 2060(19-060)-1

ASSOCIATION OF ONTARIO  
LAND SURVEYORS  
PLAN SUBMISSION FORM  
2094956

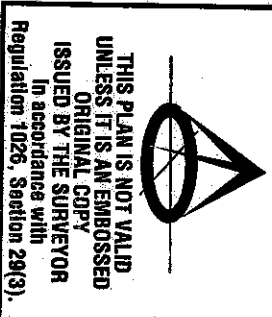

THIS REPORT WAS PREPARED FOR  
GREENPARK HOMES  
AND THE UNDERSIGNED ACCEPTS NO  
RESPONSIBILITY FOR USE BY OTHER PARTIES.

© R-PE SURVEYING LTD., O.L.S. 2019.

\*19-060\* \*43M-2060 L1-5\*