

SURVEYOR'S REAL PROPERTY REPORT

PART 1

PLAN OF LOTS 13, 14 AND 15
PLAN 43M-2060
CITY OF BRAMPTON
REGIONAL MUNICIPALITY OF PEE


SCALE 1:300

10m 5m 0 10m 20metres

R-PE SURVEYING LTD., O.L.S.
METRIC

DISTANCES SHOWN ON THIS PLAN ARE IN METRES AND CAN
BE CONVERTED TO FEET BY DIVIDING BY 0.3048.

ASSOCIATION OF ONTARIO
LAND SURVEYORS
PLAN SUBMISSION FORM
2094958

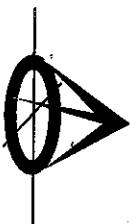

THIS PLAN IS NOT VALID
UNLESS IT IS AN EMBOSSED
ORIGINAL COPY
ISSUED BY THE SURVEYOR
In accordance with
Regulation 1026, Section 29(3).

PART 2 (SURVEY REPORT)

REGISTERED EASEMENTS AND/OR RIGHT-OF-WAYS: LOTS 13 TO 15 ARE
SUBJECT TO AN EASEMENT AS SET OUT IN PR1279464.
THIS PLAN DOES NOT CERTIFY COMPLIANCE WITH ZONING BY-LAWS


SURVEYOR'S CERTIFICATE

I CERTIFY THAT:

1. THIS SURVEY AND PLAN ARE CORRECT AND IN ACCORDANCE
WITH THE SURVEYS ACT, THE SURVEYORS ACT AND THE LAND
TITLES ACT AND THE REGULATIONS MADE UNDER THEM.
2. THE SURVEY WAS COMPLETED ON THE 6th DAY OF MAY 2019.

DATE: July 15, 2019.

T. SINGH
ONTARIO LAND SURVEYOR

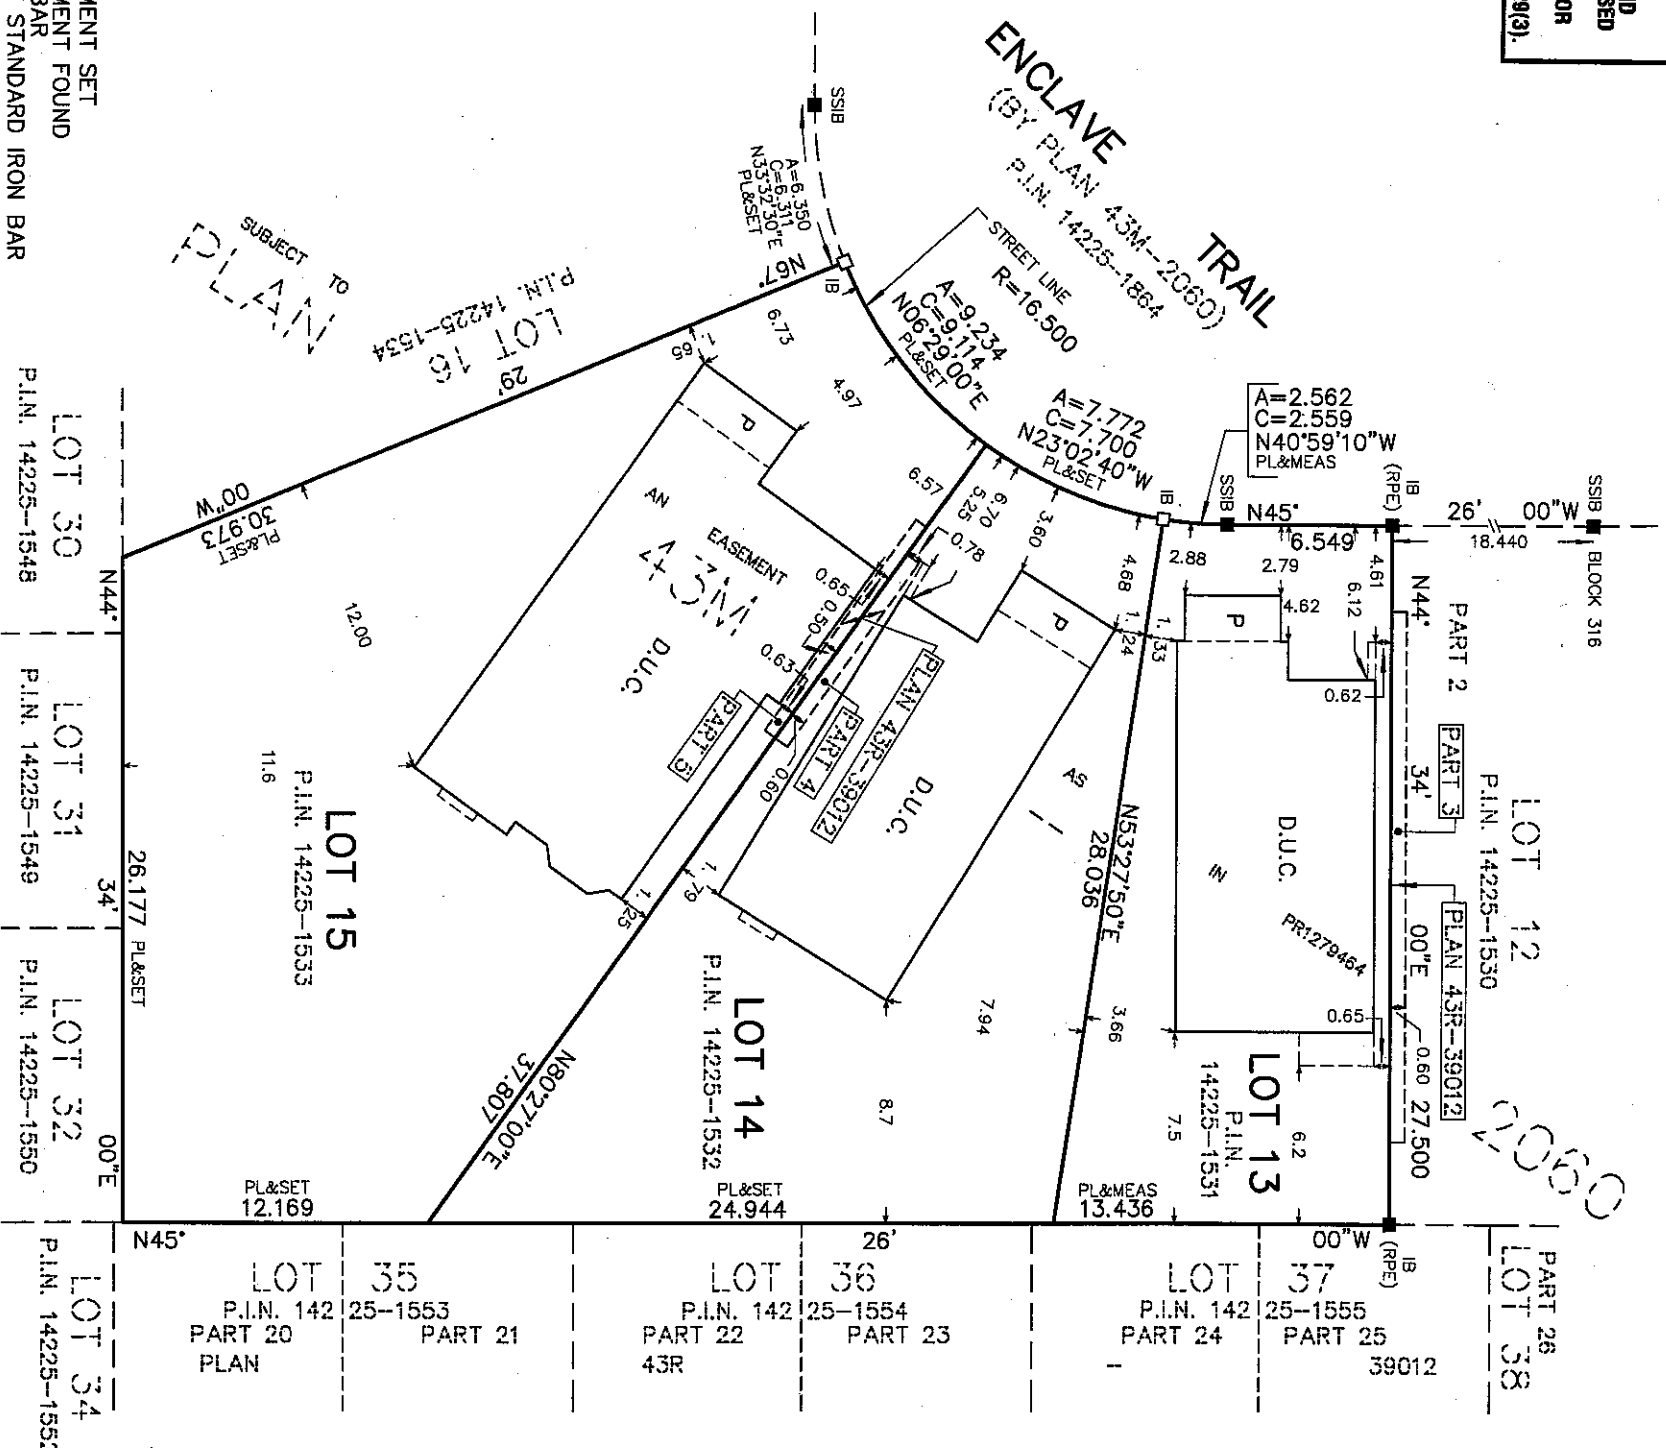

NOTES

- DENOTES MONUMENT SET
- DENOTES MONUMENT FOUND
- IB DENOTES IRON BAR
- SSB DENOTES SHORT STANDARD IRON BAR
- D.U.C. DENOTES DWELLING UNDER CONSTRUCTION
- P.L.N. DENOTES PROPERTY IDENTIFIER NUMBER
- PL DENOTES PORCH
- PL DENOTES PLAN 43M-2060
- (RPE) DENOTES R-PE SURVEYING LTD., O.L.S.

ALL FOUND MONUMENTS BY J. D. BARNES
SURVEYING, O.L.S. UNLESS NOTED OTHERWISE.

ALL TIES TO CONCRETE FOUNDATIONS.

BEARINGS ARE GRID AND ARE REFERRED TO THE
NORTHEASTERLY LIMIT OF ENCLAVE TRAIL AS
SHOWN ON PLAN 43M-2060 HAVING A BEARING
OF N45°26'00\"W.

THIS REPORT WAS PREPARED FOR
GREENPARK HOMES
AND THE UNDERSIGNED ACCEPTS NO
RESPONSIBILITY FOR USE BY OTHER PARTIES.

©R-PE SURVEYING LTD., O.L.S. 2019.



R-PE SURVEYING LTD.
ONTARIO LAND SURVEYORS
643 Christie Road, Suite 7
Woodbridge, Ontario L4L 8A3
Tel.(416)635-5000 Fax (416)635-5001
Tel.(905)264-0881 Fax (905)264-2099
Website: www.r-pe.ca
DRAWN: V.H.
JOB No. 19-060

CHECKED: G.Y./T.S.
CAD FILE No.2060(19-060)-13

19-060 *43M-2060 L13-15*