

CONSTRUCTION SUMMARY				
Lotus Pointe 2 (G) - Lamberts Lane Home Corp.				
PURCHASERS: Adegoke Joseph ADERIYE and Folasade O ADERIYE				TEL:
LOT / PHASE	REG. PLAN #	HOUSE TYPE		
25 / 2	Per Sched X	Preston Three Elev 2 5 Bedroom		

CONSTRUCTION

1 - ADD BASEMENT WALK-UP	
14May19 Note:	
PUSH FIREPLACE INTO ROOM TO ACCOMMODATE DOOR IN BASEMENT-	Sketch Attached

PROMOTIONAL

1 - LESS CREDIT FROM PURCHASER EXTRA SHEET IN OFFER	
14May19 Note:	

EXTRAS AS PER OFFER

(7,5) The Vendor agrees that notwithstanding any other term or provision in this Agreement included in the Purchase Price and in addition to those items detailed in Schedule GP to the Agreement of Purchase and Sale, the Purchaser is entitled to a credit	
Worksheet Note:	
The Purchaser acknowledges that the Purchase Price is inclusive of all credits and promotional packages available at the time of purchase.	
Worksheet Note:	


This Document is Extremely Time Sensitive - Printed 28 May 19 at 9:32

LOT 25 LAMBERTS LANE PHASE 2

PRESTON 3 ELEVATION 2

REVISIONS:

1. ADD WALK-UP STAIR. PUSH FIREPLACE INTO ROOM TO ACCOMMODATE DOOR IN BASEMENT.
2. RELOCATE BASEMENT WINDOW DUE TO DOOR.

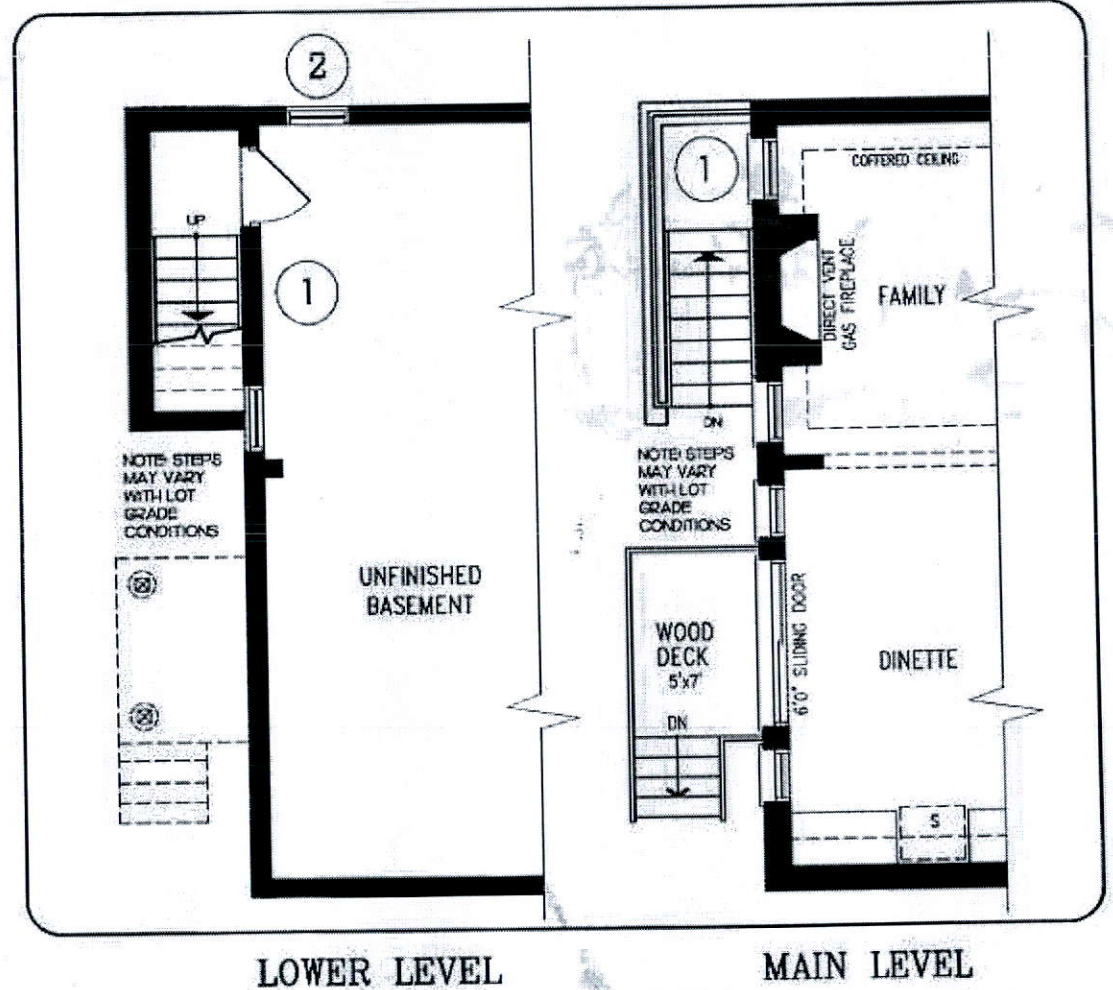

DISCLAIMERS: SKETCH NOT TO SCALE. DIMENSIONS, SPECIFICATIONS AND ARCHITECTURAL DETAILS SUBJECT TO MODIFICATION BY THE VENDOR. SKETCH IS ONLY FOR THE PURPOSE OF ILLUSTRATING REVISIONS REQUESTED BY THE PURCHASER AND ALL REVISIONS ARE SUBJECT TO VENDOR'S FINAL APPROVAL. ONLY REVISIONS ACCEPTED IN WRITING BY THE PURCHASER AND VENDOR ON A PURCHASER'S EXTRA SHEET WILL BE INCORPORATED INTO THE PLANS FILED WITH THE MUNICIPALITY. E. & O.E.

REGION	SCALE	N.T.S.
VERSION	BY	DATE
NC	ZMP	1 OF 1

