

CONSTRUCTION SUMMARY

Georgian Estate Collection - Tiburtino Buildup Corp.

PURCHASER: Milos VARAKLIC

TEL: RES.: 647-449-1987 BUS.: 905-829-3538

LOT / PHASE 7 / 1	REG. PLAN # 20M-1210	HOUSE TYPE Georgian Three Elev B		
----------------------	-------------------------	-------------------------------------	--	--

CABINETRY

1 - POWDER ROOM- RAISE VANITY TO 36 15Oct19 Note:	
1 - MASTER ENSUITE - RAISE VANITY TO 36" 15Oct19 Note:	
1 - POWDER ROOM -SOFT CLOSE CABINETS 15Oct19 Note:	
1 - MASTER ENSUITE- SOFT CLOSE CABINETS AND BLU MOTION DRAWERS 15Oct19 Note:	
1 - ENSUITE 5- - CABINETS UPGRADE 3- LEGACY 15Oct19 Note:	
1 - ENSUITE 4 - CABINETS UPGRADE 3- LEGACY 15Oct19 Note:	
1 - ENSUITE 2/3 - CABINETS UPGRADE 3- LEGACY 15Oct19 Note:	
1 - POWDER ROOM- CABINETS UPGRADE 3- LEGACY 15Oct19 Note:	
1 - MASTER ENSUITE - CABINETS UPGRADE 3- LEGACY 15Oct19 Note:	
1 - KITCHEN- ADD 2 TALL POSTS ON EACH SIDE OF FRIDGE WALL- MANCHESTER 15Oct19 Note:	
1 - KITCHEN- ADD 2 HOOD POSTS- MANCHESTER 15Oct19 Note:	
1 - KITCHEN- TRANSITIONAL HOOD- UPGRADE 6 15Oct19 Note:	
1 - KITCHEN- STACKED MINI UPPERS IN CLEAR GLASS X 19- BEDFORD DOORS 15Oct19 Note:	
1 - KITCHEN- UPGRADE 6 BEDFORD DOOR 15Oct19 Note:	

CABINETRY ACCESSORIES

4 - KITCHEN CABINETRY UPPER - GLASS DOOR - CLEAR - FINISHED INTERIOR - FITS TALL UPPER CABINETS - PRICE IS PER DOOR - UPGRADE 6 2 ON EACH SIDE OF SINK 15Oct19 Note:	
1 - KITCHEN- 3 DUMMY DOORS ON SINK WALL 15Oct19 Note:	
1 - KITCHEN- 4 ISLAND POSTS- MANCHESTER 15Oct19 Note:	
1 - KITCHEN- 4 DUMMY DOORS ON ISLAND 15Oct19 Note:	
1 - KITCHEN- 8 DUMMY DOORS ON FRIDGE WALL 15Oct19 Note:	
1 - KITCHEN CABINETRY BASE - TOP DRAWER SINGLE - PRICE IS PER DRAWER - UPGRADE 6 15Oct19 Note: 2 TOP DRAWERS ON SERVERY	

CONSTRUCTION SUMMARY  
Georgian Estate Collection - Tiburtino Buildup Corp.

PURCHASER: Milos VARAKLIC TEL: RES.: 647-449-1987 BUS.: 905-829-3538

LOT / PHASE 7 / 1	REG. PLAN # 20M-1210	HOUSE TYPE Georgian Three Elev B		
1 - KITCHEN- EXTRA BANK OF DRAWERS 15Oct19 Note:				
1 - KITCHEN CABINETRY BASE - PULLOUT WIRE SPICE RACK - PRICE IS EACH 15Oct19 Note:				
1 - KITCHEN- DECOR TK-ON FRONT OF STOVE 15Oct19 Note:				
2 - KITCHEN CABINETRY BASE - POT/PAN DRAWERS (CABINET) - UPGRADE 6 15Oct19 Note: UNDER COOKTOP AND ON ISLAND				
1 - KITCHEN CABINETRY ACCESSORY - TRAY DIVIDER (MELAMINE) SINGLE DOOR CABINETS - PRICE IS EACH 15Oct19 Note:				
1 - CABINETRY DECORATIVE ITEMS - WALL POSTS (80 WIDE) - PRICE IS EACH (NOT AV. IN STANDARD LINE)x2 MANCHESTER 15Oct19 Note: BASE OF STOVE				
1 - KITCHEN CABINETRY ACCESSORY - MAGIC CORNER MECHANISM - PRICE IS EACH - STANDARD 15Oct19 Note:				

CERAMIC TILE

1 - MASTER ENSUITE- UPGRADE 3 FLOOR AND WALL TILES 15Oct19 Note:	
1 - FOYER AND POWER ROOM- UPGRADE 3 TILES 15Oct19 Note:	

COUNTER TOP

1 - KITCHEN AND SERVERY - UPGRADE COUNTERTOP TO HIGH GRADE QUARTZ IN LIEU OF STANDARD 15Oct19 Note:	
1 - ENSUITE 4 AND ENSUITE 5 SHOWER JAMS UPGRADED TO QUARTZ TO MATCH COUNTERTOP 15Oct19 Note:	

ELECTRICAL

1 - KITCHEN - FAN INSERT FOR UPGRADE 36" HOOD - CYCLONE BX21534 IN LIEU OF 30" IN LIEU OF STANDARD 15Oct19 Note:	
1 - MASTER BEDROOM- 3 WAY SWITCH - SEE SKETCH 25Jun19 Note:	
1 - MASTER BEDROOM CLOSET- ROUGH IN FOR FUTURE STACKABLE WASHER AND DRYER- PLUMBING, ELECTRICAL AND VENTING- SEE SKETCH FOR LOCATION 25Jun19 Note:	
1 - STANDARD PORCH LIGHT TO BE CENTERED IN PORCH CEILING 25Jun19 Note:	
1 - BASEMENT REC ROOM AND MAIN HALL- DELETE STANDARD LIGHTS - SEE SKETCH 25Jun19 Note:	
1 - FIRST FLOOR MAIN HALL- DELETE STANDARD MAIN HALL LIGHTS- SEE SKETCH 25Jun19 Note:	
3 - REC ROOM- POT LIGHTS ON DIMMER SWITCHES- SEE SKETCH 25Jun19 Note:	
19 - POT LIGHT - LED - BASEMENT REC ROOM INSTALLATION 25Jun19 Note:	



CONSTRUCTION SUMMARY

Georgian Estate Collection - Tiburtino Buildup Corp.

PURCHASER: Milos VARAKLIC

TEL: RES.: 647-449-1987 BUS.: 905-829-3538

LOT / PHASE 7 / 1	REG. PLAN # 20M-1210	HOUSE TYPE Georgian Three Elev B		
1 - REC ROOM- ADD ROUGH IN ELECTRICAL FOR FUTURE WET BAR DISHWASHER & FRIDGE - SEE SKETCH 25Jun19 Note:				
3 - POT LIGHTS TO BE ON DIMMER SWITCH- KITCHEN, BREAKFAST, FAMILY 25Jun19 Note:				
1 - PLUG - ELECTRICAL PLUG - ADD TO ISLAND 25Jun19 Note:				
3 - LIGHT AND SWITCH - NO FIXTURE INCLUDED- ADD LIGHT TO SHARED ENSUITE 2/3 , BEDROOM 4 ENSUITE AND BED 5 REC ROOM ENSUITE 25Jun19 Note:				
1 - POT LIGHT - SHOWER POT LIGHT- ADD TO TUB IN SHARED ENSUITE 2/3 25Jun19 Note:				
3 - PLUG - ELECTRICAL PLUG- FAMILY ROOM, MASTER BEDROOM AND REC ROOM- 5FT FROM FLOOR FOR TV 25Jun19 Note:				
1 - ABOVE KITCHEN ISLAND - ADD LIGHT AND SWITCH - NO FIXTURE INCLUDED 25Jun19 Note:				
1 - LIGHT AND SWITCH - NO FIXTURE INCLUDED - LIVING ROOM 25Jun19 Note:				

FIREPLACE AND ACCESSORIES

1 - ADD FIREPLACE TO BASEMENT WITH STANDARD MANTLE 25Jun19 Note:	
1 - GAS LINE ROUGH-IN FOR BARBECUE - FIRST FLOOR 25Jun19 Note:	

HARDWOOD FLOORING

1 - LAMINATE -UPGRADE TO LEXINGTON SERIES IN LIEU OF STANDARD LAMINATE 15Oct19 Note:	
1 - FIRST AND SECOND FLOOR- GROUP B 5" HARDWOOD IN LIEU OF STANDARD - 15Oct19 Note:	

MIRRORS AND GLASS

1 - FOR CONFIRMATION PURPOSES- MASTER ENSUITE- INSTALL 2 FRAMELESS DOORS FOR SHOWER 15Oct19 Note:	
--	--

MISCELLANEOUS

1 - FURTHER VENDOR DISCOUNT 15Oct19 Note:	
--	--

PLUMBING

1 - ADD RECIRCULATING LINE FOR HOT WATER 01Oct19 Note:	
1 - MASTER BEDROOM CLOSET- ROUGH IN FOR FUTURE STACKABLE WASHER AND DRYER- PLUMBING, ELECTRICAL AND VENTING- SEE SKETCH FOR LOCATION 25Jun19 Note:	
1 - - REC ROOM- ADD ROUGH IN PLUMBING FOR FUTURE WET BAR- SEE SKETCH 25Jun19 Note:	
1 - ALL EXTERIOR HOSE BIBS TO BE FROST FEE- FRONT AND BACK 25Jun19 Note:	

CONSTRUCTION SUMMARY				
Georgian Estate Collection - Tiburtino Buildup Corp.				
PURCHASER: Milos VARAKLIC			TEL: RES.: 647-449-1987 BUS.: 905-829-3538	
LOT / PHASE 7 / 1	REG. PLAN # 20M-1210	HOUSE TYPE Georgian Three Elev B		

PROMOTIONAL

I - LESS BALANCE OF CREDIT FROM PURCHASER EXTRA SHEET IN OFFER 15Oct19 Note:	
I - PARTIAL REDEMPTION OF PROMOTIONAL PACKAGE \$14,360 BALANCE FORWARD \$25,640 TO BE USED AT A LATER DATE. ORIGINAL PROMOTIONAL PACKAGE OF \$40,000 25Jun19 Note:	

EXTRAS AS PER OFFER

The Vendor agrees that notwithstanding any other term or provision in this Agreement included in the Purchase Price and in addition to those items detailed in Schedule GP to the Agreement of Purchase and Sale, the Purchaser is entitled to a credit of For Worksheet Note:	
The Purchaser acknowledges that the Purchase Price is inclusive of all credits and promotional packages available at the time of purchase. Worksheet Note:	

This Document is Extremely Time Sensitive - Printed 15 Oct 19 at 15:20



Purchaser:Milos VARAKLIC

Telephone Res. / Bus: (647) 449-1987 / (905) 829-3538

Decor Advisor: Natalie Mancuso

Lock Date: 15-Oct-19

Property: 7

Project: Tiburtino Buildup Corp.

Model and Elevation: Georgian Three Elev B

Plan #: 20M-1210

Layout Changes: ☒ Yes ☐ No

Sketch Attached: ☒ Yes ☐ No

Exterior Colour Scheme:

1. Cabinetry

	Style and Colour	Hardware
Kitchen / Breakfast	BEDFORD L614XZ4 - HARDWARE BASES 431SA- HARDWARE UPPERS 113SB	
Laundry Room	ELISSE	Standard
Powder Room	LEGACY L614XZ4	113SB
Master Ensuite Bathroom	LEGACY L614XZ4	113SB
Ensuite Bath - Bedroom 2/3	LEGACY L614XZ4	113SB
Ensuite Bath - Bedroom 4	LEGACY L614XZ4	113SB
Ensuite Bath - Bedroom 5	LEGACY L614XZ4	113SB

Appliances:

Built In Appliances ☒ Yes ☐ No

Slide In Stove ☐ Yes ☒ No

Dishwasher Cabinet ☐ Closed ☒ Open

41" Upper Cabinets ☒ Yes ☐ No

Please NOTE: Standard Cabinet Height is 30"

Stove Opening

NOTE: If not specified, opening will be set to builder's standard opening of approximately 30" width

Fridge Opening

NOTE: If not specified, opening will be set to builder's standard opening of approximately 37" width x 74" height

\*\* Refer to Construction Summary

2. Counters

	Counter	Edge
Kitchen / Breakfast	QUARTZ- VICTORIA	#360
Laundry Room	N/A	
Powder Room	MARBLE- BIANCO CARRARA	#360
Master Ensuite Bathroom	MARBLE- BIANCO CARRARA	#360
Ensuite Bath - Bedroom 2/3	QUARTZ- TORRONE	#360
Ensuite Bath - Bedroom 4	QUARTZ- TORRONE	#360
Ensuite Bath - Bedroom 5	QUARTZ- TORRONE	#360

\*\* Refer to Construction Summary  
MASTER ENSUITE SHOWER JAMS- MARBLE- BIANCO CARRARA  
ENSUITE 4 AND 5 SHOWER JAMS- QUARTZ- TORRONE



Purchaser: Milos VARAKLIC

Property: 7

Telephone Res. / Bus: (647) 449-1987 / (905) 829-3538

Project: Tiburtino Buildup Corp.

Decor Advisor: Natalie Mancuso

Model and Elevation: Georgian Three Elev B

Lock Date: 15-Oct-19

15-Oct-19

Plan #: 20M-1210

## 3. Ceramic Flooring

		At a 45 Threshold-If App.	
Entrance Vestibule	TILE- LITIUM SILVER POLISHED 24X24	<input type="checkbox"/>	Metal Strip Where Applicable
Main Hall	HARDWOOD	<input type="checkbox"/>	
Kitchen / Breakfast	HARDWOOD	<input type="checkbox"/>	
Laundry Room	TILE- STONE LITE GREY 12.5 X 24.5	<input type="checkbox"/>	
Powder Room	TILE- LITIUM SILVER POLISHED 24X24	<input type="checkbox"/>	
Master Ensuite Bathroom	TILE- LITIUM PEARL POLISHED 24X24	<input type="checkbox"/>	
Ensuite Bath - Bedroom 2/3	TILE- VESUBIO GRECO IVORY 20X20	<input type="checkbox"/>	
Ensuite Bath - Bedroom 4	TILE- VESUBIO GRECO IVORY 20X20	<input type="checkbox"/>	
Ensuite Bath - Bedroom 5	TILE- VESUBIO GRECO IVORY 20X20	<input type="checkbox"/>	
		<input type="checkbox"/>	
		<input type="checkbox"/>	

MASTER ENSUITE SHOWER JAMS- MARBLE- BIANCO CARRARA  
ENSUITE 4 AND 5 SHOWER JAMS- QUARTZ- TORRONE

## 4. Ceramic Wall Tile

Master Ensuite Bathroom		Selection	Describe
Tub Deck Wall			
Tub Deck			
Tub Deck Skirt			
Shower Stall		TILE- LITIUM PEARL POLISHED 24X24	
Bathtub Enclosure Walls			
Ensuite Bath - Bedroom 2/3		TILE- VESUBIO GRECO IVORY 10X20	LAI D HORIZONTAL
Ensuite Bath - Bedroom 4		TILE- VESUBIO GRECO IVORY 10X20	LAI D HORIZONTAL
Ensuite Bath - Bedroom 5		TILE- VESUBIO GRECO IVORY 10X20	LAI D HORIZONTAL
Kitchen Backsplash			

\*\* Refer to Construction Summary - STANDARD GROUT THROUGHOUT UNLESS SPECIFIED  
ALL SHOWER FLOORS TO BE- PREMIER WHITE 2X2 MOSAIC

## 5. Plumbing Fixtures

All Bathrooms

White

Whirlpool

 ☐ Yes ☒ NoDishwasher Rough-In ☒ Yes ☐ NoWaterline for Fridge ☒ Yes ☐ No

\*\* Refer to Construction Summary

## 6. Trim Carpentry

Interior Doors

CARRARA-SMOOTH

Interior Trim

3" BB CASING WITH 7 1/4" BASEBOARD - ONE STEP

Door Handles

As Per Construction Specifications

Exterior Front Door Handle

As Per Construction Specifications

\*\* Refer to Construction Summary

Initial: 



Purchaser:

Milos VARAKLIC

Telephone Res. / Bus:

(647) 449-1987 / (905) 829-3538

Decor Advisor:

Natalie Mancuso

Lock Date:

15-Oct-19

Property: 7

Project: Tiburtino Buildup Corp.

Model and Elevation: Georgian Three Elev B

Plan #:

20M-1210

7. Other Flooring

Main Hall	HARDWOOD- MIRAGE 5INCH RED OAK CHARACTER- TREASURE- CASHMERE	
Living Room	HARDWOOD- MIRAGE 5INCH RED OAK CHARACTER- TREASURE- CASHMERE	
Dining Room	HARDWOOD- MIRAGE 5INCH RED OAK CHARACTER- TREASURE- CASHMERE	
Family Room	HARDWOOD- MIRAGE 5INCH RED OAK CHARACTER- TREASURE- CASHMERE	
Den / Library / Study	HARDWOOD- MIRAGE 5INCH RED OAK CHARACTER- TREASURE- CASHMERE	
Basement Landing(If Applies)	LAMINATE-LEXINGTON - WHITE ROCK OAK TL-21008-MT	
Lower Landing (If Applies)	HARDWOOD- MIRAGE 5INCH RED OAK CHARACTER- TREASURE- CASHMERE	
Upper Landing	HARDWOOD- MIRAGE 5INCH RED OAK CHARACTER- TREASURE- CASHMERE	
Upper Hall	HARDWOOD- MIRAGE 5INCH RED OAK CHARACTER- TREASURE- CASHMERE	
Master Bedroom	HARDWOOD- MIRAGE 5INCH RED OAK CHARACTER- TREASURE- CASHMERE	
Bedroom #2	HARDWOOD- MIRAGE 5INCH RED OAK CHARACTER- TREASURE- CASHMERE	
Bedroom #3	HARDWOOD- MIRAGE 5INCH RED OAK CHARACTER- TREASURE- CASHMERE	
Bedroom #4	HARDWOOD- MIRAGE 5INCH RED OAK CHARACTER- TREASURE- CASHMERE	
Bedroom #5	LAMINATE-LEXINGTON - WHITE ROCK OAK TL-21008-MT	
KITCHEN/BREAKFAST	HARDWOOD- MIRAGE 5INCH RED OAK CHARACTER- TREASURE- CASHMERE	
BASEMENT REC /GYM	LAMINATE-LEXINGTON - WHITE ROCK OAK TL-21008-MT	
Underpad	Type	Area

\*\* Refer to Construction Summary

8. Railings and Pickets

Railing Type	V-GROOVE	Colour	MIRAGE- TREASURE
Picket Type	EUROLINE 1	Colour	BLACK
Stringer / Riser	AS PER CONSTRUCTION SPECIFICATIO	Colour	MIRAGE- TREASURE
Treads	AS PER CONSTRUCTION SPECIFICATIO	Colour	MIRAGE- TREASURE
Red Oak Stairs with Semi Gloss Finish		<input checked="" type="radio"/> Yes <input type="radio"/> No	

\*\* Refer to Construction Summary

9. Wall Paint Flat Finish

Main & Upper Hall	22 WARM GREY	Master Bedroom	22 WARM GREY
Living Room	22 WARM GREY	Bedroom #2	22 WARM GREY
Dining Room	22 WARM GREY	Bedroom #3	22 WARM GREY
Kitchen / Breakfast	22 WARM GREY	Bedroom #4	22 WARM GREY
Family Room	22 WARM GREY	Bedroom #5	22 WARM GREY
Powder Room	22 WARM GREY	Master Ensuite	22 WARM GREY
Laundry Room	22 WARM GREY	Ensuite Bath - Bedroom 2/3	22 WARM GREY
Den/Library	22 WARM GREY	Ensuite Bath - Bedroom 4	22 WARM GREY
Trim Paint-Semi Gloss	BIRCH WHITE	Ensuite Bath - Bedroom 5	22 WARM GREY
		BASEMENT	22 WARM GREY

Smooth Ceilings First Floor ☒ Yes ☐ No

\*\* Refer to Construction Summary

Initial: 



Purchaser:Milos VARAKLIC

Telephone Res. / Bus: (647) 449-1987 / (905) 829-3538

Decor Advisor: Natalie Mancuso

Lock Date: 15-Oct-19

Property: 7

Project: Tiburtino Buildup Corp.

Model and Elevation: Georgian Three Elev B

Plan #: 20M-1210

10. Plaster Mouldings and Medallions

Entrance Vestibule	B-8-8		Kitchen/Breakfast		
Main Hall	B-8-8		Den/Library		
Living Room			Lower Landing		
Dining Room					
Family Room					

\*\* Refer to Construction Summary

11. Fireplace

	Living Room			Family Room			Other Room - Specify		
	Purchased	As Per Plan	N/A	Purchased	As Per Plan	N/A	Purchased	As Per Plan	N/A
Fireplace Type	<input type="radio"/>	<input checked="" type="radio"/>	<input type="radio"/>	<input type="radio"/>	<input checked="" type="radio"/>	<input type="radio"/>	<input checked="" type="radio"/>	<input type="radio"/>	<input type="radio"/>
Mantle Type	FLAT ON WALL			FLAT ON WALL			FLAT ON WALL		
Mantle Type	MANTLE M1-STANDARD			MANTLE M1-STANDARD			MANTLE M1-STANDARD		
Colour / Stain	AS PER CONSTRUCTION SPECIFICATIONS			AS PER CONSTRUCTION SPECIFICATIONS			AS PER CONSTRUCTION SPECIFICATIONS		
Surround	BIANCO			BIANCO			BIANCO		
Hearth	NO			NO			NO		

\*\* Refer to Construction Summary

12. Heating and Air Conditioning

Air Conditioning	YES	Gas Provisions Stove	NO
Gas Provisions Dryer	NO	Gas Provisions Barbecue	YES
Comment			

\*\* Refer to Construction Summary

13. Electrical

Plugs and Switches	<input checked="" type="radio"/> White	DECOR	Above Kitchen Cabinet Light	<input type="radio"/> Yes	<input checked="" type="radio"/> No
Hood Fan	CYCLONE INSERT <del>20" #B221528</del>		Below Kitchen Cabinet Light	<input checked="" type="radio"/> Yes	<input type="radio"/> No
Appliances	Built in Cooktop	Built in Oven	Gas Stove	Microwave	
	<input checked="" type="radio"/> Yes <input type="radio"/> No	<input checked="" type="radio"/> Yes <input type="radio"/> No	<input type="radio"/> Yes <input checked="" type="radio"/> No	<input checked="" type="radio"/> Yes <input type="radio"/> No	
Dishwasher Rough-in	Yes				

\*\* Refer to Construction Summary

14. General Comments

\*\* Refer to Construction Summary

Disclaimers and Notes


- Colours of all materials are as close as possible to builder's selection, but not necessarily identical due to variances in manufacturing.
- Any extras listed above are null and void unless accompanied by a separate invoice/amendment. Said invoice must be paid in full.
- The Purchaser agrees that this colour selection is final and that no changes will be permitted, unless required by the Vendor.
- The Purchaser acknowledges reading and accepting document which contains other miscellaneous disclaimers.

Signature: \_\_\_\_\_ Date: \_\_\_\_\_



PAULINE  
AUG 29 19  
REV SEP 26 19 PB  
REV OCT 16 19 PB


PROTOTYPE  
FOR EXTRAS

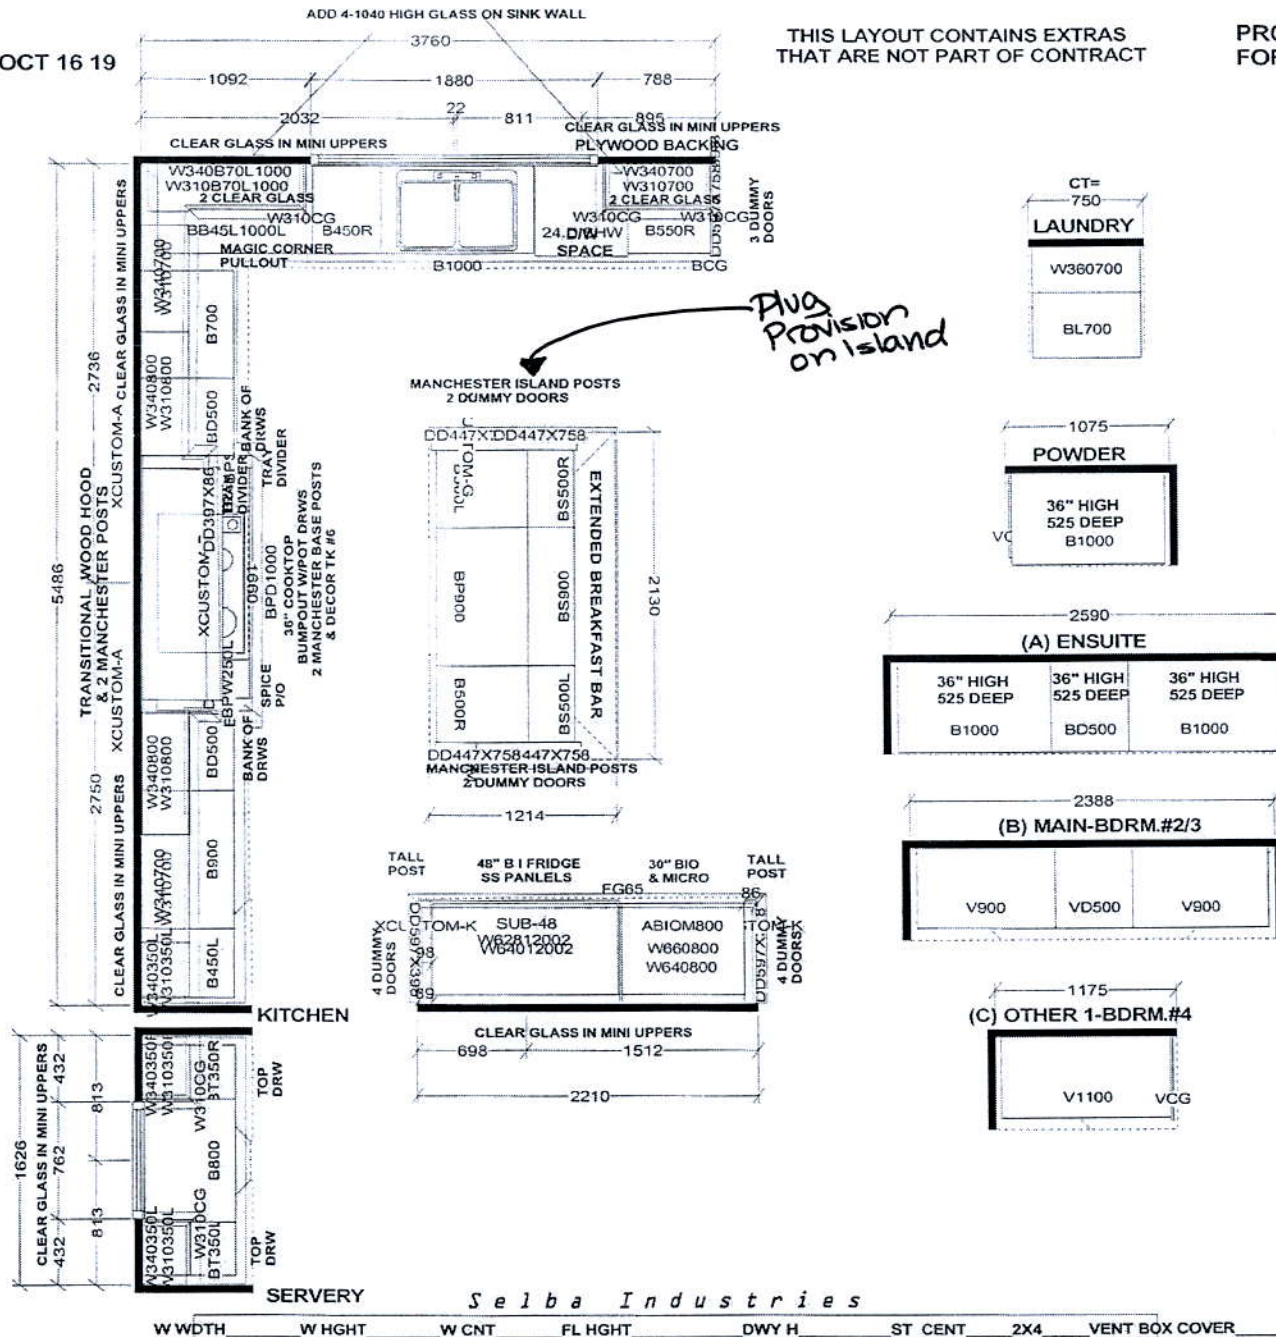

*This drawing is the intellectual property of SELDA INDUSTRIES INC. and is an original design which must not be released or copied unless applicable fee has been paid or job order placed.*

**JOB NUMBER:**  
**BUILDER:** GREENYORK  
**SITE NAME:** TIBURTINO, Oakville  
**MODEL:** GEORGIAN 3X ELEV A,B  
**LOT #:**  
**DESIGNER:** KS  
**DATE:** JAN 24 18/rev'd June 28 18  
rev'd Aug 31 18/rev'd Sept



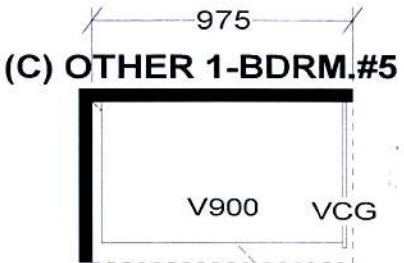

*S e l b a   I n d u s t r i e s*

WDTH \_\_\_\_\_ W HGHT \_\_\_\_\_ W CNT \_\_\_\_\_ FL HGHT \_\_\_\_\_ DWY H \_\_\_\_\_ ST CENT \_\_\_\_\_ 2X4 \_\_\_\_\_ VENT BOX COVER \_\_\_\_\_




*This drawing is the intellectual property of  
SELBA INDUSTRIES INC. and is an  
original design which must not be released  
or copied unless applicable fee has been  
paid or job order placed.*



JOB NUMBER:  
BUILDER: GREENYORK  
SITE NAME: TIBURTINO, Oakville  
MODEL: GEORGIAN 3X ELEV A,B FIN BSMT  
LOT #:  
DESIGNER: KS  
DATE: JAN 24 18/rev'd June 28 18



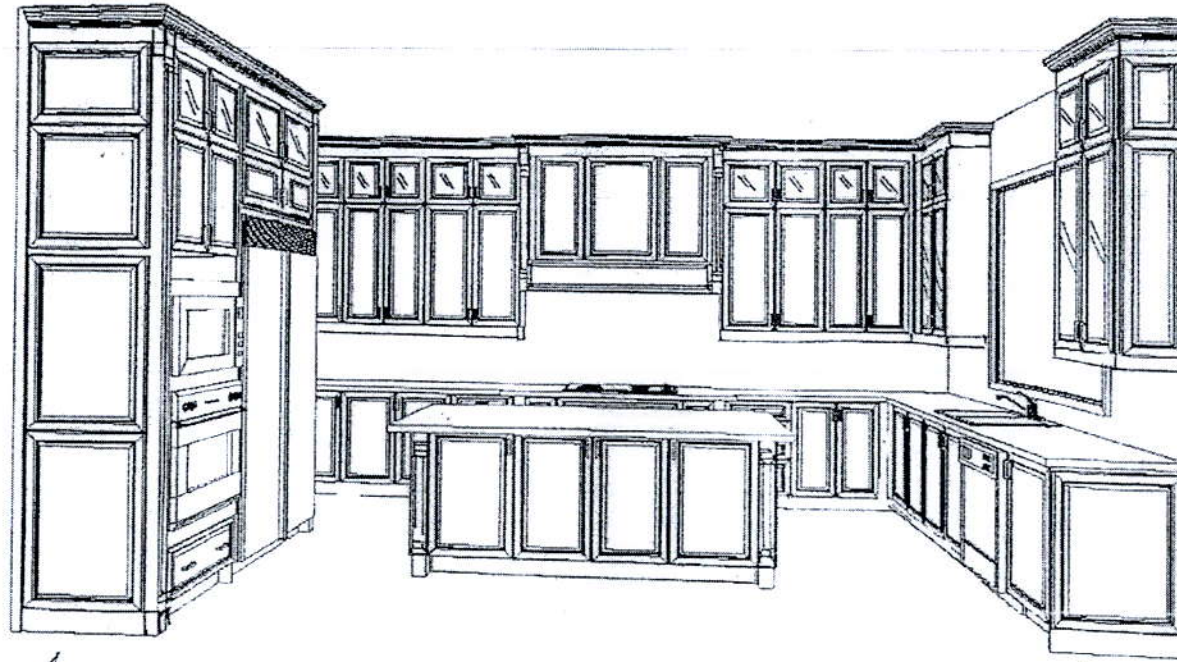

↑  
D. DOOLE

↑ D. DOOLE

This drawing is the intellectual property of SELBA INDUSTRIES INC. and is an artistic interpretation of the general appearance of the design. It is not meant to be an exact rendition.

**Selba**  
Kitchen - Bath, Design

Designed: 9/26/2019  
Printed: 9/26/2019


Rev OCT 16/19  
RF " " "

TIBURTINO 7-SEP 26 19

TIBURTINO 7-SEP 26 19 Drawing #: 1

M.V.



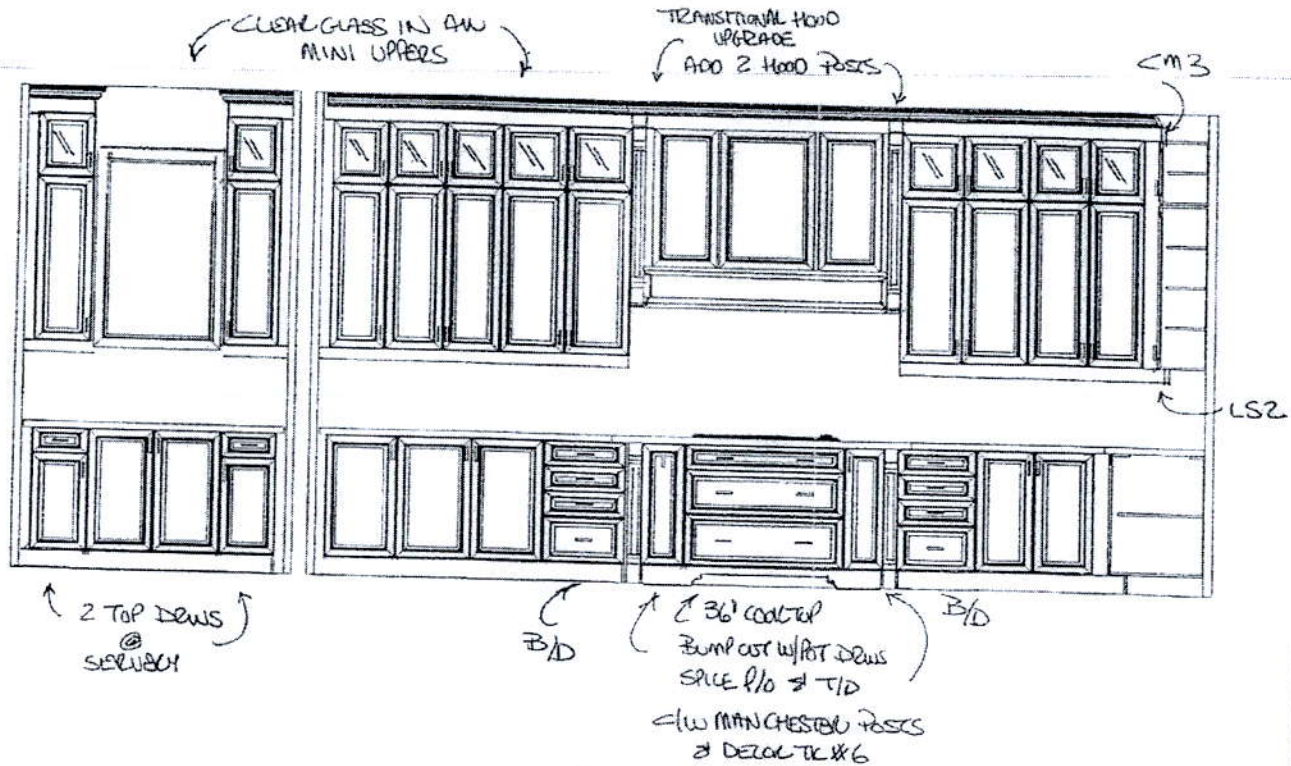

This drawing is the intellectual property of SELBA INDUSTRIES INC. and is an artistic interpretation of the general appearance of the design. It is not meant to be an exact rendition.

**Selba**  
Kitchen • Bath Designs


Designed: 9/26/2019  
Printed: 9/26/2019

SERJEAN Z. STANLEY  
TIBURTINO 7-SEP 26 19

TIBURTINO 7-SEP 26 19 Drawing #: 1

M.V.



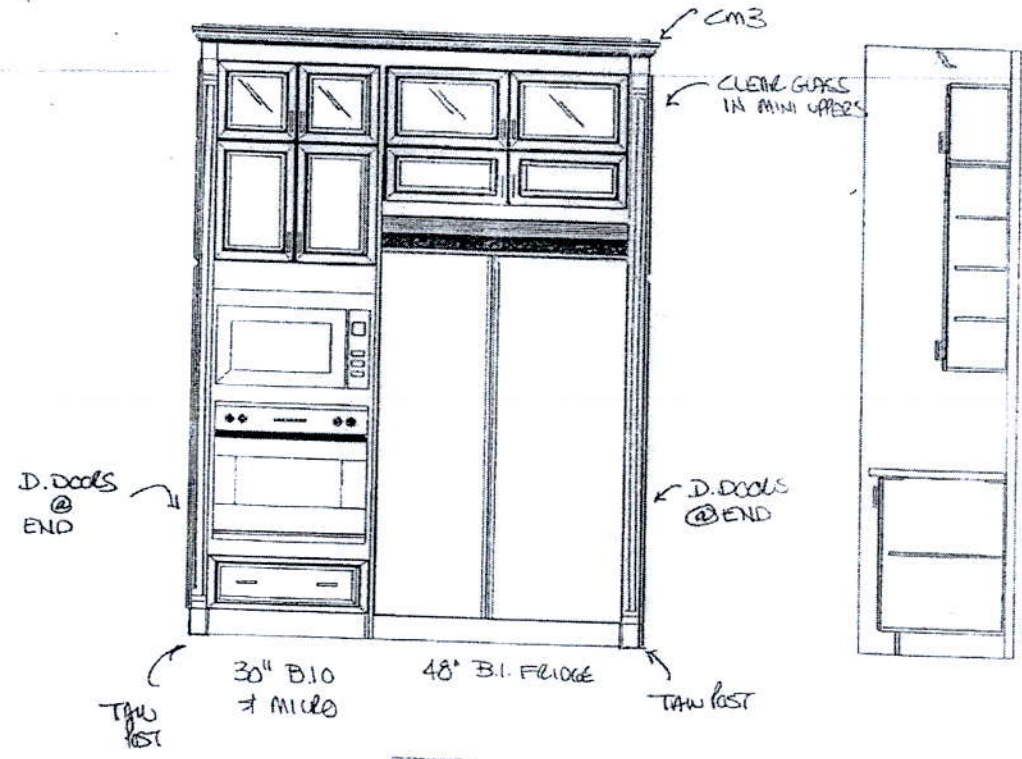

This drawing is the intellectual property of SELBA INDUSTRIES INC. and is an artistic interpretation of the general appearance of the design. It is not meant to be an exact rendition.

*Selba*  
Interiors • Elite Designs


Designed: 9/26/2019  
 Printed: 9/26/2019

Rev 07 16/19

TIBURTINO 7-SEP 26 19


TIBURTINO 7-SEP 26 19 Drawing #: 1

m.v

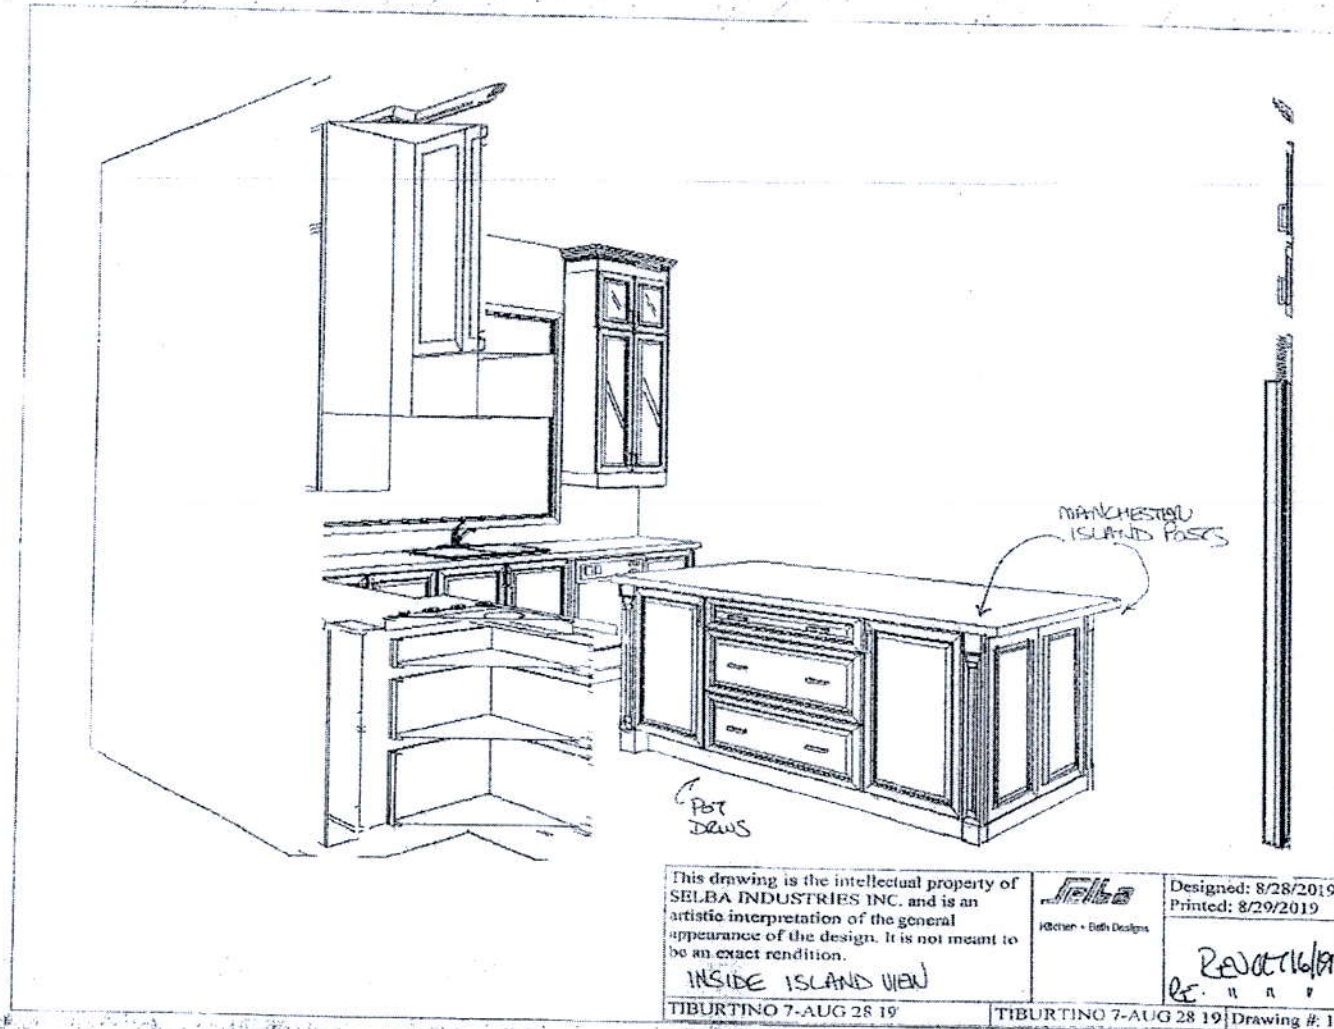

M.V.



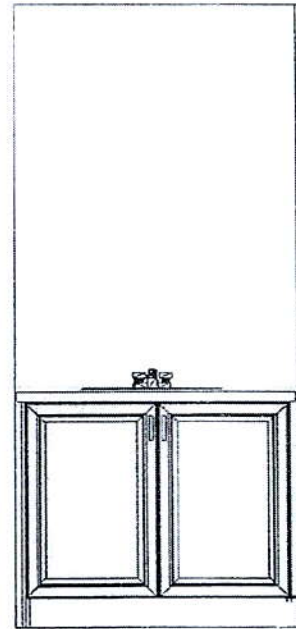

Powder Room


This drawing is the intellectual property of SELBA INDUSTRIES INC. and is an artistic interpretation of the general appearance of the design. It is not meant to be an exact rendition.

*Powder*  
TIBURTINO 7

**Selba**  
Kitchen • Bath Designs

Designed: 7/2/2019  
Printed: 7/2/2019

TIBURTINO 5 Drawing #: 1

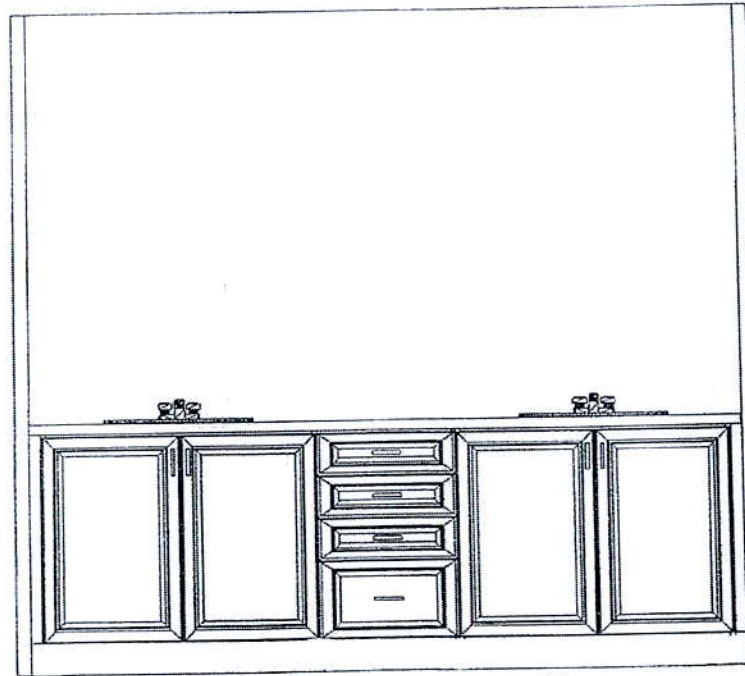

914 (36")

master Ensuite Bathroom.

This drawing is the intellectual property of SELBA INDUSTRIES INC. and is an artistic interpretation of the general appearance of the design. It is not meant to be an exact rendition.

**Selba**  
Kitchen + Bath Design


Designed: 7/2/2019  
Printed: 7/2/2019

ENSUITE 110" To 36" H.

TIBURTINO 7

TIBURTINO 5 | Drawing #: 1



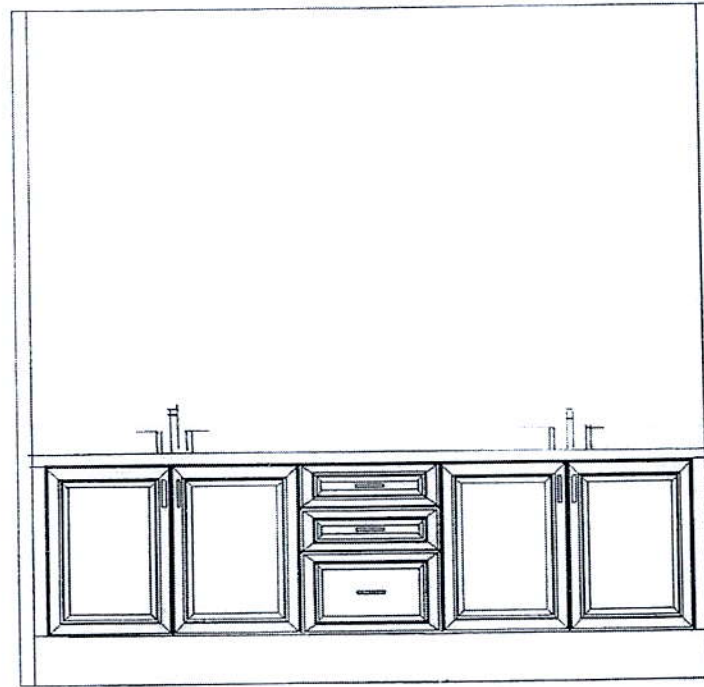

Ensuite 2/3 Bathroom


This drawing is the intellectual property of SELBA INDUSTRIES INC. and is an artistic interpretation of the general appearance of the design. It is not meant to be an exact rendition.

**Selba**  
Küchen + Bath Designs


Designed: 7/2/2019  
Printed: 7/25/2019

380 2/3 (STD.)  
TIBURTINO 7

TIBURTINO 5 | Drawing #: 1

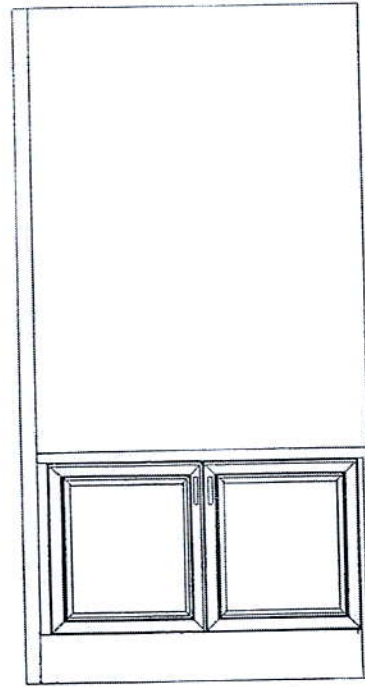

Ensuite 4 Bathroom

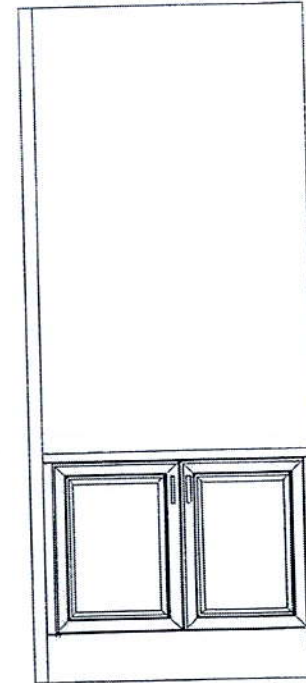

Ensuite 5 Bathroom

This drawing is the intellectual property of SELBA INDUSTRIES INC. and is an artistic interpretation of the general appearance of the design. It is not meant to be an exact rendition.


**Selba**  
Kitchen + Bath Designs

Designed: 7/2/2019  
Printed: 7/25/2019

BED 4 & BED 5 (STD)  
TIBURTINO 7

TIBURTINO 5 | Drawing #: 1




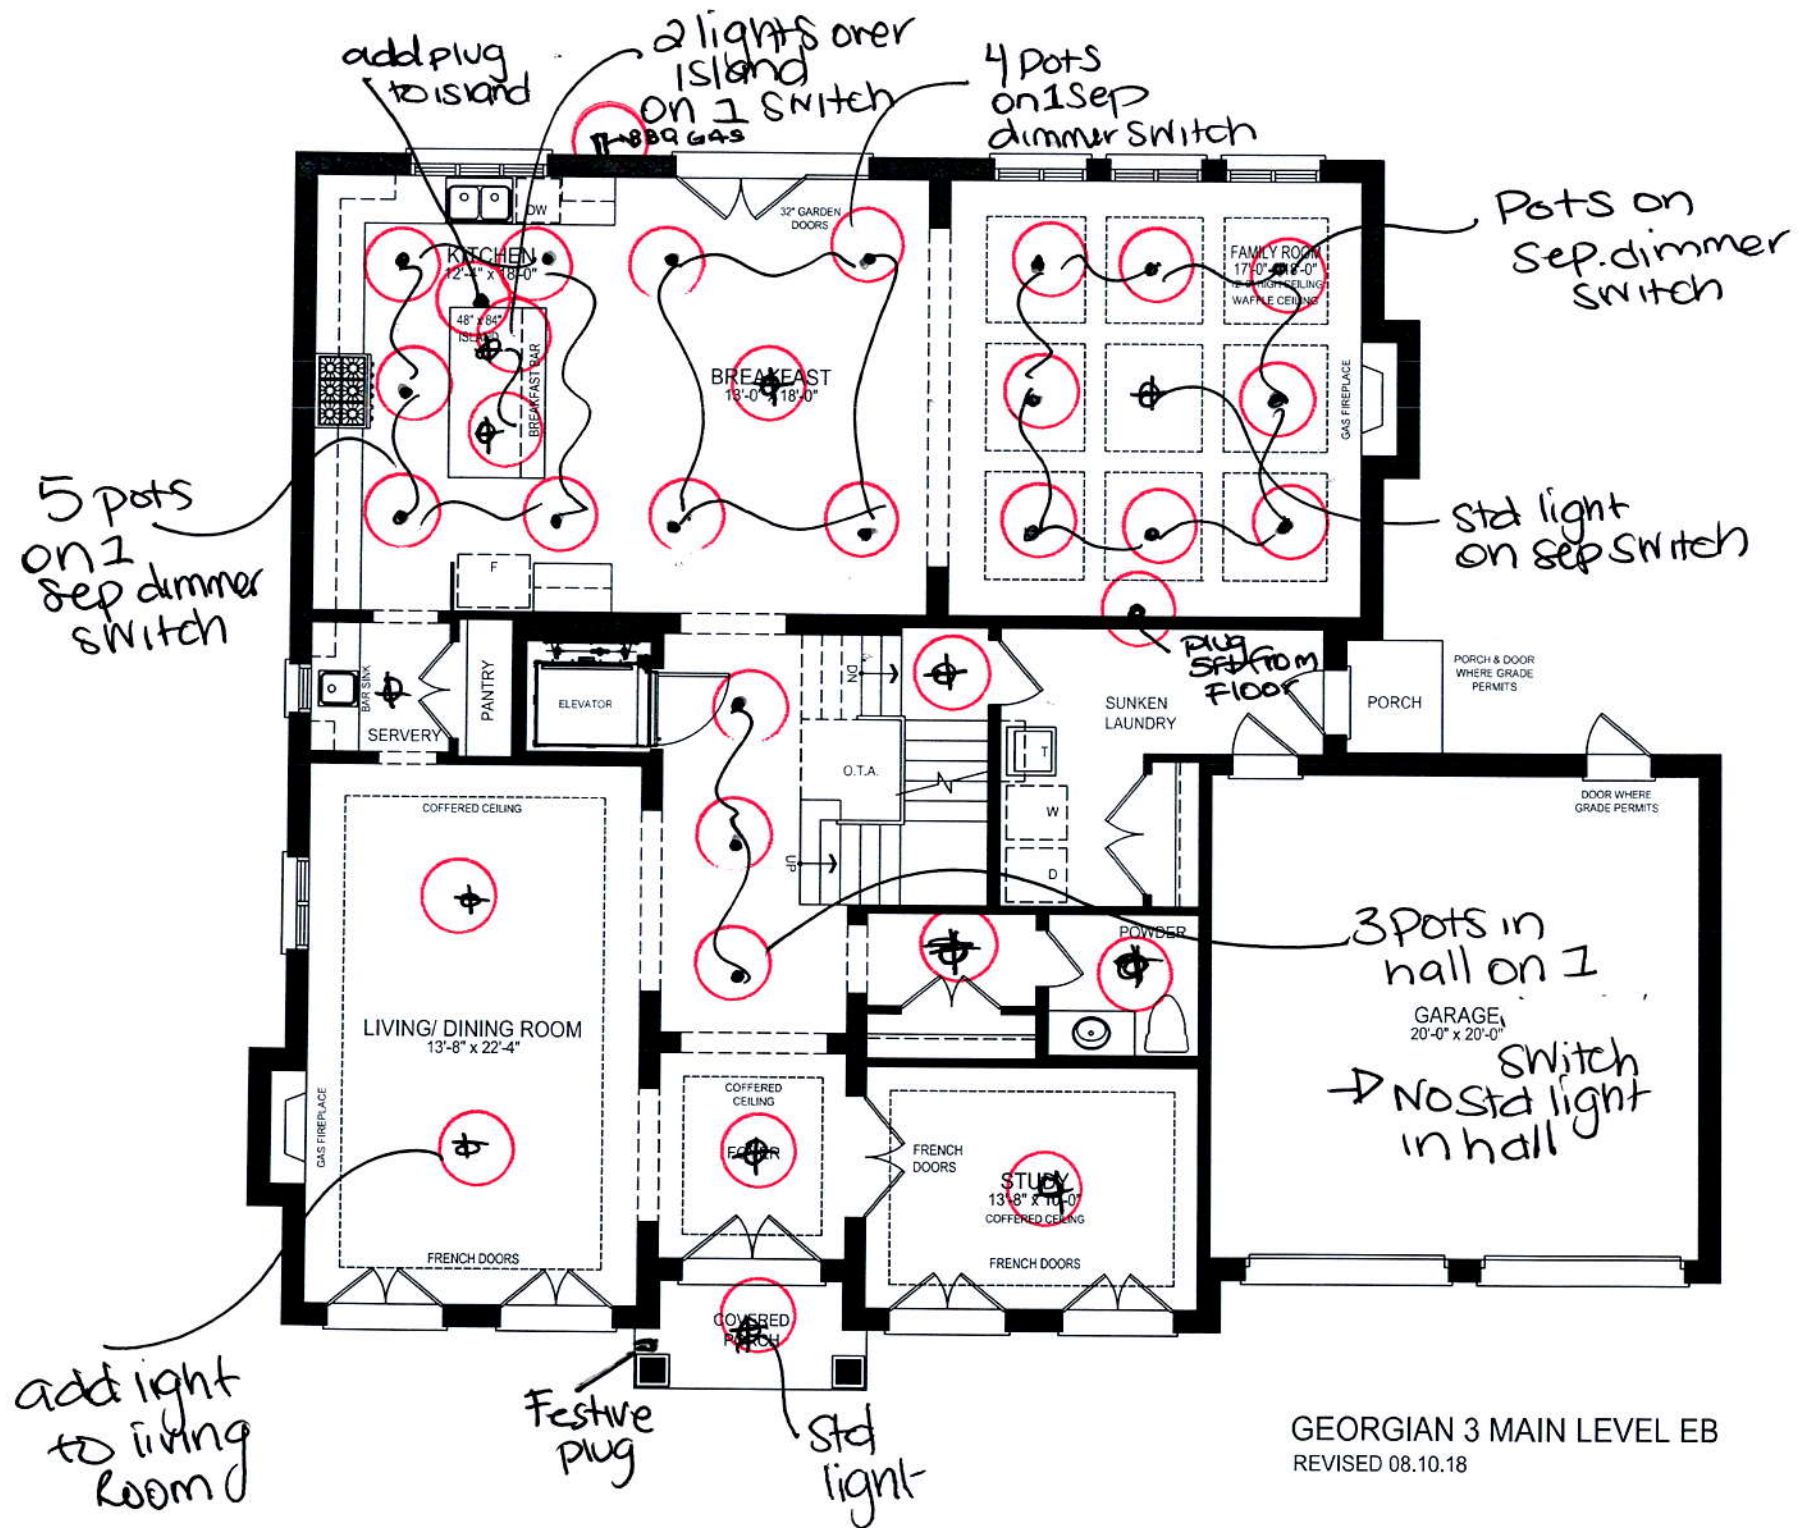

GEORGIAN 3 MAIN LEVEL EB  
REVISED 08.10.18





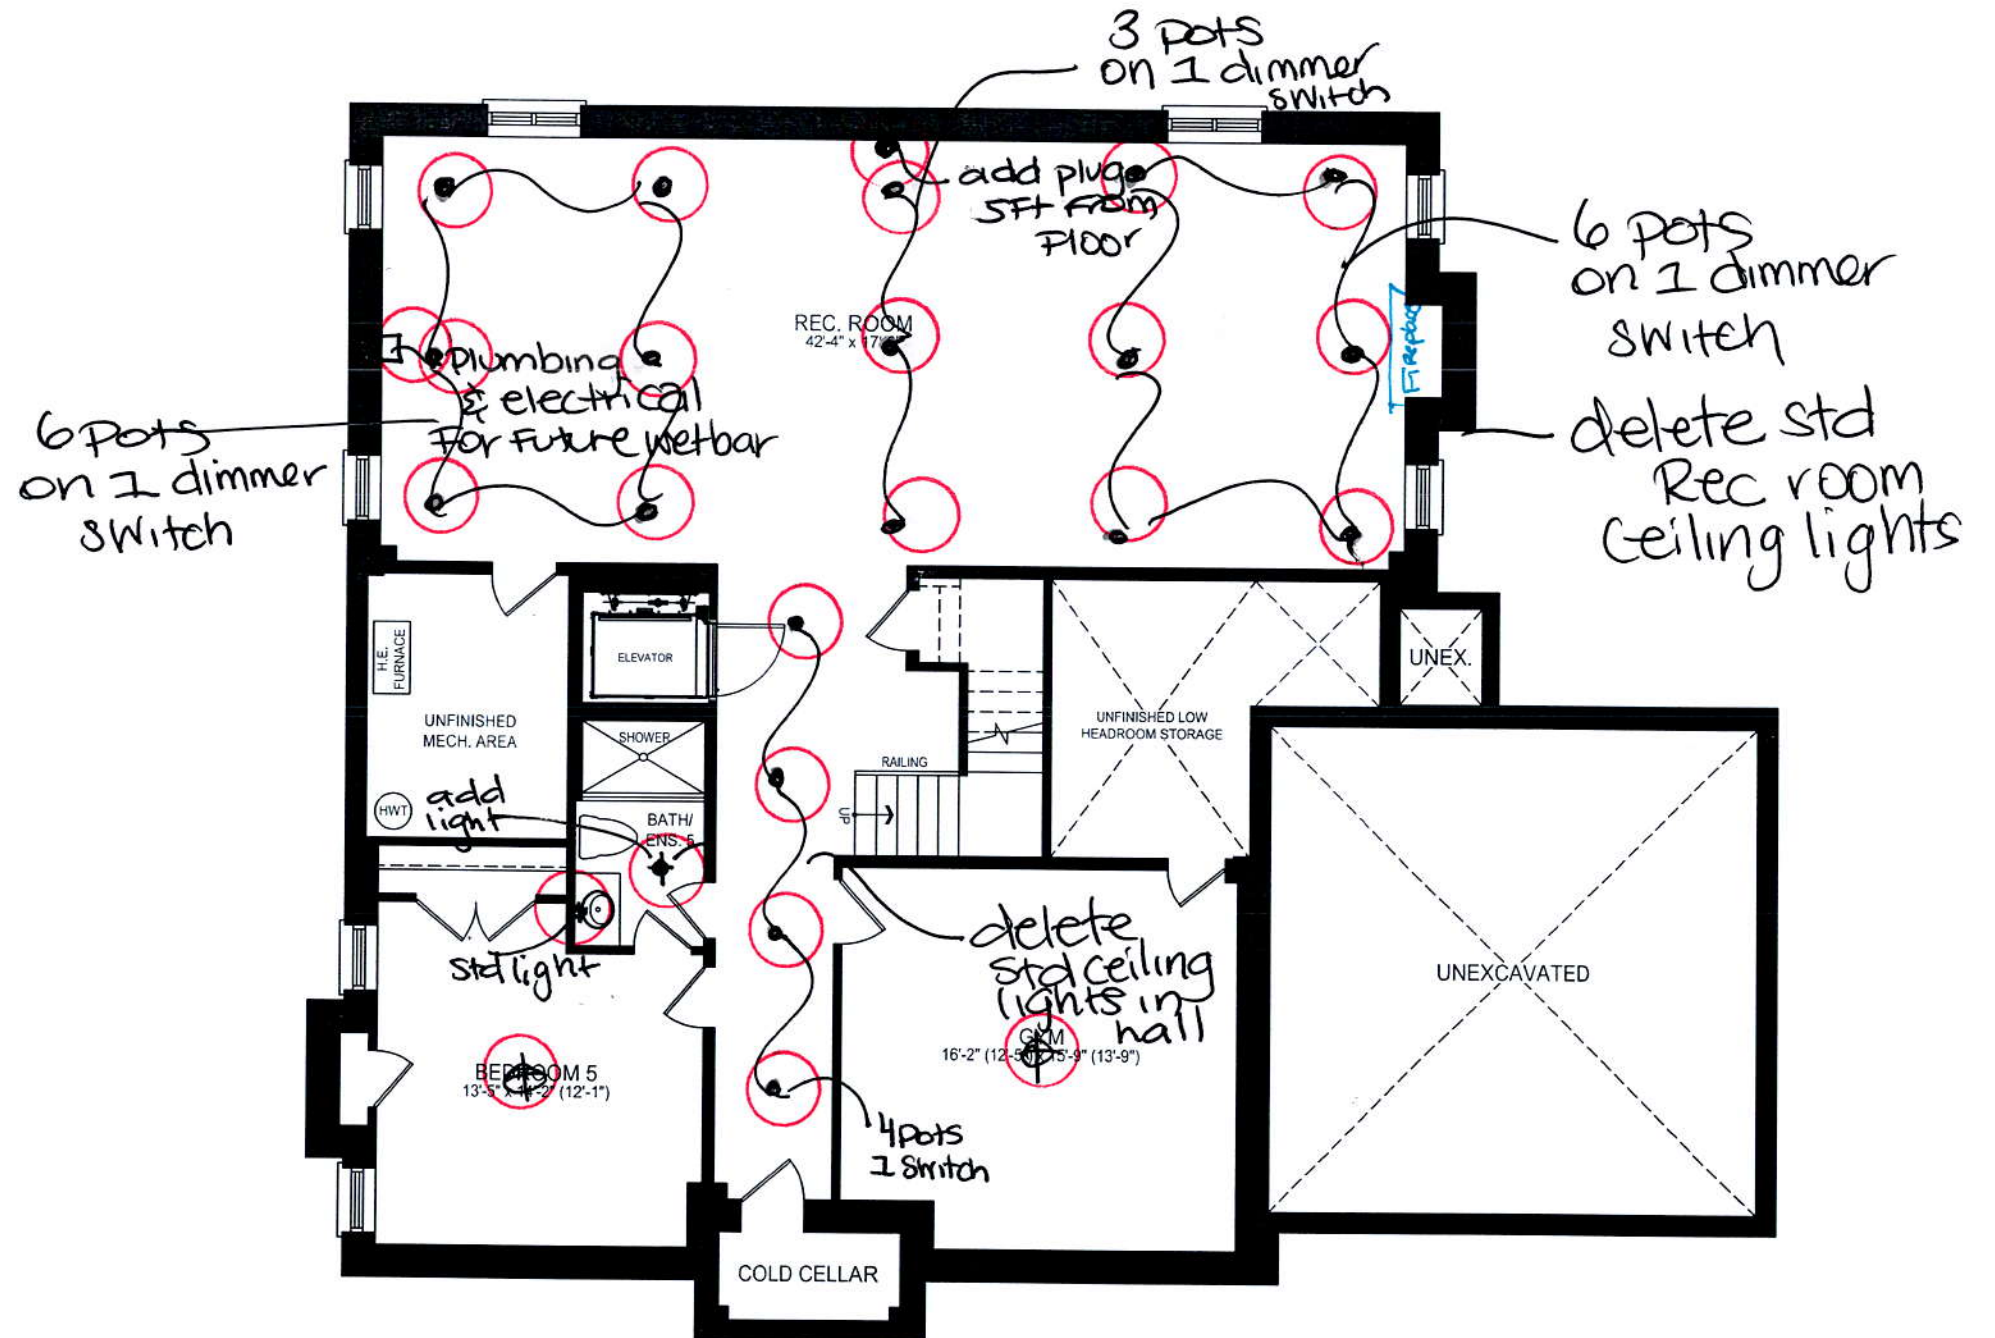

GEORGIAN 3 LOWER LEVEL EB  
REVISED 08.10.18