

CONSTRUCTION SUMMARY

Lotus Pointe 2 (G) - Lamberts Lane Home Corp.

RECEIVED NOV 07 2019

PURCHASERS: HARMINDER SINGH WALIA and HARSHPREET KAUR WALIA

TEL:

LOT / PHASE 45 / 2	REG. PLAN # 43M-2071	HOUSE TYPE Kinmount Eleven-B Elev 1		
-----------------------	-------------------------	--	--	--

ELECTRICAL

2 - POT LIGHT - LED - FIRST FLOOR INSTALLATION- FAMILY ROOM AND DINING- SEE SKETCH 07Nov19 Note:	
1 - POT LIGHT - EXTERIOR - SOFFIT MOUNT - REGULAR VOLTAGE 07Nov19 Note:	
1 - PLUG - ELECTRICAL PLUG WITH GFI AND SWITCH - FOR FESTIVE LIGHTING 07Nov19 Note:	
1 - PLUG - ELECTRICAL PLUG - TO BE INSTALLED OVER FIREPLACE 07Nov19 Note:	

PLUMBING

2 - TOE TESTER - ADD TOE TESTER TO SHOWER- MASTER ENSUITE AND BEDROOM 2 BATH 07Nov19 Note:	
---	--




PROMOTIONAL

1 - PARTIAL REDEMPTION OF PROMOTIONAL PACKAGE \$1,425 BALANCE FORWARD 6,075 TO BE USED AT A LATER DATE. ORIGINAL PROMOTIONAL PACKAGE OF \$7,500 AS PER SCHEDULE PE 07Nov19 Note:	
---	--

EXTRAS AS PER OFFER

Walk-up Basement Worksheet Note:	
The Purchaser acknowledges that the Purchase Price is inclusive of all credits and promotional packages available at the time of purchase. Worksheet Note:	
(7,5) The Vendor agrees that notwithstanding any other term or provision in this Agreement included in the Purchase Price and in addition to those items detailed in Schedule GP to the Agreement of Purchase and Sale, the Purchaser is entitled to a credit Worksheet Note:	
LAUNDRY ON MAIN FLOOR AS PER ATTACHED SKETCH Worksheet Note:	

This Document is Extremely Time Sensitive - Printed 7 Nov 19 at 11:17

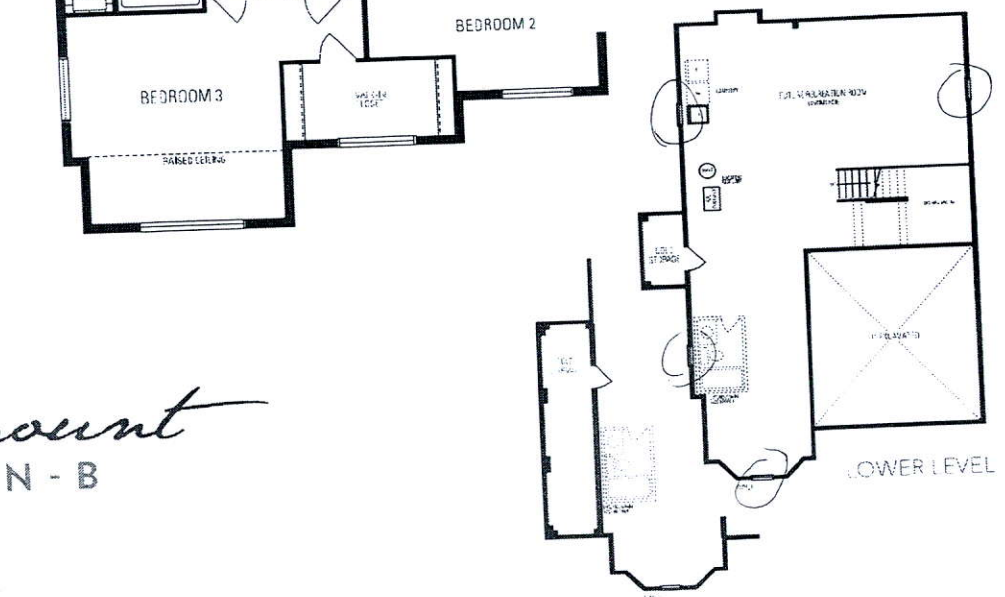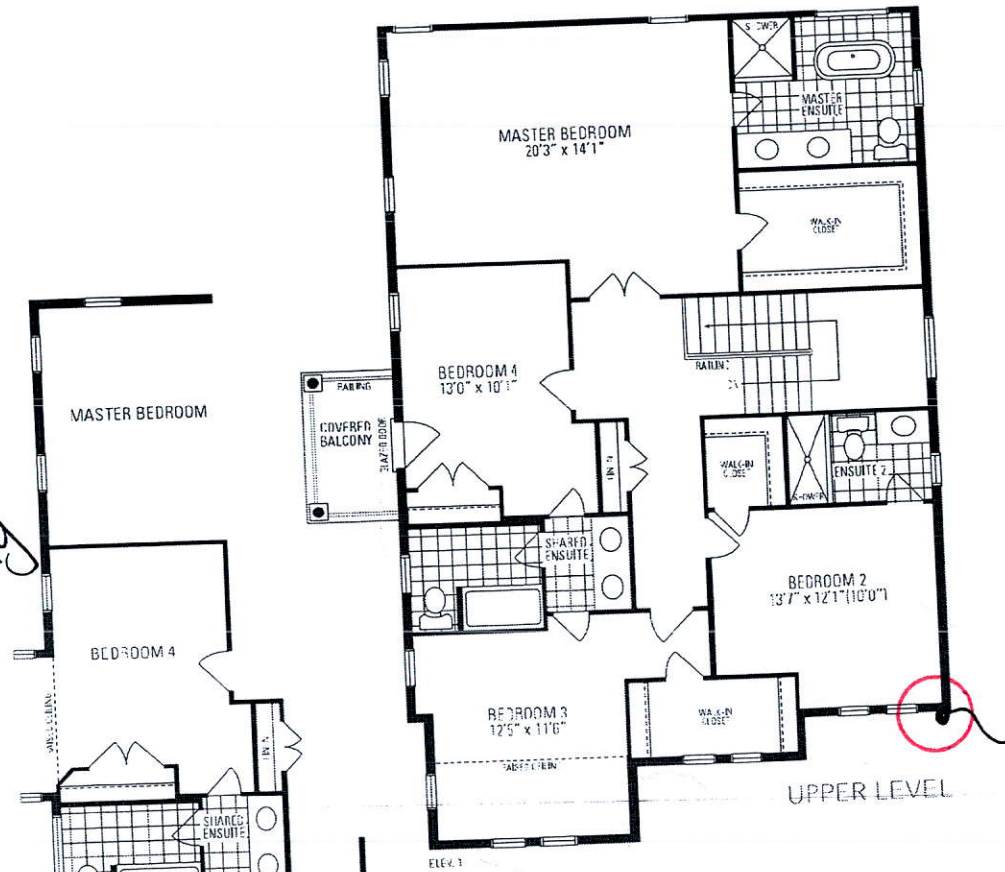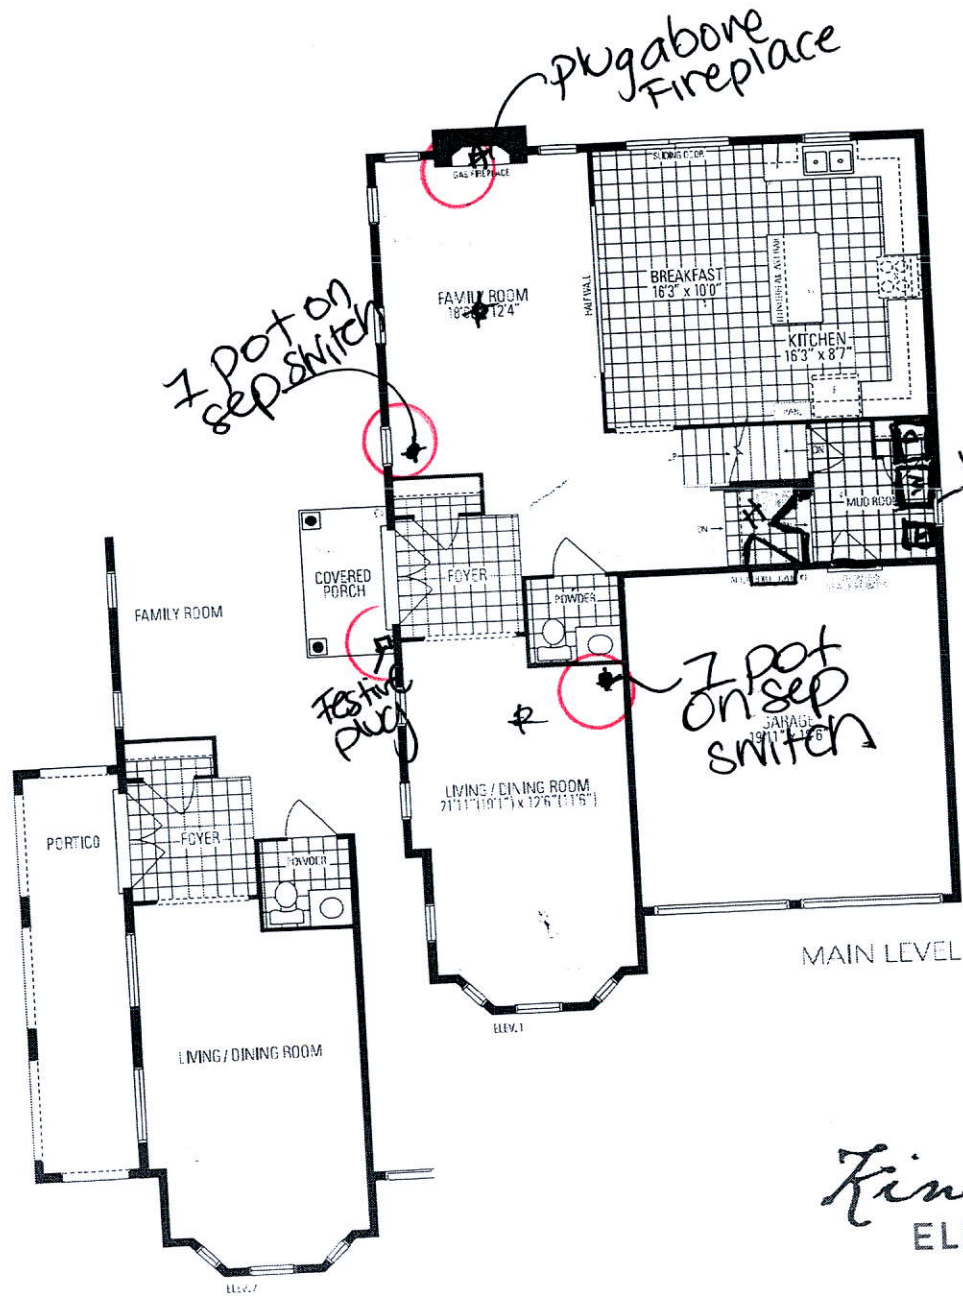

Kinmount
ELEVEN - B


1 exterior
pot light

LOT 45 & 49 LAMBERTS LANE PHASE 2

KINMOUNT 11B ELEVATION 1 & 2

REVISIONS:

1. REMOVE CLOSET IN MUD ROOM.
2. RELOCATE LAUNDRY FROM BASEMENT TO OLD MUD ROOM.
3. ADD DOOR TO NEW LAUNDRY ROOM.
4. ALTERNATE GARAGE ENTRY DOOR LOCATION REQUIRED DUE TO GRADING.

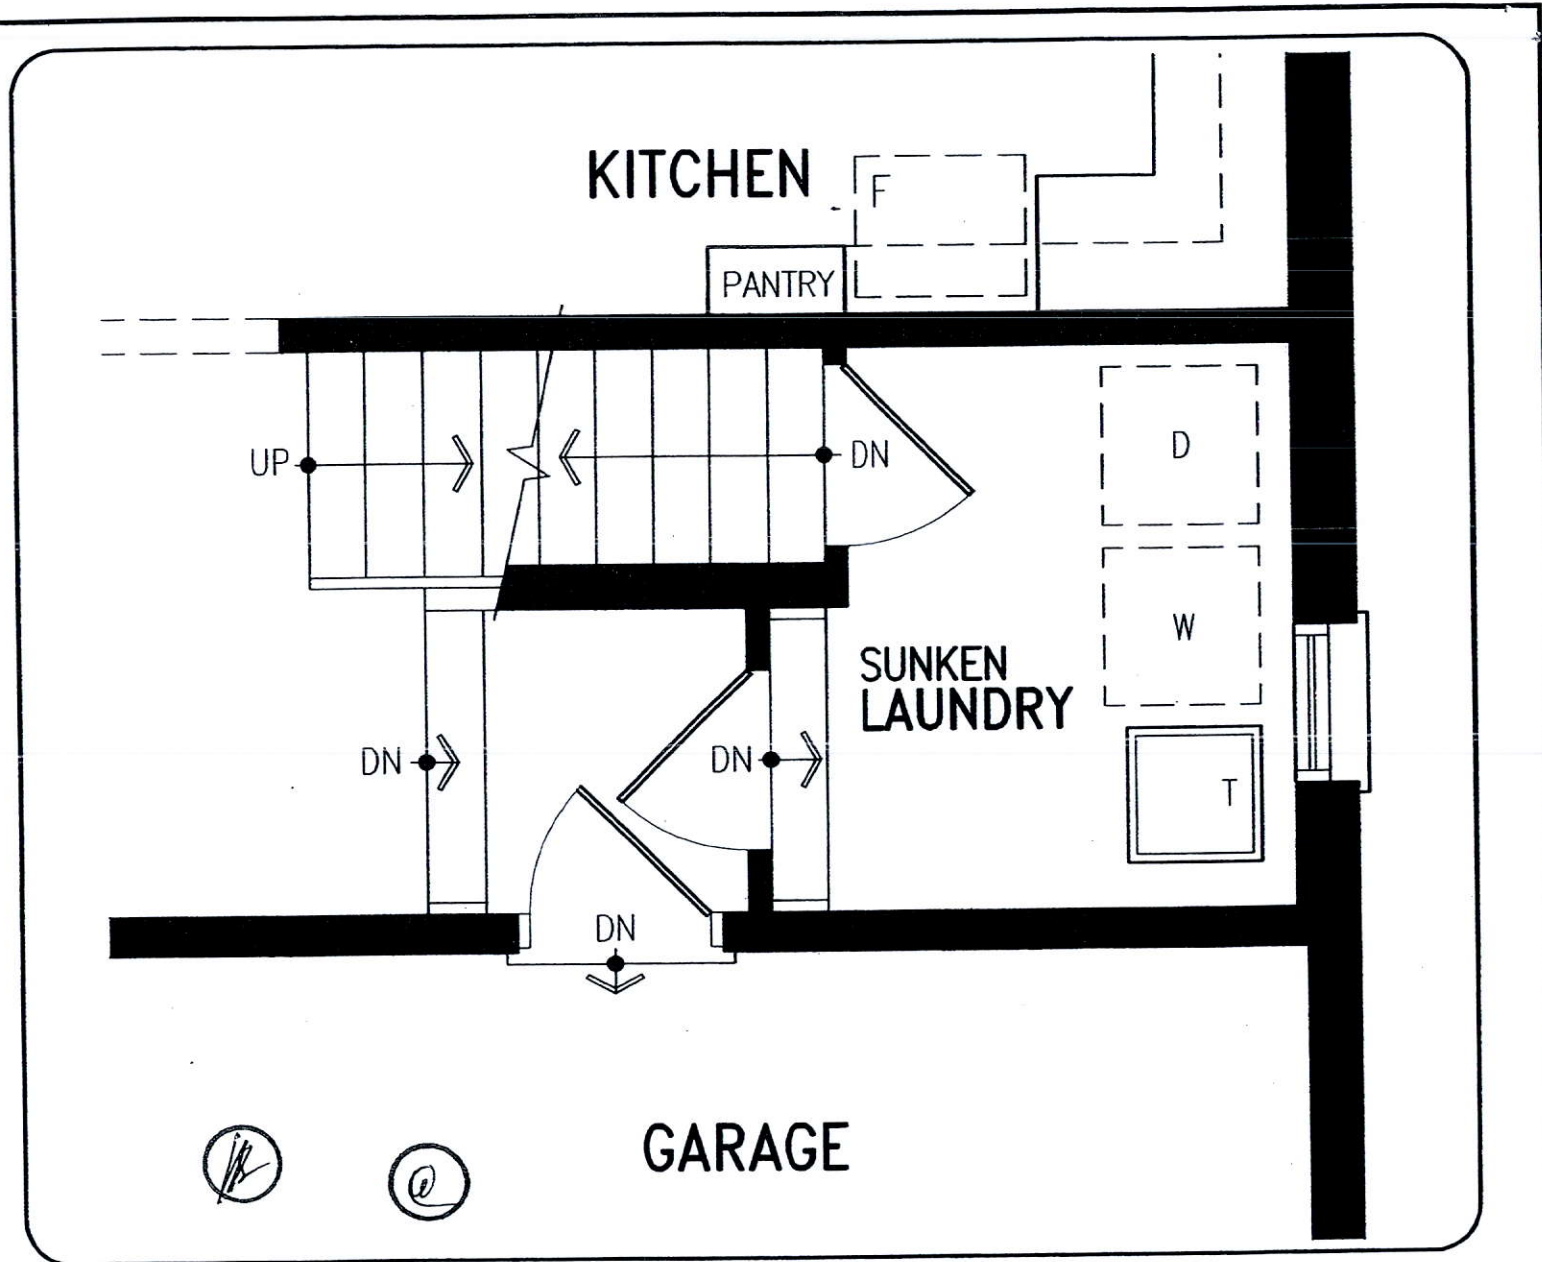

MAIN LEVEL

DISCLAIMERS: SKETCH NOT TO SCALE. DIMENSIONS, SPECIFICATIONS AND ARCHITECTURAL DETAILS SUBJECT TO MODIFICATION BY THE VENDOR. SKETCH IS ONLY FOR THE PURPOSE OF ILLUSTRATING REVISIONS REQUESTED BY THE PURCHASER AND ALL REVISIONS ARE SUBJECT TO VENDOR'S FINAL APPROVAL. ONLY REVISIONS ACCEPTED IN WRITING BY THE PURCHASER AND VENDOR ON A PURCHASER'S EXTRA SHEET WILL BE INCORPORATED INTO THE PLANS FILED WITH THE MUNICIPALITY. E. & O.E.

**REGION
DESIGN
INC.**

SCALE
BY
MB

N.T.S.
PAGE No.
1 OF 1



LOT 45

LAMBERTS LANE



PHASE 2

KINMOUNT 11B

ELEVATION 1

REVISIONS:

1. ADD EXTERIOR BASEMENT WALK-UP STAIRS.
2. PUSH FIREPLACE INTO FAMILY ROOM MAKING FLUSH WALL TO ACCOMMODATE WALK-UP DOOR IN BASEMENT.

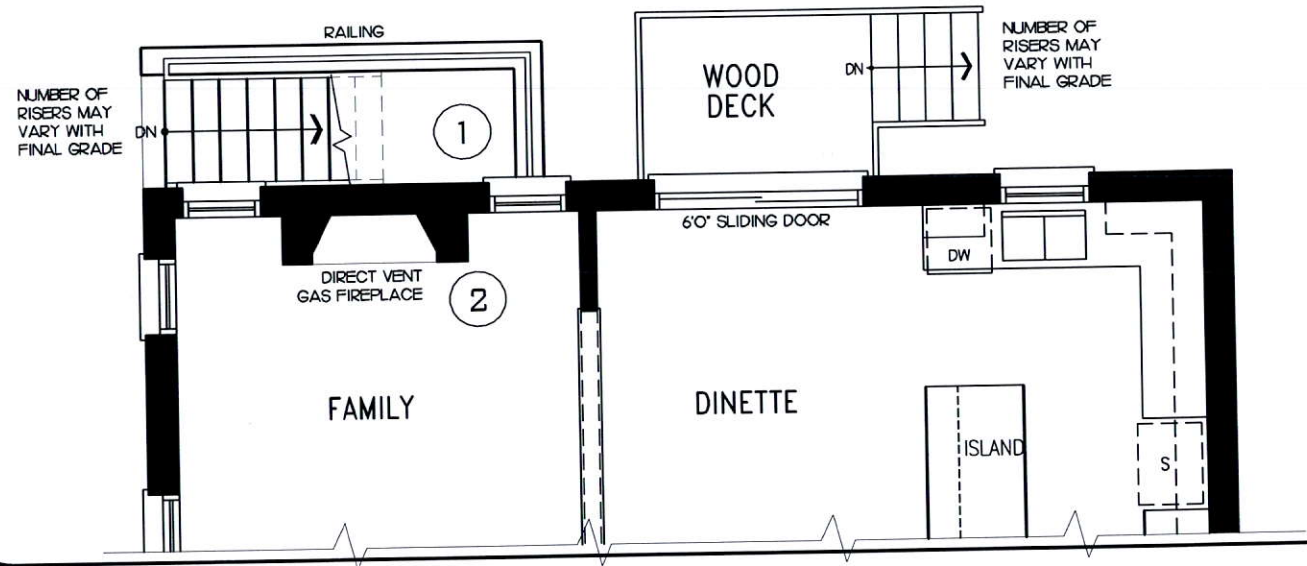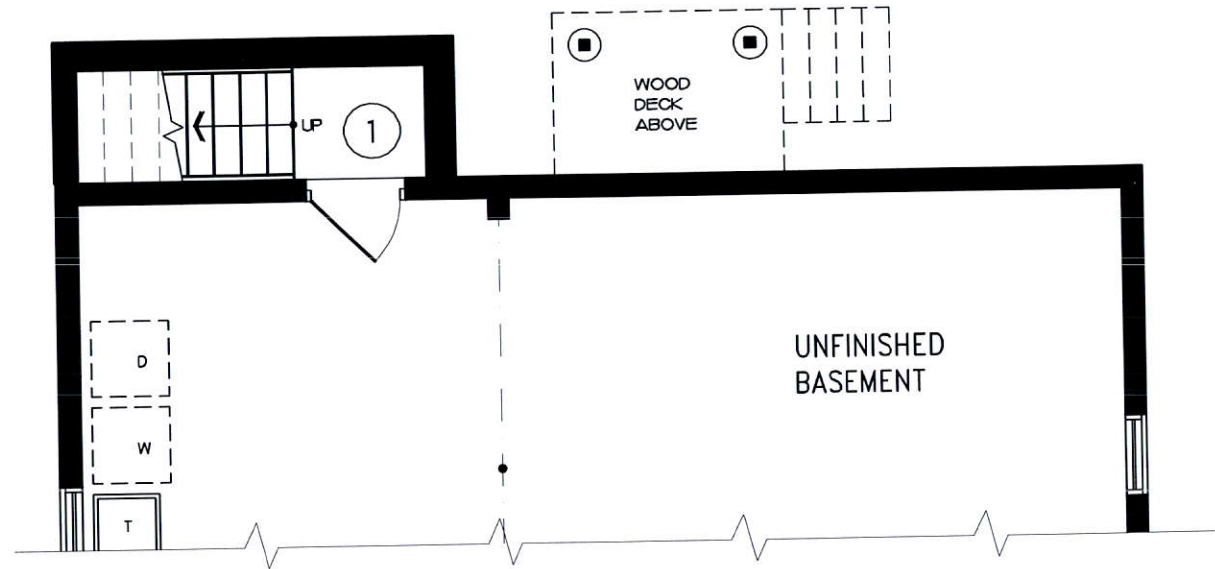

UPPER LEVEL

DISCLAIMERS: SKETCH NOT TO SCALE. DIMENSIONS, SPECIFICATIONS AND ARCHITECTURAL DETAILS SUBJECT TO MODIFICATION BY THE VENDOR. SKETCH IS ONLY FOR THE PURPOSE OF ILLUSTRATING REVISIONS REQUESTED BY THE PURCHASER AND ALL REVISIONS ARE SUBJECT TO VENDOR'S FINAL APPROVAL. ONLY REVISIONS ACCEPTED IN WRITING BY THE PURCHASER AND VENDOR ON A PURCHASER'S EXTRA SHEET WILL BE INCORPORATED INTO THE PLANS FILED WITH THE MUNICIPALITY. E. & O.E.

**REGION
DESIGN
INC.**

SCALE

N.T.S.

BY
MB

PAGE No.
1 OF 1

