

CONSTRUCTION SUMMARY

Lotus Pointe 2 (G) - Lamberts Lane Home Corp.

PURCHASERS: Mohan SINGH and Rovena GAFFAR

TEL:

| | | | | |
|-------------|-------------|------------------------------|--|--|
| LOT / PHASE | REG. PLAN # | HOUSE TYPE | | |
| 38 / 2 | 43M-2071 | Preston 11A Elev 1 4 Bedroom | | |

CONSTRUCTION

| | |
|--------------------------------------------------------------------------------------------------------------------|--|
| 1 - BASEMENT 8 FOOT 6 INCH CONCRETE POUR - MEASURED FROM TOP OF FOOTING TO TOP OF FOUNDATION WALL 15May19 Note: | |
| 1 - ADD BASEMENT WALK-UP 14May19 Note: | |

ELECTRICAL

| | |
|----------------------------------------------------------------------------------------|--|
| 1 - PLUG - ELECTRICAL PLUG WITH GFI AND SWITCH - FOR FESTIVE LIGHTING 07Nov19 Note: | |
| 1 - PLUG - ELECTRICAL PLUG - TO BE INSTALLED OVER FIREPLACE 07Nov19 Note: | |

PROMOTIONAL

| | |
|--------------------------------------------------------------------------------------------------------------------------------------------------------------------------------------------------------|--|
| 1 - PARTIAL REDEMPTION OF PROMOTIONAL PACKAGE \$405 BALANCE FORWARD \$4,595 TO BE USED AT A LATER DATE. ORIGINAL PROMOTIONAL PACKAGE OF \$5,000 AS PER SCHEDULE PE DATED 31.JUL.19 07Nov19 Note: | |
| 1 - LESS CREDIT FROM PURCHASER EXTRA SHEET IN OFFER 14May19 Note: | |




EXTRAS AS PER OFFER

| | |
|----------------------------------------------------------------------------------------------------------------------------------------------------------------------------------------------------------------------------------------------------------------------------------|--|
| The Purchaser acknowledges that the Purchase Price is inclusive of all credits and promotional packages available at the time of purchase. Worksheet Note: | |
| (7,5) The Vendor agrees that notwithstanding any other term or provision in this Agreement included in the Purchase Price and in addition to those items detailed in Schedule GP to the Agreement of Purchase and Sale, the Purchaser is entitled to a credit Worksheet Note: | |

This Document is Extremely Time Sensitive - Printed 7 Nov 19 at 15:41

PRESTON 11A - LOT 38

2,677 SQ.FT.

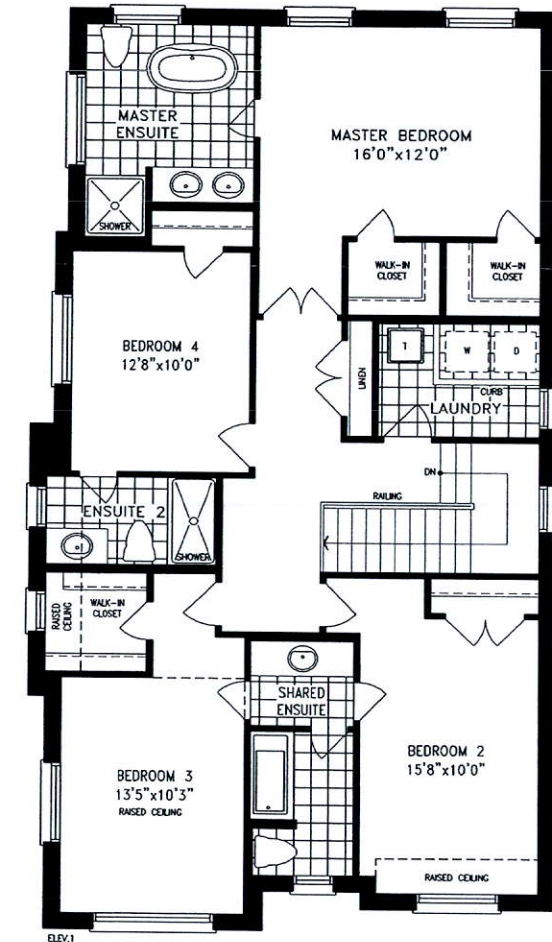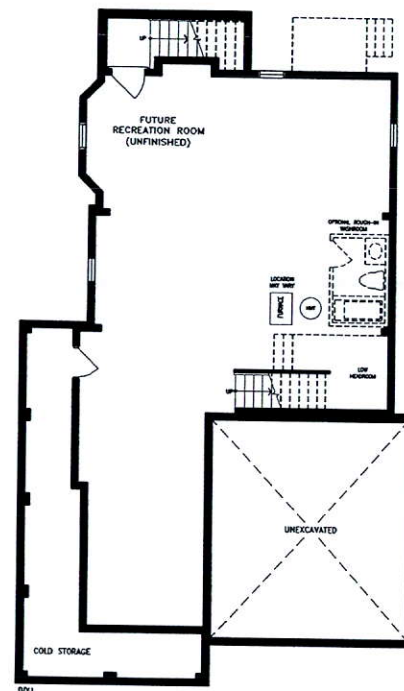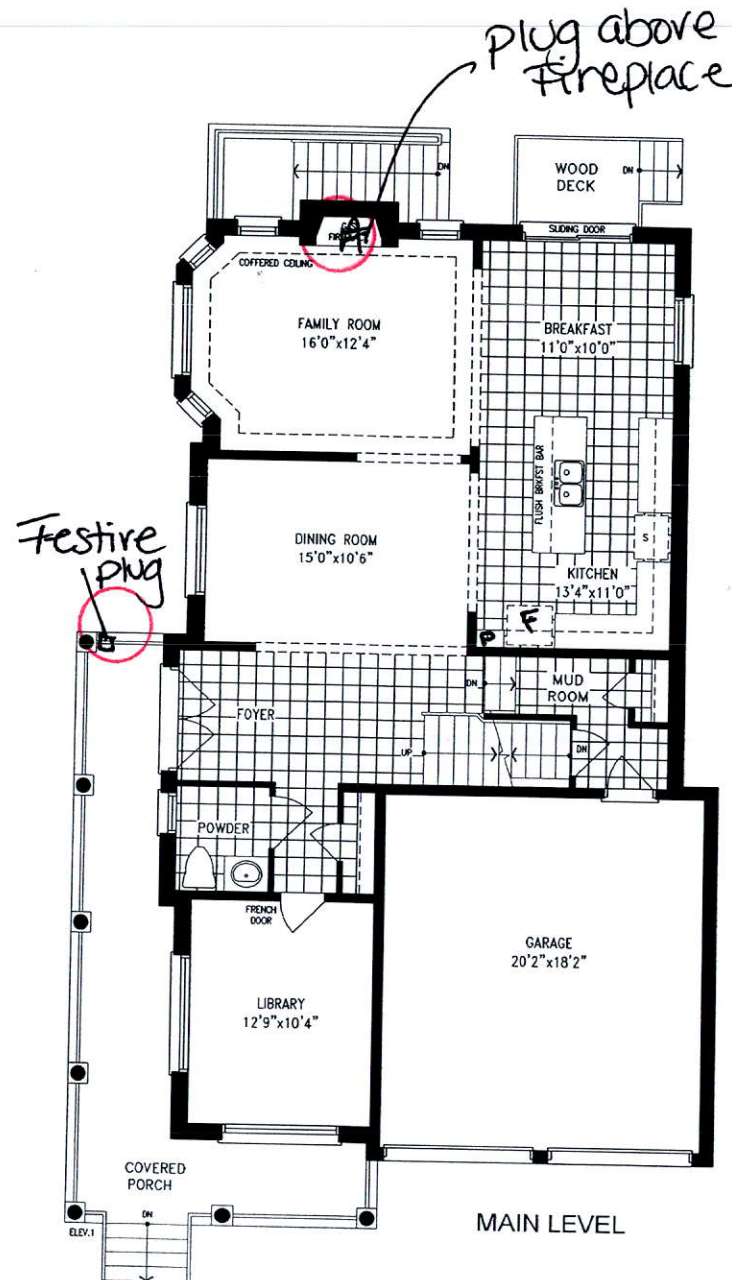

ORIENTATION OF HOME MAY BE REVERSED AND PURCHASER AGREES TO ACCEPT THE SAME. STEPS AND PORCHES MAY VARY AT ANY EXTERIOR ENTRANCE WAYS DUE TO GRADING VARIANCE. ACTUAL USABLE FLOOR SPACE MAY VARY FROM THE STATED FLOOR AREA. ALL RENDERINGS ARE ARTIST'S CONCEPT. DIMENSIONS, SPECIFICATIONS AND ARCHITECTURAL DETAILING SUBJECT TO MODIFICATIONS. E. & D.E. ROOFLINE AND ADJOINING MODEL TYPES MAY VARY DUE TO SITING. SEC - COPYRIGHT 06/12/19



ALL RENDERINGS ARE ARTIST'S CONCEPT