

CONSTRUCTION SUMMARY

Lotus Pointe 2 (G) - Lamberts Lane Home Corp.

PURCHASERS: PARAMDEEP SINGH and AMANDEEP KAUR SAINI

TEL: RES.: 647-705-1107

LOT / PHASE 28 / 2	REG. PLAN # 43M-2071	HOUSE TYPE Barton Three Elev 1		
-----------------------	-------------------------	-----------------------------------	--	--

ELECTRICAL

1 - STANDARD KITCHEN LIGHT TO BE CENTERED OVER ISLAND 11Nov19 Note:	
1 - PLUG - ELECTRICAL PLUG - TO BE INSTALLED OVER FIREPLACE 11Nov19 Note:	
1 - LIGHT AND SWITCH - NO FIXTURE INCLUDED - LIVING ROOM 11Nov19 Note:	




PROMOTIONAL

1 - PARTIAL REDEMPTION OF PROMOTIONAL PACKAGE \$375 BALANCE FORWARD \$7,125 TO BE USED AT A LATER DATE. ORIGINAL PROMOTIONAL PACKAGE OF \$7,500 AS PER SCHEDULE PE 11Nov19 Note:	
---	--

EXTRAS AS PER OFFER

(7,5) The Vendor agrees that notwithstanding any other term or provision in this Agreement included in the Purchase Price and in addition to those items detailed in Schedule GP to the Agreement of Purchase and Sale, the Purchaser is entitled to a credit Worksheet Note:	
The Purchaser acknowledges that the Purchase Price is inclusive of all credits and promotional packages available at the time of purchase. Worksheet Note:	

This Document is Extremely Time Sensitive - Printed 11 Nov 19 at 11:12

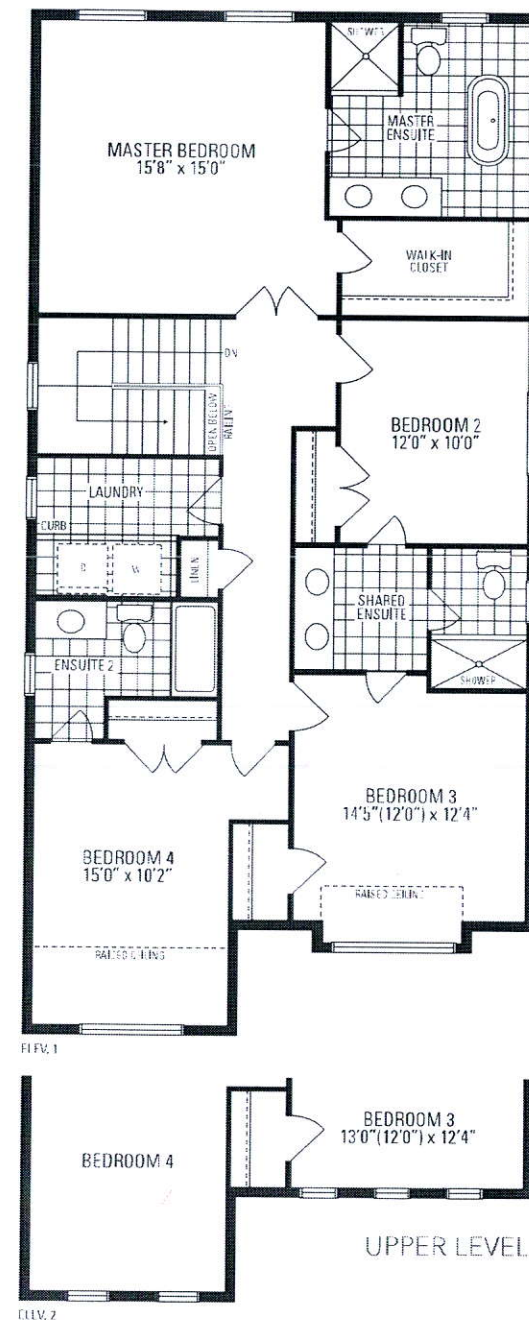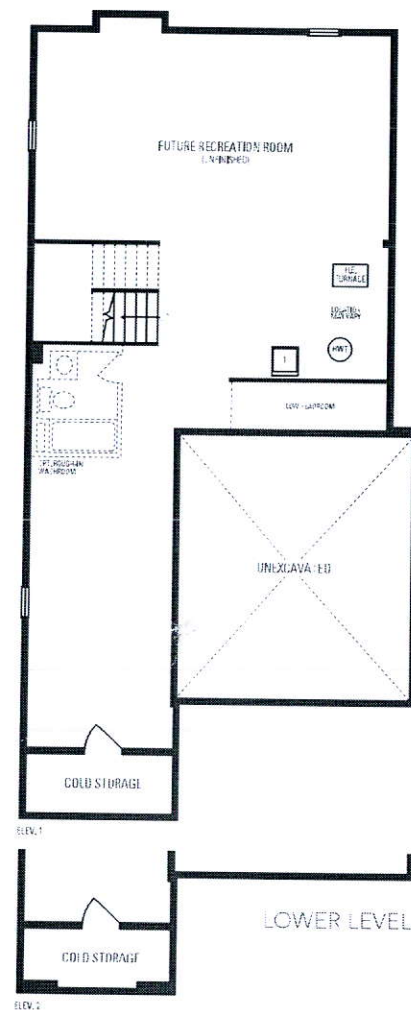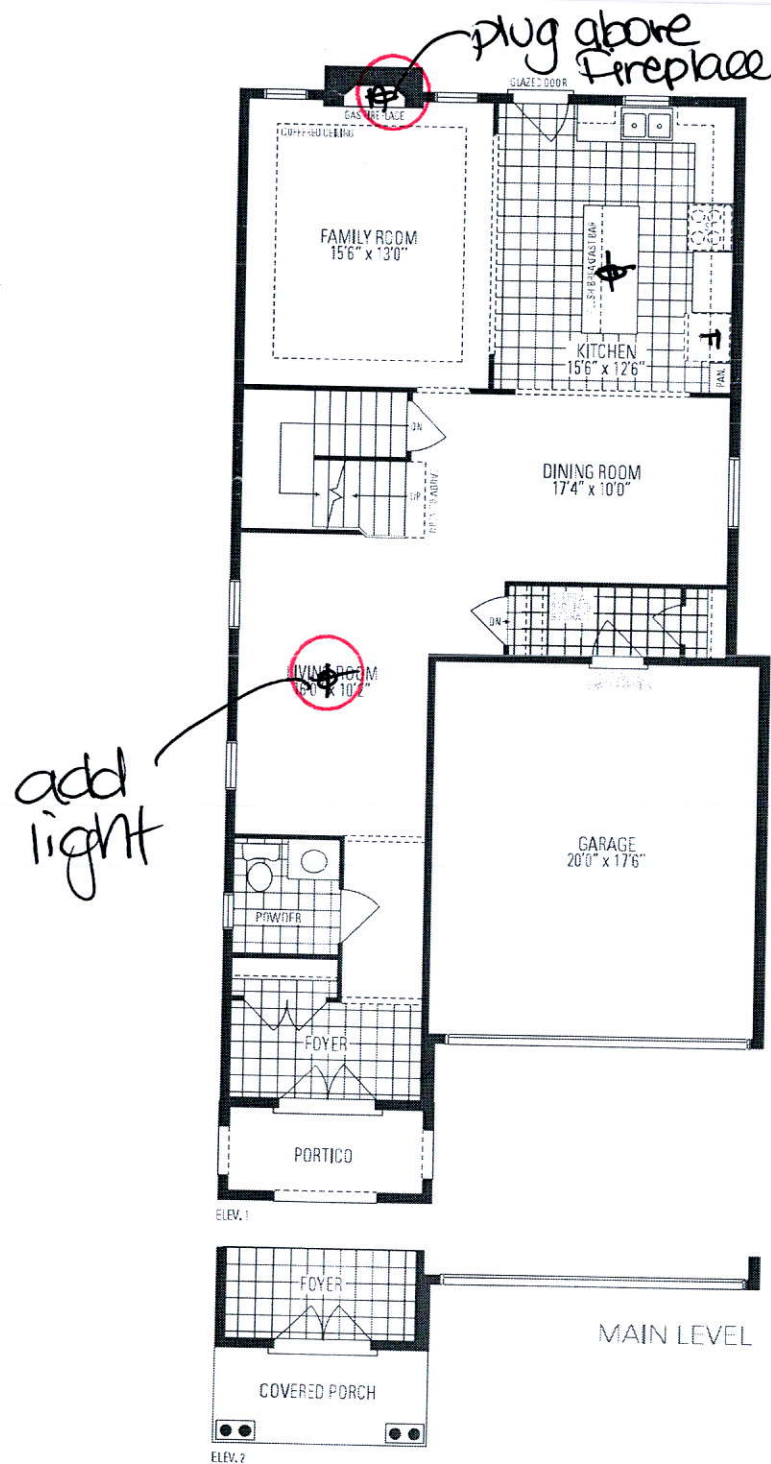

Barton
THREE
28