

CONSTRUCTION SUMMARY		RECEIVED NOV 12 2019
Lotus Pointe 2 (G) - Lamberts Lane Home Corp.		
PURCHASERS: Conganige Gayan Suranga Deshan ANTHONY and Warnakulasuriya FERNANDO		TEL: RES.: 647-821-9457

LOT / PHASE	REG. PLAN #	HOUSE TYPE		
75 / 2	43M-2071	Barton Four Elev 2		

ELECTRICAL

1 - FAMILY ROOM -----PLUG - ELECTRICAL PLUG - TO BE INSTALLED OVER FIREPLACE	
11Nov19 Note:	

MIRRORS AND GLASS

1 - IN MASTER ENSUITE-----FRAMELESS GLASS SHOWER ENCLOSURE	
11Nov19 Note:	

PLUMBING

3 - TOE TESTER - ADD TOE TESTER TO SHOWER	
11Nov19 Note:	
1 - ADD IN MAIN BATH-----5 FOOT SHOWER WITH SLIDING GLASS CHROME DOORS IN LIEU OF TUB	
11Nov19 Note:	


PROMOTIONAL

1 - LESS CREDIT FROM PURCHASER EXTRA SHEET IN OFFER	
11Nov19 Note: PROMO \$7,500 LESS \$5425 NEW PROMO BALANCE \$2075.00	


EXTRAS AS PER OFFER

(7,5) The Vendor agrees that notwithstanding any other term or provision in this Agreement included in the Purchase Price and in addition to those items detailed in Schedule GP to the Agreement of Purchase and Sale, the Purchaser is entitled to a credit	
Worksheet Note:	
The Purchaser acknowledges that the Purchase Price is inclusive of all credits and promotional packages available at the time of purchase.	
Worksheet Note:	

This Document is Extremely Time Sensitive - Printed 11 Nov 19 at 13:11

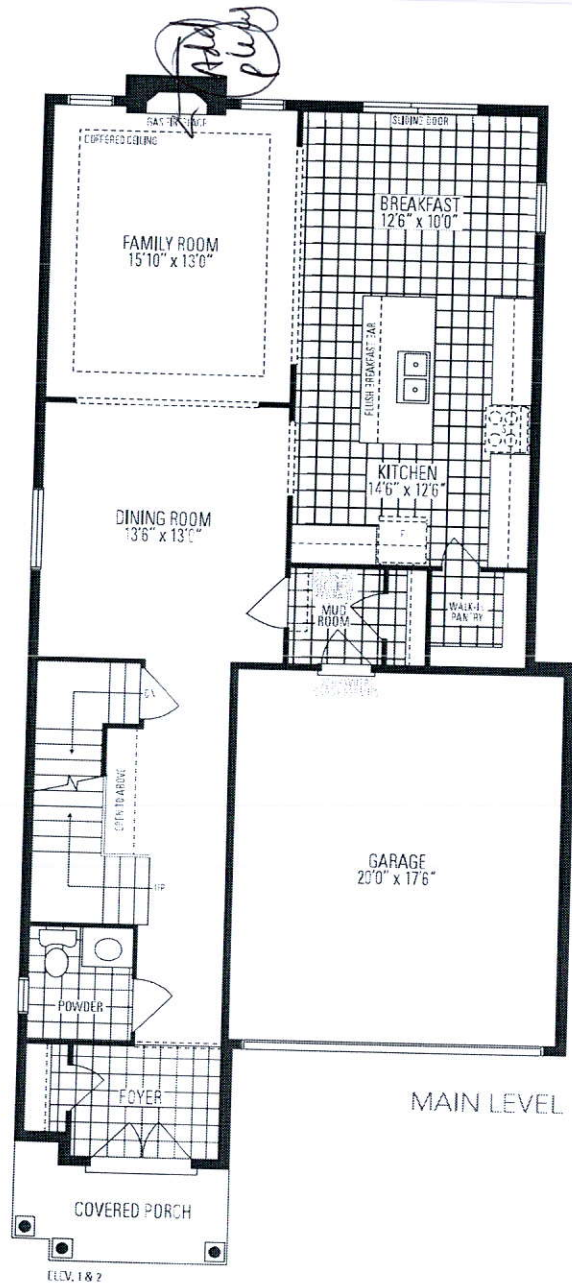


MAIN LEVEL

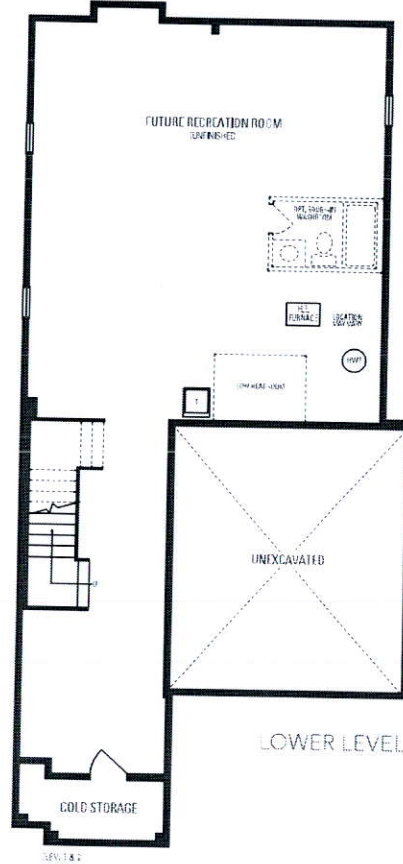

LOWER LEVEL

# *Barton* FOUR INCLUDES 12 SQ. FT. OF OPEN AREA

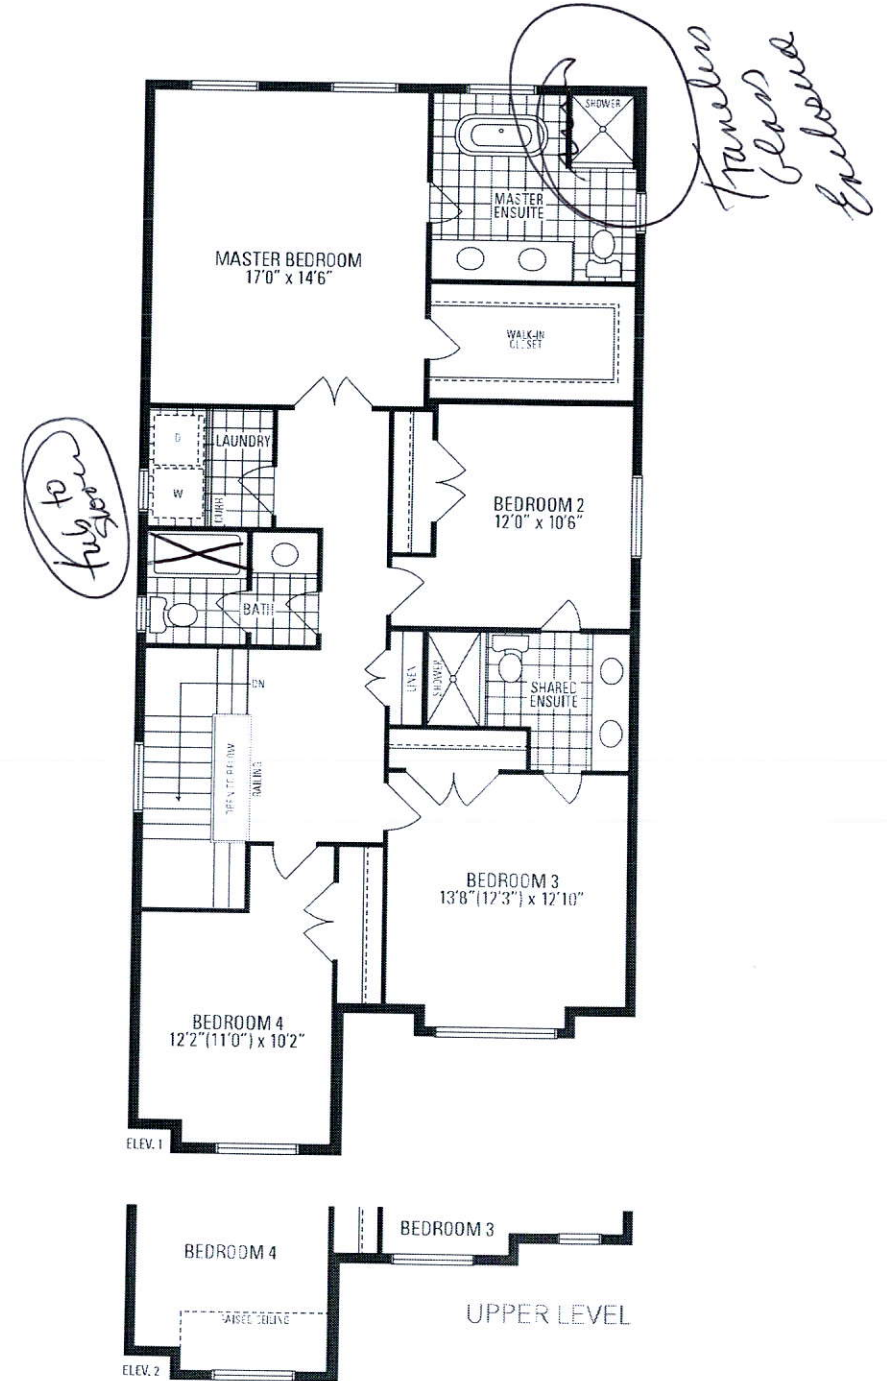

UPPER LEVEL