

Preliminary

CONSTRUCTION SUMMARY
Lotus Pointe 2 (G) - Lamberts Lane Home Corp.

RECEIVED NOV 28 2019

PURCHASER: Gurcharan Singh BRAR

TEL: RES.: 416-315-3384

LOT / PHASE 78 / 2	REG. PLAN # 43M-2071	HOUSE TYPE Barton Three Elev 2		
-----------------------	-------------------------	-----------------------------------	--	--

ELECTRICAL

1 - PLUG - ELECTRICAL PLUG - TO BE INSTALLED OVER FIREPLACE 27Nov19 Note:	
1 - LIGHT AND SWITCH - NO FIXTURE INCLUDED - LIVING ROOM 27Nov19 Note:	




PROMOTIONAL

1 - PARTIAL REDEMPTION OF PROMOTIONAL PACKAGE \$375 BALANCE FORWARD \$7,125 TO BE USED AT A LATER DATE. ORIGINAL PROMOTIONAL PACKAGE OF \$7500 AS PER SCHEDULE PE DATED MMMDDYYYY. 27Nov19 Note:	
---	--

EXTRAS AS PER OFFER

The Purchaser acknowledges that the Purchase Price is inclusive of all credits and promotional packages available at the time of purchase. Worksheet Note:	
(7,5) The Vendor agrees that notwithstanding any other term or provision in this Agreement included in the Purchase Price and in addition to those items detailed in Schedule GP to the Agreement of Purchase and Sale, the Purchaser is entitled to a credit Worksheet Note:	

This Document is Extremely Time Sensitive - Printed 27 Nov 19 at 15:02

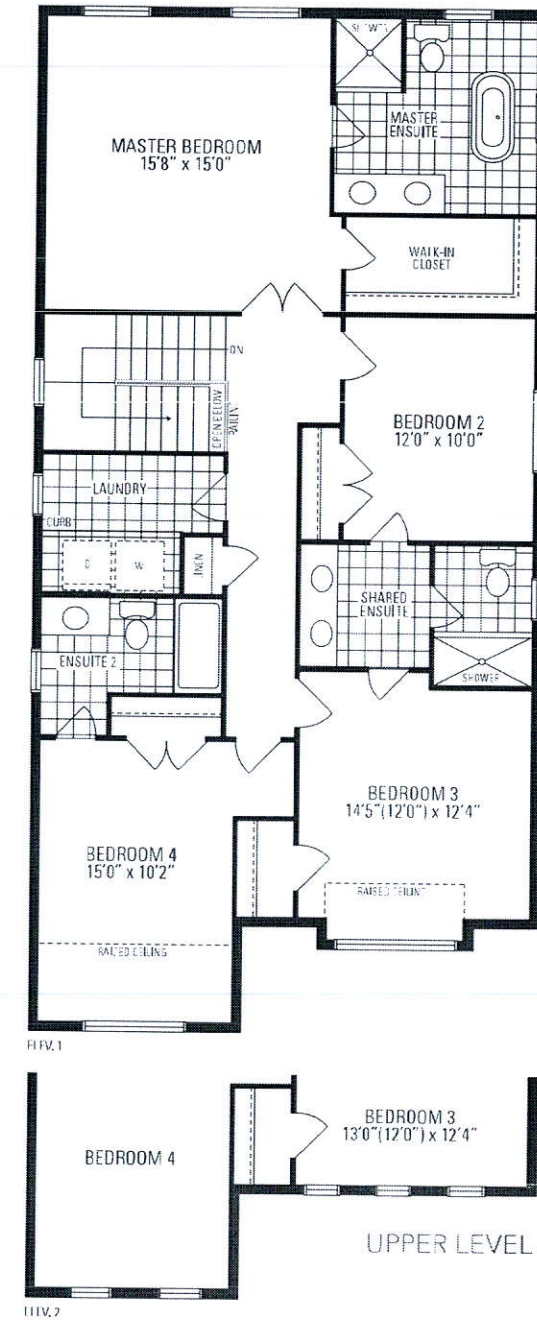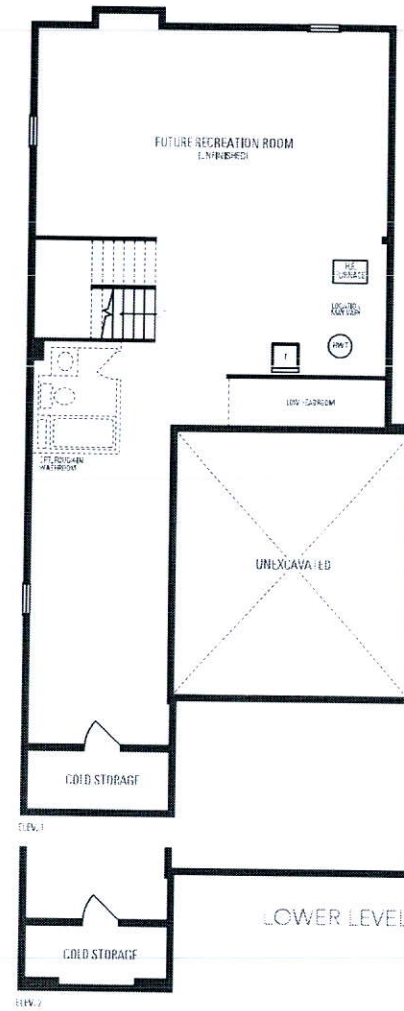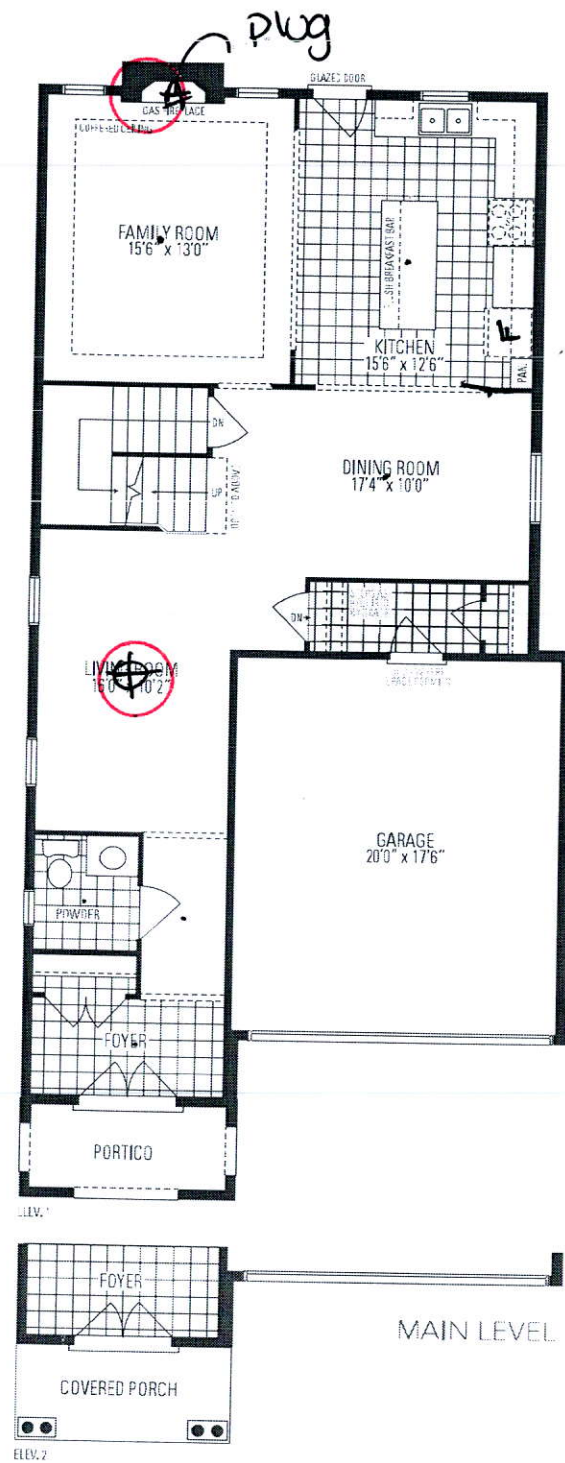

Barton
THREE

78