

JAN 24 2020

CONSTRUCTION SUMMARY

Lotus Pointe 2 (G) - Lamberts Lane Home Corp.

PURCHASER: Kulwant Singh BHULLAR

TEL:

LOT / PHASE	REG. PLAN #	HOUSE TYPE		
71 / 2	43M-2071	Preston Three Elev 1 4 Bedroom		

ELECTRICAL

1 - RELOCATE STANDARD KITCHEN LIGHT TO BE CENTERED OVER ISLAND 23Jan20 Note:	
1 - PLUG - ELECTRICAL PLUG - TO BE INSTALLED OVER FIREPLACE 23Jan20 Note:	
1 - PLUG - ELECTRICAL PLUG WITH GFI AND SWITCH - FOR FESTIVE LIGHTING 23Jan20 Note:	

PLUMBING

1 - MASTER ENSUITE- SHOWER UPGRADE-ZURA DFKIT19 23Jan20 Note:	
--	--

PROMOTIONAL

1 - PARTIAL REDEMPTION OF PROMOTIONAL PACKAGE \$2,460 BALANCE FORWARD \$5,040 TO BE USED AT A LATER DATE. ORIGINAL PROMOTIONAL PACKAGE OF \$7,500 AS PER SCHEDULE PE 23Jan20 Note:	
--	--

EXTRAS AS PER OFFER

The Purchaser acknowledges that the Purchase Price is inclusive of all credits and promotional packages available at the time of purchase. Worksheet Note:	
(7,5) The Vendor agrees that notwithstanding any other term or provision in this Agreement included in the Purchase Price and in addition to those items detailed in Schedule GP to the Agreement of Purchase and Sale, the Purchaser is entitled to a credit. Worksheet Note:	

This Document is Extremely Time Sensitive - Printed 23 Jan 20 at 11:08




*Delta Contemporary Square 14 Series Pressure Balance Kit
Integrated Diverter Valve
Includes both ceiling mount & wall mount shower arm*

Model DF-KIT19

Model DF-KIT19-WS (With Stops)

DELTA
see what Delta can do™

2.0 GPM

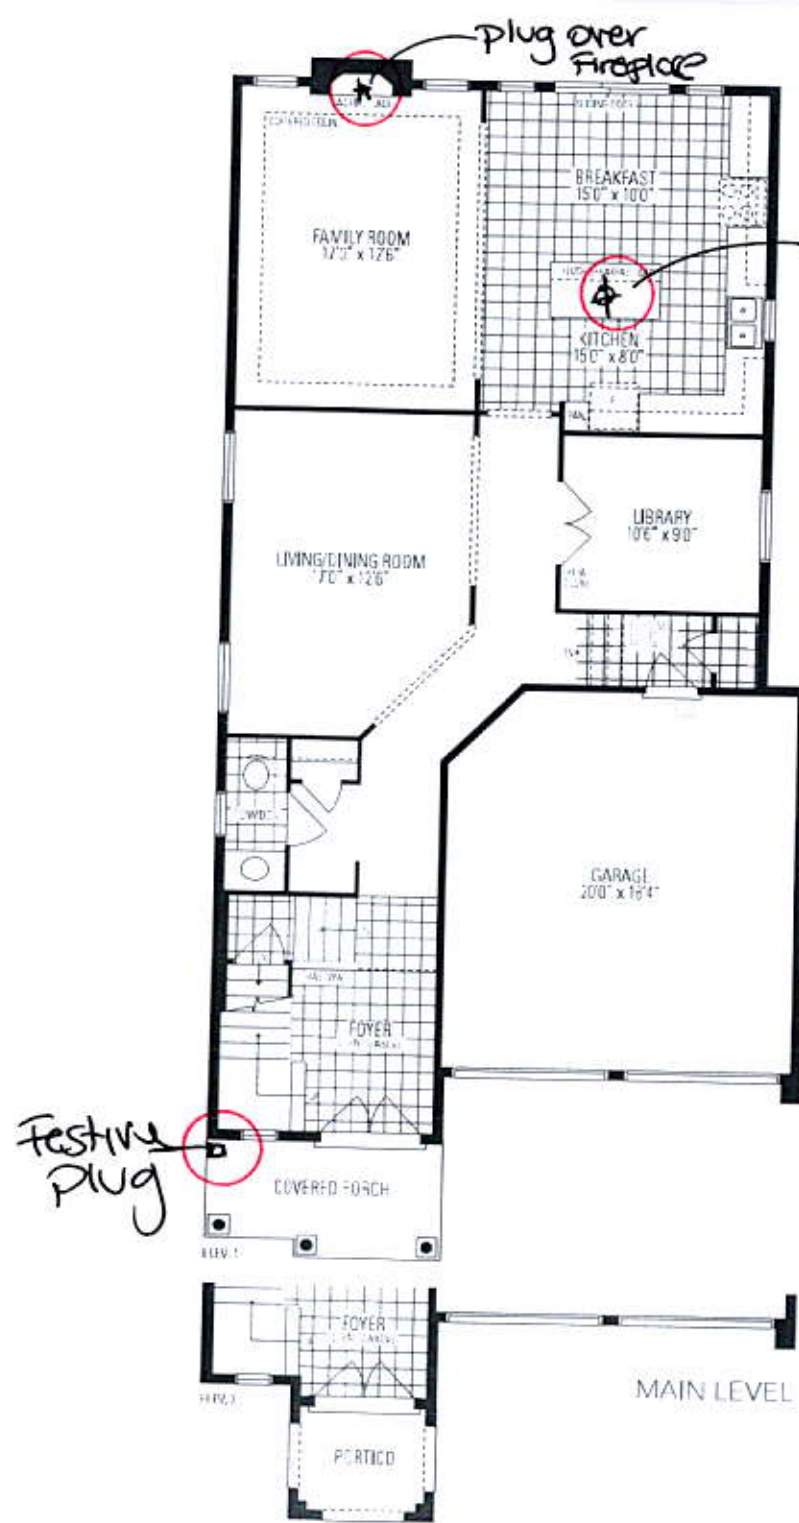

Preston
THREE
INCLUDES 63 SQ. FT. OF OPEN AREA

