

CONSTRUCTION SUMMARY

Lotus Pointe 2 (G) - Lamberts Lane Home Corp.

DATE:

TEL:

PURCHASER: Gagandeep Kaur SANDHU

LOT / PHASE Block 83 Unit 1 / 2	REG. PLAN # 43M-2071	HOUSE TYPE Urban One Elev 2		
------------------------------------	-------------------------	--------------------------------	--	--

CABINETRY

1 - KITCHEN - DELETE CABINETS ABOVE STOVE - VENDOR WILL SUPPLY 6 INCH VENT AS PER CONSTRUCTION SPECIFICATIONS AND VENT MAY NOT BE IN THE APPROPRIATE LOCATION FOR INSTALLATION OF PURCHASER SUPPLIED VENT - PURCHASER TO SUPPLY OWN FAN AFTER CLOSING (TEMP. FAN MA 10Sep19 Note:	
--	--

CABINETRY ACCESSORIES

1 - KITCHEN CABINETRY UPPER - ANGLED CORNER CABINET - FITS TALL UPPER CABINETS - PER UNIT - STANDARD 10Sep19 Note:	
1 - KITCHEN CABINETRY BASE - PIE CUT CORNER CABINET - BASE CABINETRY - STANDARD 10Sep19 Note:	
1 - KITCHEN CABINETRY UPPER - FULL DEPTH ABOVE FRIDGE - WITH GABLES - 600MM - PRICE IS EACH - STANDARD 10Sep19 Note:	

CERAMIC TILE

1 - TILE - UPGRADE 1 FLOOR TILE - - ENSUITE BATHROOM - FLOOR 10Sep19 Note:	
1 - TILE - UPGRADE 1 FLOOR TILE - - FOYER 10Sep19 Note:	
1 - TILE - UPGRADE 1 FLOOR TILE - - POWDER ROOM 10Sep19 Note:	
1 - TILE - UPGRADE 1 FLOOR TILE - - KITCHEN 10Sep19 Note:	

ELECTRICAL

2 - PLUG - ELECTRICAL PLUG- 5FT FROM FLOOR IN FAMILY ROOM AND DEN SEE SKETCH 10Sep19 Note:	
---	--

PROMOTIONAL

1 - LESS BALANCE OF CREDIT FROM PURCHASER EXTRA SHEET IN OFFER 10Sep19 Note:	
---	--

EXTRAS AS PER OFFER

Complete Central Air Conditioning Supplied and installed Worksheet Note:	
(5) The Vendor agrees that notwithstanding any other term or provision in this Agreement included in the Purchase Price and in addition to those items detailed in Schedule GP to the Agreement of Purchase and Sale, the Purchaser is entitled to a credit of Worksheet Note:	
Five (5) White Appliances as per PE Appliances Worksheet Note:	
The Purchaser acknowledges that the Purchase Price is inclusive of all credits and promotional packages available at the time of purchase. Worksheet Note:	

This Document is Extremely Time Sensitive - Printed 10 Sep 19 at 14:56

RECEIVED SEP 11 2019

Purchaser:Gagandeep Kaur SANDHU

Telephone Res. / Bus: /

Decor Advisor:Natalie Mancuso

Lock Date:10-Sep-19

Layout Changes:☐ Yes ☒ No

Property: Block 83 Unit 1

Project: Lamberts Lane Home Corp.

Model and Elevation: Urban One Elev 2

10-Sep-19

Plan #: 43M-2071

Sketch Attached:☒ Yes ☐ No

Exterior Colour Scheme:

1. Cabinetry

	Style and Colour	Hardware
Kitchen / Breakfast	CONTINENTAL 814 DARK CHOCOLATE	431SA
Laundry Room	N/A	N/A
Powder Room	CONTINENTAL 814 DARK CHOCOLATE	431SA
Master Ensuite Bathroom	EVEREST WHITE	431SA
Main Bathroom	EVEREST WHITE	431SA

Appliances:

Dishwasher Cabinet

Stove Opening

Fridge Opening

Built In Appliances ☐ Yes ☒ No

Closed ☒ Open

41" Upper Cabinets ☒ Yes ☐ No

Slide In Stove ☐ Yes ☒ No

Please NOTE: Standard Cabinet Height is 30"

NOTE: If not specified, opening will be set to builder's standard opening of approximately 30" width

NOTE: If not specified, opening will be set to builder's standard opening of approximately 37" width x 74" height

\*\* Refer to Construction Summary

2. Counters

	Counter	Edge
Kitchen / Breakfast	LAMINATE-CARRARA BIANCO 6696-46	
Laundry Room	N/A	
Powder Room	LAMINATE-CARRARA BIANCO 6696-46	
Master Ensuite Bathroom	LAMINATE-CALCUTTA MARBLE 4925K-07	
Main Bathroom	LAMINATE-CALCUTTA MARBLE 4925K-07	

\*\* Refer to Construction Summary

Initial: 



Purchaser:	Gagandeep Kaur SANDHU	Property:	Block 83 Unit 1
Telephone Res. / Bus:	/	Project:	Lamberts Lane Home Corp.
Decor Advisor:	Anne Federico	Model and Elevation:	Urban One Elev 2
Lock Date:	27-Jan-20	10-Sep-19	Plan #: 43M-2071

3. Ceramic Flooring

Entrance Vestibule	TILE- EE0028 LUXOR GRIGIO 18X18	<div>At a 45 Threshold-If App.</div> <div><input type="checkbox"/> Metal Strip Where Applic.</div>
Main Hall	CARPET	<input type="checkbox"/>
Kitchen / Breakfast	TILE- EE0028 LUXOR GRIGIO 18X18	<input type="checkbox"/>
Laundry Room	TILE- RAINBOW WHITE 13X13	<input type="checkbox"/>
Powder Room	TILE- EE0028 LUXOR GRIGIO 18X18	<input type="checkbox"/>
Master Ensuite Bathroom	TILE- FM45GL001S GLOSSY WHITE 18X18	<input type="checkbox"/>
Main Bathroom	TILE- RAINBOW WHITE 13X13	<input type="checkbox"/>
GARAGE ENTRANCE	TILE-RAINBOW WHITE 13X13	<input type="checkbox"/>
		<input type="checkbox"/>
		<input type="checkbox"/>
		<input type="checkbox"/>

JAN 27 2020

\*\* Refer to Construction Summary

4. Ceramic Wall Tile

Master Ensuite Bathroom	Selection	Describe
Tub Deck Wall		
Tub Deck		
Tub Deck Skirt		
Shower Stall	TILE- NATURALE GRIGIO 8X10	
Bathtub Enclosure Walls		
Main Bathroom	TILE- NATURALE GRIGIO 8X10	
GARAGE ENTRANCE		

Kitchen Backsplash

\*\* Refer to Construction Summary - STANDARD GROUT THROUGHOUT UNLESS SPECIFIED

5. Plumbing Fixtures

All Bathrooms	White	Whirlpool	<div><input type="radio"/> Yes <input checked="" type="radio"/> No</div>

Dishwasher Rough-In ☒ Yes ☐ No  
Waterline for Fridge ☒ Yes ☐ No

\*\* Refer to Construction Summary

6. Trim Carpentry

Interior Doors	As Per Construction Specifications
Interior Trim	As Per Construction Specifications
Door Handles	As Per Construction Specifications
Exterior Front Door Handle	As Per Construction Specifications

\*\* Refer to Construction Summary

Purchaser:

Gagandeep Kaur SANDHU

Telephone Res. / Bus:

/

Decor Advisor:

Natalie Mancuso

Lock Date:

10-Sep-19

Property:

Block 83 Unit 1

Project:

Lamberts Lane Home Corp.

Model and Elevation:

Urban One Elev 2

Plan #:

43M-2071

10-Sep-19

10-Sep-19

7. Other Flooring	
Main Hall	CARPET- EE9954 CABANA BAY SOLID- #00520 ICE
Living Room	CARPET- EE9954 CABANA BAY SOLID- #00520 ICE
Dining Room	CARPET- EE9954 CABANA BAY SOLID- #00520 ICE
Family Room	CARPET- EE9954 CABANA BAY SOLID- #00520 ICE
Den / Library / Study	CARPET- EE9954 CABANA BAY SOLID- #00520 ICE
Basement Landing(If Applies)	
Lower Landing (If Applies)	NATURAL LAMNATE
Upper Landing	NATURAL LAMNATE
Upper Hall	CARPET- EE9954 CABANA BAY SOLID- #00520 ICE
Master Bedroom	CARPET- EE9954 CABANA BAY SOLID- #00520 ICE
Bedroom #2	CARPET- EE9954 CABANA BAY SOLID- #00520 ICE
Bedroom #3	CARPET- EE9954 CABANA BAY SOLID- #00520 ICE
Bedroom #4	
Bedroom #5	
STORAGE	CARPET- EE9954 CABANA BAY SOLID- #00520 ICE

Underpad	Type	Area
----------	------	------

\*\* Refer to Construction Summary

8. Railings and Pickets

Railing Type	AS PER CONSTRUCTION SPECIFICATIONS	Colour	NATURAL
Picket Type	AS PER CONSTRUCTION SPECIFICATIONS	Colour	NATURAL
Stringer / Riser	AS PER CONSTRUCTION SPECIFICATIO	Colour	NATURAL
Treads	AS PER CONSTRUCTION SPECIFICATIO	Colour	NATURAL
Red Oak Stairs with Semi Gloss Finish			<input checked="" type="radio"/> Yes <input type="radio"/> No

\*\* Refer to Construction Summary

9. Wall Paint Flat Finish

Main & Upper Hall	22 WARM GREY	Master Bedroom	22 WARM GREY
Living Room	22 WARM GREY	Bedroom #2	22 WARM GREY
Dining Room	22 WARM GREY	Bedroom #3	22 WARM GREY
Kitchen / Breakfast	22 WARM GREY	Bedroom #4	
Family Room	22 WARM GREY	Bedroom #5	
Powder Room	22 WARM GREY	Master Ensuite	22 WARM GREY
Laundry Room	22 WARM GREY	Main Bathroom	22 WARM GREY
Den/Library	22 WARM GREY	STORAGE	22 WARM GREY
Trim Paint-Semi Gloss	BIRCH WHITE		

Smooth Ceilings First Floor ☒ Yes ☐ No

\*\* Refer to Construction Summary



Purchaser: Gagandeep Kaur SANDHU

Property: Block 83 Unit 1

Telephone Res. / Bus: /

Project: Lamberts Lane Home Corp.

Decor Advisor: Natalie Mancuso

Model and Elevation: Urban One Elev 2

Lock Date: 10-Sep-19

10-Sep-19

Plan #: 43M-2071

### 10. Plaster Mouldings and Medallions

Entrance Vestibule

Main Hall

Living Room

Dining Room

Family Room

Kitchen/Breakfast

Den/Library

Lower Landing

\*\* Refer to Construction Summary

### 11. Fireplace

Living Room

Purchased

As Per Plan

N/A

Family Room

Purchased

As Per Plan

N/A

Other Room - Specify

Purchased

As Per Plan

N/A

Fireplace Type

Mantle Type

Colour / Stain

Surround

Hearth

\*\* Refer to Construction Summary

### 12. Heating and Air Conditioning

Air Conditioning

~~NO~~ YES

Gas Provisions Dryer

NO

Gas Provisions Stove

NO

Gas Provisions Barbecue

NO

Comment

\*\* Refer to Construction Summary

### 13. Electrical

Plugs and Switches

☒ White

DECOR

Above Kitchen Cabinet Light

☐ Yes ☒ No

Hood Fan

STANDARD WHITE

Below Kitchen Cabinet Light

☐ Yes ☒ No

Appliances

Built in Cooktop

Built in Oven

Gas Stove

Microwave

Yes

☒ No

Yes

☒ No

Yes

☒ No

Yes

☒ No

Dishwasher Rough-in

Yes

\*\* Refer to Construction Summary

### 14. General Comments

\*\* Refer to Construction Summary

### Disclaimers and Notes


- Colours of all materials are as close as possible to builder's selection, but not necessarily identical due to variances in manufacturing.
- Any extras listed above are null and void unless accompanied by a separate invoice/amendment. Said invoice must be paid in full.
- The Purchaser agrees that this colour selection is final and that no changes will be permitted, unless required by the Vendor.
- The Purchaser acknowledges reading and accepting document which contains other miscellaneous disclaimers.

Signature

*[Signature]*

Date

*SEP/16/19*

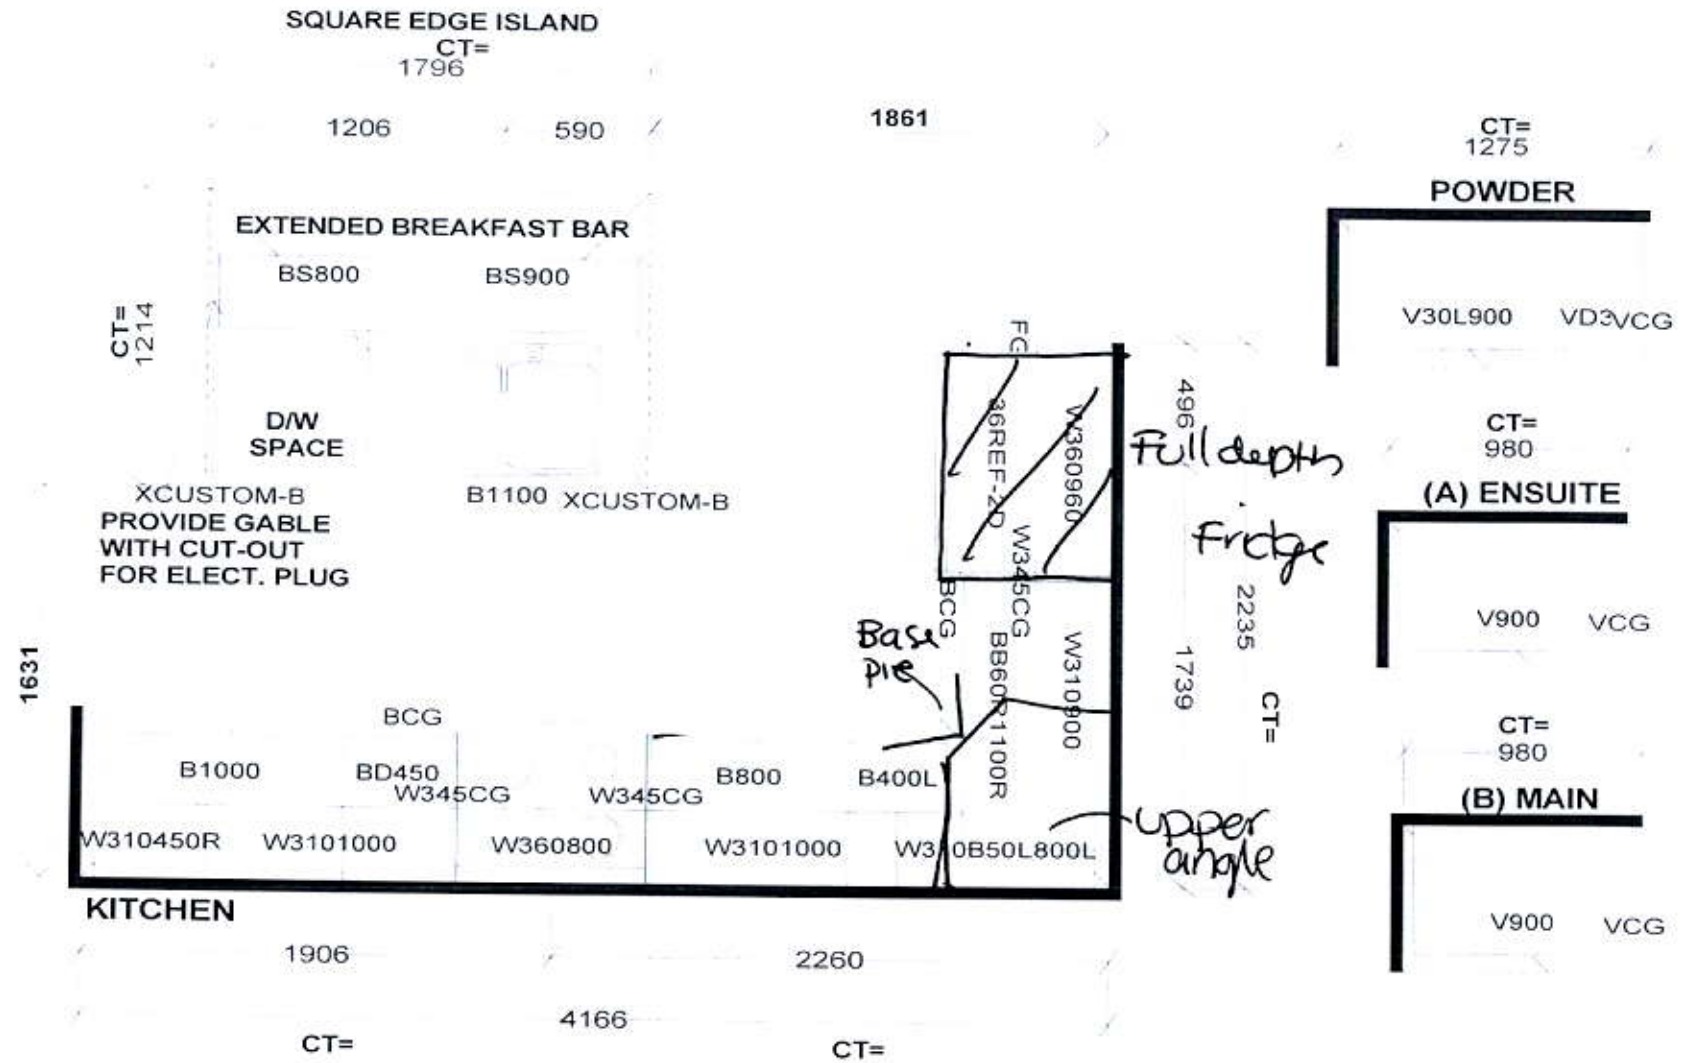

Selba Industries

J#

W WDT \_\_\_\_\_ W HGHT \_\_\_\_\_ W CNT \_\_\_\_\_  
FLOOR HGHT \_\_\_\_\_ DOOR HGHT \_\_\_\_\_  
ST CENT \_\_\_\_\_ 2X4 \_\_\_\_\_ VENT BOX COVER \_\_\_\_\_




This drawing is the intellectual property of SELBA INDUSTRIES INC. and is an original design which must not be released or copied unless applicable fee has been paid or job order placed.

HA  
G B  
F C  
ED

DESIGNER: KS  
DATE: MAR 12 19

JOB NUMBER:  
BUILDER: GREENPARK  
SITE: LAMBERTS LANE PH.2  
MODEL: URBAN 1X EL 1,1A,2,2A  
LOT #:



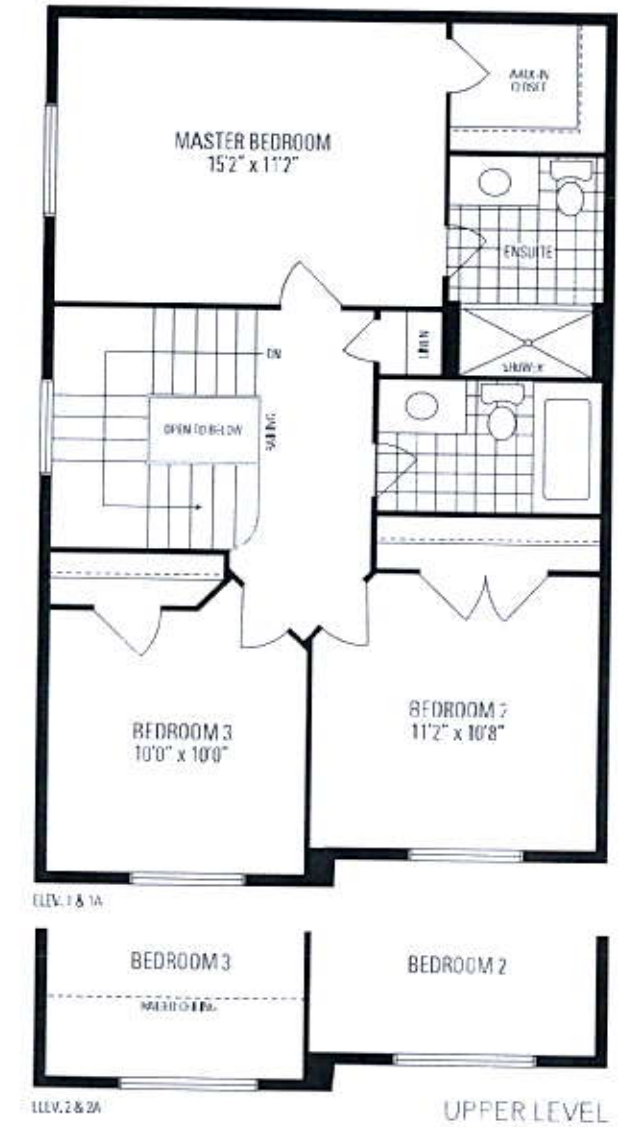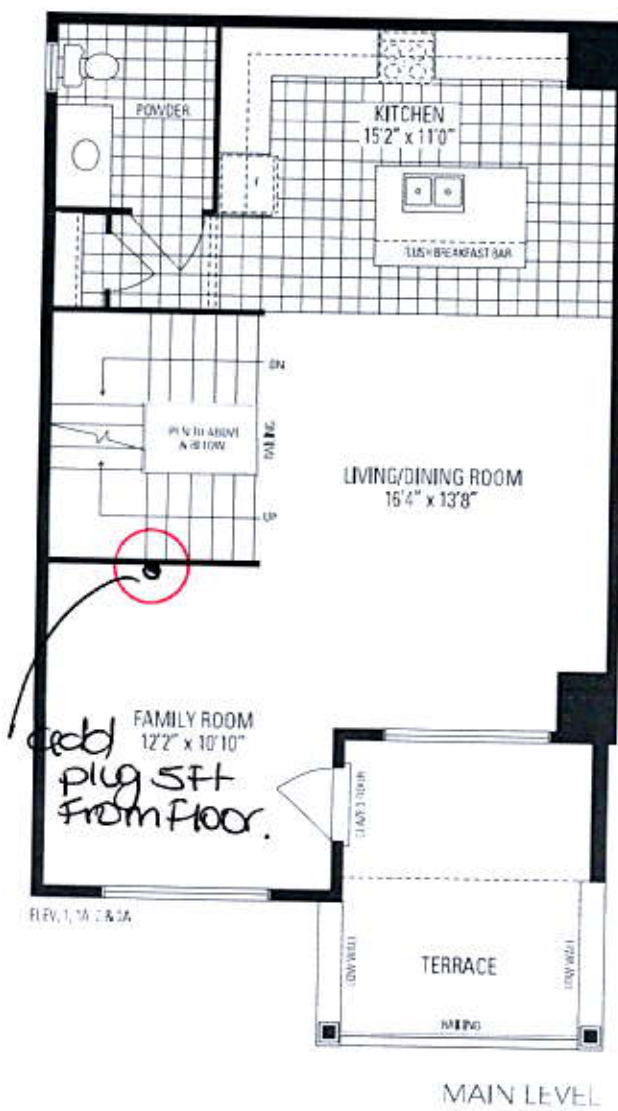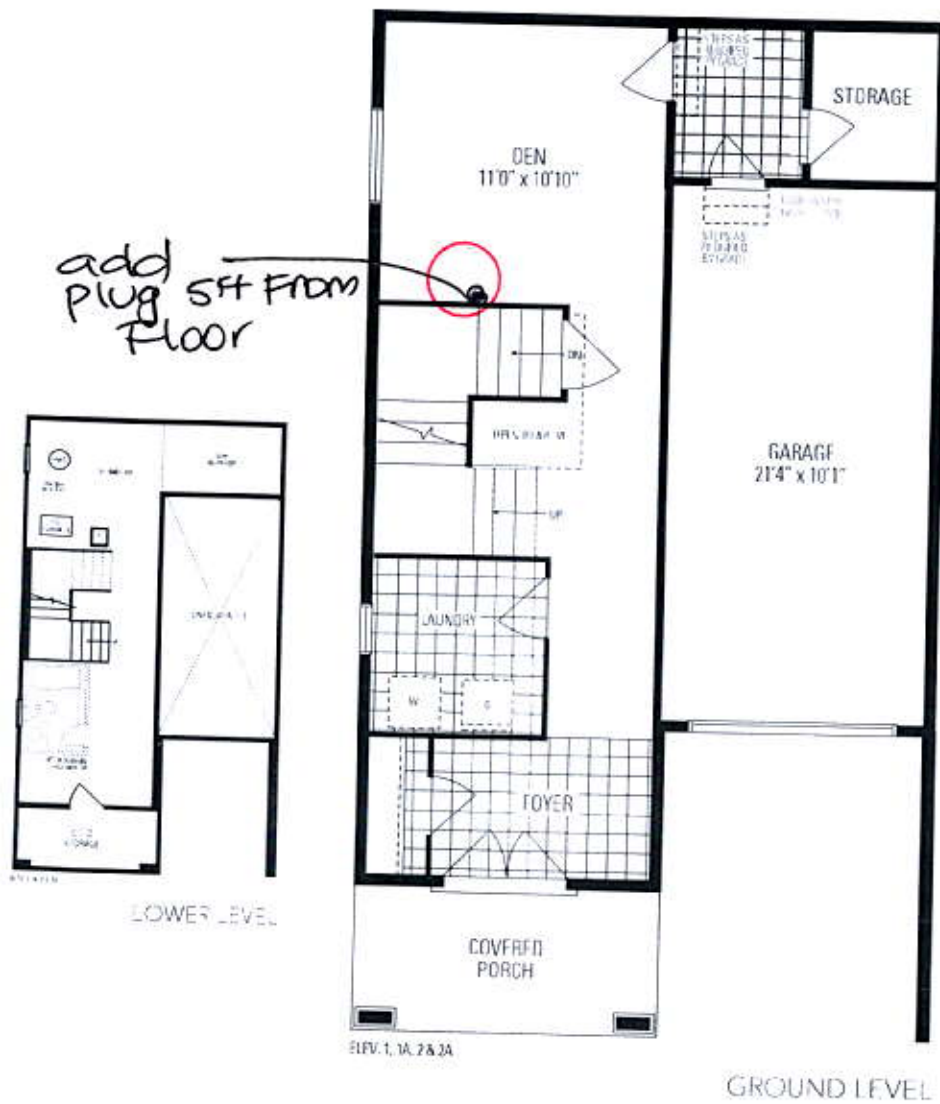

83/1

Urban ONE

2,028 SQ. FT. INCLUDES 20 SQ. FT. OF OPEN AREA

Orientation of home may be reversed and purchaser agrees to accept the same. Steps and patches may vary at any exterior entrance ways due to grading variance. Actual usable floor space may vary from the stated floor areas. All renderings are artist's concept. Dimensions, specifications and architectural detailing subject to modifications. Roofline and adjoining model types may vary due to siting. E. & O. E. March 2019.