

CONSTRUCTION SUMMARY


Lotus Pointe 2 (G) - Lamberts Lane Home Corp.

PURCHASERS: Jaswinder Kaur JASSAR and Harmeet Singh JASSAR // Milandeep Kaur M

TEL:

LOT / PHASE 60 / 2	REG. PLAN # 43M-2071	HOUSE TYPE Kinmount Four-B Elev 1		
-----------------------	-------------------------	--------------------------------------	--	--

MIRRORS AND GLASS

1 - FRAMELESS GLASS SHOWER ENCLOSURE WITH CHROME KNOB - MASTER ENSUITE 27Jan20 Note:	
---	---


PROMOTIONAL

1 - PARTIAL REDEMPTION OF PROMOTIONAL PACKAGE \$3,000 BALANCE FORWARD \$4,500 TO BE USED AT A LATER DATE. ORIGINAL PROMOTIONAL PACKAGE OF \$7,500 AS PER SCHEDULE PE 27Jan20 Note:	
--	--

EXTRAS AS PER OFFER

Complete Central Air Conditioning Supplied and installed Worksheet Note:	
The Purchaser acknowledges that the Purchase Price is inclusive of all credits and promotional packages available at the time of purchase. Worksheet Note:	
(7,5) The Vendor agrees that notwithstanding any other term or provision in this Agreement included in the Purchase Price and in addition to those items detailed in Schedule GP to the Agreement of Purchase and Sale, the Purchaser is entitled to a credit Worksheet Note:	

This Document is Extremely Time Sensitive - Printed 27 Jan 20 at 9:13

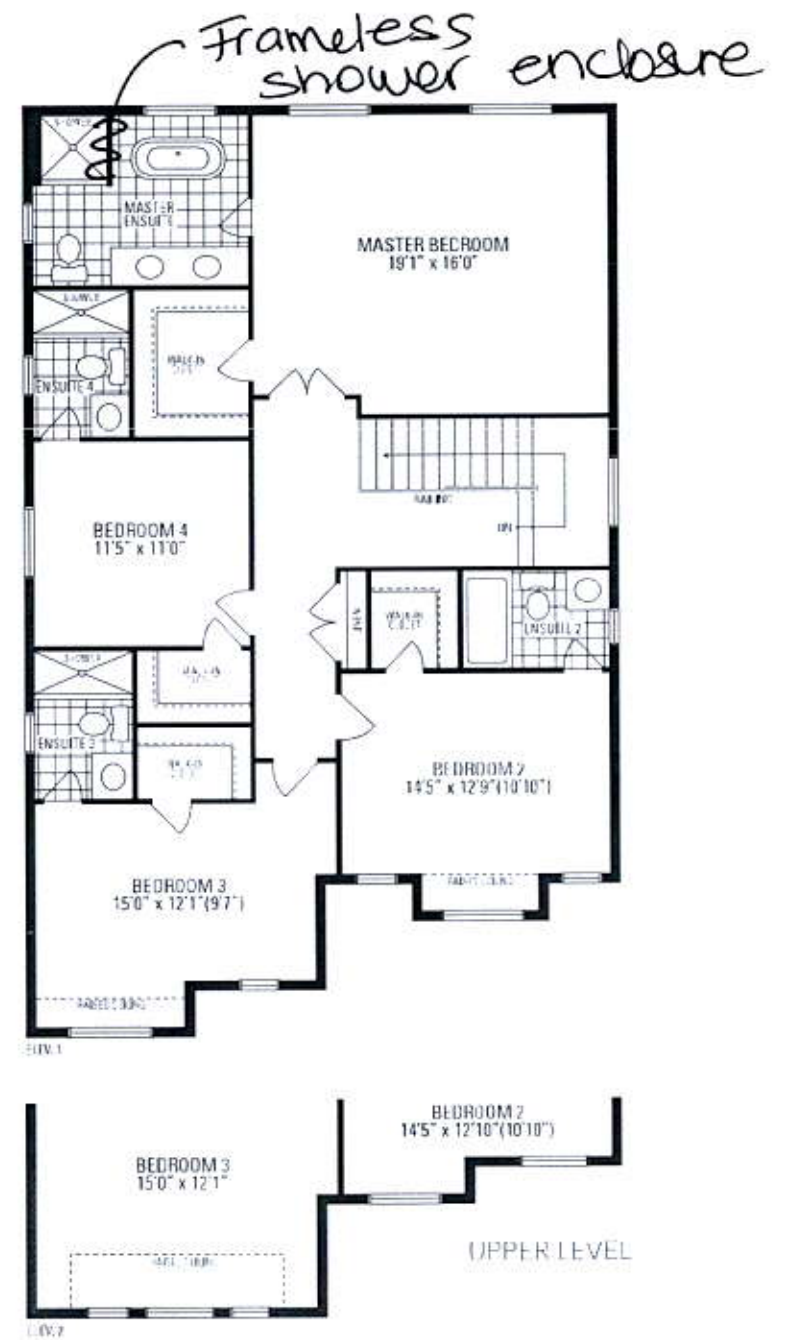

Kinsmont
FOUR - B