

CONSTRUCTION SUMMARY

Lotus Pointe 2 (G) - Lamberts Lane Home Corp.

PURCHASERS: Jasbir Singh KHAKH and Harjit Kaur BINNING

TEL:

LOT / PHASE 67 / 2	REG. PLAN # 43M-2071	HOUSE TYPE Preston Three Elev 1 4 Bedroom		
-----------------------	-------------------------	--	--	--

CONSTRUCTION

1 - BASEMENT 8 FOOT 6 INCH CONCRETE POUR - MEASURED FROM TOP OF FOOTING TO TOP OF FOUNDATION WALL 10May19 Note:	
--	--

ELECTRICAL

1 - LIGHT AND SWITCH - NO FIXTURE INCLUDED - LIVING ROOM 29Jan20 Note:	
1 - STANDARD KITCHEN LIGHT TO BE OVER ISLAND 29Jan20 Note:	
1 - ABOVE KITCHEN ISLAND - ADD LIGHT AND SWITCH - NO FIXTURE INCLUDED 29Jan20 Note:	
1 - PLUG - ELECTRICAL PLUG - TO BE INSTALLED OVER FIREPLACE 07Nov19 Note:	

MIRRORS AND GLASS

1 - MASTER ENSUITE SHOWER- ADD FRAMELESS GLASS SHOWER ENCLOSURE 07Nov19 Note:	
--	--

PLUMBING

1 - TOE TESTER - ADD TOE TESTER TO SHOWER 07Nov19 Note:	
--	--

MASTER ENSUITE

PROMOTIONAL

1 - LESS CREDIT FROM PURCHASER EXTRA SHEET IN OFFER 10May19 Note:	
--	--


EXTRAS AS PER OFFER

(7.5) The Vendor agrees that notwithstanding any other term or provision in this Agreement included in the Purchase Price and in addition to those items detailed in Schedule GP to the Agreement of Purchase and Sale, the Purchaser is entitled to a credit Worksheet Note:	
--	--


The Purchaser acknowledges that the Purchase Price is inclusive of all credits and promotional packages available at the time of purchase. Worksheet Note:	
---	--

This Document is Extremely Time Sensitive - Printed 3 Feb 20 at 11:00

67

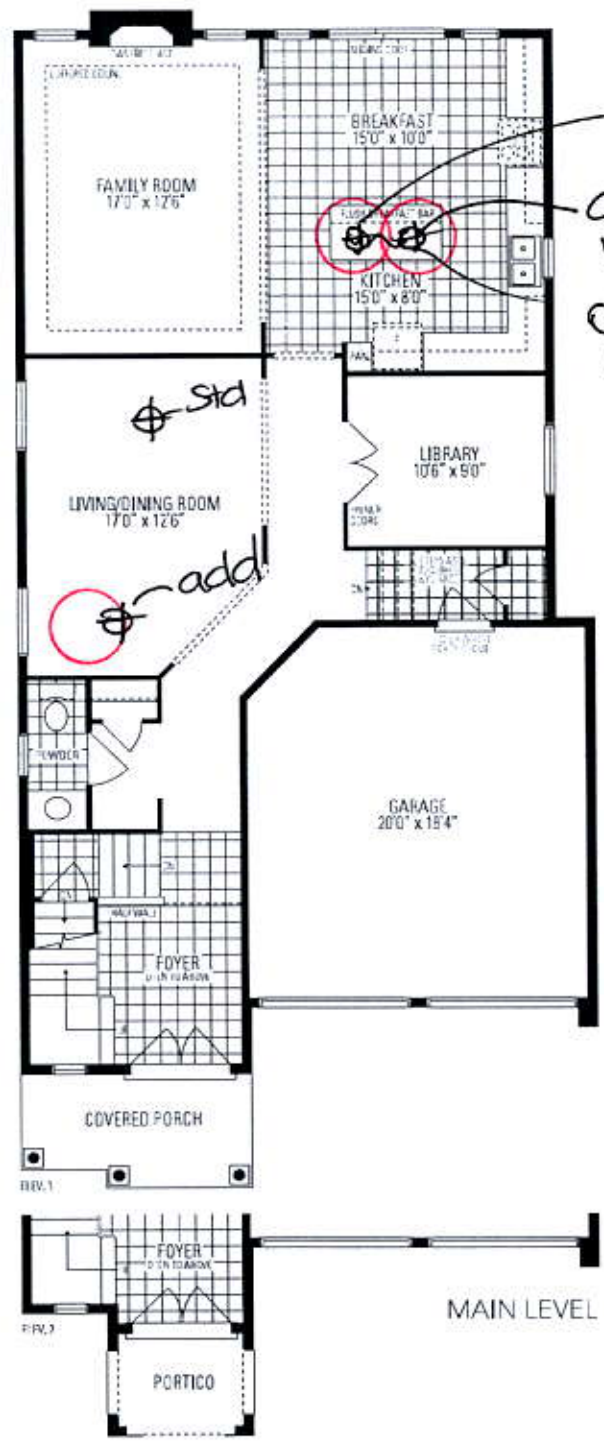

std light
add light
one switch

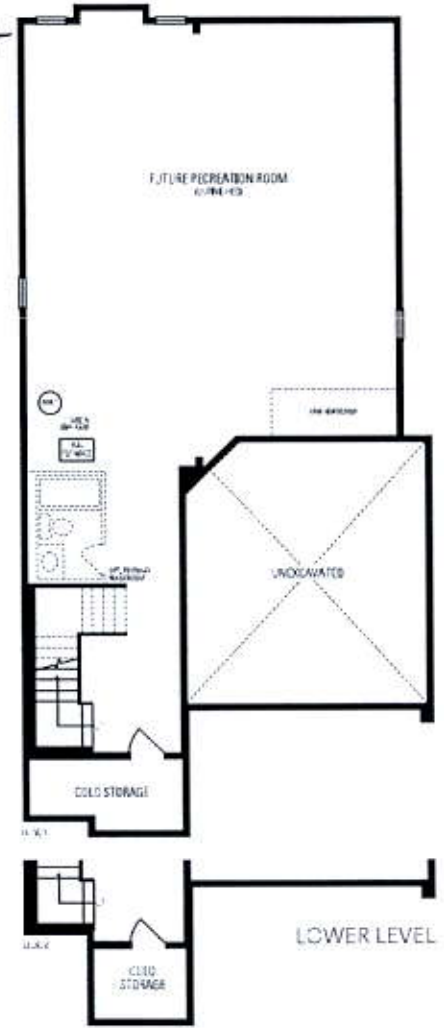

Preston
THREE
INCLUDES 63 SQ. FT. OF OPEN AREA

