

CONSTRUCTION SUMMARY - PARTIAL ONLY
Georgian Estate Collection - Tiburtino Buildup Corp.


PURCHASER: Dusan VARAKLIC

TEL: RES.: 416-738-1987 BUS.: 905-829-3538

LOT NUMBER	PHASE	HOUSE TYPE	REG. PLAN #	
6	1	Georgian Two Elev B	20M-1210	
INV#	QTY	EXTRA / CHANGE		

ELECTRICAL

24,477 09Mar20	1 - GARAGE-ADD 2 60 AMPS EACH CONNECTIONS IN THE GARAGE AS PER SKETCH Note:	
23,951 19Jun19	1 - FRONT PORCH - INSTALL STANDARD LIGHT FROM SOFFIT - SEE SKETCH Note:	new
23,951 19Jun19	2 - EXTERIOR OF FRONT PORCH - LIGHT - EXTERIOR WITH INTERIOR SWITCH - SERPERATE SWITCH FROM STANDARD LIGHT Note:	
23,951 19Jun19	1 - LIGHT AND SWITCH - NO FIXTURE INCLUDED - LIVING ROOM Note:	
23,951 19Jun19	3 - FAMILY ROOM, MASTER BEDROOM & REC ROOM - PLUG - ELECTRICAL PLUG - INSTALLED 5' FROM FLOOR FOR FUTURE TV Note:	
23,951 19Jun19	1 - KITCHEN - PLUG - ELECTRICAL PLUG - ADD TO ISLAND Note:	
23,951 19Jun19	7 - FAMILY ROOM, STUDY, DINETTE, MASTER BEDROOM, BASEMENT WET BAR, BASEMENT REC ROOM, BASEMENT ENTERTAINMENT AREA - SWITCH - DIMMER SWITCH IN LIEU OF EXISTING SWITCH - PRICE IS EACH - FOR POTLIGHTS Note:	
23,951 19Jun19	1 - RELOCATE STANDARD KITCHEN LIGHT TO BE CENTERED OVER ISLAND Note:	
23,951 19Jun19	1 - ABOVE KITCHEN ISLAND - ADD LIGHT AND SWITCH - NO FIXTURE - ON SAME SWITCH AS STANDARD LIGHT (2 IN TOTAL INCLUDING RELOCATED) STANDARD LIGHT Note:	
23,951 19Jun19	1 - ENSUITE 2/3 BATHROOM - POT LIGHT - SHOWER POT LIGHT - INSTALLED ON TUB Note:	
23,951 19Jun19	4 - MASTER ENSUITE, ENSUITE 2/3, ENSUITE 4 & ENSUITE 5 BATHROOMS - LIGHT AND SWITCH - NO FIXTURE INCLUDED - INSTALLED ON CEILING - SEPERATE SWITCH FROM STANDARD LIGHTS Note:	
23,951 19Jun19	1 - MASTER ENSUITE BATHROOM - INSTALL 2 STANDARD LIGHTS ABOVE VANITY - ONE ABOVE EACH SINK Note:	
23,951 19Jun19	1 - BASEMENT POWDER ROOM - RELOCATE STANDARD LIGHT TO CEILING - IF CONSTRUCTION PERMITS Note:	
23,951 19Jun19	1 - BASEMENT - REC ROOM - ROUGH-IN ELECTRICAL FOR FUTURE WET BAR - FRIDGE AND DISHWASHER Note:	
23,951 19Jun19	3 - ENTERTAINMENT AREA - POT LIGHT - LED - BASEMENT INSTALLATION - SEPERATE SWITCH Note:	
23,951 19Jun19	6 - REC ROOM AREA - POT LIGHT - LED - BASEMENT INSTALLATION - SEPERATE SWITCH Note:	

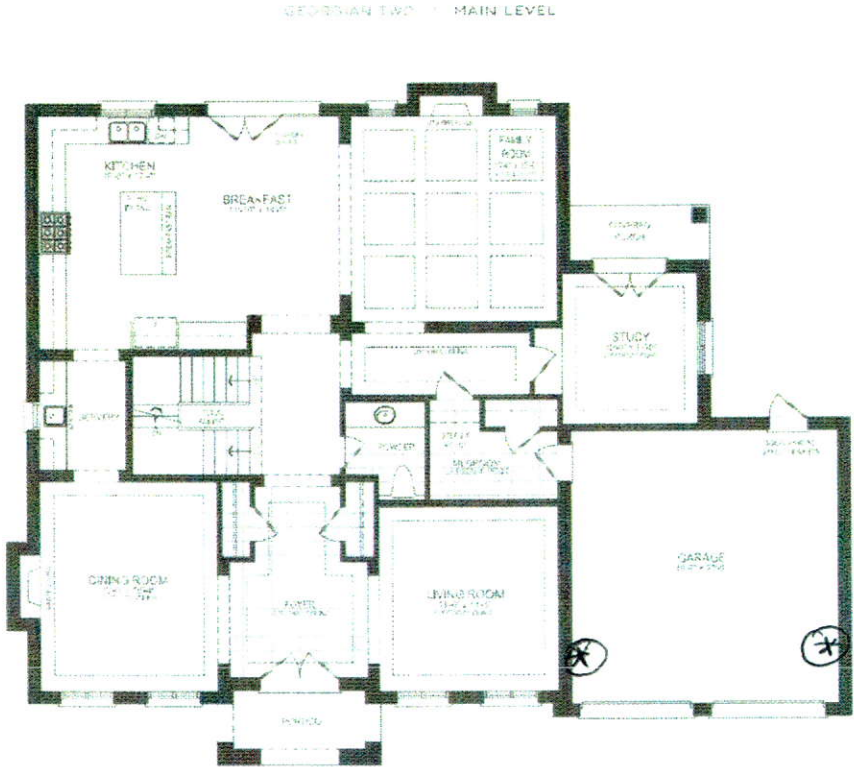

Impact North • 8555 Jane Street, Suite 308, Vaughan • 905.776.8555 • impactnorth.com

Date	October 2, 2018	Revised	1/1/18
Client	Greene & Hines	File Format	Indica gr / PDF
Job	Georgian - Exterior - Brickwork	Draw Size	12" X 12"
Publication	-	Notes	-
Revision Date	-	-	-

Impact North Approved Client Approved Final Approved