

CONSTRUCTION SUMMARY

Upside Towns - Firstgreen Corp

PURCHASER: TATIANA NAKHIMOVA

TEL:

LOT / PHASE Block 2 TH11 / 1	REG. PLAN #	HOUSE TYPE The Tannery Elev 2		
---------------------------------	-------------	----------------------------------	--	--

CONSTRUCTION

1 - GROUND LEVEL ADD SHOWER SEE SKETCH 11Mar20 Note:	
---	--

PROMOTIONAL

1 - PARTIAL REDEMPTION OF PROMOTIONAL PACKAGE \$\$\$\$\$\$ BALANCE FORWARD TO BE USED AT A LATER DATE. ORIGINAL PROMOTIONAL PACKAGE OF \$\$\$\$ AS PER SCHEDULE PE DATED MMDDYYYY. 11Mar20 Note: BALANCE OF PROMO \$15,000.00	
---	--

EXTRAS AS PER OFFER

The Purchaser acknowledges that the Purchase Price is inclusive of all credits and promotional packages available at the time of purchase. Worksheet Note:	
---	--

The Vendor agrees that notwithstanding any other term or provision in this Agreement included in the Purchase Price and in addition to those items detailed in Schedule GP to the Agreement of Purchase and Sale, the Purchaser is entitled to a credit of Two Worksheet Note:	
---	--

This Document is Extremely Time Sensitive - Printed 11 Mar 20 at 11:54

BLK-2 TH-11
FIRSTGREEN CORP
 UPSIDE TOWNS

THE TANNERY
 ELEV.2

REVISIONS:


1. REDUCE WALK-IN CLOSET SIZE AND ADD SHOWER STALL WITH FRAMED GLASS DOOR TO POWDER ROOM.

*Cabinets w/ Laminate
 Countertop -*

RECEIVED

MAR 11 2020

[Signature]

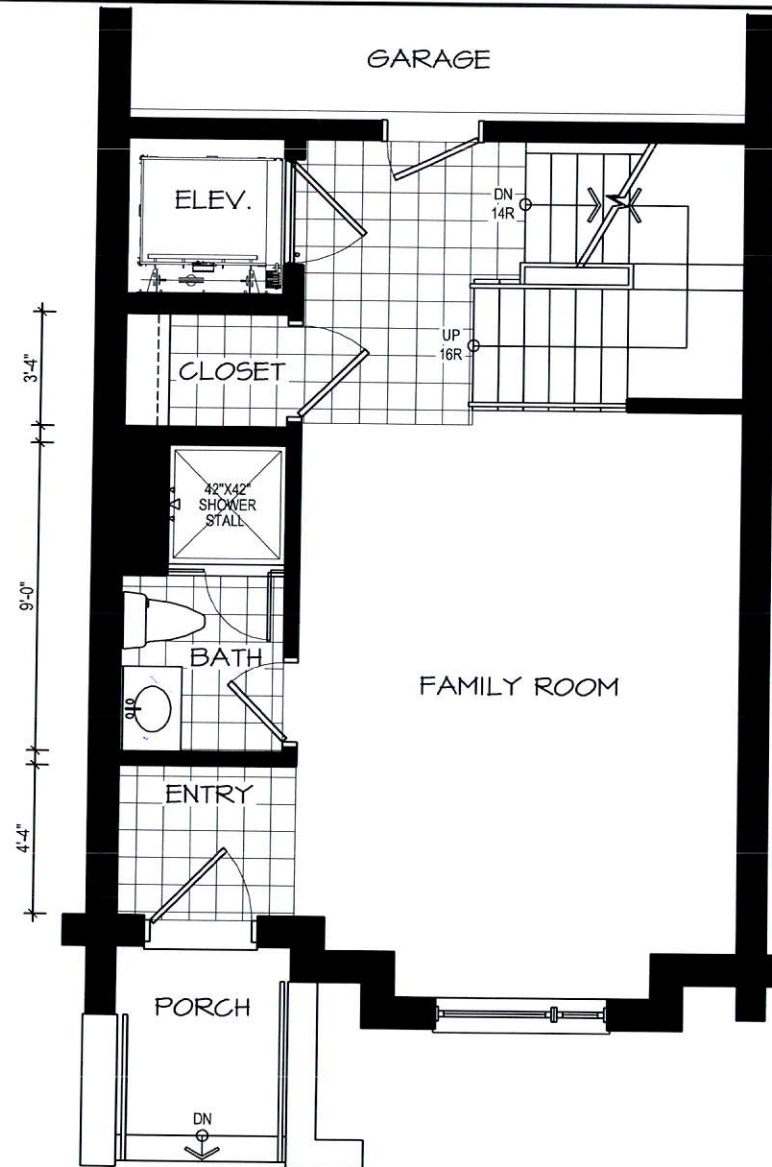

GROUND LEVEL

DISCLAIMERS: SKETCH NOT TO SCALE. DIMENSIONS, SPECIFICATIONS AND ARCHITECTURAL DETAILS SUBJECT TO MODIFICATION BY THE VENDOR. SKETCH IS ONLY FOR THE PURPOSE OF ILLUSTRATING REVISIONS REQUESTED BY THE PURCHASER AND ALL REVISIONS ARE SUBJECT TO VENDOR'S FINAL APPROVAL. ONLY REVISIONS ACCEPTED IN WRITING BY THE PURCHASER AND VENDOR ON A PURCHASER'S EXTRA SHEET WILL BE INCORPORATED INTO THE PLANS FILED WITH THE MUNICIPALITY. E. & O.E.

**REGION
 DESIGN
 INC.**

SCALE

N.T.S.

BY
 MB

PAGE No.
 1 OF 1

