

CONSTRUCTION SUMMARY


Upside Towns - Firstgreen Corp

PURCHASERS: MATT SHEN and SHANSHAN YU


TEL: RES.: 647-888-9308

LOT / PHASE	REG. PLAN #	HOUSE TYPE		
Block 3 TH15 / 1		The Tannery Elev 1		

CONSTRUCTION

1 - GROUND LEVEL REVISION- REDUCE WALK-IN CLOSET SIZE AND ADD SHOWER STALL WITH FRAMED GLASS DOOR TO POWDER ROOM- SEE SKETCH 05Jun20 Note:	RECEIVED JUN 08 2020	
---	-------------------------	---

PLUMBING

1 - GROUND LEVEL REVISION- ADD SHOWER STALL WITH FRAMED GLASS DOOR TO POWDER ROOM- SEE SKETCH 05Jun20 Note:	RECEIVED JUN 08 2020	
--	-------------------------	---

PROMOTIONAL

1 - PARTIAL REDEMPTION OF PROMOTIONAL PACKAGE \$5,000 BALANCE FORWARD \$5,000 TO BE USED AT A LATER DATE. ORIGINAL PROMOTIONAL PACKAGE OF \$10,000 AS PER SCHEDULE PE 05Jun20 Note:	
--	--

EXTRAS AS PER OFFER

The Purchaser acknowledges that the Purchase Price is inclusive of all credits and promotional packages available at the time of purchase. Worksheet Note:	
The Vendor agrees that notwithstanding any other term or provision in this Agreement included in the Purchase Price and in addition to those items detailed in Schedule GP to the Agreement of Purchase and Sale, the Purchaser is entitled to a credit of Ten Worksheet Note:	

This Document is Extremely Time Sensitive - Printed 5 Jun 20 at 11:24

BLK-3 TH-15
FIRSTGREEN CORP
 UPSIDE TOWNS


THE TANNERY
 ELEV.1

REVISIONS:

1. REDUCE WALK-IN CLOSET SIZE AND ADD SHOWER STALL WITH FRAMED GLASS DOOR TO POWDER ROOM.

* pedestal Sink

RECEIVED
 JUN 08 2020

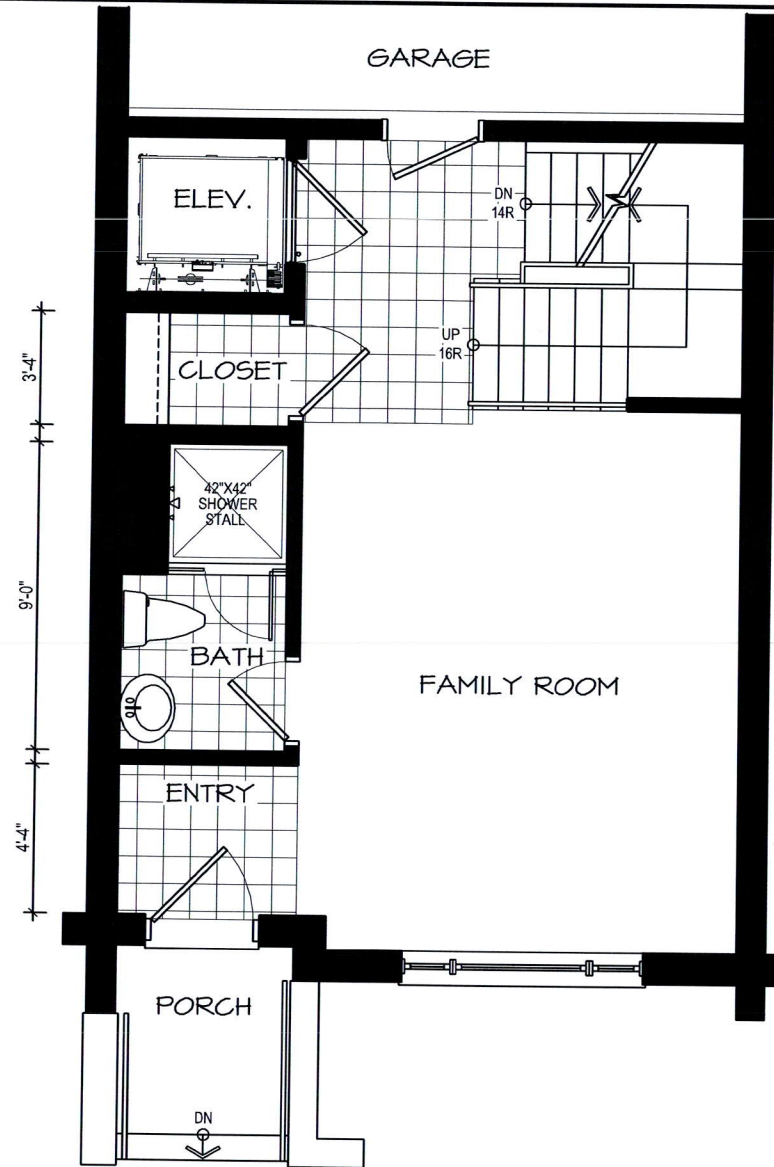

GROUND LEVEL

DISCLAIMERS: SKETCH NOT TO SCALE. DIMENSIONS, SPECIFICATIONS AND ARCHITECTURAL DETAILS SUBJECT TO MODIFICATION BY THE VENDOR. SKETCH IS ONLY FOR THE PURPOSE OF ILLUSTRATING REVISIONS REQUESTED BY THE PURCHASER AND ALL REVISIONS ARE SUBJECT TO VENDOR'S FINAL APPROVAL. ONLY REVISIONS ACCEPTED IN WRITING BY THE PURCHASER AND VENDOR ON A PURCHASER'S EXTRA SHEET WILL BE INCORPORATED INTO THE PLANS FILED WITH THE MUNICIPALITY. E. & O.E.

**REGION
 DESIGN
 INC.**

SCALE		N.T.S.
BY	PAGE No.	
MB	1 OF 1	

