

CONSTRUCTION SUMMARY			
PURCHASER: Dusan VARAKLIC		Georgian Estate Collection - Tiburtino Buildup Corp.	
		TEL: RES.: 416-738-1987 BUS.: 905-829-3538	
LOT / PHASE	REG. PLAN #	HOUSE TYPE	
6 / 1	20M-1210	Georgian Two Elev B	
1 - KITCHEN - UPGRADE TO TRANSITIONAL HOOD IN LIEU OF STANDARD AS PER OFFER			
20Aug19	Note:		
4 - KITCHEN - 400MM HEIGHT MULLION FROSTED GLASS DOORS			
20Aug19	Note:		
4 - KITCHEN - 1040MM HEIGHT MULLION FROSTED GLASS DOORS			
20Aug19	Note:		
1 - KITCHEN - ADDITIONAL BANK OF DRAWERS			
20Aug19	Note:		
1 - KITCHEN - PULL-OUT SPICE RACK			
20Aug19	Note:		
1 - KITCHEN - TRAY DIVIDERS			
20Aug19	Note:		
1 - KITCHEN - 2 POT & PAN DRAWERS INSTALLED BELOW COOKTOP			
20Aug19	Note:		
ONE SET- 2 DRAWERS			
2 - KITCHEN - TRAFALGAR BASE POSTS ON EITHER SIDE OF COOKTOP AREA			
20Aug19	Note:		
1 - KITCHEN - MAGIC CORNER			
20Aug19	Note:		
1 - KITCHEN - DISHWASHER DOOR PANEL			
20Aug19	Note:		

CERAMIC TILE

1 - ENSUITE 5 BATHROOM - SHOWER STALL - UPGRADED SHOWER JAMS TO MATCH COUNTERTOP		
20Aug19	Note:	
1 - ENSUITE 4 BATHROOM - SHOWER STALL - UPGRADED SHOWER JAMS TO MATCH COUNTERTOP		
20Aug19	Note:	
1 - MASTER ENSUITE BATHROOM - SHOWER STALL - UPGRADED SHOWER JAMS TO MATCH COUNTERTOP		
20Aug19	Note:	
1 - MASTER ENSUITE BATHROOM - FLOOR & SHOWER WALL - UPGRADE 3 TILES		
20Aug19	Note:	
1 - MUDROOM - UPGRDAE 3 FLOOR TILES		
20Aug19	Note:	
1 - POWDER ROOM - UPGRDAE 3 FLOOR TILES		
20Aug19	Note:	
1 - FOYER - UPGRDAE 3 FLOOR TILES		
20Aug19	Note:	

COUNTER TOP

1 - MASTER ENSUITE BATHROOM - HIGH-END QUARTZ COUNTERTOP IN LIEU OF STANDARD AS PER OFFER		
20Aug19	Note:	

ELECTRICAL


1 - PLUG - ELECTRICAL PLUG - TO BE INSTALLED OVER FIREPLACE		
04May20	Note:	
1 - GARAGE-ADD 2 60 AMPS EACH CONNECTIONS IN THE GARAGE AS PER SKETCH		
09Mar20	Note:	

RECEIVED

JUN 0 8 2020

RECEIVED

JUN 08 2020

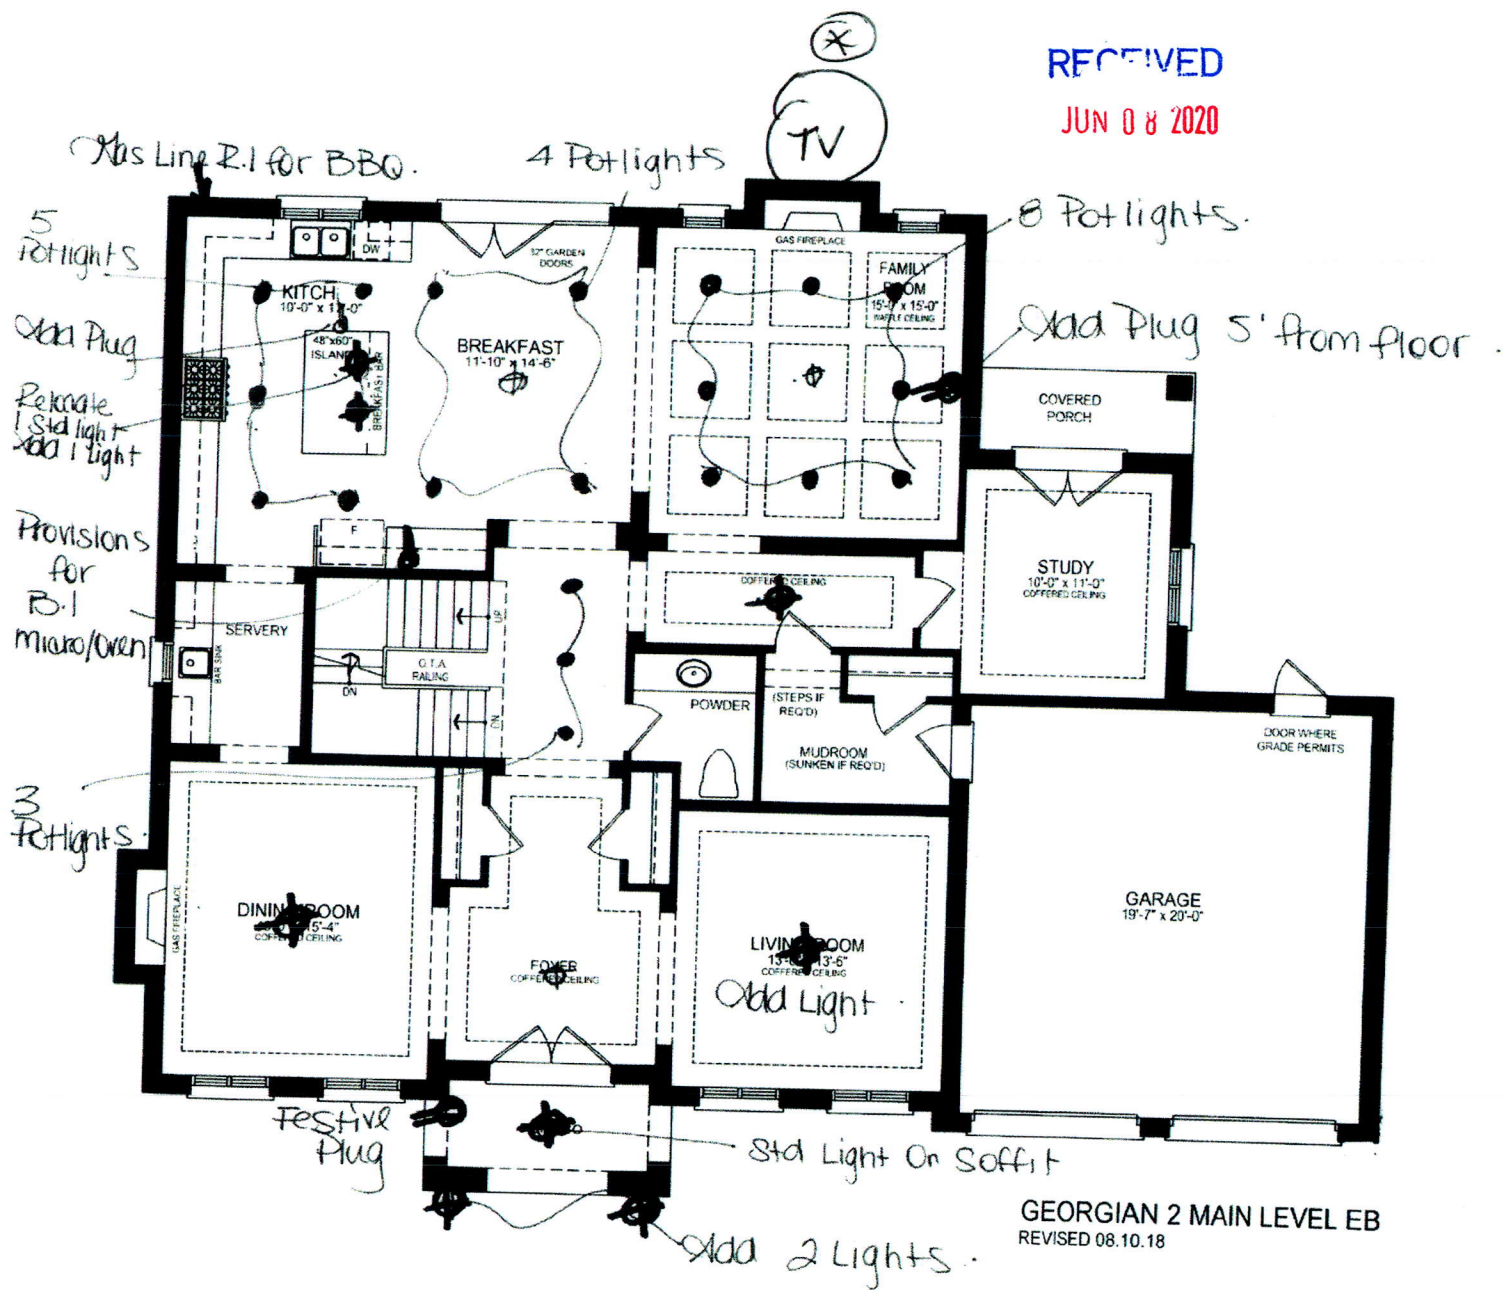

Lot 6
Tiburtino

D.V.

GEORGIAN 2 MAIN LEVEL EB
REVISED 08.10.18