

CONSTRUCTION SUMMARY - PARTIAL ONLY				
Upside Towns - Firstgreen Corp				
PURCHASER: DARREN C KERBEL			TEL:	
LOT NUMBER	PHASE	HOUSE TYPE	REG. PLAN #	
Block 7 TH43	1	The Carville Elev 1		
INV#	QTY	EXTRA / CHANGE		

Offer	Note:
-------	-------

FIREPLACE AND ACCESSORIES

23,963 26Sep19	1 - LIVING/DINING ROOM - DIMPLEX XLF74 IGNITE ELECTRIC FIREPLACE Note:
23,963 26Sep19	1 - GAS LINE ROUGH-IN FOR BARBECUE - SECOND FLOOR Note:
23,963 26Sep19	GAS LINE R.I. FOR BBQ- INSTALL ON ROOFTOP TERRACE Note: <i>Main Level</i>
23,963 26Sep19	1 - GAS LINE ROUGH-IN FOR STOVE (INCLUDES ELECTRICAL OUTLET) - SECOND FLOOR Note: <i>Upper Level</i>
23,963 26Sep19	1 - GAS LINE ROUGH-IN FOR DRYER (INCLUDES ELECTRICAL PLUG) - SECOND FLOOR Note:

This Document is Extremely Time Sensitive - Printed 14 May 20 at 12:45

REVISED RECEIVED

DATE: JUN 08 2020

REVISED
RECEIVED

DATE: JUN 08 2020

BLK 7 TH43


Cannot be done
A.B.G.

Stackable
2 TUB.


THE CARVILLE

ELEVATION 1 - 2,599 SQ.FT.
Includes 303 sq.ft.
of Finished Basement Area


Move to

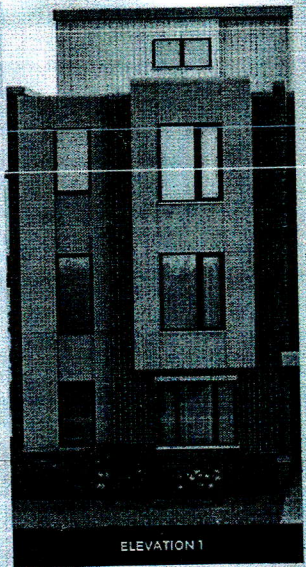

ELEVATION 1

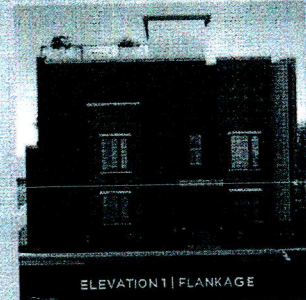


ELEVATION 1 | FLANKAGE

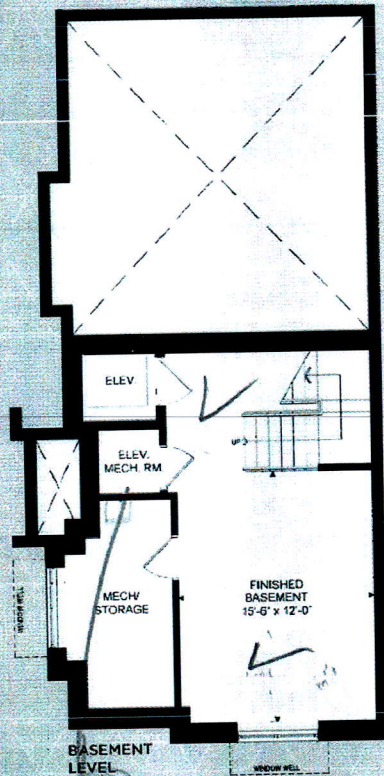


BASEMENT LEVEL

B.T. Plumbing
not to scale

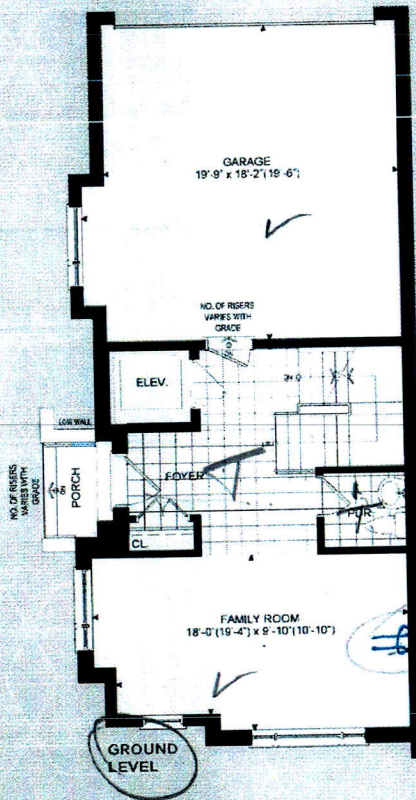


GROUND LEVEL

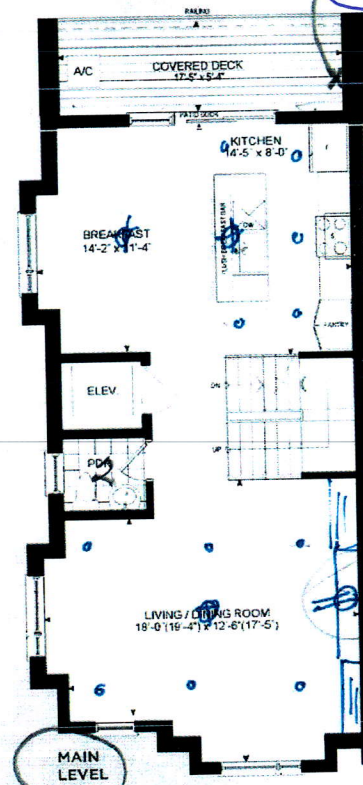

MAIN LEVEL


Plug 5' from Floor

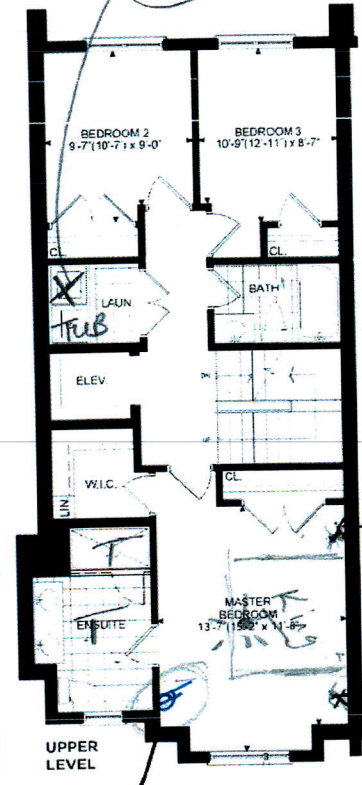

UPPER LEVEL

Plug over fireplace

Plug 6' from Floor

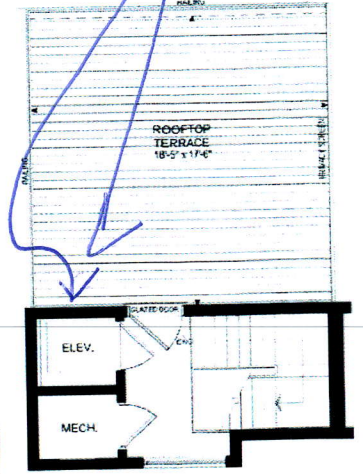

TERRACE LEVEL

2 wall
scores