

CONSTRUCTION SUMMARY

Georgian Estate Collection - Tiburtino Buildup Corp.

PURCHASER: Michael MAJCHROWICZ

TEL:

LOT / PHASE	REG. PLAN #	HOUSE TYPE		
8 / 1	20M-1210	Georgian One Elev B		

CABINETRY

1 - BEDROOM 4 ENSUITE- ADD 36" HIGH CABINETS 25Jun20 Note:	
1 - BED 2/3 ENSUITE ADD 36" HIGH CABINET- 25Jun20 Note:	
1 - MASTER ENSUITE- UPGRADE TO TUSCANY AT 36" HIGH 25Jun20 Note:	
1 - POWDER ROOM- ADD 2 ROPE POSTS AND DECOR TK 25Jun20 Note:	
1 - POWDER ROOM- UPGRADED TO TUSCANY DOOR 36" HIGHT- 25Jun20 Note:	
1 - PANTRY- WITH SB01 AND CLEAR GLASS MIDDLE DOOR AND UPPER DOOR- X4 25Jun20 Note:	
1 - PANTRY- ADD 6" DEEP CUSTOM PANTRY W/SHELVES 25Jun20 Note:	
1 - KITCHEN- ADD SHADING TO CABINETRY 25Jun20 Note:	
1 - KITCHEN UPGRADE TO LEGACY OR BANCROFT 25Jun20 Note: KITCHEN UPGRADE TO LEGACY WITH SHADING	

CABINETRY ACCESSORIES - (Spec's to follow)

1 - KITCHEN CABINETRY - APPLIANCE DOOR PANELS - 36" FRIDGE DOOR PANELS (SUPPLY ONLY) - UPGRADE 3 25Jun20 Note: SPECS REQUIRED	
2 - KITCHEN- 2 TILT UP DOORS- 25Jun20 Note: ONE ABOVE FRIDGE ONE ABOVE COOKTOP	
1 - KITCHEN CABINETRY BASE - POT/PAN DRAWERS (CABINET) - UPGRADE 3 25Jun20 Note: BELOW COOKTOP	
1 - KITCHEN CABINETRY ACCESSORY - STAINLESS STEELE CUTLERY INSERT - PRICE IS EACH 25Jun20 Note:	
1 - KITCHEN CABINETRY BASE - PULLOUT WIRE SPICE RACK - PRICE IS EACH 25Jun20 Note:	
1 - KITCHEN CABINETRY BASE - PIE CUT CORNER CABINET - BASE CABINETRY - UPGRADE 3 25Jun20 Note:	
1 - KITCHEN-LARGE DECOR WOOD HOOD WITH INLAYS 25Jun20 Note:	
1 - ISLAND- EXTRA BANK OF DRAWERS 25Jun20 Note:	
1 - KITCHEN-GLASS SHELVES IN PANTRY-ONLY 25Jun20 Note:	
1 - KITCHEN-PUCK LITES IN MINI UPPERS-X15 25Jun20 Note: INCLUDING PANTRY	
1 - KITCHEN-SB01 MULLION AND CLEAR GLASS IN MINI UPPERS 25Jun20 Note:	

RECEIVED

JUL 17 2020

CONSTRUCTION SUMMARY

Georgian Estate Collection - Tiburtino Buildup Corp.

PURCHASER: Michael MAJCHROWICZ

TEL:

LOT / PHASE	REG. PLAN #	HOUSE TYPE		
8 / 1	20M-1210	Georgian One Elev B		

1 - KITCHEN- DECOR WINDOW BOX 25Jun20    Note:	
1 - KITCHEN0 SOFT CLOSE DOORS- 25Jun20    Note: IN EXTRA DOORS	
1 - KITCHEN- BLUMOTION DRWS 25Jun20    Note: IN EXTRA DRAWERS	

CERAMIC TILE

1 - MASTER ENSUITE- UPGRADED SHOWER JAMS- 13Jul20    Note:	
1 - BEDROOM 2/3 ENSUITE -UPGRADED FLOOR AND WALL TILES WITH A BORDER IN BATHTUB- 13Jul20    Note:	
1 - BEDR 4 AND BED 5 ENSUITE SHOWER FLOORS UPGRADED MOSAICS ONLY- 13Jul20    Note:	
1 - MASTER ENSUITE- UPGRADED TILES ON FLOOR AND MOSAICS ON SHOWER FLOOR AND WALL 13Jul20    Note:	
1 - POWDER ROOM AND MUDROOM UPGRADED 24X24 POLISHED TILES 13Jul20    Note:	
1 - FOYER- UPGRADE TILES 13Jul20    Note:	

CONSTRUCTION

1 - DELETE -UPPER LEVEL ELECTRIC INFLOOR HEATINGS AS PER P.E.24467 25Jun20    Note:	
1 - LOWER LEVEL - ADD ROUGH-IN BAR ROUGH-IN INCLUDING PLUMBING FOR SINK, ELECTRICAL COUNTER PLUGS AS REQUIRED 17Mar20    Note:	
1 - UPPER LEVEL - ELECTRIC FLOOR HEATING WITH ONE ZONE IN BATHROOMS 17Mar20    Note: MASTER ENSUITE, BEDROOM 2/3 ENSUITE & BEDROOM 4 ENSUITE- EACH ROOM HAS ITS OWN THERMOSTAT-	
1 - LOWER LEVEL - IN FLOOR HEATING WITH BOILER 17Mar20    Note:	

COUNTER TOP

1 - ALL BATHROOM COUNTERTOPS UPGRADED TO QUARTZ- POWDER ROOMS- MASTER ENSUITE, BED 2/3, BED 4 AND BEDR.5 ENSUITE VANITIES- 13Jul20    Note:	
1 - KITCHEN-UPGRADED GRANITE FROM STANDARD VENDORS SAMPLES 13Jul20    Note:	

DOORS AND TRIM

1 - LOWER LEVEL - UPGRADE DOOR FOR COLD CELLER 17Mar20    Note: FLAT DECORATIVE DOOR	
---	--

ELECTRICAL

1 - KITCHEN - FAN INSERT FOR UPGRADE 36" HOOD - CYCLONE BX21534 13Jul20    Note:	
1 - UPPER LEVEL - MASTER BEDROOM - ADD COVE LIGHTING - INCANDESCENT 17Mar20    Note:	



CONSTRUCTION SUMMARY

Georgian Estate Collection - Tiburtino Buildup Corp.

PURCHASER: Michael MAJCHROWICZ

TEL:

LOT / PHASE	REG. PLAN #	HOUSE TYPE		
8 / 1	20M-1210	Georgian One Elev B		

2 - UPPER LEVEL - MASTER BEDROOM - ADD 2 LIGHTS FOR FUTURE WALL SCONCES 17Mar20 Note:	
4 - UPPER LEVEL - MASTER BEDROOM - ADD 4 NSULATED POT LIGHTS 17Mar20 Note:	
4 - UPPER LEVEL - UPPER HALL - ADD 4 INSULATED POT LIGHTS 17Mar20 Note:	
2 - UPPER LEVEL - UPPER HALL - ADD 2 LIGHTS FOR FUTURE WALL SCONCES 17Mar20 Note:	
2 - UPPER LEVEL - STAIR LANDING - ADD 2 LIGHTS FOR FUTURE WALL SCONCES 17Mar20 Note:	
1 - MAIN LEVEL - KITCHEN - UPGRADE VALANCE LIGHTING TO LED LIGHT IN LIEU OF FLUORESCENT LIGHT 17Mar20 Note:	
1 - MAIN LEVEL - DINING ROOM - ADD COVE LIGHTING - INCANDESCENT 17Mar20 Note:	
1 - MAIN LEVEL - LIVING ROOM - ADD COVE LIGHTING - INCANDESCENT 17Mar20 Note:	
1 - MAIN LEVEL - FOYER & MAIN HALL - ADD COVE LIGHTING - INCANDESCENT 17Mar20 Note:	
1 - MAIN LEVEL - KITCHEN - RELOCATE STANDARD LIGHT TO BE CENTERED ABOVE ISLAND ADD 1 ADDITIONAL LIGHTS (2LIGHTS TOTAL ABOVE ISLAND) 17Mar20 Note:	
2 - MAIN LEVEL - DINING ROOM - ADD 2 LIGHTS FOR FUTURE WALL SCONCES 17Mar20 Note:	
2 - MAIN LEVEL - FOYER - ADD 2 LIGHTS FOR FUTURE WALL SCONCES 17Mar20 Note:	
10 - MAIN LEVEL - KITCHEN & BREAKFAST - ADD 10 POT LIGHTS 17Mar20 Note:	
8 - MAIN LEVEL - STUDY - ADD 8 POT LIGHTS 17Mar20 Note:	
5 - MAIN LEVEL - MAIN HALL - ADD 5 POT LIGHTS 17Mar20 Note:	
6 - MAIN LEVEL - FOYER - 6 POT LIGHTS (AS PER OFFER) 17Mar20 Note:	
8 - MAIN LEVEL - DINING ROOM - 8 POT LIGHTS (AS PER OFFER) 17Mar20 Note:	
6 - MAIN LEVEL - FAMILY ROOM - 6 POT LIGHTS (AS PER OFFER) 17Mar20 Note:	
19 - LOWER LEVEL - ADD POT LIGHTS THROUGHOUT REC ROOM & HALL 17Mar20 Note:	

FIREPLACE AND ACCESSORIES

1 - MAIN LEVEL - KITCHEN - ADD ROUGH-IN PROVISIONS FOR FUTURE GAS STOVE 17Mar20 Note:	
1 - LOWER LEVEL - ADD DIRECT VENT GAS FIREPLACE WITH MANTEL (M1 OR M2) 17Mar20 Note:	



CONSTRUCTION SUMMARY

Georgian Estate Collection - Tiburtino Buildup Corp.

PURCHASER: Michael MAJCHROWICZ

TEL:

LOT / PHASE 8 / 1	REG. PLAN # 20M-1210	HOUSE TYPE Georgian One Elev B		
----------------------	-------------------------	-----------------------------------	--	--

PROMOTIONAL

1 - LESS BALANCE OF CREDIT FROM PURCHASER EXTRA SHEET IN OFFER 13Jul20 Note:	
1 - PROMO AS PER OFFER- 17Mar20 Note: PROMO AS PER OFFER \$100,000.00 LESS \$97,380.00 NEW PROMO BALANCE \$2620.00	

This Document is Extremely Time Sensitive - Printed 16 Jul 20 at 10:13

Purchaser:Michael MAJCHROWICZ

Property: 8

Telephone Res. / Bus: /

Project: Tibertino Buildup Corp.

Decor Advisor: Anne Federico

Model and Elevation: Georgian One Elev B

Lock Date: 13-Jul-20

13-Jul-20

Plan #: 20M-1210

Layout Changes: ☐ Yes ☐ No

Sketch Attached: ☐ Yes ☐ No

Exterior Colour Scheme:

1. Cabinetry

	Style and Colour	Hardware
Kitchen / Breakfast	LEGACY L614DZ4 WITH SHADING	
Laundry Room	ELISSE	
Powder Room	TUSCANY W821XZ4	
Master Ensuite Bathroom	TUSCANY W821XZ4	
Ensuite Bath - Bedroom 2/3	MONACO W823XZ4	
Ensuite Bath - Bedroom 4	MONACO W823XZ4	
Ensuite Bath - Bedroom 5	MONACO W823XZ4	
Basement Powder Rm	MONACO W823XZ4	

Appliances:

Built In Appliances ☒ Yes ☐ No

Slide In Stove ☐ Yes ☒ No

Dishwasher Cabinet ☐ Closed ☒ Open

41" Upper Cabinets ☒ Yes ☐ No

Please NOTE: Standard Cabinet Height is 30"

Stove Opening 

36"

NOTE: If not specified, opening will be set to builder's standard opening of approximately 30" width

Fridge Opening 

Custom

NOTE: If not specified, opening will be set to builder's standard opening of approximately 37" width x 74" height

\*\* Refer to Construction Summary

2. Counters

	Counter	Edge
Kitchen / Breakfast	GRANITE-WHITE ICE	#360 EDGE
Laundry Room	N/A	
Powder Room	QUARTZ-VIRGINIA	#360 EDGE
Master Ensuite Bathroom	QUARTZ-MOUNTAIN GREY	#360 EDGE
Ensuite Bath - Bedroom 2/3	QUARTZITE-CRYSTAL ONYX ABSOLUTE	#360 EDGE
Ensuite Bath - Bedroom 4	QUARTZ-WHISTLER WHITE	#360 EDGE
Ensuite Bath - Bedroom 5	QUARTZ-WHISTLER WHITE	#360 EDGE
Basement Powder Rm	QUARTZ-LYKSAM	#360 EDGE

\*\* Refer to Construction Summary

Initial: 

AM

Page 1 of 4

Printed 7/13/2020 11:03:40



Purchaser: Michael MAJCHROWICZ

Property: 8

Telephone Res. / Bus: /

Project: Tiburtino Buildup Corp.

Decor Advisor: Anne Federico

Model and Elevation: Georgian One Elev B

Lock Date: 13-Jul-20

13-Jul-20

Plan #: 20M-1210

## 3. Ceramic Flooring

		At a 45	Threshold-If App.
Entrance Vestibule	TILE-ELEMENTS PORT LAURENT 24X24	<input type="checkbox"/>	METAL STRIP
Main Hall	HARDWOOD	<input type="checkbox"/>	
Kitchen / Breakfast	HARDWOOD	<input type="checkbox"/>	
Laundry Room	TILE-MARMORA BIANCO VENATO 12X24	<input type="checkbox"/>	
Powder Room	TILE-CALACATTA PURITY LUX 24X24	<input type="checkbox"/>	
Master Ensuite Bathroom	TILE-TRAVERTINO BIANCO MEMENTO POL 12X24	<input type="checkbox"/>	
Ensuite Bath - Bedroom 2/3	TILE-RMD CARRARA BRILL 10X30	<input type="checkbox"/>	
Ensuite Bath - Bedroom 4	TILE-PLSS WHITE 12X24	<input type="checkbox"/>	
Ensuite Bath - Bedroom 5	TILE-PLSS WHITE 12X24	<input type="checkbox"/>	
Basement Powder Room	TILE-PALLISSANDRO DARK 12X24	<input type="checkbox"/>	
MUD ROOM-	TILE-CALACATTA PURITY LUX 24X24	<input type="checkbox"/>	

\*\* Refer to Construction Summary

## 4. Ceramic Wall Tile

Master Ensuite Bathroom	Selection	Describe
Tub Deck Wall	N/A	
Tub Deck	N/A	
Tub Deck Skirt	N/A	
Shower Stall	Travertino BIANCO MEMENTO INTRECCIO Mosaic 12x12	INCLUDES SHOWER BASE
Bathtub Enclosure Walls	N/A	
Ensuite Bath - Bedroom 2/3	TILE-RMD CARRARA BRILL 10X30 - LAID HORIZONTAL	Border-RDM Carrara Macro 2X2- 6"(3 Rows of 2x2)
Ensuite Bath - Bedroom 4	TILE-PLSS WHITE 12X24 - LAID HORIZONTAL	Shower Base - PLSS WHITE MOSAIC 2X2
Ensuite Bath - Bedroom 5	TILE-PLSS WHITE 12X24 - LAID HORIZONTAL	Shower Base - PLSS WHITE MOSAIC 2X2
Basement Powder Room	N/A	
MUD ROOM-		
Kitchen Backsplash	N/A	

\*\* Refer to Construction Summary - STANDARD GROUT THROUGHOUT UNLESS SPECIFIED  
MASTER ENSUITE SHOWER JAM = QUARTZ-CALACATTA SM  
BEDROOM 4 ENSUITE & BEDROOM 5 ENSUITE SHOWER JAM = BIANCO CARRARA

## 5. Plumbing Fixtures

All Bathrooms

White

Whirlpool

 ☐ Yes ☒ NoDishwasher Rough-In ☒ Yes ☐ NoWaterline for Fridge ☒ Yes ☐ No

\*\* Refer to Construction Summary

## 6. Trim Carpentry

Interior Doors	CARRARA-SMOOTH
Interior Trim	As Per Construction Specifications
Door Handles	As Per Construction Specifications
Exterior Front Door Handle	As Per Construction Specifications

\*\* Refer to Construction Summary

Initial: 

Page 2 of 4



Purchaser:Michael MAJCHROWICZ

Telephone Res. / Bus: /

Decor Advisor:Anne Federico

Lock Date:13-Jul-20

Property: 8

Project: Tibertino Buildup Corp.

Model and Elevation: Georgian One Elev B

Plan #: 20M-1210

7. Other Flooring

Main Hall	MIRAGE-CHARCOAL MAPLE 4 7/16 CASHMERE
Living Room	MIRAGE-CHARCOAL MAPLE 4 7/16 CASHMERE
Dining Room	MIRAGE-CHARCOAL MAPLE 4 7/16 CASHMERE
Family Room	MIRAGE-CHARCOAL MAPLE 4 7/16 CASHMERE
Den / Library / Study	MIRAGE-CHARCOAL MAPLE 4 7/16 CASHMERE
Basement Landing(If Applies)	LAMINATE-PARK LANE - VENICE OAK LIGHT TL-EL3990
Lower Landing (If Applies)	MIRAGE-CHARCOAL MAPLE 4 7/16 CASHMERE
Upper Landing	MIRAGE-CHARCOAL MAPLE 4 7/16 CASHMERE
Upper Hall	MIRAGE-CHARCOAL MAPLE 4 7/16 CASHMERE
Master Bedroom	MIRAGE-CHARCOAL MAPLE 4 7/16 CASHMERE
Bedroom #2	MIRAGE-CHARCOAL MAPLE 4 7/16 CASHMERE
Bedroom #3	MIRAGE-CHARCOAL MAPLE 4 7/16 CASHMERE
Bedroom #4	MIRAGE-CHARCOAL MAPLE 4 7/16 CASHMERE
Bedroom #5	LAMINATE-PARK LANE - VENICE OAK LIGHT TL-EL3990
BASEMENT-	LAMINATE-PARK LANE - VENICE OAK LIGHT TL-EL3990
KITCHEN/BREAKFAST	MIRAGE-CHARCOAL MAPLE 4 7/16 CASHMERE
Underpad	TypeArea

\*\* Refer to Construction Summary

8. Railings and Pickets

Railing Type	V-GROOVE	Colour	MIRAGE MAPLE CHARCOAL
Picket Type	EUROLINE 1	Colour	BLACK
Stringer / Riser	AS PER CONSTRUCTION SPECIFICATIO	Colour	MIRAGE MAPLE CHARCOAL
Treads	AS PER CONSTRUCTION SPECIFICATIO	Colour	MIRAGE MAPLE CHARCOAL
Red Oak Stairs with Semi Gloss Finish		<input checked="" type="radio"/> Yes <input type="radio"/> No	

\*\* Refer to Construction Summary THE STAIN COLOURS OR FINISH AVAILABLE ON RISERS, TREADS, PICKETS AND RAILS (STAIRCASES), WILL NOT BE AN EXACT MATCH TO PREFINISHED HARDWOOD OR LAMINATE FLOORS.

9. Wall Paint Flat Finish

Main & Upper Hall	WARM GREY	Master Bedroom	WARM GREY
Living Room	WARM GREY	Bedroom #2	WARM GREY
Dining Room	WARM GREY	Bedroom #3	WARM GREY
Kitchen / Breakfast	WARM GREY	Bedroom #4	WARM GREY
Family Room	WARM GREY	Bedroom #5	WARM GREY
Powder Room	WARM GREY	Master Ensuite	WARM GREY
Laundry Room	WARM GREY	Ensuite Bath - Bedroom 2/3	WARM GREY
Den/Library	WARM GREY	Ensuite Bath - Bedroom 4	WARM GREY
Trim Paint-Semi Gloss	WHITE	Ensuite Bath-Bedroom5	Ensuite Bath - Bedroom 4 Warm Grey
		Basement Powder Rm	Ensuite Bath - Bedroom 4 Warm Grey
		BASEMENT	Ensuite Bath - Bedroom 4 Warm Grey

Smooth Ceilings First Floor ☒ Yes ☐ No

\*\* Refer to Construction Summary-THROUGHOUT SMOOTH CELILINGS-----

Initial: 



Purchaser: Michael MAJCHROWICZ

Property: 8

Telephone Res. / Bus: /

Project: Tibertino Buildup Corp.

Decor Advisor: Anne Federico

Model and Elevation: Georgian One Elev B

Lock Date: 13-Jul-20

13-Jul-20

Plan #: 20M-1210

## 10. Plaster Mouldings and Medallions

Entrance Vestibule	SEE NOTES		Kitchen/Breakfast		
Main Hall			Den/Library		
Living Room			Lower Landing		
Dining Room					
Family Room					

\*\* Refer to Construction Summary

## 11. Fireplace

Living Room			Family Room			Other Room - Specify - <u>Basement</u>		
Purchased	As Per Plan	N/A	Purchased	As Per Plan	N/A	Purchased	As Per Plan	N/A
<input type="radio"/>	<input type="radio"/>	<input checked="" type="radio"/>	<input type="radio"/>	<input checked="" type="radio"/>	<input type="radio"/>	<input checked="" type="radio"/>	<input type="radio"/>	<input type="radio"/>
Fireplace Type			As Per Construction Specifications			As Per Construction Specifications		
Mantle Type			MANTLE M1-STANDARD			MANTLE M1-STANDARD		
Colour / Stain			AS PER CONSTRUCTION SPECIFICATIONS			AS PER CONSTRUCTION SPECIFICATIONS		
Surround			NERO			BIANCO		
Hearth			NO			NO		

\*\* Refer to Construction Summary

## 12. Heating and Air Conditioning

Air Conditioning	YES	Gas Provisions Stove	YES
Gas Provisions Dryer	NO	Gas Provisions Barbecue	NO

Comment

\*\* Refer to Construction Summary

## 13. Electrical

Plugs and Switches	<input checked="" type="radio"/> White	DECOR	Above Kitchen Cabinet Light	<input type="radio"/> Yes <input checked="" type="radio"/> No
Hood Fan	CYCLONE INSERT 34" #BX21534		Below Kitchen Cabinet Light	<input checked="" type="radio"/> Yes <input type="radio"/> No
Appliances	Built in Cooktop		Gas Stove	Microwave
	<input checked="" type="radio"/> Yes <input type="radio"/> No	Built in Oven	<input checked="" type="radio"/> Yes <input type="radio"/> No	<input checked="" type="radio"/> Yes <input type="radio"/> No
Dishwasher Rough-in	Yes			

\*\* Refer to Construction Summary

## 14. General Comments


\*\* Refer to Construction Summary

## Disclaimers and Notes

- Colours of all materials are as close as possible to builder's selection, but not necessarily identical due to variances in manufacturing.
- Any extras listed above are null and void unless accompanied by a separate invoice/amendment. Said invoice must be paid in full.
- The Purchaser agrees that this colour selection is final and that no changes will be permitted, unless required by the Vendor.
- The Purchaser acknowledges reading and accepting document which contains other miscellaneous disclaimers.


Signature: AM Date: \_\_\_\_\_



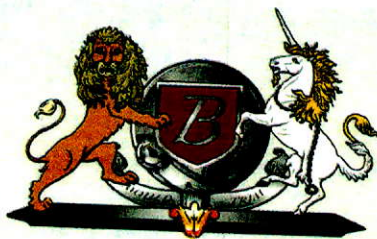


**BABBINGTONS**  
MOULD & TRIM INC.

## INTERIOR SERIES: BCLC-05

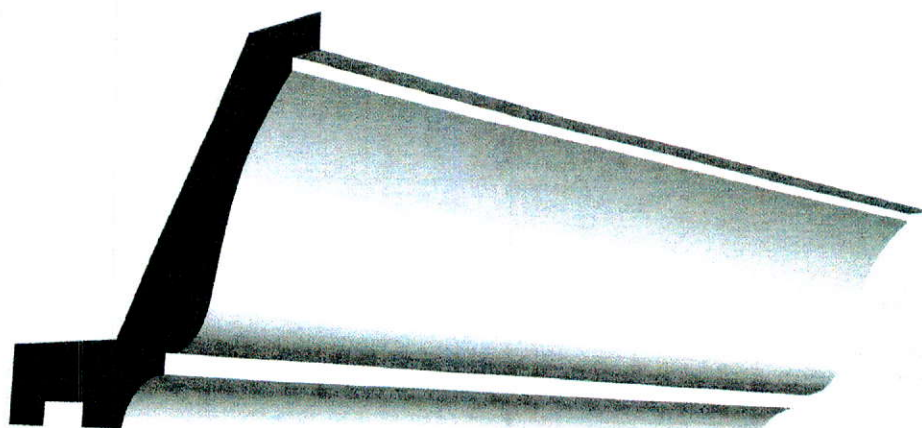

### DIMENSIONS All dimensions are in inches

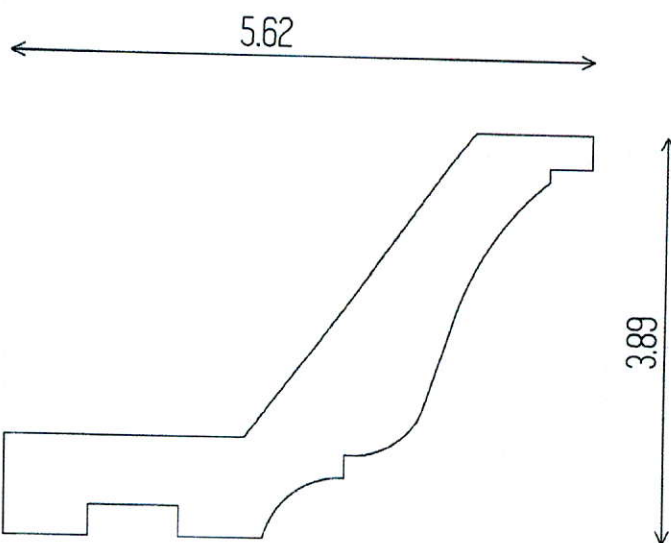

Contact:  
Phone: 905.850.0542  
Fax: 905.850.7659  
Email: [info@babbingtons.com](mailto:info@babbingtons.com)

39 Haist Avenue, Unit 1&2, Woodbridge ON, L4L 5V5  
[www.babbingtons.com](http://www.babbingtons.com)

FILE NAME:  
TIBURTINO 8

PAULINE  
MAR 18 20  
REV JUL 17 20 PB



UPGRADE KITCHEN  
TO LEGACY OR BANCORP

CROWN MLD-CM3  
LIGHT VAL-LS4

BLUMOTION DRWS  
SOFT CLOSE DOORS

THIS LAYOUT CONTAINS EXTRAS  
THAT ARE NOT PART OF CONTRACT

PROTOTYPE  
FOR EXTRAS

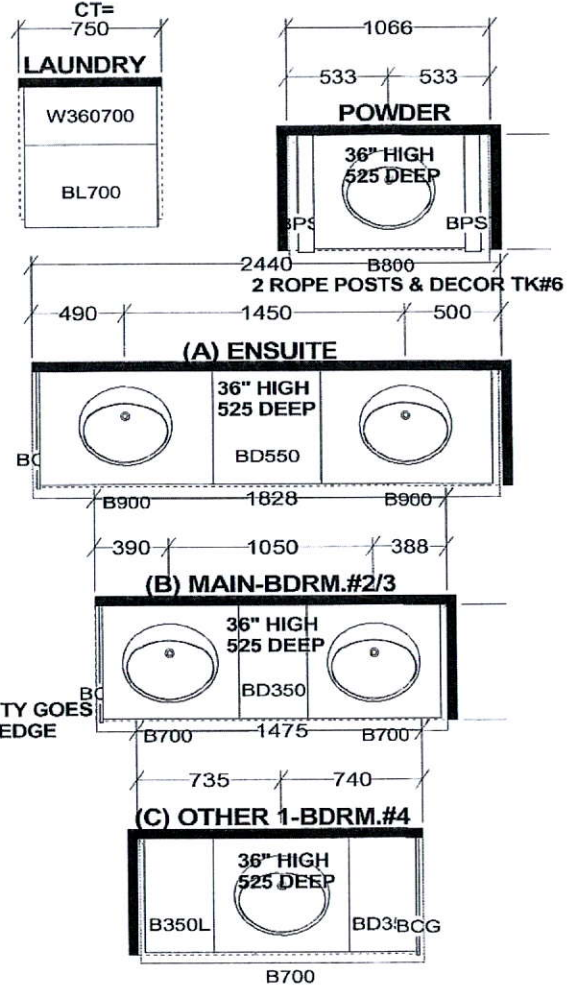
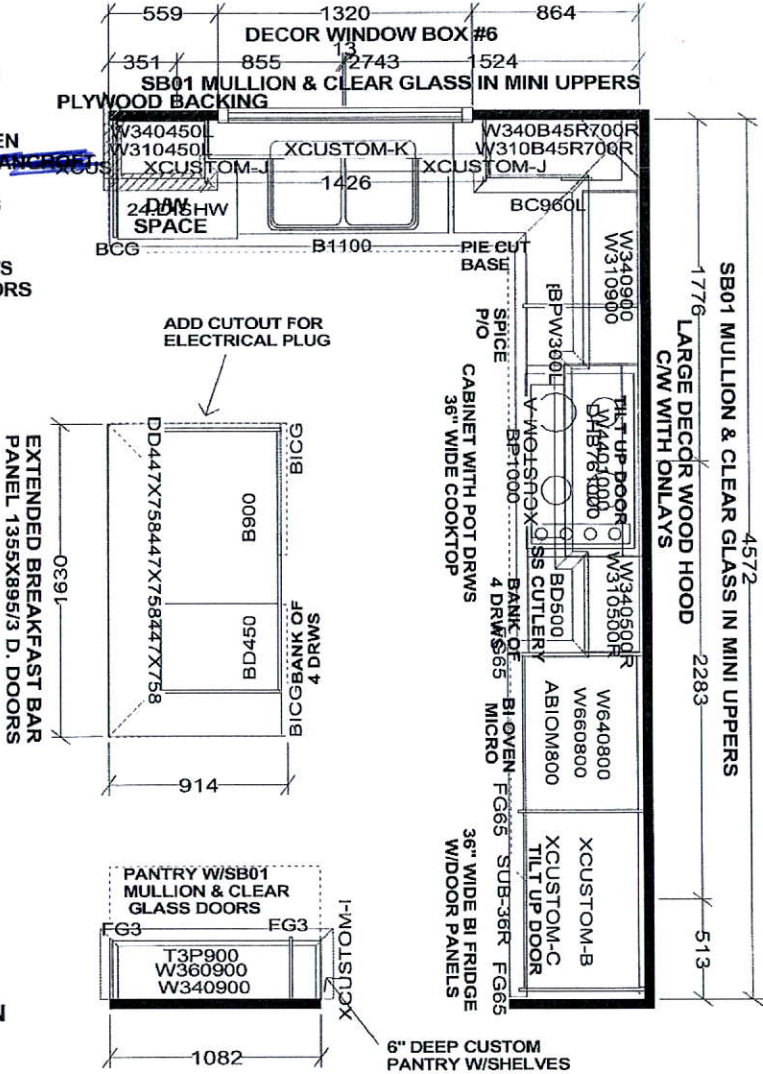


KITCHEN


Selba Industries


W	WDTH	W	HGHT	W	CNT	FL	HGHT	DWY	H	ST	CENT	2X4	VENT	BOX	COVER
This drawing is the intellectual property of SELBA INDUSTRIES INC. and is an original design which must not be released or copied unless applicable fee has been paid or job order placed.															
										JOB NUMBER: BUILDER: GREENYORK SITE NAME: TIBURTINO, Oakville MODEL: GEORGIAN 1X ELEV A,B LOT #: DESIGNER: KS DATE: JAN 24 18 /rev'd June 28 18/ rev'd Aug 31 18/rev'd Sept 20 18					



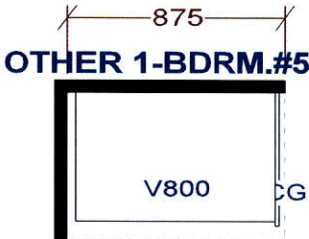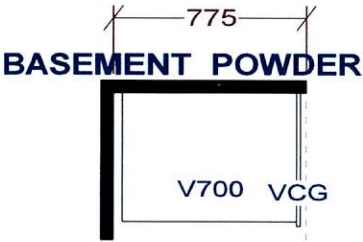

*S e l b a   I n d u s t r i e s*

W WIDTH	W HGHT	W CNT	FL HGHT	DWY H	ST CENT	2X4	VENT BOX COVER	
			<p><i>This drawing is the intellectual property of SELBA INDUSTRIES INC. and is an original design which must not be released or copied unless applicable fee has been paid or job order placed.</i></p>					<p>JOB NUMBER: BUILDER: GREENYORK SITE NAME: TIBURTINO, Oakville MODEL: GEORGIAN 5X ELEV A,B FIN BSMT LOT #: DESIGNER: KS DATE: JAN 24 18/rev'd June 28 18</p>

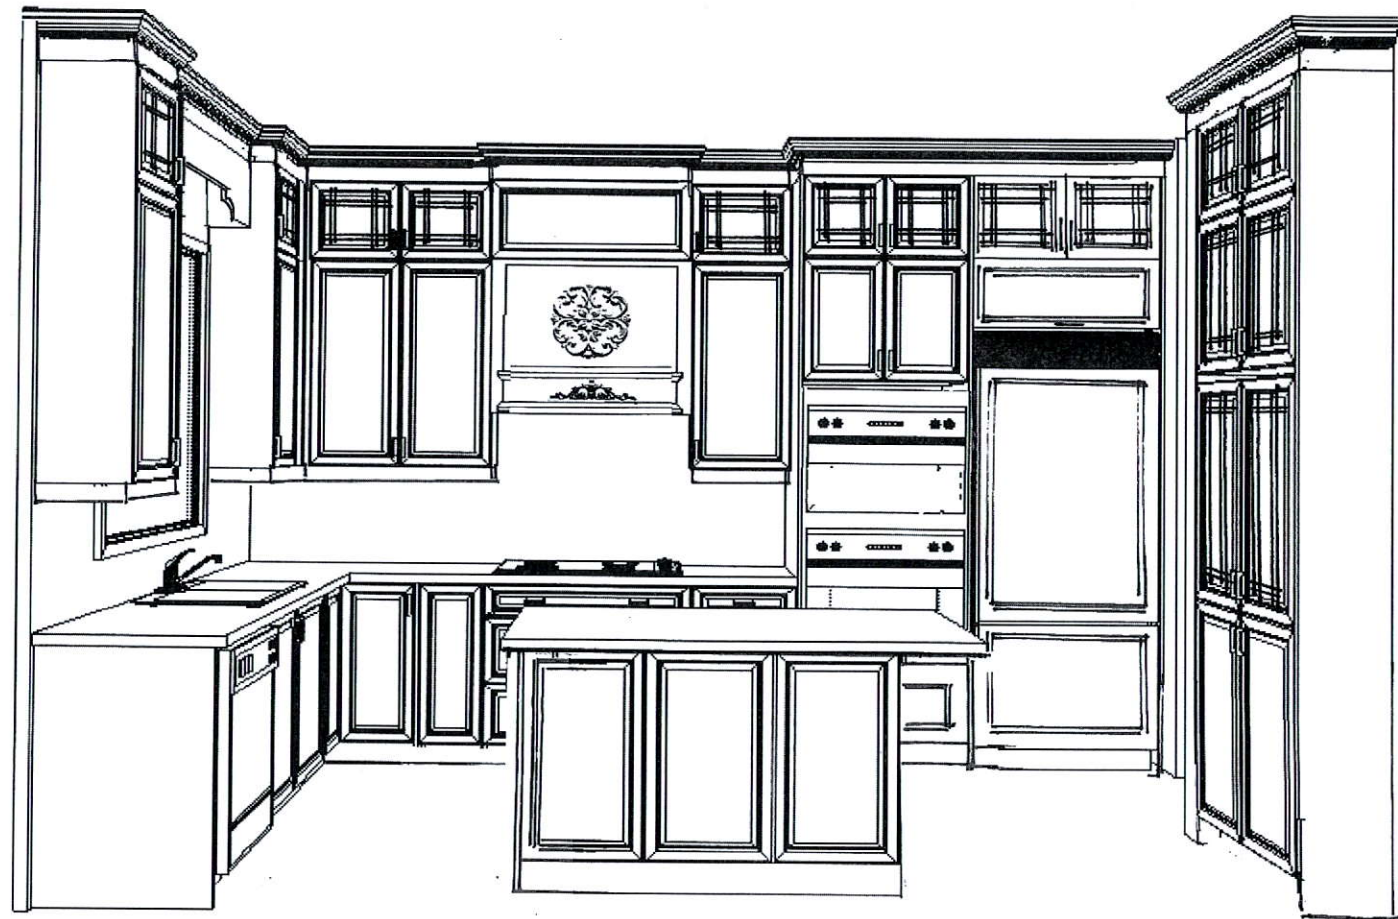

This drawing is the intellectual property of SELBA INDUSTRIES INC. and is an artistic interpretation of the general appearance of the design. It is not meant to be an exact rendition.

**Selba**  
Kitchen + Bath Designs

Designed: 3/18/2020  
Printed: 3/19/2020

3-D VIEW REV. JULY 17/20  
TIBURTINO 8

TIBURTINO 8 Drawing #: 1



SB01  
MULLION  
CLEAR GLASS

WIN VAL BOX #6

CM3

LS4

PIE WT BASE CORNER

This drawing is the intellectual property of  
SELBA INDUSTRIES INC. and is an  
artistic interpretation of the general  
appearance of the design. It is not meant to  
be an exact rendition.


**Selba**  
Kitchen + Bath Designs

Designed: 3/18/2020  
Printed: 3/18/2020

SINK WALL

TIBURTINO 8

TIBURTINO 8 Drawing #: 1

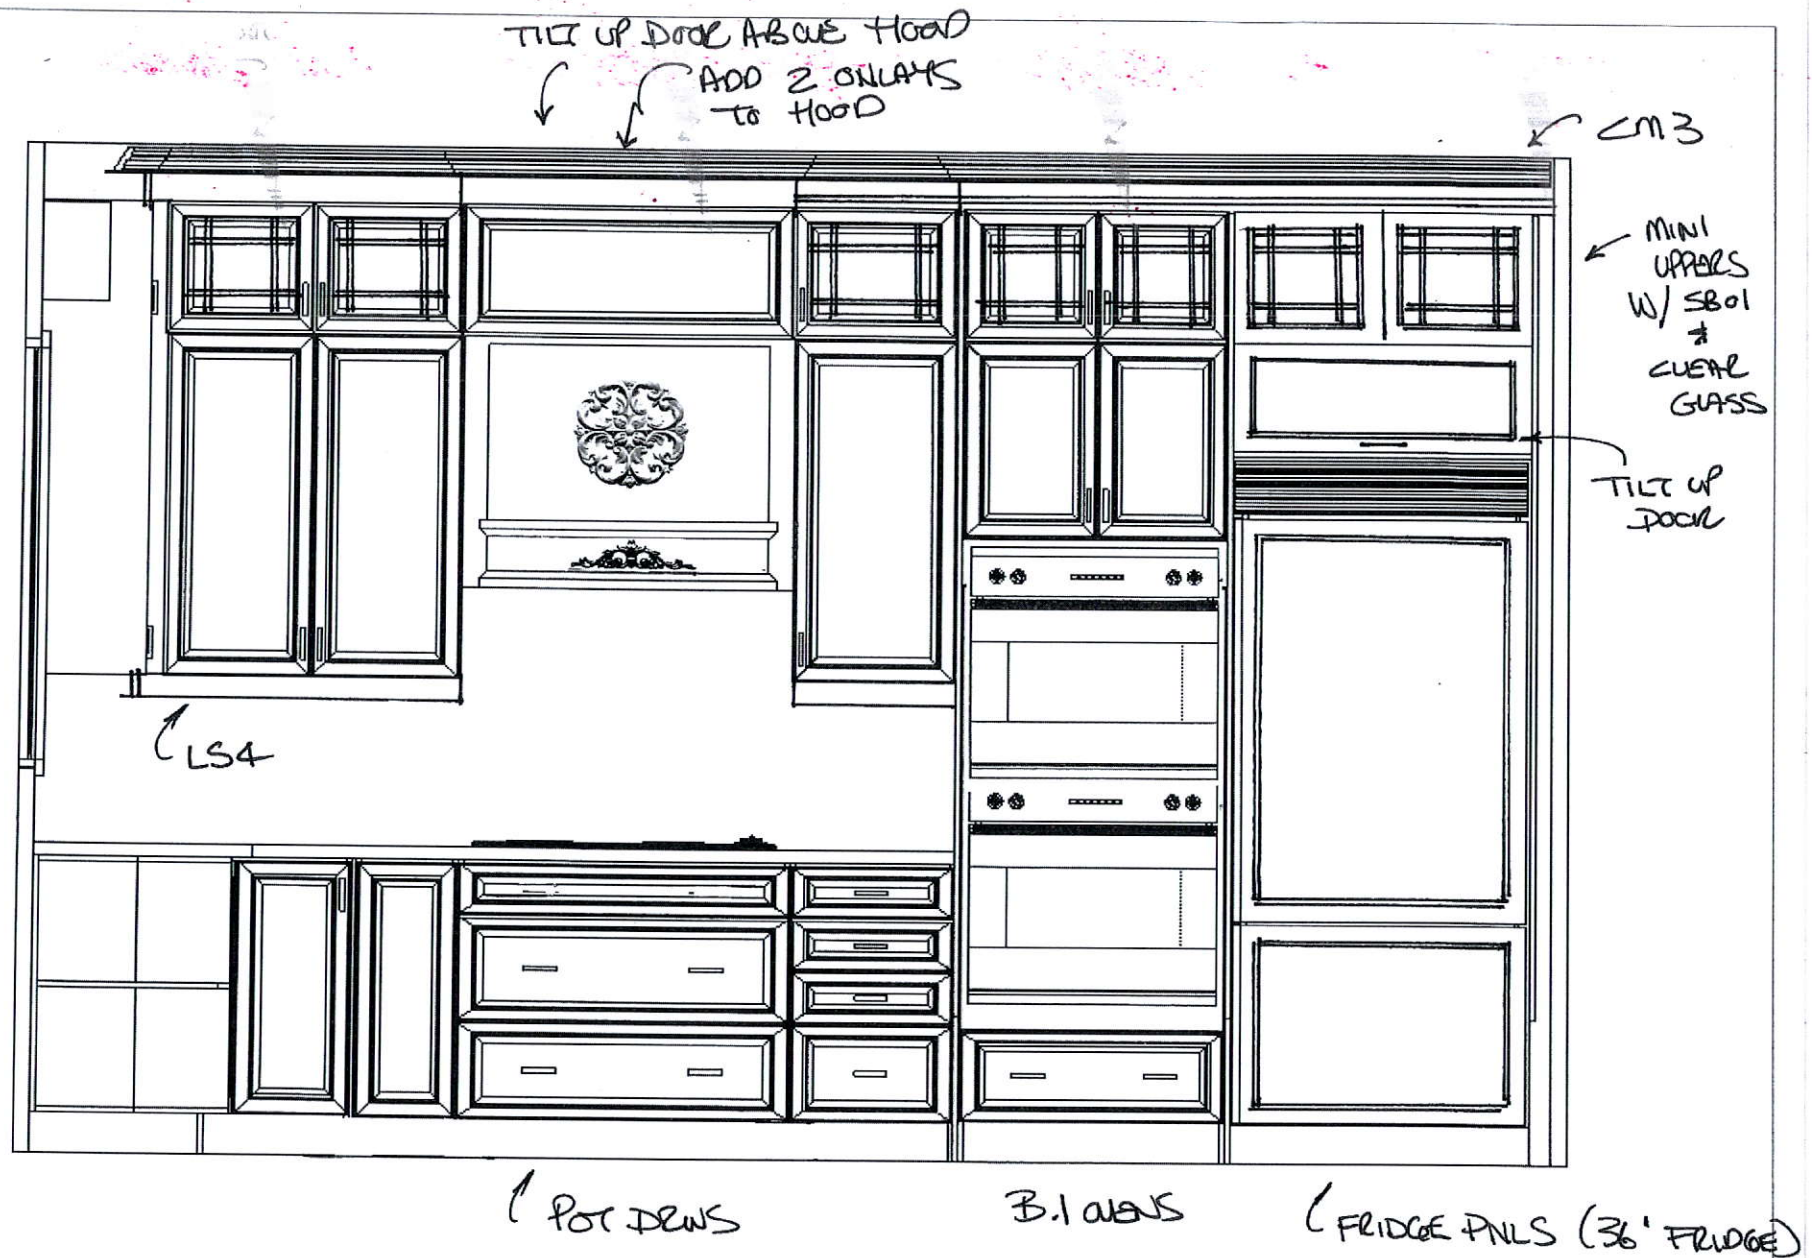

This drawing is the intellectual property of  
SELBA INDUSTRIES INC. and is an  
artistic interpretation of the general  
appearance of the design. It is not meant to  
be an exact rendition.

STOVE WALL

TIBURTINO 8


**SELBA**

Kitchen + Bath Designs


Designed: 3/18/2020  
Printed: 3/18/2020

TIBURTINO 8 Drawing #: 1



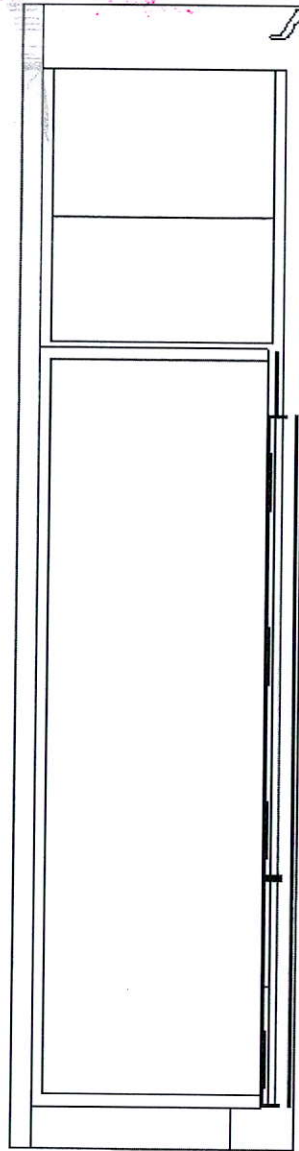

6" DEEP  
PANTRY  
@ SIDE

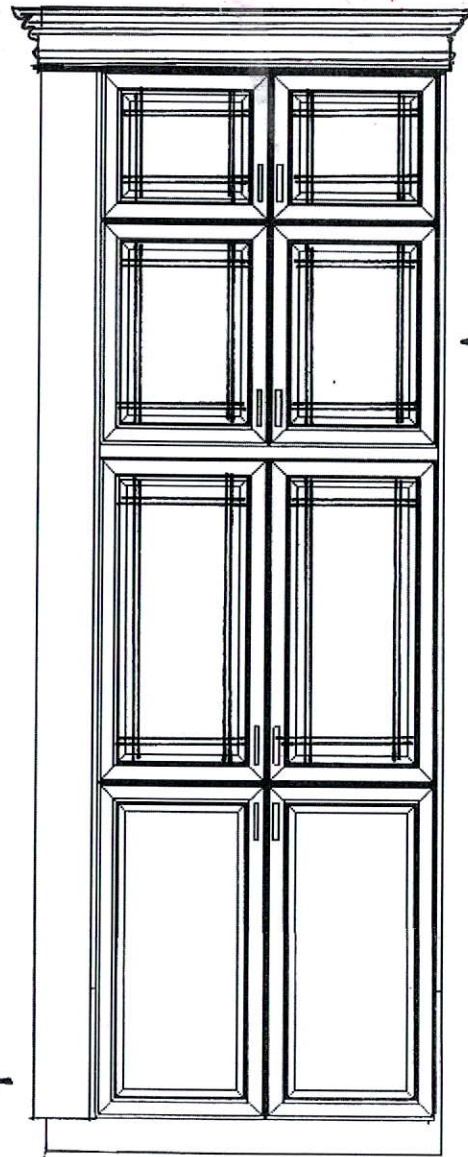

5801 MULLION  
& CLEAR GLASS

PUCK LIGHTS & GLASS  
SHOWERS

This drawing is the intellectual property of  
SELBA INDUSTRIES INC. and is an  
artistic interpretation of the general  
appearance of the design. It is not meant to  
be an exact rendition.


**Selba**

Kitchen + Bath Designs


Designed: 3/18/2020  
Printed: 3/18/2020

PANTRY  
TIBURTINO 8


TIBURTINO 8 Drawing #: 1

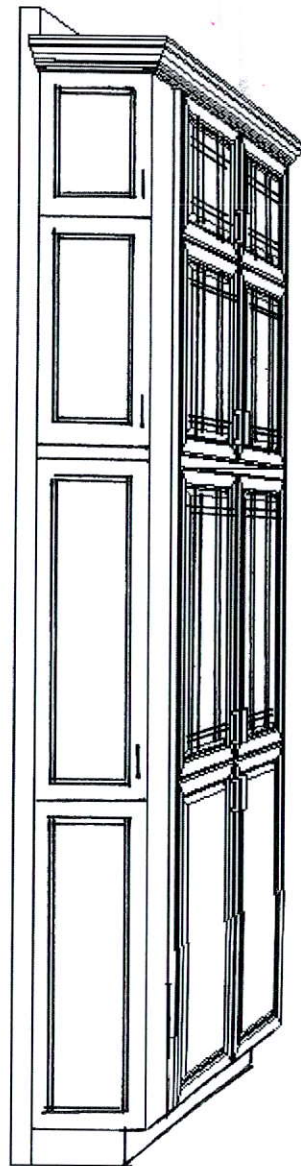

↑ LITTLE SIDE PANTRY  
6-8" DEPT T.B.C.

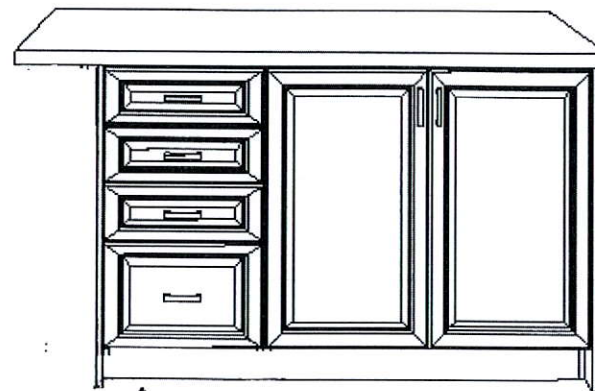

↑  
X-TRA  
B/D

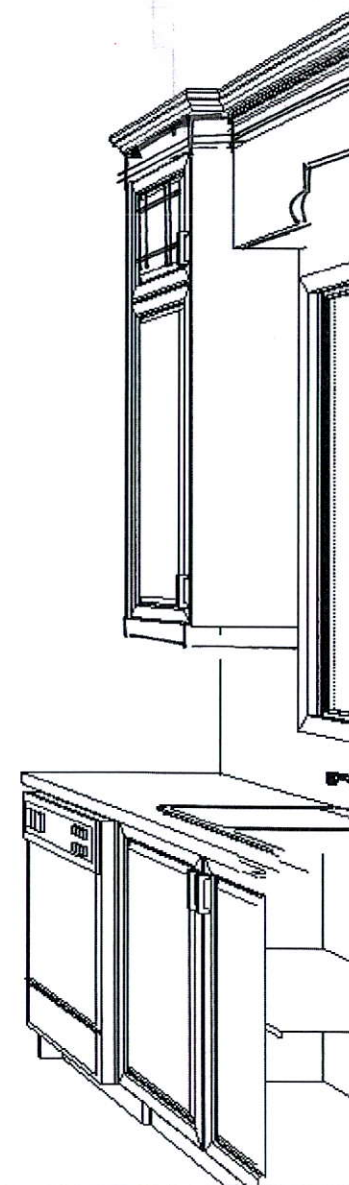

This drawing is the intellectual property of SELBA INDUSTRIES INC. and is an artistic interpretation of the general appearance of the design. It is not meant to be an exact rendition.


**Selba**  
Kitchen + Bath Designs

Designed: 3/18/2020  
Printed: 3/18/2020

INSIDE ISLAND VIEW REV JUN 17/20  
TIBURTINO 8

TIBURTINO 8 Drawing #: 1



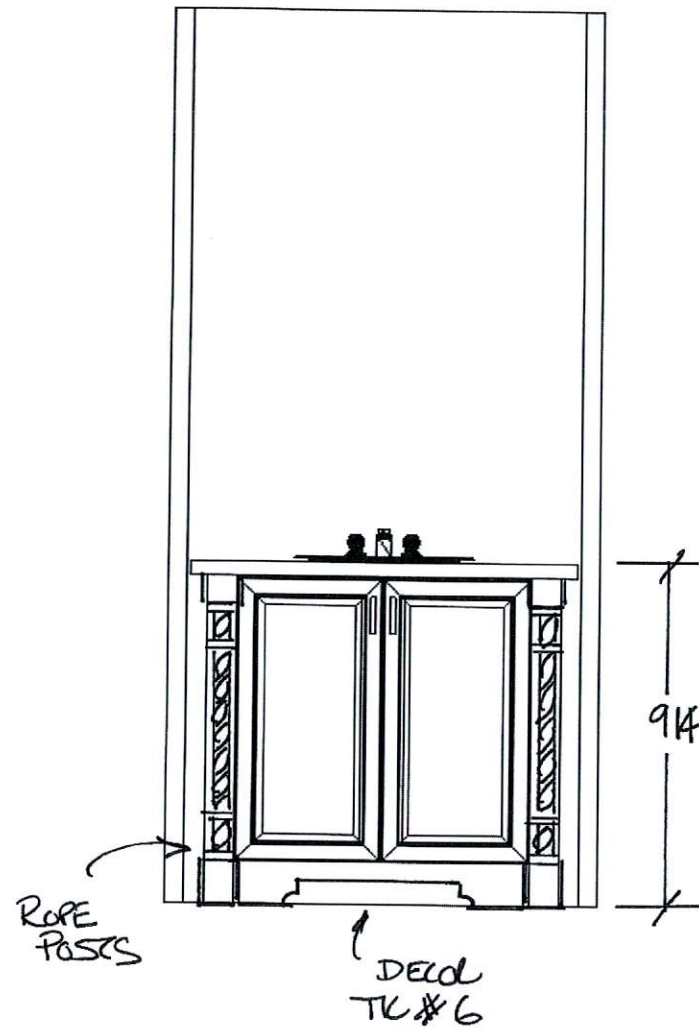

Tuscany  
821X24-  
Virginia


This drawing is the intellectual property of SELBA INDUSTRIES INC. and is an artistic interpretation of the general appearance of the design. It is not meant to be an exact rendition.

**SELBA**  
Kitchen + Bath Designs

Designed: 3/18/2020  
Printed: 3/18/2020

POWDER  
TIBURTINO 8

TIBURTINO 8 Drawing #: 1

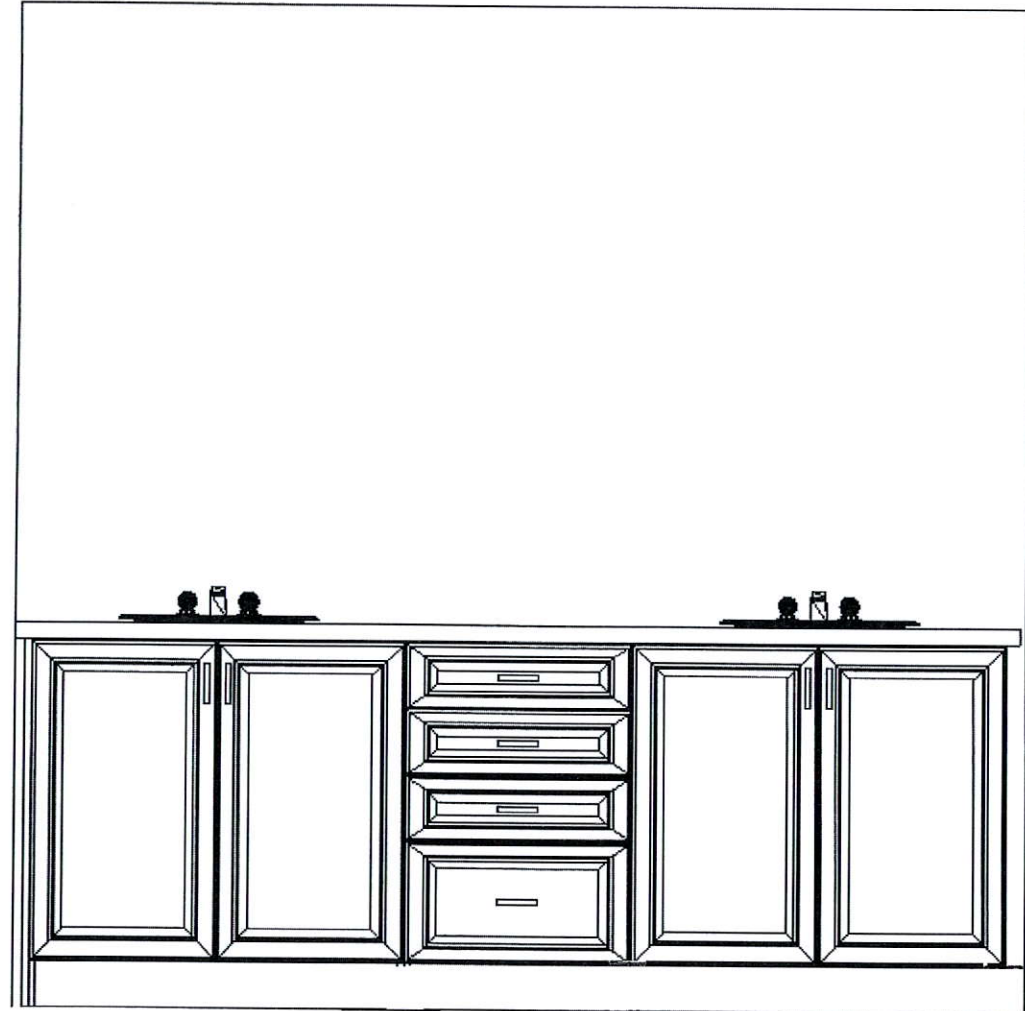

Tuscan  
821X20.

914 Mountain  
Grey

This drawing is the intellectual property of  
SELBA INDUSTRIES INC. and is an  
artistic interpretation of the general  
appearance of the design. It is not meant to  
be an exact rendition.


**Selba**  
Kitchen + Bath Designs

Designed: 3/18/2020  
Printed: 3/18/2020

ENSORTE  
TIBURTINO 8

TIBURTINO 8 Drawing #: 1



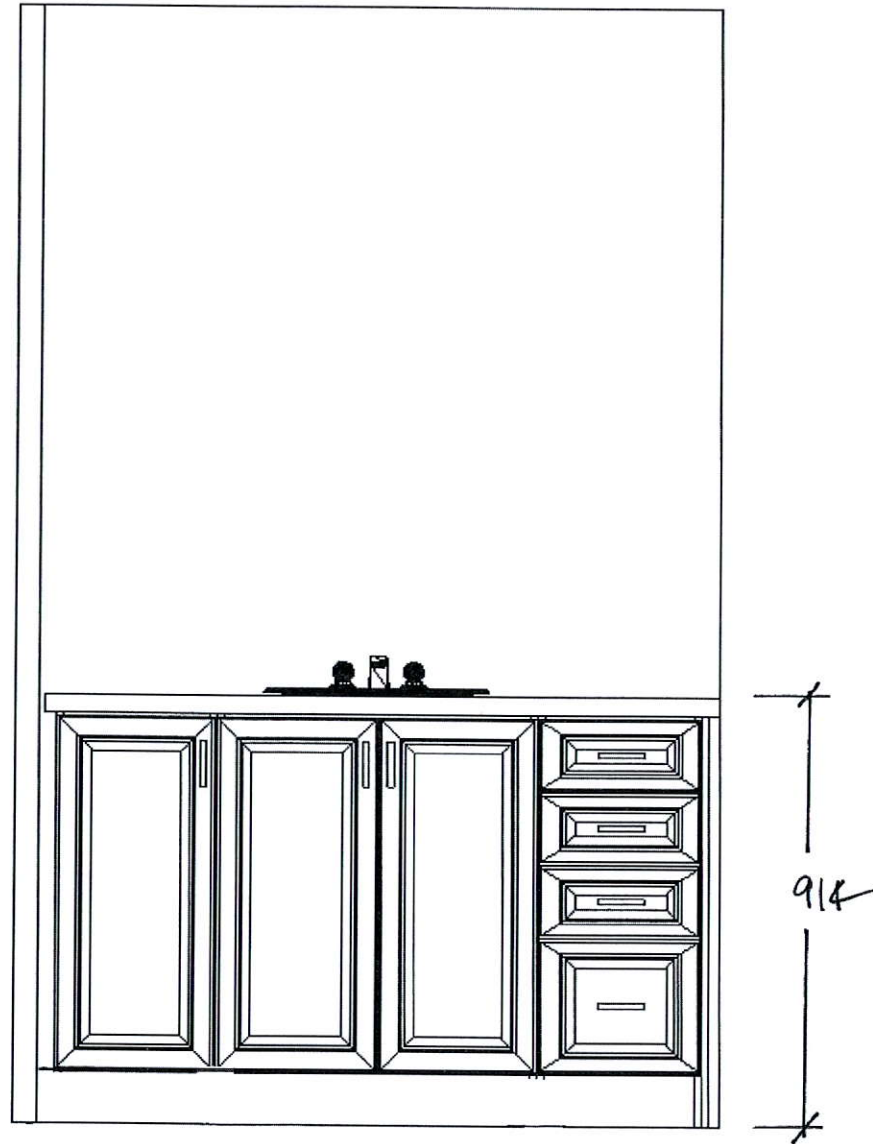

This drawing is the intellectual property of  
SELBA INDUSTRIES INC. and is an  
artistic interpretation of the general  
appearance of the design. It is not meant to  
be an exact rendition.


3004

TIBURTINO 8

**Selba**  
Kitchen + Bath Designs

Designed: 3/18/2020  
Printed: 3/18/2020

TIBURTINO 8 < 1

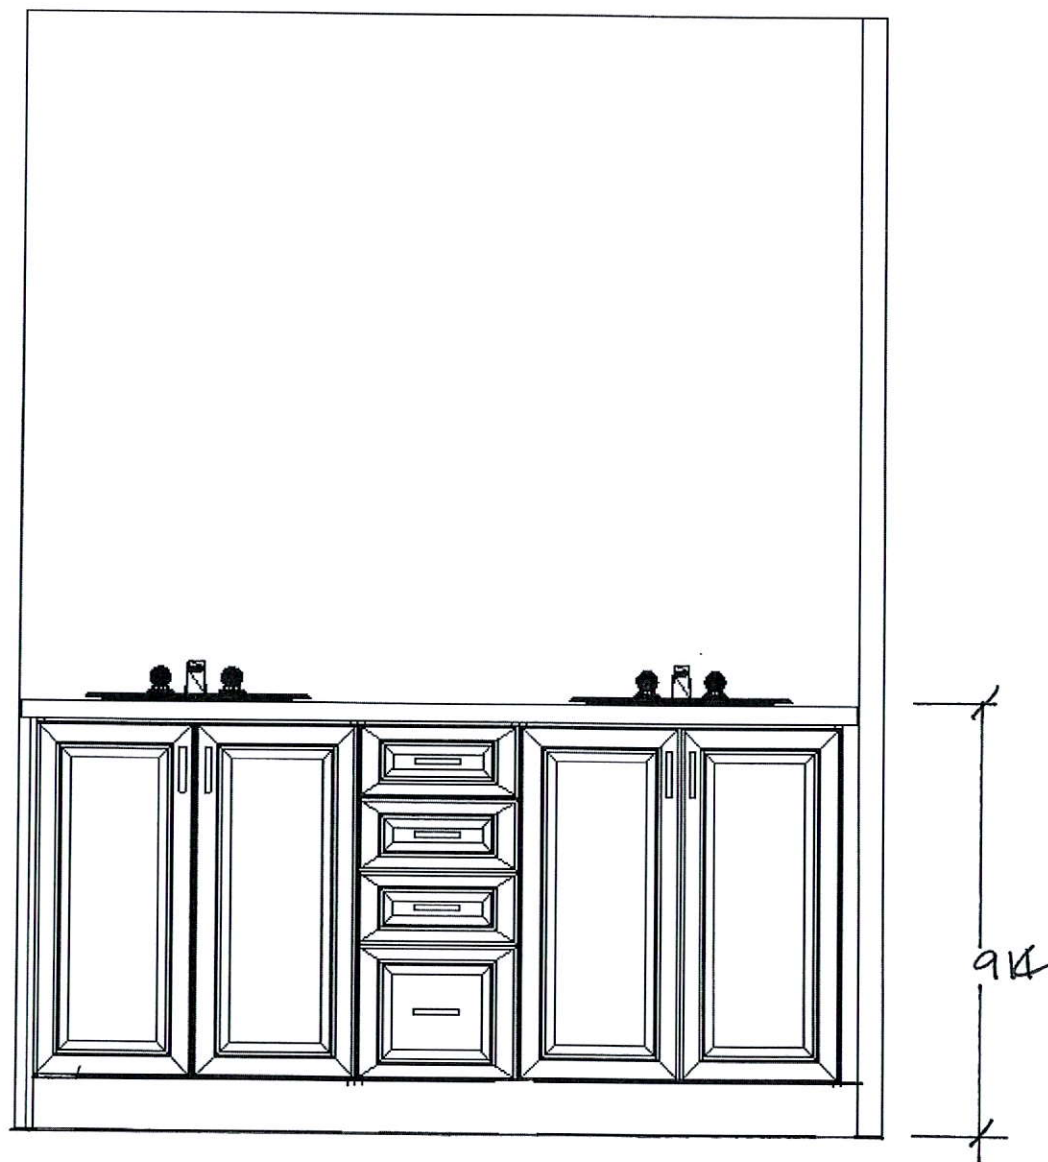

This drawing is the intellectual property of  
SELBA INDUSTRIES INC. and is an  
artistic interpretation of the general  
appearance of the design. It is not meant to  
be an exact rendition.

**Selba**  
Kitchen + Bath Designs

Designed: 3/18/2020  
Printed: 3/18/2020


Bed 2/3

TIBURTINO 8


TIBURTINO 8 Drawing #: 1



# Lot 8 Tiburtino

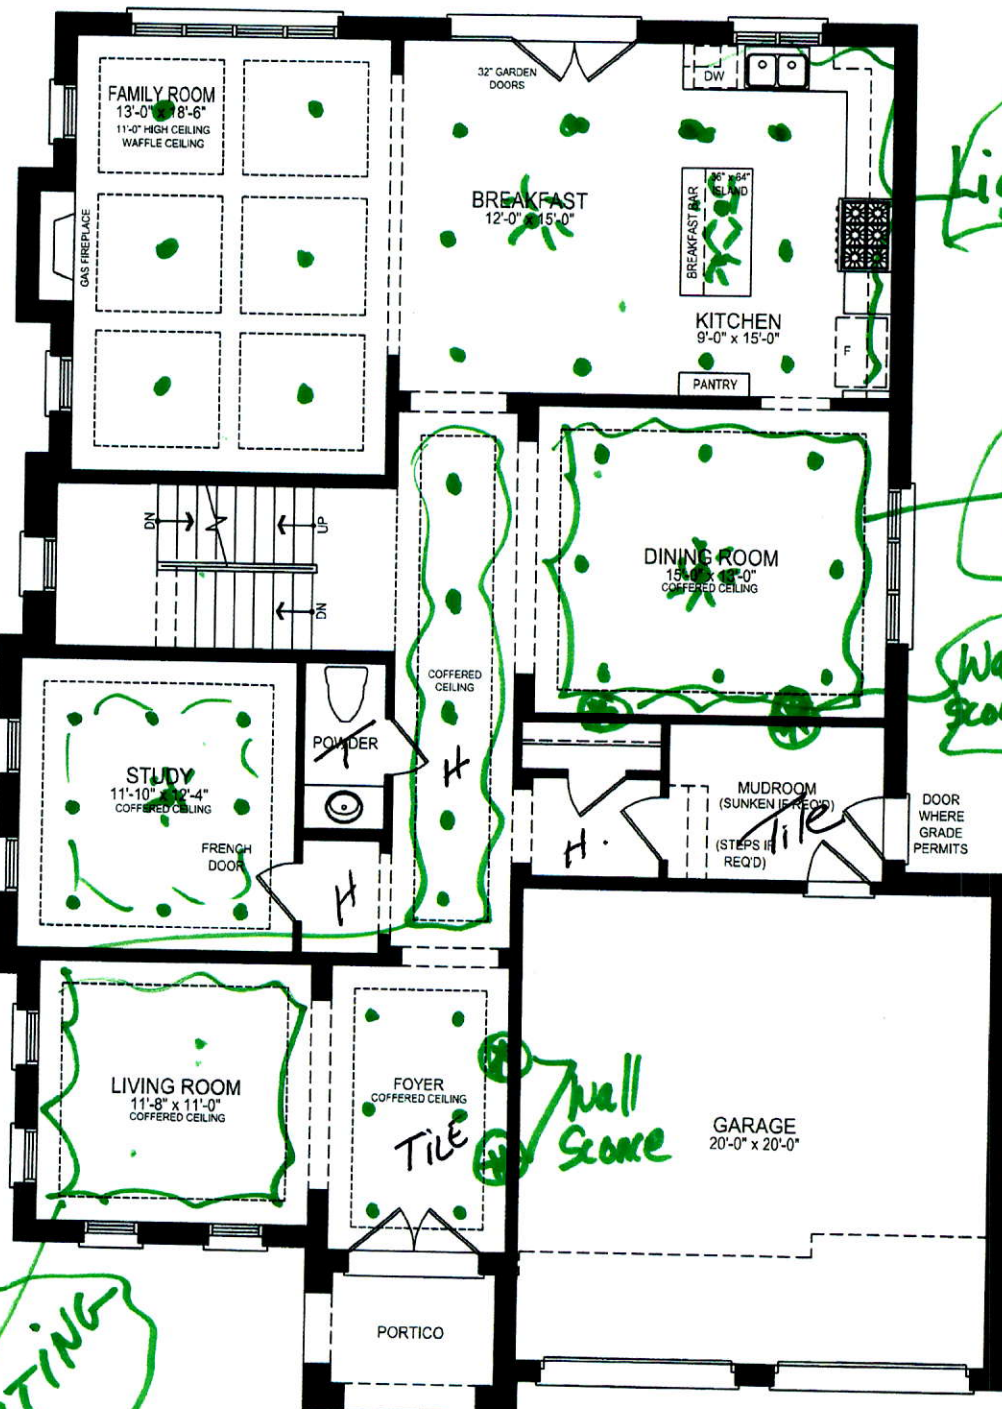


GEORGIAN 1 MAIN LEVEL EB  
REVISED 08.15.18

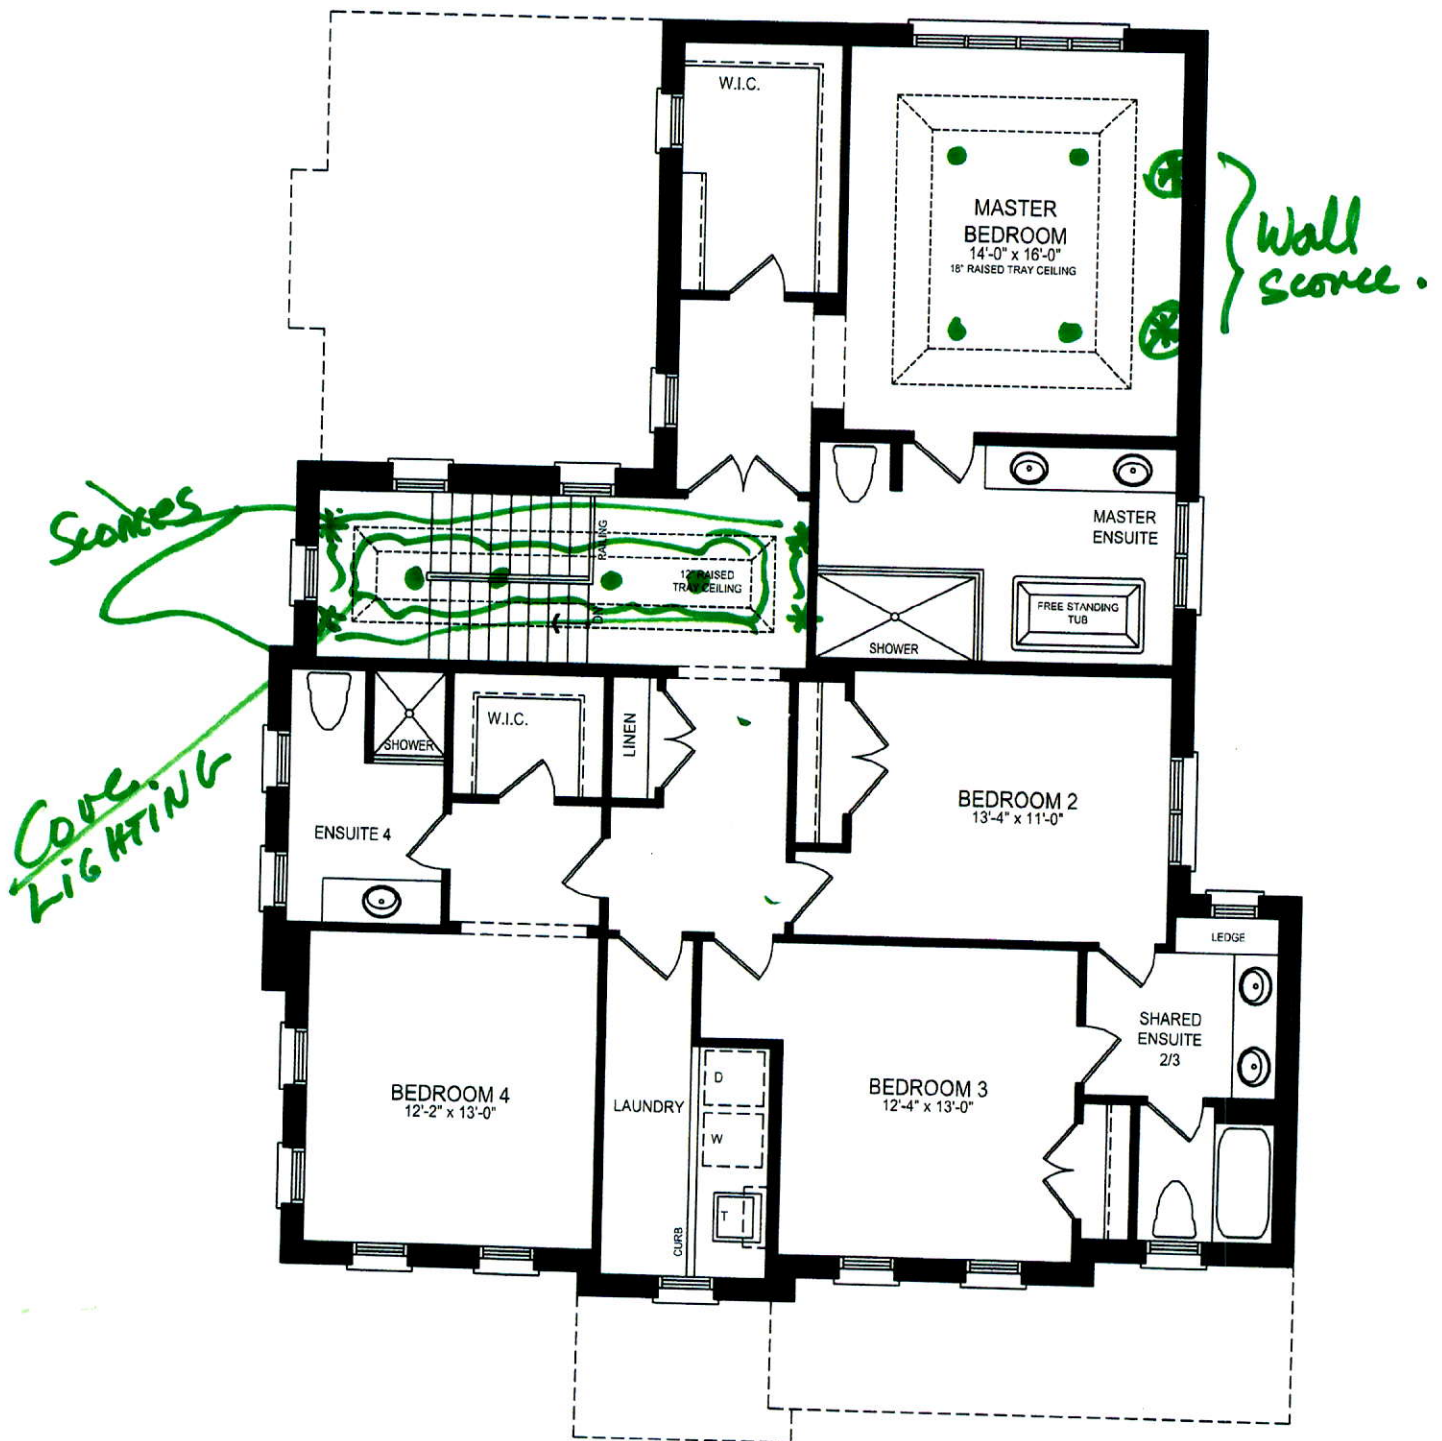

GEORGIAN 1 UPPER LEVEL EB  
REVISED 08.10.18



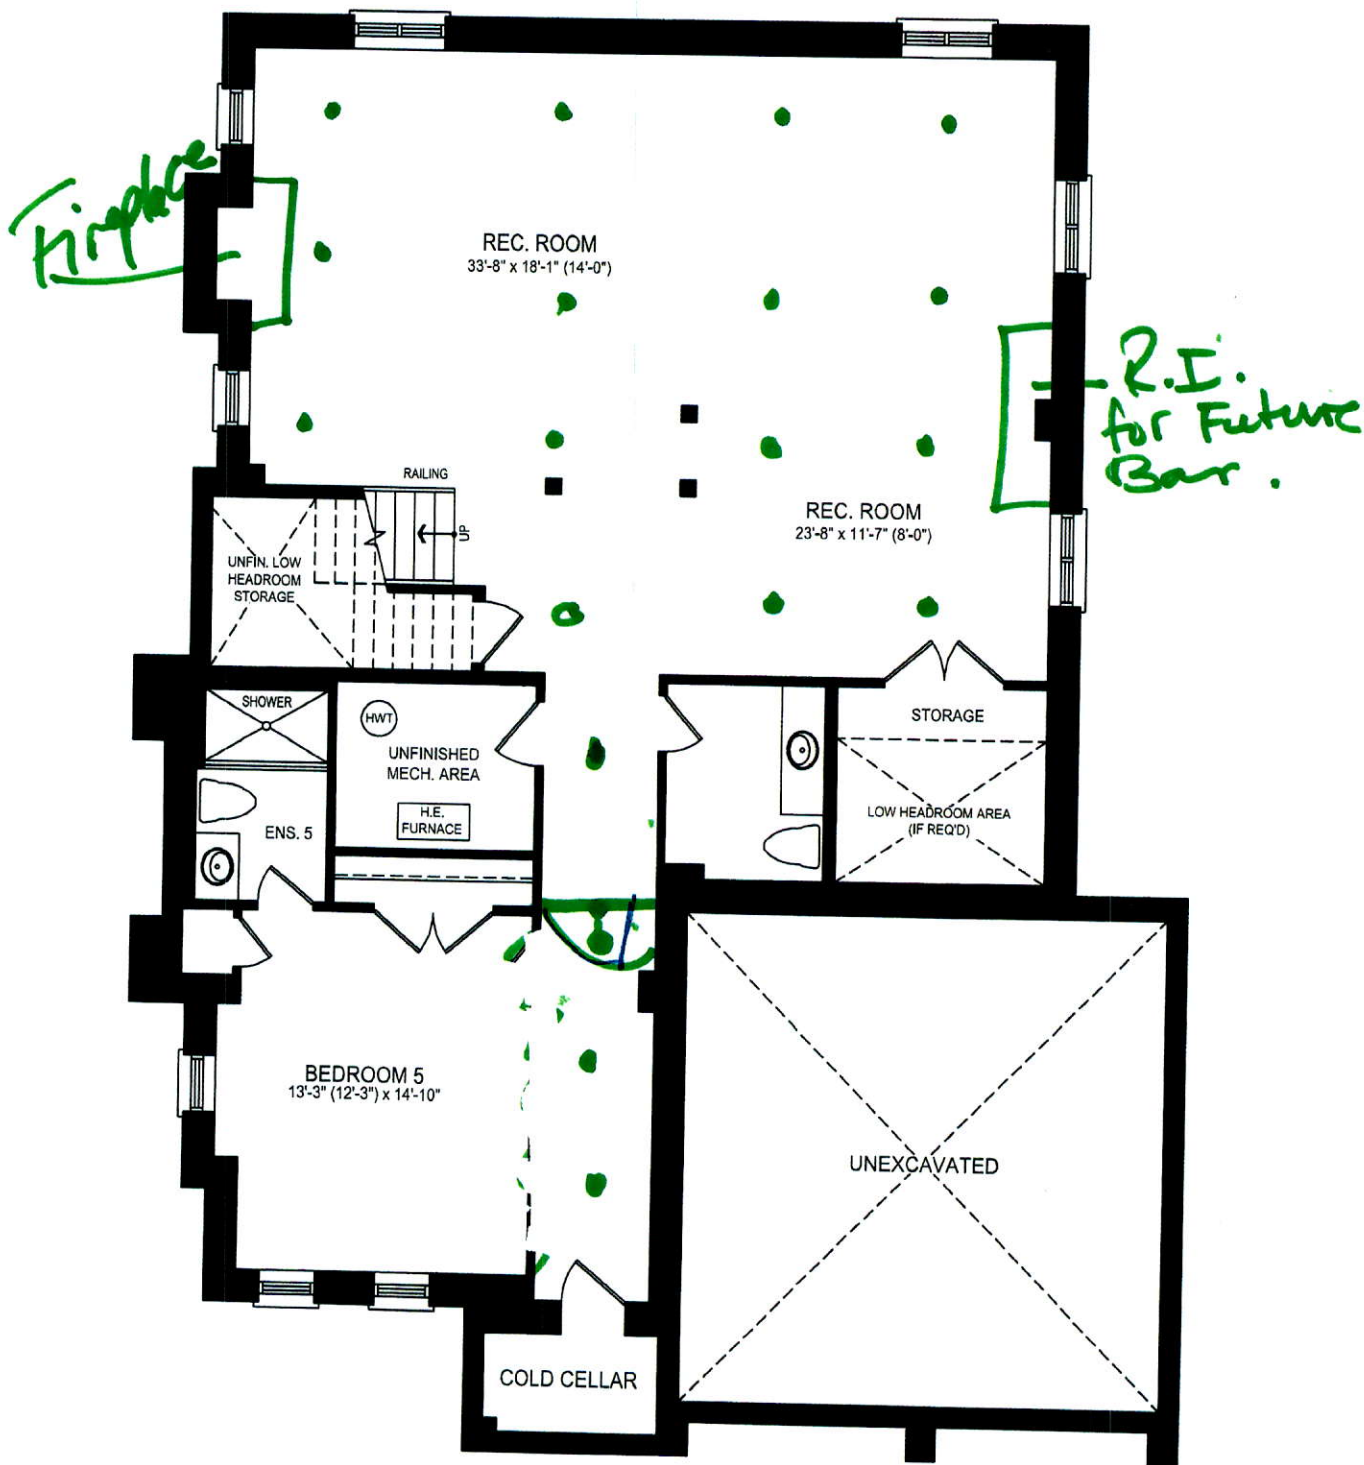

GEORGIAN 1 LOWER LEVEL EA  
REVISED 08.10.18