

CONSTRUCTION SUMMARY

Mountainview Heights 3 (G) - Russell Gardens Building Ltd.

PURCHASERS: Abdul MOID and Moona MOID

JUL 23 2020

TEL:

LOT / PHASE	REG. PLAN #	HOUSE TYPE
307 / 3	62M-1266	Valleycreek Four Elev 3

CONSTRUCTION

1 - MASTER ENSUITE - FRAMELESS GLASS SHOWER ENCLOSURE INCLUDES CHROME KNOB & HINGES 21Jul20 Note: IF CONSTRUCTION PERMITS

ELECTRICAL

1 - 200 AMP ELECTRICAL SERVICE 21Jul20 Note:

PLUMBING

3 - TOE TESTER - ADD TOE TESTER TO SHOWER - ALL SHOWERS 21Jul20 Note:
--

PROMOTIONAL



1 - PARTIAL REDEMPTION OF PROMOTIONAL PACKAGE \$4,815.00 BALANCE (\$10,185.00) FORWARD TO BE USED AT A LATER DATE. ORIGINAL PROMOTIONAL PACKAGE OF \$15,000.00 AS PER SCHEDULE PE DATED 07/05/2020. 21Jul20 Note:
--

EXTRAS AS PER OFFER


The Vendor agrees that notwithstanding any other term or provision in this Agreement included in the Purchase Price and in addition to those items detailed in Schedule GP to the Agreement of Purchase and Sale, the Purchaser is entitled to a credit of Fif Worksheet Note:

This Document is Extremely Time Sensitive - Printed 21 Jul 20 at 16:29

TM

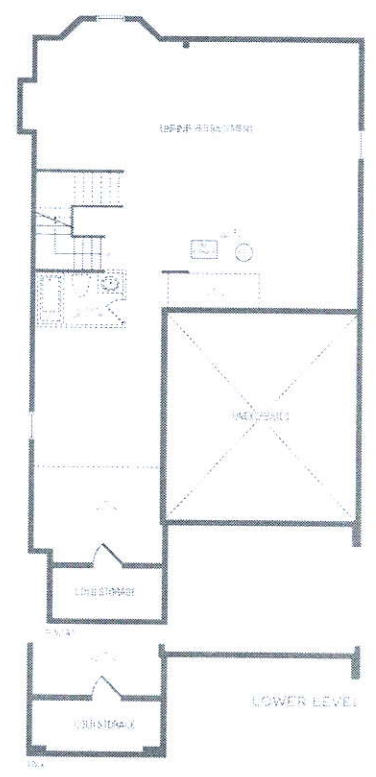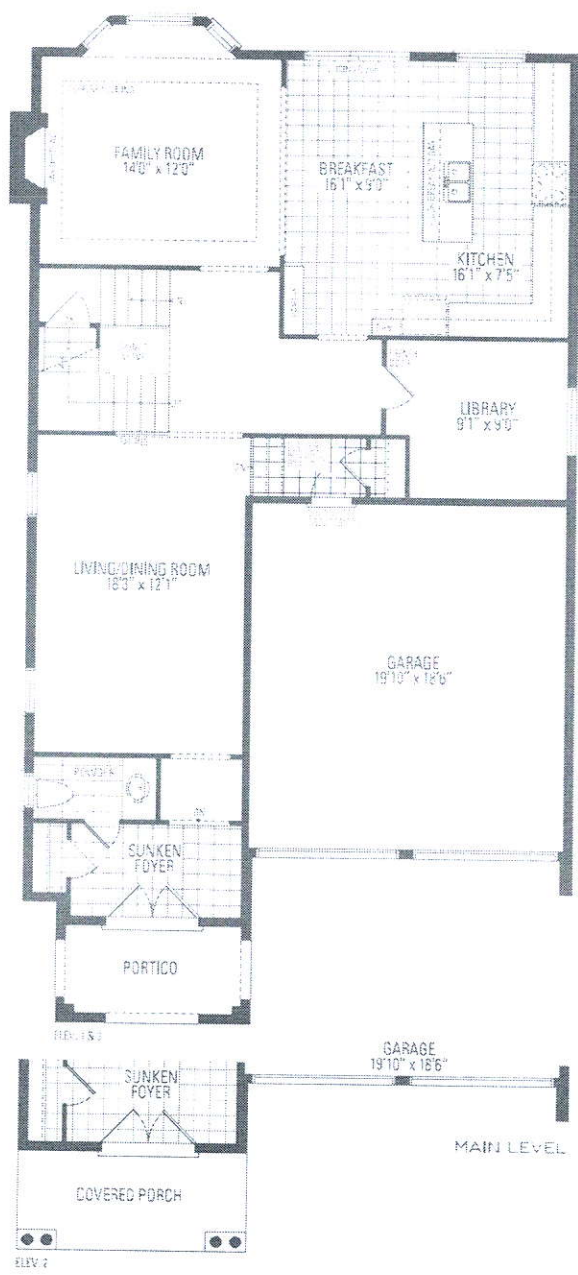

200 AMP

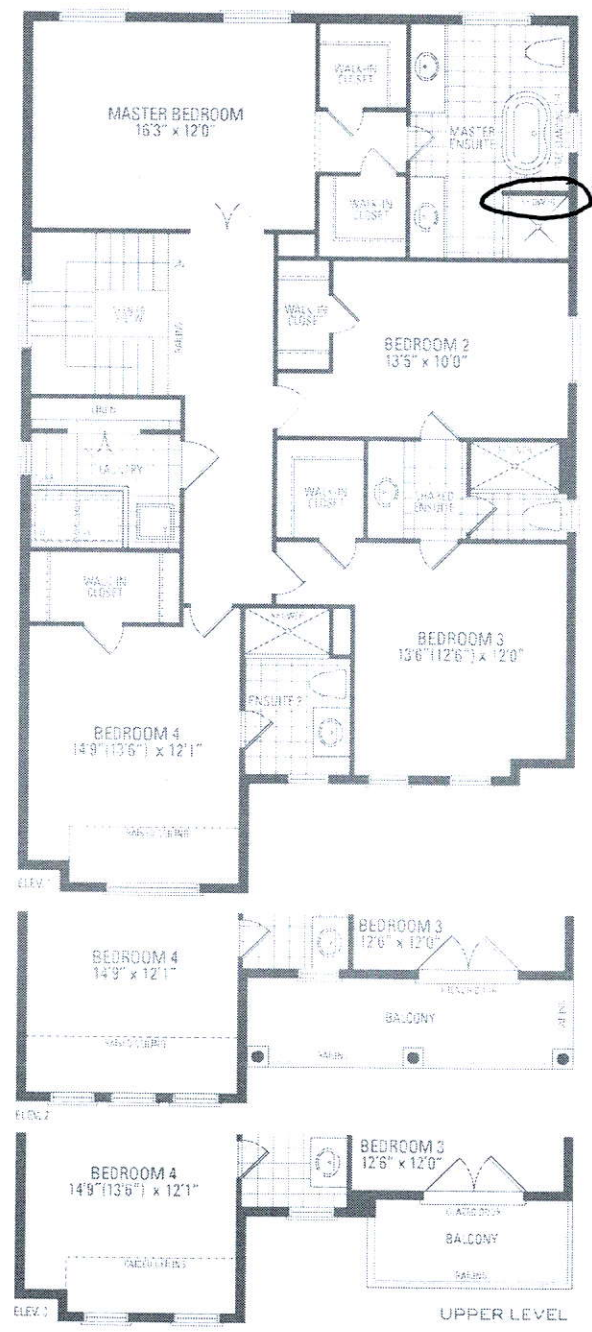

Frameless Glass Shower Enclosure

Lot 307 Russell Gardens III
VALLEYCREEK FOUR ELEV. 1 • 2,814 sq.ft. | ELEV. 2 • 2,805 sq.ft. | ELEV. 3 • 2,816 sq.ft.

Orientation of home may be reversed and purchaser agrees to accept the same. Steps and porches may vary at any exterior entrance ways due to grading variance. Actual usable floor space may vary from the stated floor areas. All renderings are artist's concept. Dimensions, specifications and architectural detailing subject to modifications. Roughing and adjoining model types may vary due to site. E. & D. E. May 2020