

CONSTRUCTION SUMMARY
Mountainview Heights 3 (G) - Russell Gardens Building Ltd.

JUL 20 2020

PURCHASERS: Ritu CHAUDHARY and Shakti SINGH

TEL:

LOT / PHASE	REG. PLAN #	HOUSE TYPE	
313 / 3	62M-1266	Mountainash Six (4 Bedroom) Elev 3	

CONSTRUCTION

1 - MASTER ENSUITE - FRAMELESS GLASS SHOWER DOOR & FRONT WALL AT SEAT INCLUDES CHROME KNOB & HINGES 14Jul20 Note: IF CONSTRUCTION PERMITS	
4 - ENLARGE BASEMENT WINDOWS (MAY REQUIRE WINDOW WELLS) - WINDOW IS 30 INCHES X 24 INCHES 14Jul20 Note: IF CONSTRUCTION PERMITS	

ELECTRICAL


1 - 200 AMP ELECTRICAL SERVICE 14Jul20 Note:	
---	--

PROMOTIONAL


1 - PARTIAL REDEMPTION OF PROMOTIONAL PACKAGE \$5,305.00 BALANCE (\$6,695.00) FORWARD TO BE USED AT A LATER DATE. ORIGINAL PROMOTIONAL PACKAGE OF \$12,000 AS PER SCHEDULE PE DATED 07/04/2020. 14Jul20 Note:	
--	--

This Document is Extremely Time Sensitive - Printed 14 Jul 20 at 9:34


TM

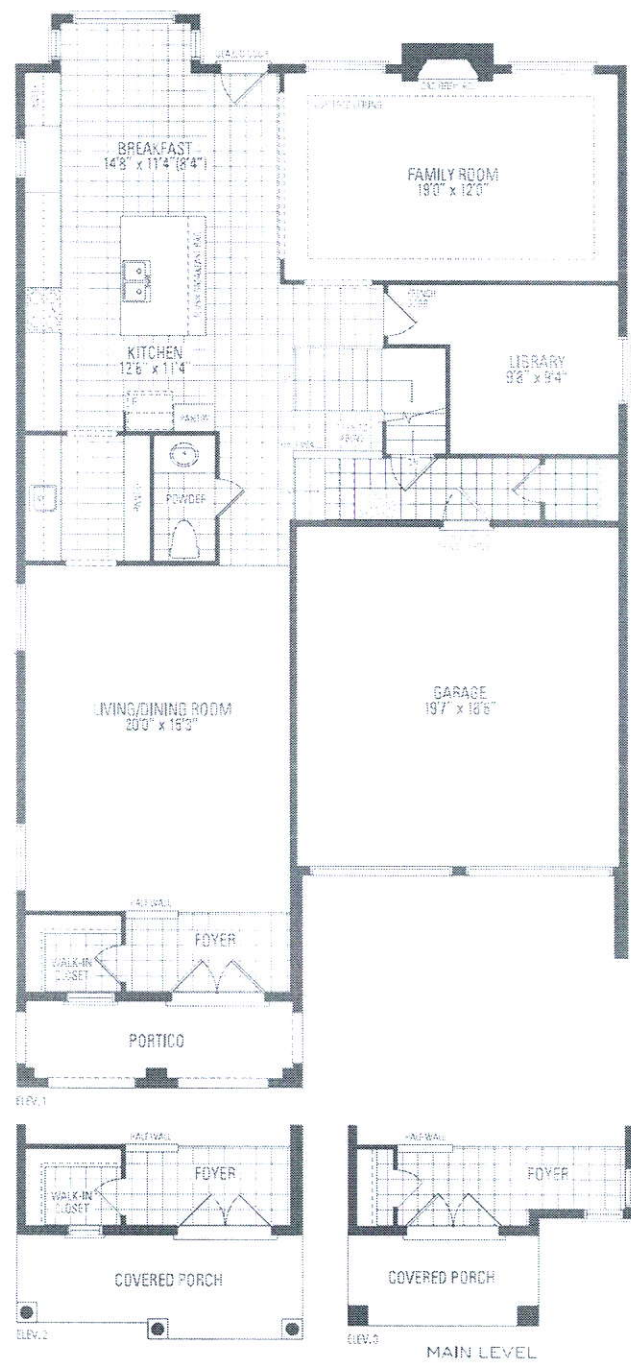

Enlarged Basement Windows

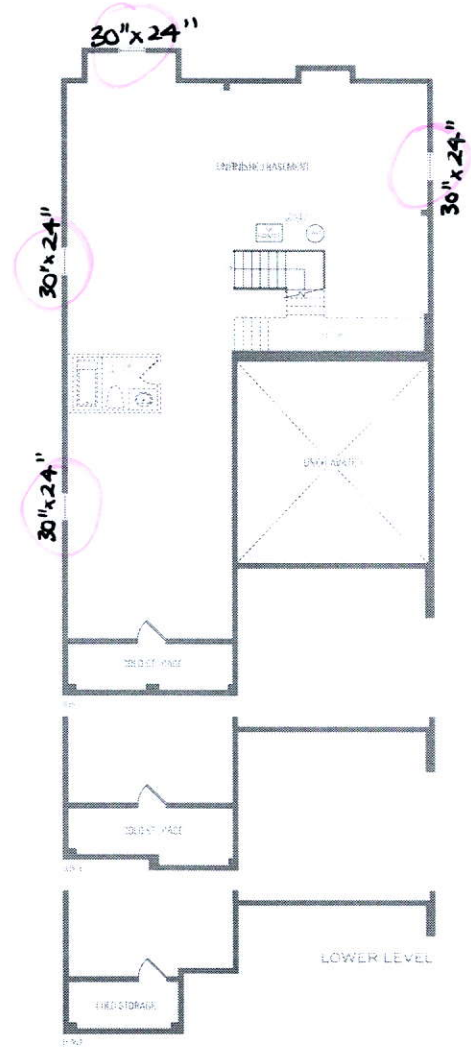

200 AHP

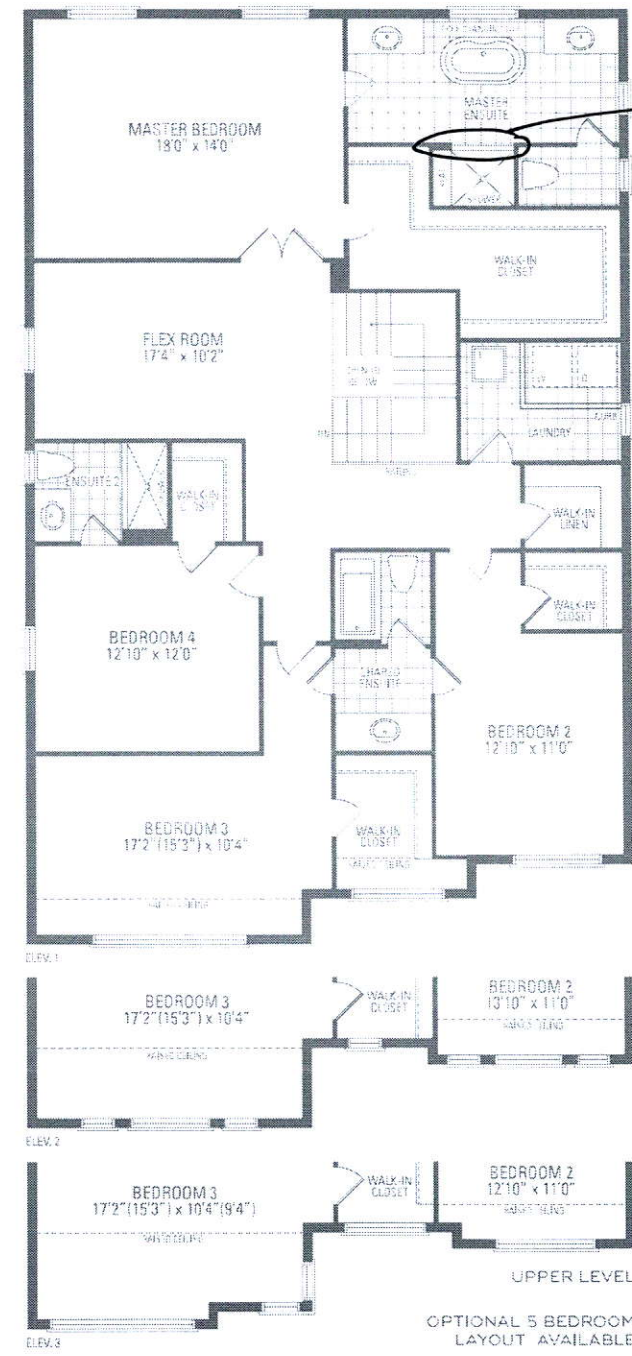

Frameless Glass shower Door and Wall At seat

Lot 313 Russell Gardens III
MOUNTAINASH SIX ELEV. 1 • 3,409 sq.ft. | ELEV. 2 • 3,403 sq.ft. | ELEV. 3 • 3,368 sq.ft.

Orientation of home may be reversed and purchaser agrees to accept the same. Steps and porches may vary at any external entrance ways due to grading variance. Actual usable floor space may vary from the stated floor areas. All renderings are a list's concept. Dimensions, specifications and architectural detailing subject to modifications. Roofline and adjoining model types may vary due to site. E & D. E. May 2020