

PURCHASERS: REY KEYVANI and KRISTINA EVELYN KEYVANI				CONSTRUCTION SUMMARY		RECEIVED	
Elizabeth Heights - Trinar Hall Homes Inc.						SEP 28 2020	
TEL:							
LOT / PHASE		REG. PLAN #	HOUSE TYPE				
15 / 1		65M-4671	BRENTWOOD 2 ELEV 2				

CONSTRUCTION

1 - MASTER ENSUITE- DELETE WALL AND DOOR IN FRONT OF TOILET- 21Aug20 Note: See Sketch:	
3 - ENLARGE BASEMENT WINDOWS (MAY REQUIRE WINDOW WELLS) - WINDOW IS 30 INCHES X 24 INCHES 21Aug20 Note:	

ELECTRICAL

1 - 200 AMP ELECTRICAL SERVICE 21Aug20 Note:	
---	--

MIRRORS AND GLASS

1 - MASTER ENSUITE - FRAMELESS GLASS SHOWER ENCLOSURE -- INCLUDES CHROME KNOB AND HINGES 21Aug20 Note:	
---	--

PLUMBING

1 - BEDROOM 4 ENSUITE-----DELETE SHOWER AND INSTALL 5 TUB 21Aug20 Note:	
--	--


PROMOTIONAL

1 - PARTIAL REDEMPTION OF PROMOTIONAL PACKAGE \$\$\$\$\$\$ BALANCE FORWARD TO BE USED AT A LATER DATE. ORIGINAL PROMOTIONAL PACKAGE OF \$\$\$\$\$ AS PER SCHEDULE PE DATED MM/DD/YYYY. 21Aug20 Note: PROMO AS PER OFFER \$15,000.00 LESS \$6,820.00 NEW BALANCE PROMO \$8,180.00 *	
--	--





EXTRAS AS PER OFFER

PURCHASER(S) ACKNOWLEDGES THAT THE PURCHASE PRICE IS INCLUSIVE OF ALL CREDITS AND PROMOTIONAL PACKAGES AVAILABLE AT TIME OF PURCHASE. Worksheet Note:	
The Vendor agrees that notwithstanding any other term or provision in this Agreement included in the Purchase Price and in addition to those items detailed in Schedule GP to the Agreement of Purchase and Sale, the Purchaser is entitled to a credit of Fif Worksheet Note:	

This Document is Extremely Time Sensitive - Printed 24 Aug 20 at 8:54

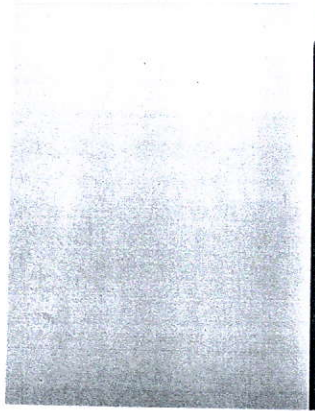

BRENTWOOD 2
2,810 SQ.FT.
17 SQ.FT. OF OPEN AREA

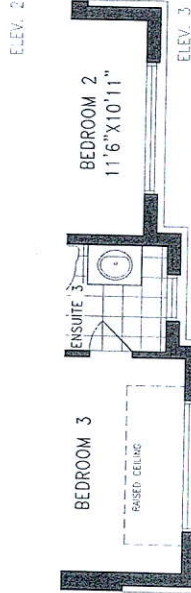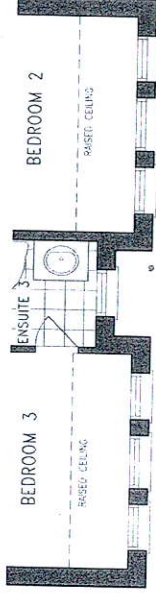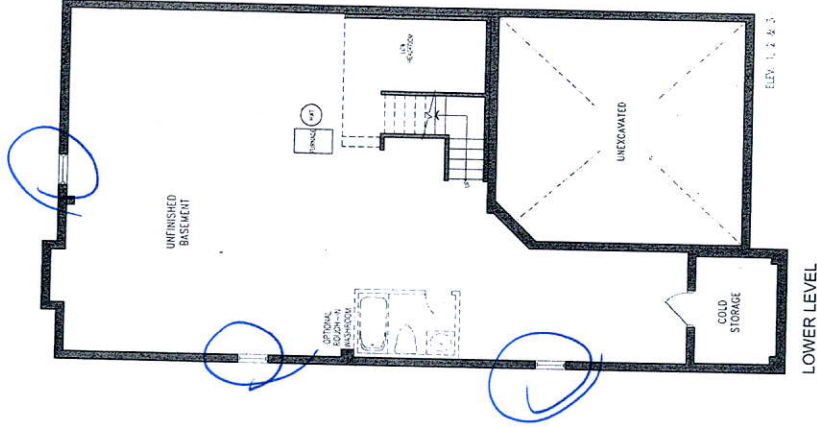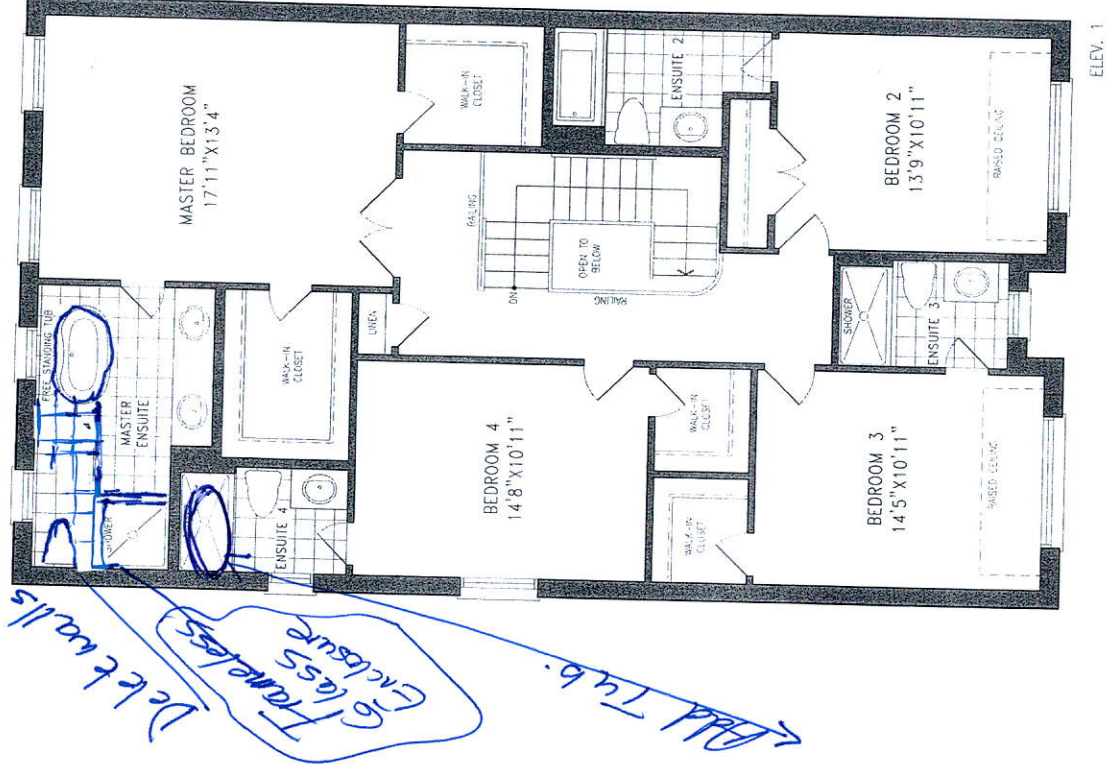

UPPER LEVEL


PURCHASER ALTERATION FORM

LOT 15
TRINAR HALL HOMES INC

BRENTWOOD 2
ELEV. 2

REVISION:

1. MASTER ENSUITE - REMOVE WALL OF WC AND ADD GLASS WALL TO SHOWER AS PER SKETCH

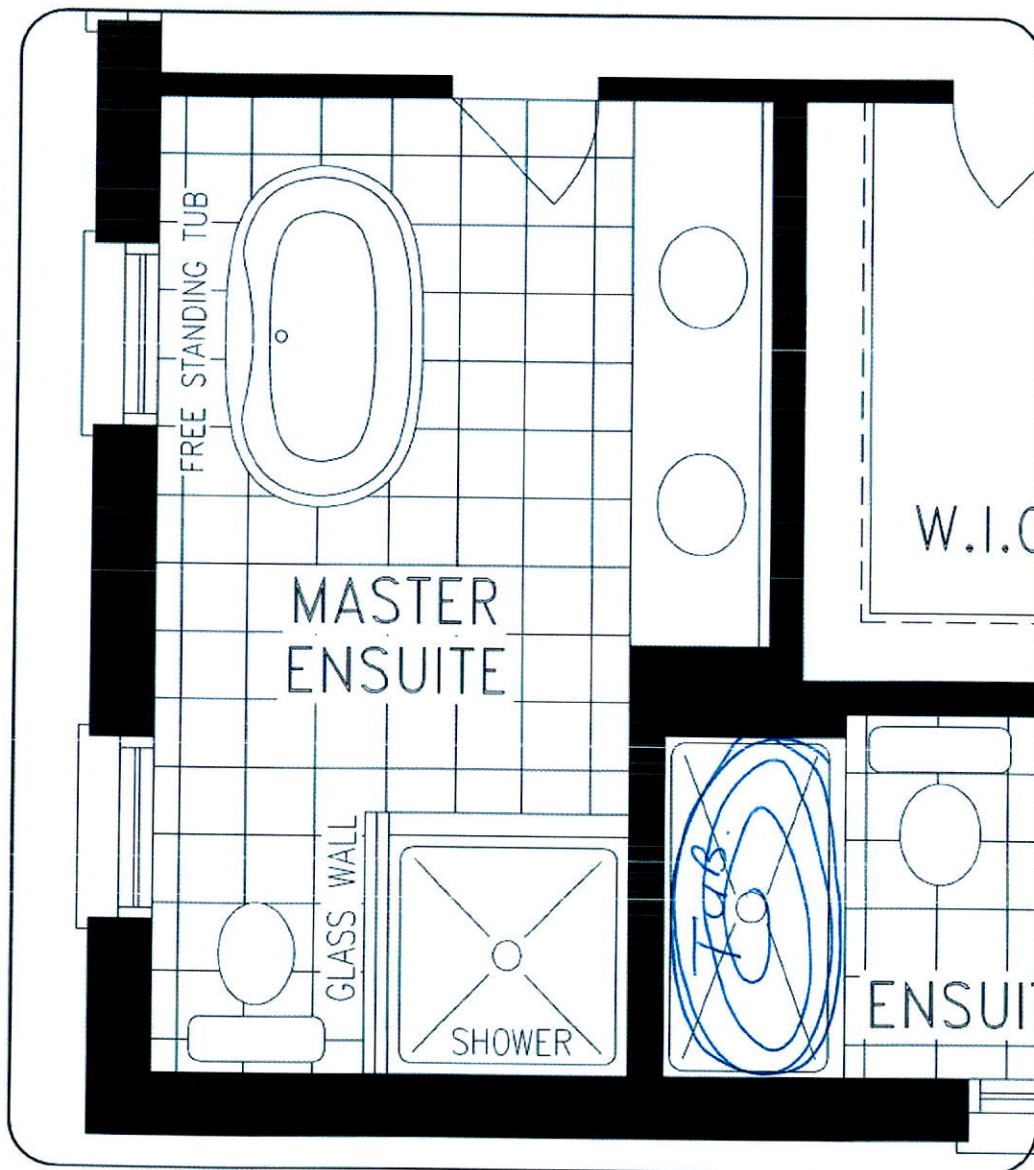

UPPER LEVEL

DISCLAIMERS: SKETCH NOT TO SCALE. DIMENSIONS, SPECIFICATIONS AND ARCHITECTURAL DETAILS SUBJECT TO MODIFICATION BY THE VENDOR. SKETCH IS ONLY FOR THE PURPOSE OF ILLUSTRATING REVISIONS REQUESTED BY THE PURCHASER AND ALL REVISIONS ARE SUBJECT TO VENDOR'S FINAL APPROVAL. ONLY REVISIONS ACCEPTED IN WRITING BY THE PURCHASER AND VENDOR ON A PURCHASER'S EXTRA SHEET WILL BE INCORPORATED INTO THE PLANS FILED WITH THE MUNICIPALITY. E. & O.E.

REGION
DESIGN
INC.

SCALE
N.T.S.
BY
PAGE No.
VG 1 OF 1

Greenpark.

Ray Kyran-Hristina Heydari