



PURCHASER: MOHAMMED,J AHMED,				CONSTRUCTION SUMMARY		RECEIVED	
Elizabeth Heights - Trinar Hall Homes Inc.						SEP 22 2020	
TEL:							
LOT / PHASE	REG. PLAN #	HOUSE TYPE					
22 / 1	65M-4671	BRENTWOOD 3 ELEV 3					

CONSTRUCTION

I - ENLARGE BASEMENT WINDOWS (MAY REQUIRE WINDOW WELLS) - WINDOW IS 30 INCHES X 24 INCHES	
31Aug20 Note:	

PROMOTIONAL


I - PARTIAL REDEMPTION OF PROMOTIONAL PACKAGE \$\$\$\$\$\$ BALANCE FORWARD TO BE USED AT A LATER DATE.	
ORIGINAL PROMOTIONAL PACKAGE OF \$\$\$\$ AS PER SCHEDULE PE DATED MMMDDYYYY.	
31Aug20 Note: NEW PROMO BALANCE \$14,515.00	

EXTRAS AS PER OFFER

The Vendor agrees that notwithstanding any other term or provision in this Agreement included in the Purchase Price and in addition to those items detailed in Schedule GP to the Agreement of Purchase and Sale, the Purchaser is entitled to a credit of Fif	
Worksheet Note:	
PURCHASER(S) ACKNOWLEDGES THAT THE PURCHASE PRICE IS INCLUSIVE OF ALL CREDITS AND	
PROMOTIONAL PACKAGES AVAILABLE AT TIME OF PURCHASE.	
Worksheet Note:	

This Document is Extremely Time Sensitive - Printed 31 Aug 20 at 13:31


6' LOT

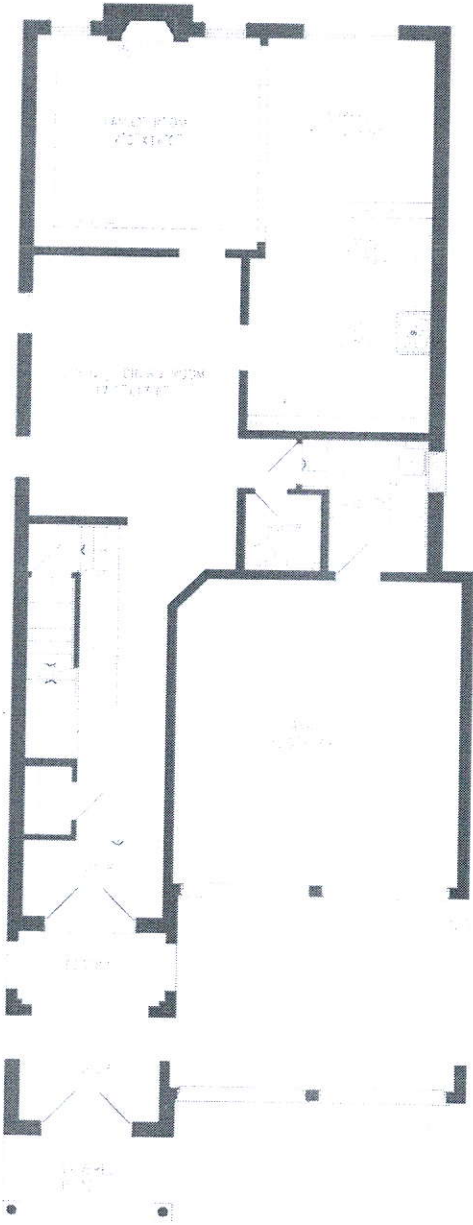

MAIN LEVEL




BRENTWOOD 3
2,815 SQ.FT.
21 SQ.FT. OF OPEN AREA

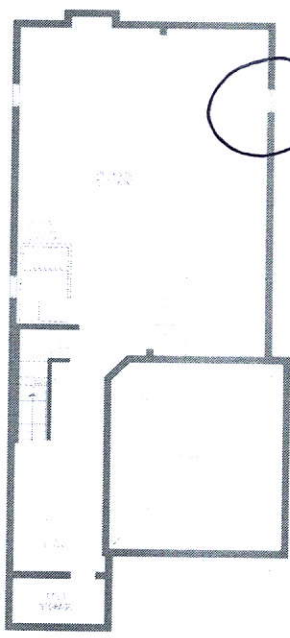

LOWER LEVEL

Enlarge window

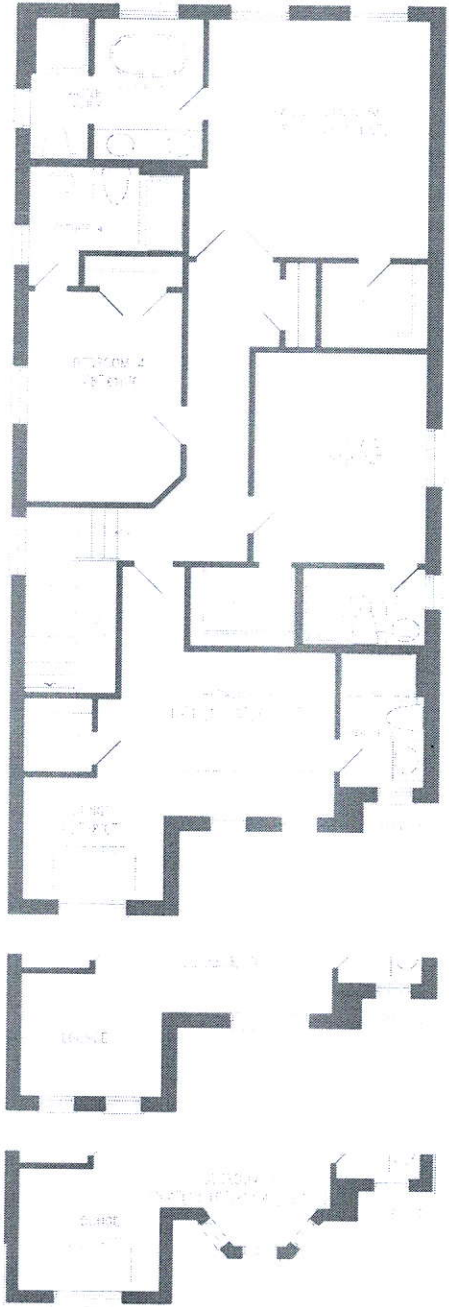

UPPER LEVEL

Orientation of home may be reversed and purchaser agrees to accept the same. Steps and porches may vary at any exterior entrance ways due to grading variance. Actual usable floor space may vary from the stated floor areas. All renderings are artist's concept. Dimensions, specifications and architectural detailing subject to modifications. Roofline and adjoining model types may vary due to siting. E. & O. E. February 2020