

CONSTRUCTION SUMMARY

Mountainview Heights 3 (G) - Russell Gardens Building Ltd.

PURCHASERS: RAVISHANKAR THIRUCHELVAM and SUTHARSINI RAVISHANKAR

TEL:

LOT / PHASE 221 / 3	REG. PLAN # 62M-1266	HOUSE TYPE Mountainash Three (5 Bedroom) Elev 3		
------------------------	-------------------------	--	--	--

CABINETRY

1 - CABINETRY - KITCHEN - LIGHT VALENCE 26Jul21    Note:		
1 - DELETE HARDWARE NO HOLES DRILLED - KITCHEN & BATHROOMS 26Jul21    Note:		
1 - KITCHEN - ISLAND - CREATE OPENING IN ISLAND FOR WINE BEVERAGE FRIDGE 08Jun21    Note:		
1 - CABINETRY PROVISION - PROVISION FOR PLUG ON ISLAND (PLUG EXTRA ORDERED SEPARATELY) 08Jun21    Note:		

CABINETRY ACCESSORIES

1 - KITCHEN - RELOCATE STANDARD BANK OF DRAWERS TO ISLAND 26Jul21    Note:		
1 - VANITY CABINETRY - RAISE VANITY TO 36" HIGH VANITY IN LIEU OF STANDARD HEIGHT - MASTER ENSUITE BATHROOM 26Jul21    Note:		
1 - KITCHEN - BLU MOTION DRAWERS 26Jul21    Note:		
1 - KITCHEN - SOFT CLOSING CABINETRY 26Jul21    Note:		
1 - PANTRY UNIT UPGRADE - TO GO FROM 300MM TO 600MM DEEP - PRICE IS PER FOOT - STANDARD 26Jul21    Note:		
1 - KITCHEN CABINETRY UPPER - FULL DEPTH ABOVE FRIDGE - WITH GABLES - 600MM - PRICE IS EACH - STANDARD 26Jul21    Note:		
1 - KITCHEN CABINETRY BASE - PULLOUT RECYCLE 4 BIN - PRICE IS EACH 26Jul21    Note:		
1 - KITCHEN CABINETRY BASE - PULLOUT WIRE SPICE RACK - PRICE IS EACH 26Jul21    Note:		
1 - KITCHEN CABINETRY - BUILT-IN MICROWAVE/OVEN COMBO - STANDARD 26Jul21    Note:		
1 - KITCHEN CABINETRY BASE - COOKTOP CABINET WITH POT DRAWERS (2 DRAWERS) - STANDARD 26Jul21    Note:		
1 - KITCHEN - REDUCE PANTRY AND SHIFT FRIDGE TO ACCOMMODATE BUILT-IN OVEN/MICRO 08Jun21    Note:		

CERAMIC TILE

1 - DELETE ALL CERAMIC BATHROOM ACCESSORIES - DELETE TOWEL BAR, PAPER HOLDER & SOAP DISH THROUGHOUT 26Jul21    Note:	
1 - TILE - UPGRADE 4 FLOOR TILE - - POWDER ROOM 26Jul21    Note:	

CONSTRUCTION SUMMARY

Mountainview Heights 3 (G) - Russell Gardens Building Ltd.

PURCHASERS: RAVISHANKAR THIRUCHELVAM and SUTHARSINI RAVISHANKAR

TEL:

LOT / PHASE	REG. PLAN #	HOUSE TYPE		
221 / 3	62M-1266	Mountainash Three (5 Bedroom) Elev 3		

1 - TILE - UPGRADE 4 FLOOR TILE - - KITCHEN

26Jul21 Note:

1 - TILE - UPGRADE 4 FLOOR TILE - - FOYER

26Jul21 Note:

1 - TILE - UPGRADE 4 WALL TILE - - ENSUITE WALL TILE - SHOWER

26Jul21 Note:

1 - TILE - UPGRADE 4 FLOOR TILE - - ENSUITE BATHROOM - FLOOR

26Jul21 Note:

CONSTRUCTION

1 - MASTER ENSUITE BATHROOM - ADJUST FRAMING ON SHOWER TO ACCOMMODATE FRAMELESS ENCLOSURE

04Aug21 Note:

3 - PROVISION FOR SHAMPOO NICHE APPROX. 24" WIDE X 20" HIGH AS PER SKETCH – IF CONSTRUCTION - ALL ENSUITE BATHROOMSPERMITS

04Aug21 Note:

1 - SMOOTH CEILINGS ON FIRST FLOOR ONLY - DET

08Jun21 Note:

COUNTER TOP

3 - SHAMPOO NICHE 24" WIDE X 20" HIGH AS PER SKETCH – MARBLE, GRANITE OR QUARTZ – IF CONSTRUCTION PERMITS - REQUIRES PROVISION FROM CONSTRUCTION - ALL ENSUITE BATHROOMS

04Aug21 Note: SUPPLY & INSTALL

1 - KITCHEN - FULL HEIGHT QUARTZ BACKSPLASH

26Jul21 Note:

1 - COUNTER TOP - UPGRADE - KITCHEN COUNTER TOP

26Jul21 Note:

1 - COUNTER TOP - UPGRADE - POWER ROOM VANITY COUNTER TOP

26Jul21 Note:

1 - COUNTER TOP - UPGRADE - ENSUITE BATHROOM VANITY COUNTER TOP

26Jul21 Note:

1 - COUNTER TOP - UPGRADE - ENSUITE BATHROOM 4/5 VANITY COUNTER TOP

26Jul21 Note:

1 - COUNTER TOP - UPGRADE - ENSUITE BATHROOM 2/3 VANITY COUNTER TOP

26Jul21 Note:

DOORS AND TRIM

1 - TRIM - UPGRADE 3- 7-¼" ONE STEP BASEBOARD AND ONE STEP BB CASING

26Jul21 Note:

ELECTRICAL

1 - KITCHEN - VALANCE LIGHTING - LED LIGHTING

26Jul21 Note:





CONSTRUCTION SUMMARY

Mountainview Heights 3 (G) - Russell Gardens Building Ltd.

PURCHASERS: RAVISHANKAR THIRUCHELVAM and SUTHARSINI RAVISHANKAR TEL:

LOT / PHASE	REG. PLAN #	HOUSE TYPE		
221 / 3	62M-1266	Mountainash Three (5 Bedroom) Elev 3		
1 - KITCHEN - RELOCATE FRIDGE TO ACCOMMODATE BUILT-IN OVEN/MICRO 08Jun21 Note:				
1 - PLUG - ELECTRICAL PLUG - FOR BEVERAGE FRIDGE 08Jun21 Note:				
1 - BUILT IN OVEN AND COOKTOP PROVISION - PROVISION ONLY - ELECTRICAL ONLY 08Jun21 Note:				
1 - PLUG - ELECTRICAL PLUG - INSTALLED 5' FROM FLOOR FOR FUTURE TV - MASTER BEDROOM 08Jun21 Note:				
3 - FAN - BATHROOM EXHAUST FAN - ENERGY STAR 80 CFM - IN LIEU OF STANDARD FAN - ALL ENSUITE BATHROOMS 08Jun21 Note:				
1 - ABOVE KITCHEN ISLAND - ADD LIGHT AND SWITCH - NO FIXTURE INCLUDED 08Jun21 Note:				
1 - PLUG - ELECTRICAL PLUG - ADD TO ISLAND 08Jun21 Note:				
1 - PLUG - ELECTRICAL PLUG - TO BE INSTALLED OVER FIREPLACE 08Jun21 Note:				
1 - POT LIGHT - LED - FIRST FLOOR INSTALLATION - INSTALLED ON SEPERATE SWITCH - LIVING/DINING ROOM 08Jun21 Note:				
1 - STANDARD DINING ROOM LIGHT TO BE CENTERED BETWEEN LIVING AND DINING ROOM 08Jun21 Note:				

FIREPLACE AND ACCESSORIES

1 - MANTEL - CAST STONE - AEQUALITAS 1 STYLE MANTEL 26Jul21 Note:				
1 - GAS LINE ROUGH-IN FOR BARBECUE - FIRST FLOOR 08Jun21 Note:				
1 - GAS LINE ROUGH-IN FOR STOVE (INCLUDES ELECTRICAL OUTLET) - FIRST FLOOR 08Jun21 Note:				

HARDWOOD FLOORING

1 - HARDWOOD - GROUP B SERIES 6 1/2 INCH - IN LIEU OF 2 1/4 INCH NATURAL RED OAK - - LIVING AND DINING ROOM 26Jul21 Note:				
1 - HARDWOOD - GROUP B SERIES 6 1/2 INCH - IN LIEU OF 2 1/4 INCH NATURAL RED OAK - - LIBRARY/DEN 26Jul21 Note:				
1 - HARDWOOD - GROUP B SERIES 6 1/2 INCH - IN LIEU OF 2 1/4 INCH NATURAL RED OAK - - FAMILY ROOM 26Jul21 Note:				

MIRRORS AND GLASS

1 - MASTER ENSUITE – FRAMELESS GLASS SHOWER ENCLOSURE WITH GLASS PANEL ABOVE VANITY – INCLUDES CHROME KNOB AND HINGES 04Aug21 Note:				
--	--	--	--	--

CONSTRUCTION SUMMARY

Mountainview Heights 3 (G) - Russell Gardens Building Ltd.

PURCHASERS: RAVISHANKAR THIRUCHELVAM and SUTHARSINI RAVISHANKAR

TEL:

LOT / PHASE 221 / 3	REG. PLAN # 62M-1266	HOUSE TYPE Mountainash Three (5 Bedroom) Elev 3		
------------------------	-------------------------	--	--	--

1 - FRAMELESS GLASS SHOWER DOOR - INCLUDES CHROME KNOB & HINGES - MASTER ENSUITE BATHROOM  
26Jul21 Note:

PLUMBING

6 - SINK - UNDERMOUNT SINK - CONTRAC EMERY #4220CGY - ALL BATHROOMS  
26Jul21 Note:

1 - SOAP DISPENSER - CHROME FINISH - MOEN #3944 - KITCHEN  
26Jul21 Note:

1 - SINK - UNDERMOUNT SINK - BLANCO QUATRUS R15 U SUPER SINGLE #401518  
26Jul21 Note:

1 - WATER LINE FOR FRIDGE - ROUGH-IN ONLY  
08Jun21 Note:

PROMOTIONAL

1 - LESS BALANCE OF CREDIT FROM PURCHASER EXTRA SHEET IN OFFER  
26Jul21 Note:

1 - PARTIAL REDEMPTION OF PROMOTIONAL PACKAGE \$10,870.00 BALANCE (\$14,130.00) FORWARD TO BE USED AT A LATER DATE. ORIGINAL PROMOTIONAL PACKAGE OF \$25,000.00 AS PER SCHEDULE PE.  
08Jun21 Note:

STAIRS AND RAILINGS

1 - STAIRCASE - V GROOVE HANDRAIL  
26Jul21 Note:

1 - STAIRCASE - 4 X 4 POSTS  
26Jul21 Note:

1 - STAIRCASE - EUROLINE R6-3 IRON PICKETS - BLACK  
26Jul21 Note:

1 - STAINED STAIRS – STANDARD STAIRCASE - PRICE IS PER SET  
26Jul21 Note:

EXTRAS AS PER OFFER

(1) The Vendor agrees that notwithstanding any other term or provision in this Agreement included in the Purchase Price and in addition to those items detailed in Schedule GP to the Agreement of Purchase and Sale, the Purchaser is entitled to a credit of  
Worksheet Note:

200 AMP SERVICE LABELLED WITH CIRCUIT BREAKER PANEL TO UTILITY AUTHORITY STANDARDS.  
Worksheet Note:

Purchase Price includes 3 enlarged basement windows, and the obligation to construct the house with the enlarged basement windows is subject to the Vendor's approval, in its sole and unfettered discretion The Purchaser acknowledges and agrees that the  
lo  
Worksheet Note:

PURCHASER(S) ACKNOWLEDGES THAT THE PURCHASE PRICE IS INCLUSIVE OF ALL CREDITS AND PROMOTIONAL PACKAGES AVAILABLE AT TIME OF PURCHASE.  
Worksheet Note:



CONSTRUCTION SUMMARY

Mountainview Heights 3 (G) - Russell Gardens Building Ltd.

PURCHASERS: RAVISHANKAR THIRUCHELVAM and SUTHARSINI RAVISHANKAR

TEL:

LOT / PHASE 221 / 3	REG. PLAN # 62M-1266	HOUSE TYPE Mountainash Three (5 Bedroom) Elev 3		
------------------------	-------------------------	--	--	--

This Document is Extremely Time Sensitive - Printed 4 Aug 21 at 9:27

Purchasers:RAVISHANKAR THIRUCHELVAM & SUTHARSINProperty: 221

Telephone Res. / Bus: /Project: Russell Gardens Building Ltd.

Decor Advisor: Candace ForzaModel and Elevation: Mountainash Three (5 Bedroom) Elev 3

Lock Date: 26-Jul-2126-Jul-21Plan #: 62M-1266

Layout Changes: ☐ Yes ☒ NoSketch Attached: ☒ Yes ☐ NoExterior Colour Scheme:

1. Cabinetry

	Style and Colour	Hardware
Kitchen / Breakfast	MONACO 904 INK	N/A
Laundry Room	ELISSE	Standard
Powder Room	EVEREST	N/A
Master Ensuite Bathroom	MONACO 821 INDUSTRIAL GRAPHITE	N/A
Ensuite Bath - Bedroom 2/3	DORAL K38 RIVERSIDE	N/A
Ensuite Bath - Bedroom 4/5	DORAL K44 TITAN GREY	N/A
	N/A	N/A
	N/A	N/A
	N/A	N/A

Appliances:

Built In Appliances ☒ Yes ☐ NoSlide In Stove ☐ Yes ☒ No

Dishwasher Cabinet ☐ Closed ☒ Open41" Upper Cabinets ☒ Yes ☐ NoPlease NOTE: Standard Cabinet Height is 30"

Stove OpeningNOTE: If not specified, opening will be set to builder's standard opening of approximately 30" width

Fridge OpeningNOTE: If not specified, opening will be set to builder's standard opening of approximately 37" width x 74" height

\*\* Refer to Construction Summary

2. Counters

	Counter	Edge
Kitchen / Breakfast	QUARTZ-VICTORIA	#360
Laundry Room	N/A	
Powder Room	MARBLE-SILVER PORTOTO	#360
Master Ensuite Bathroom	QUARTZ-MISTRAL	#360
Ensuite Bath - Bedroom 2/3	QUARTZ-GRECALE	#360
Ensuite Bath - Bedroom 4/5	QUARTZ-VERMONT	#360
	N/A	
	N/A	
	N/A	

\*\* Refer to Construction Summary

Initials: 

T.R

T.R



Purchasers:RAVISHANKAR THIRUCHELVAM & SUTHARSINProperty: 221

Telephone Res. / Bus: /Project: Russell Gardens Building Ltd.

Decor Advisor: Candace ForzaModel and Elevation: Mountainash Three (5 Bedroom) Elev 3

Lock Date: 4-Aug-2126-Jul-21Plan #: 62M-1266

3. Ceramic Flooring

At a 45 Threshold-If App.

Entrance Vestibule	TILE-CALACATTA POLISHED (CA6083P)24X24	<input type="checkbox"/>	metal strip where applicable
Main Hall	N/A	<input type="checkbox"/>	
Kitchen / Breakfast	TILE-CALACATTA POLISHED (CA6083P)24X24	<input type="checkbox"/>	
Laundry Room	TILE-RAINBOW WHITE-13X13	<input type="checkbox"/>	
Powder Room	TILE-CALACATTA POLISHED (CA6083P)24X24	<input type="checkbox"/>	
Master Ensuite Bathroom	TILE-CALACATTA POLISHED (CA6083P)24X24	<input type="checkbox"/>	
Ensuite Bath - Bedroom 2/3	TILE-COLOURS WHITE-13X13	<input type="checkbox"/>	
Ensuite Bath - Bedroom 4/5	TILE-ESSENZE GRIGIO-13X13	<input type="checkbox"/>	
	N/A	<input type="checkbox"/>	
	N/A	<input type="checkbox"/>	
	N/A	<input type="checkbox"/>	

\*\* Refer to Construction Summary

4. Ceramic Wall Tile

Master Ensuite Bathroom	Selection	Describe
Tub Deck Wall	N/A	
Tub Deck	N/A	
Tub Deck Skirt	N/A	
Shower Stall	TILE-CALACATTA POLISHED (CA6083P)24X24	SHAMPOO NICHE - QUARTZ-MISTRAL
Bathtub Enclosure Walls	N/A	
Ensuite Bath - Bedroom 2/3	TILE-LUC AFRICA-8X16	SHAMPOO NICHE - QUARTZ-GRECALE
Ensuite Bath - Bedroom 4/5	TILE-CONCEPT PLUS DARK GREY-8X16	SHAMPOO NICHE - QUARTZ-VERMONT
	N/A	
	N/A	
	N/A	
Kitchen Backsplash	N/A	

\*\* Refer to Construction Summary - STANDARD GROUT THROUGHOUT UNLESS SPECIFIED

5. Plumbing Fixtures

All Bathrooms

White

N/A

N/A

Whirlpool

N/A

☐ Yes☒ No

Dishwasher Rough-In

☒ Yes☐ No

Waterline for Fridge

☒ Yes☐ No

\*\* Refer to Construction Summary

6. Trim Carpentry

Interior Doors	CARRARA-SMOOTH
Interior Trim	BB CASING WITH 7 1/4" BASEBOARD - ONE STEP
Door Handles	As Per Construction Specifications
Exterior Front Door Handle	As Per Construction Specifications

\*\* Refer to Construction Summary



Purchasers:

RAVISHANKAR THIRUCHELVAM & SUTHARSIN

Property: 221

Telephone Res. / Bus:

/

Project: Russell Gardens Building Ltd.

Decor Advisor:

Candace Forza

Model and Elevation: Mountainash Three (5 Bedroom) Elev 3

Lock Date:

26-Jul-21

26-Jul-21

Plan #: 62M-1266

7. Other Flooring

Main Hall	N/A	
Living Room	STRIP-MIRAGE-IMAGINE-CHARACTER-CORK-RED OAK-DURAMATT-DRIFTWOOD-6 1/2"	
Dining Room	STRIP-MIRAGE-IMAGINE-CHARACTER-CORK-RED OAK-DURAMATT-DRIFTWOOD-6 1/2"	
Family Room	STRIP-MIRAGE-IMAGINE-CHARACTER-CORK-RED OAK-DURAMATT-DRIFTWOOD-6 1/2"	
Den / Library / Study	STRIP-MIRAGE-IMAGINE-CHARACTER-CORK-RED OAK-DURAMATT-DRIFTWOOD-6 1/2"	
Basement Landing(If Applies)	N/A	
Lower Landing (If Applies)	N/A	
Upper Landing	STRIP-MIRAGE-IMAGINE-CHARACTER-CORK-RED OAK-DURAMATT-DRIFTWOOD-6 1/2"	
Upper Hall	LAMINATE-LEXINGTON-ROCHEFORT OAK-TL-LW1317	
Master Bedroom	LAMINATE-LEXINGTON-ROCHEFORT OAK-TL-LW1317	
Bedroom #2	LAMINATE-LEXINGTON-ROCHEFORT OAK-TL-LW1317	
Bedroom #3	LAMINATE-LEXINGTON-ROCHEFORT OAK-TL-LW1317	
Bedroom #4	LAMINATE-LEXINGTON-ROCHEFORT OAK-TL-LW1317	
Bedroom #5	LAMINATE-LEXINGTON-ROCHEFORT OAK-TL-LW1317	
Underpad	Type	Area
	N/A	N/A

\*\* Refer to Construction Summary

8. Railings and Pickets

Railing Type	V-GROOVE & 4X4 POSTS	Colour	MIRAGE DRIFTWOOD RED OAK
Picket Type	PICKETS R-6-3	Colour	BLACK
Stringer / Riser	AS PER CONSTRUCTION SPECIFICATIO	Colour	MIRAGE DRIFTWOOD RED OAK
Treads	AS PER CONSTRUCTION SPECIFICATIO	Colour	MIRAGE DRIFTWOOD RED OAK
Red Oak Stairs with Semi Gloss Finish		<input checked="" type="radio"/> Yes <input type="radio"/> No	

\*\* Refer to Construction Summary THE STAIN COLOURS OR FINISH AVAILABLE ON RISERS, TREADS, PICKETS AND RAILS (STAIRCASES), WILL NOT BE AN EXACT MATCH TO PREFINISHED HARDWOOD OR LAMINATE FLOORS.

9. Wall Paint Flat Finish

Main & Upper Hall	22 WARM GREY	Master Bedroom	22 WARM GREY
Living Room	22 WARM GREY	Bedroom #2	22 WARM GREY
Dining Room	22 WARM GREY	Bedroom #3	22 WARM GREY
Kitchen / Breakfast	22 WARM GREY	Bedroom #4	22 WARM GREY
Family Room	22 WARM GREY	Bedroom #5	22 WARM GREY
Powder Room	22 WARM GREY	Master Ensuite	22 WARM GREY
Laundry Room	22 WARM GREY	Ensuite Bath - Bedroom 2/3	22 WARM GREY
Den/Library	22 WARM GREY	Ensuite Bath - Bedroom 4/5	22 WARM GREY
Trim Paint-Semi Gloss	BIRCH WHITE		N/A
	N/A		N/A
	N/A		N/A

Smooth Ceilings First Floor ☒ Yes ☐ No

\*\* Refer to Construction Summary

Initials: T.R T.R



Purchasers:

RAVISHANKAR THIRUCHELVAM & SUTHARSIN

Telephone Res. / Bus:

/

Decor Advisor:

Candace Forza

Lock Date:

26-Jul-21

Property: 221

Project: Russell Gardens Building Ltd.

Model and Elevation: Mountainash Three (5 Bedroom) Elev 3

Plan #: 62M-1266

10. Plaster Mouldings and Medallions

Entrance Vestibule	N/A	N/A	Kitchen/Breakfast	N/A	N/A
Main Hall	N/A	N/A	Den/Library	N/A	N/A
Living Room	N/A	N/A	Lower Landing	N/A	N/A
Dining Room	N/A	N/A		N/A	N/A
Family Room	N/A	N/A			

\*\* Refer to Construction Summary

11. Fireplace

	Living Room			Family Room			Other Room - Specify		
	Purchased	As Per Plan	N/A	Purchased	As Per Plan	N/A	Purchased	As Per Plan	N/A
	<input type="radio"/>	<input type="radio"/>	<input checked="" type="radio"/>	<input type="radio"/>	<input checked="" type="radio"/>	<input type="radio"/>	<input type="radio"/>	<input type="radio"/>	<input checked="" type="radio"/>
Fireplace Type	N/A			FLAT ON WALL			N/A		
Mantle Type	N/A			AEQUALITAS I			N/A		
Colour / Stain	N/A			NATURAL IVORY			N/A		
Surround	N/A			N/A			N/A		
Hearth	N/A			NO			N/A		

\*\* Refer to Construction Summary

12. Heating and Air Conditioning

Air Conditioning	NO	Gas Provisions Stove	YES
Gas Provisions Dryer	NO	Gas Provisions Barbecue	YES
Comment			

\*\* Refer to Construction Summary

13. Electrical

Plugs and Switches	<input checked="" type="radio"/> White	DECOR	Above Kitchen Cabinet Light	<input type="radio"/> Yes	<input checked="" type="radio"/> No
Hood Fan	STANDARD WHITE		Below Kitchen Cabinet Light	<input checked="" type="radio"/> Yes	<input type="radio"/> No
Appliances	Built in Cooktop	Built in Oven	Gas Stove	Microwave	
	<input checked="" type="radio"/> Yes <input type="radio"/> No	<input checked="" type="radio"/> Yes <input type="radio"/> No	<input checked="" type="radio"/> Yes <input type="radio"/> No	<input checked="" type="radio"/> Yes <input type="radio"/> No	
Dishwasher Rough-in	Yes				

\*\* Refer to Construction Summary

14. General Comments

\*\* Refer to Construction Summary


Disclaimers and Notes

1) Colours of all materials are as close as possible to builder's selection, but not necessarily identical due to variances in manufacturing.


2) Any extras listed above are null and void unless accompanied by a separate invoice/amendment. Said invoice must be paid in full.

3) The Purchaser agrees that this colour selection is final and that no changes will be permitted, unless required by the Vendor.

4) The Purchaser acknowledges reading and accepting document which contains other miscellaneous disclaimers.

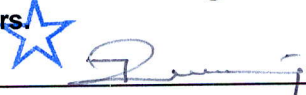Signature: 

Date: \_\_\_\_\_

Signature: 

Date: \_\_\_\_\_



Orientation of human senses has associated and associated






5 BEDROOM LAYOUT

# MOUNTAINASH THREE

ELEV. 1 • 3,086 sq.ft. | ELEV. 2 • 3,074 sq.ft. | ELEV. 3 • 3,063 sq.ft.

Add Plug 5'  
from floor for  
future tv.

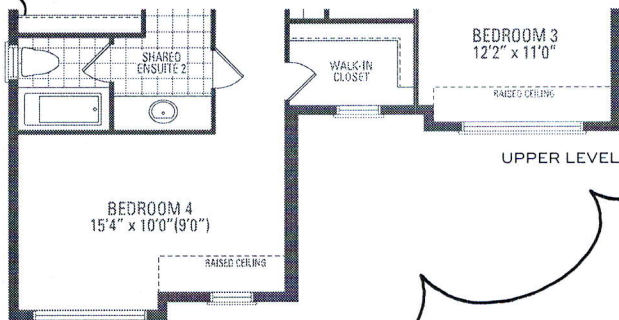
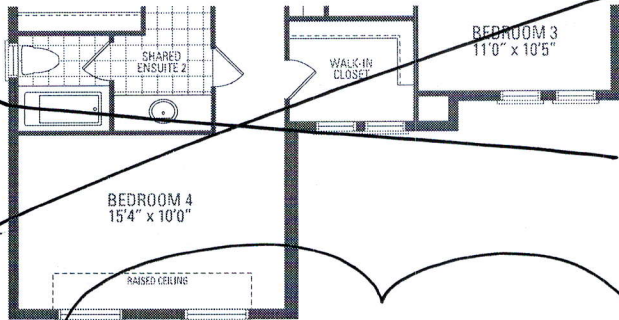
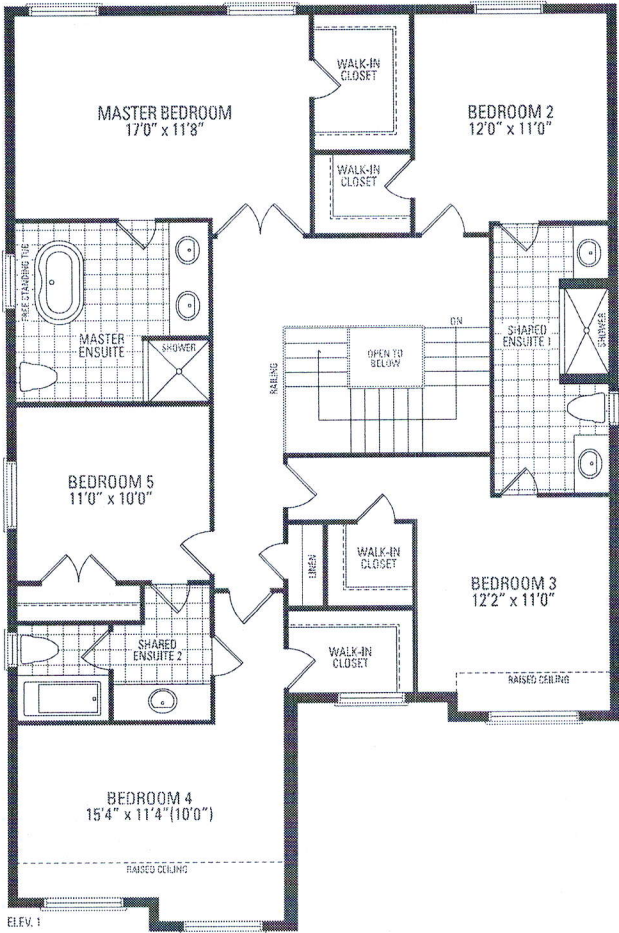


T.R

T.R



Orientation of home may be reversed and purchaser agrees to accept the same. Steps and porches may vary at any exterior entrance ways due to grading variance. Actual usable floor space may vary from the stated floor areas. All renderings are artist's concept. Dimensions, specifications and architectural detailing subject to modifications. Roofline and adjoining model types may vary due to siting. E. & G. E. May 2020

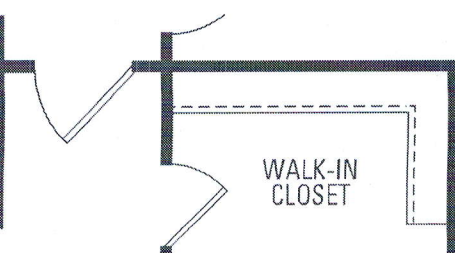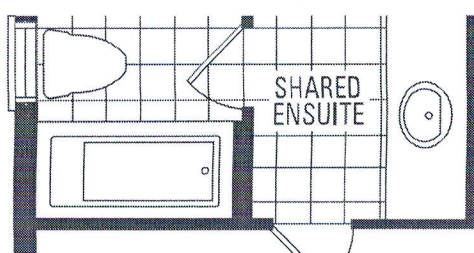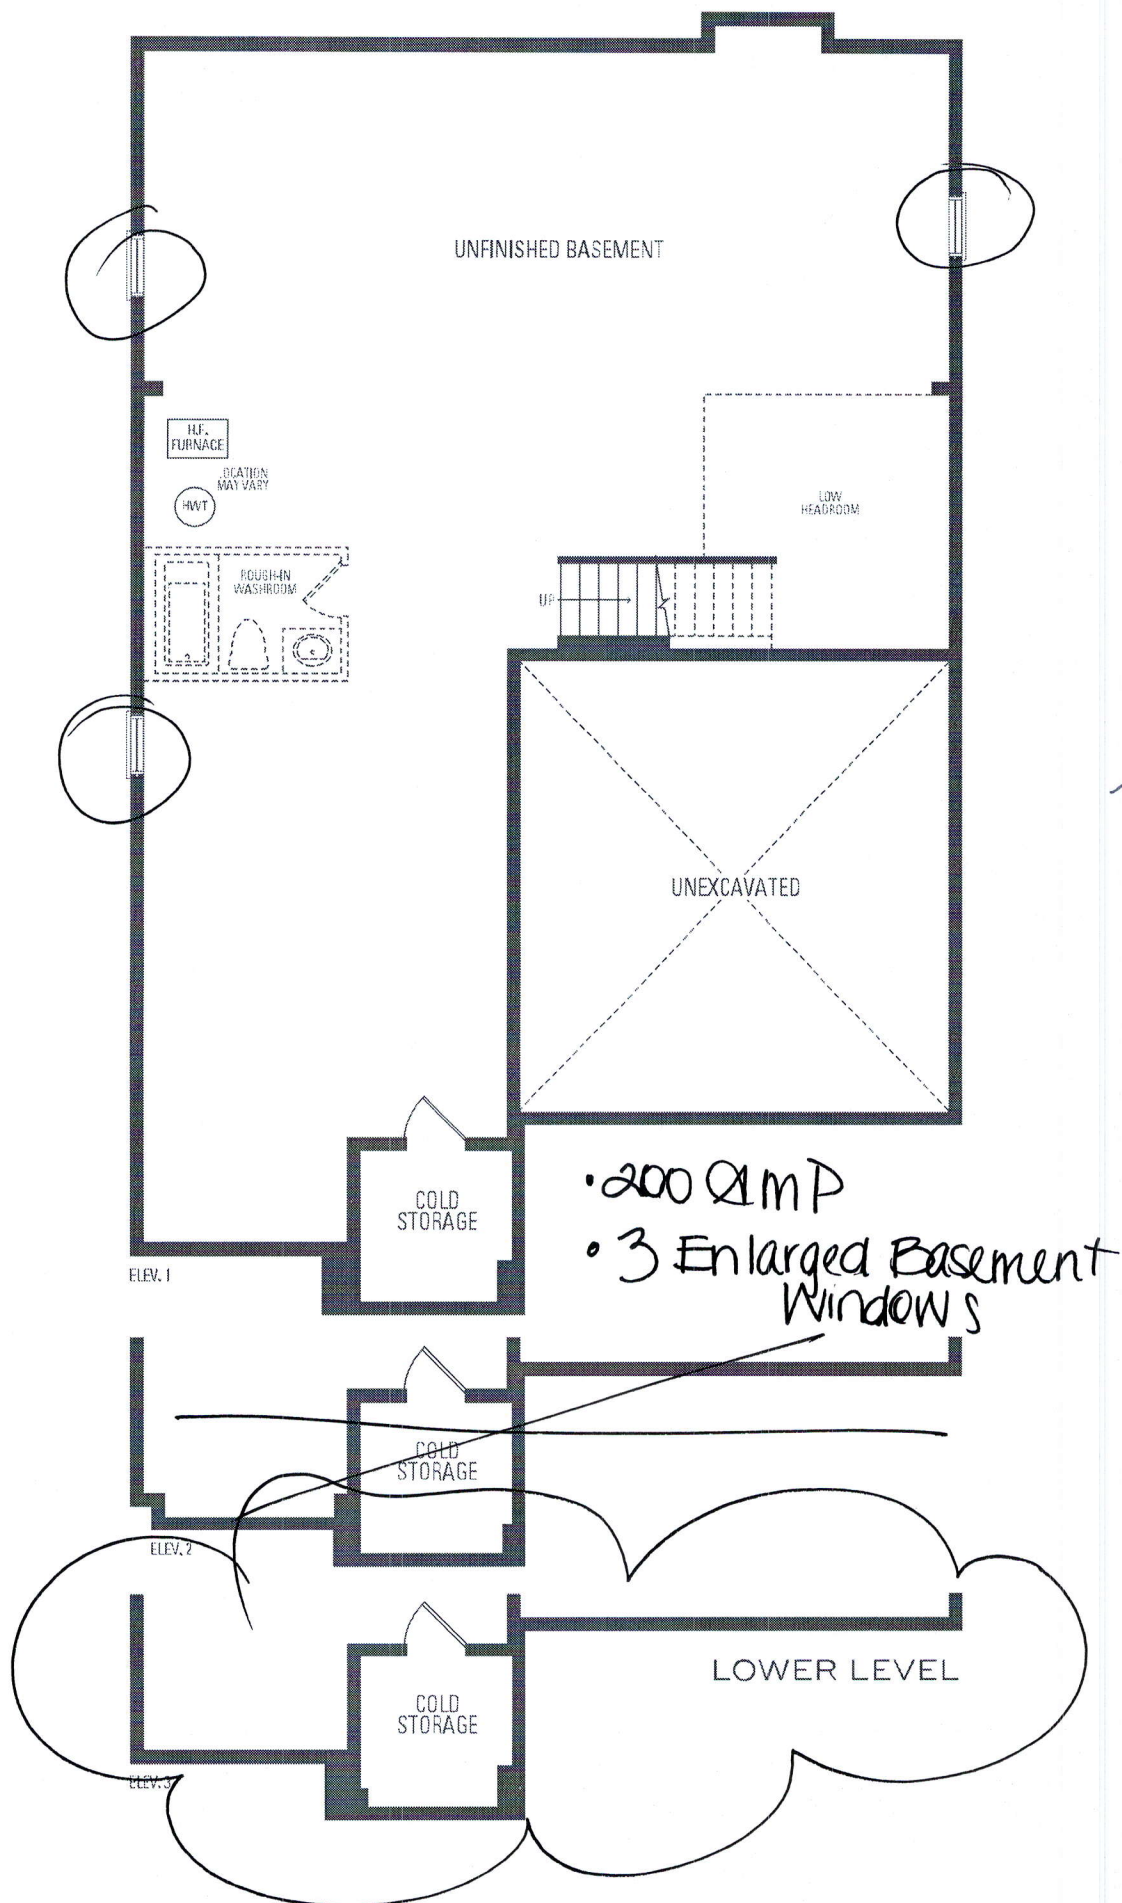

BEDROOM 2  
14'6" x 11'0"

RAISED CEILING



Kitchen

- Delete Std Hardware
- Do NOT Drill Holes.

- Soft Closing Cabinetry
- Blu motion Drawers

Built-In Oven/Micro

Pull-Out Recycle (4-Bin)  
Soap Dispenser

Create Opening for Wine Fridge

Provisions for Plug On Island.

Pot + Pan Drawers

Pull-out Spice Rack


Full Depth Fridge (Upper & Lower)

Bathrooms

- Delete Std Hardware
- Do NOT Drill Holes.

Master Ensuite

- Raise Vanity Height to 36"

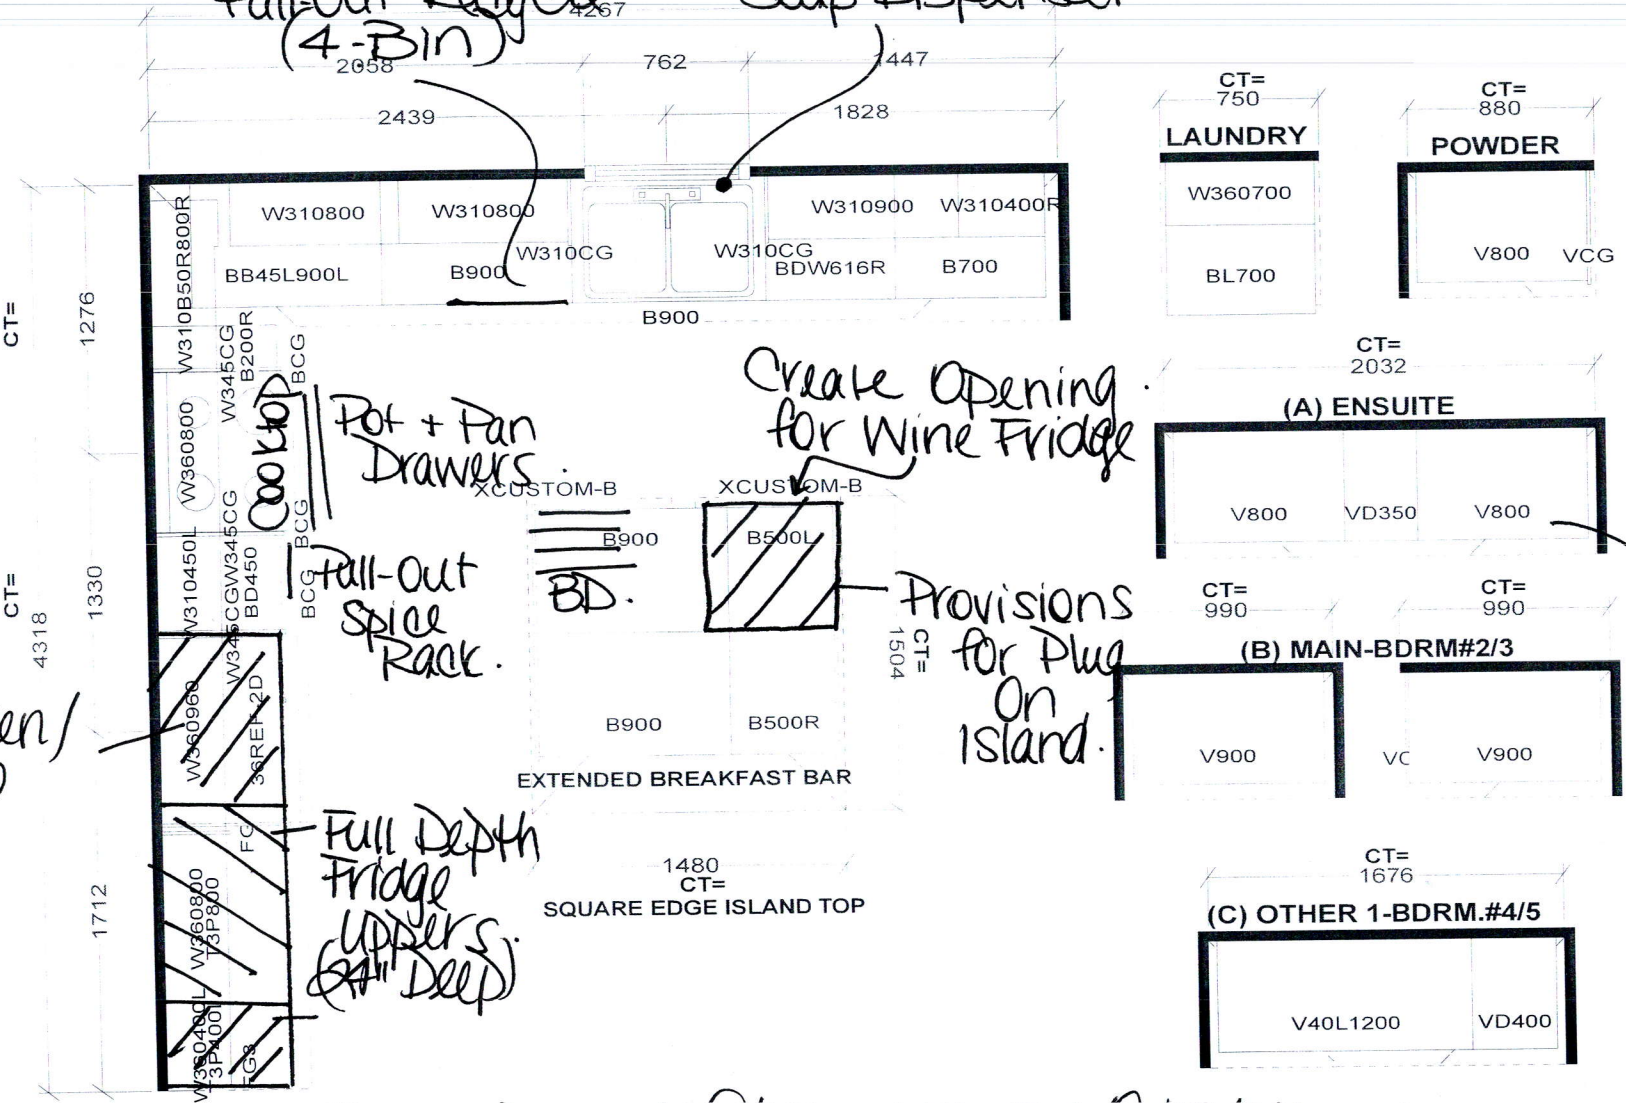

KITCHEN \*Reduce Pantry to Accommodate B.I. Oven/micro\*  
Selba Industries J#

W WDT \_\_\_\_\_ W HGHT \_\_\_\_\_ W CNT \_\_\_\_\_  
 FLOOR HGHT \_\_\_\_\_ DOOR HGHT \_\_\_\_\_  
 ST CENT \_\_\_\_\_ 2X4 \_\_\_\_\_ VENT BOX COVER \_\_\_\_\_

This drawing is the intellectual property of SELBA INDUSTRIES INC. and is an original design which must not be released or copied unless applicable fee has been paid or job order placed.

DESIGNER: KS  
DATE: MAY 13 20

JOB NUMBER: \_\_\_\_\_  
 BUILDER: GREENPARK  
 SITE: RUSSELL GARDENS PH.3  
 MODEL: MOUNTAINASH 3X OPT 5 BDRM EL 1,2,3  
 LOT #: \_\_\_\_\_