

CONSTRUCTION SUMMARY

Mountainview Heights 3 (G) - Russell Gardens Building Ltd.

PURCHASERS: MARIO G YOUSIF and LAURA DEMIANA YOUSIF

TEL: RES.: 289-400-3340

LOT / PHASE 330 / 3	REG. PLAN # 62M-1266	HOUSE TYPE Valleycreek Twelve Elev 1		
------------------------	-------------------------	---	--	--

CABINETRY

1 - KITCHEN CABINETRY - DIFFERENT COLOUR ISLAND - FLAT FEE 26Aug21 Note:	
1 - KITCHEN - DELETE CABINETS ABOVE STOVE - VENDOR WILL SUPPLY 6 INCH VENT AS PER CONSTRUCTION SPECIFICATIONS AND VENT MAY NOT BE IN THE APPROPRIATE LOCATION FOR INSTALLATION OF PURCHASER SUPPLIED VENT - PURCHASER TO SUPPLY OWN FAN AFTER CLOSING 26Aug21 Note: TEMPORARY HOOD FAN MAY BE PROVIDED	
1 - CABINETRY - KITCHEN - UPGRADE 2 26Aug21 Note:	
1 - VANITY - ENSUITE BATHROOM - UPGRADE 2 26Aug21 Note:	

CABINETRY ACCESSORIES

2 - DELETE - KITCHEN CABINETRY BASE - POT/PAN DRAWERS (CABINET) - UPGRADE 2 27Aug21 Note:	
1 - KITCHEN CABINETRY BASE - DUMMY DOOR FOR BASE CABINETRY - PRICE IS PER DOOR - UPGRADE 2 27Aug21 Note:	
2 - KITCHEN CABINETRY UPPER - UPPER CABINETS - FITS TALL UPPER CABINETS ON PERIMETER APPROX 1.5 FOOT - UPGRADE 2 27Aug21 Note:	
2 - KITCHEN CABINETRY BASE - BASE AND STANDARD COUNTER ON PERIMETER APPROX 1.5 FOOT - UPGRADE 2 27Aug21 Note:	
2 - KITCHEN CABINETRY BASE - EXTEND ISLAND BASE AND STANDARD COUNTER APPROX 1.5 FEET - UPGRADE 2 27Aug21 Note:	
1 - PANTRY UNIT UPGRADE - TO GO FROM 300MM TO 600MM DEEP - PRICE IS PER FOOT - UPGRADE 2 26Aug21 Note:	
1 - KITCHEN CABINETRY UPPER - FULL DEPTH ABOVE FRIDGE - WITH GABLES - 600MM - PRICE IS EACH - UPGRADE 2 26Aug21 Note:	
2 - KITCHEN CABINETRY BASE - POT/PAN DRAWERS (CABINET) - UPGRADE 2 26Aug21 Note:	

CERAMIC TILE

1 - TILE - UPGRADE 1 FLOOR TILE - - POWDER ROOM 26Aug21 Note:	
1 - TILE - UPGRADE 1 FLOOR TILE - - MUD ROOM 26Aug21 Note:	
1 - TILE - UPGRADE 1 FLOOR TILE - - FOYER 26Aug21 Note:	
1 - DELETE ALL CERAMIC BATHROOM ACCESSORIES - DELETE TOWEL BAR, PAPER HOLDER & SOAP DISH THROUGHOUT 26Aug21 Note:	



CONSTRUCTION SUMMARY

Mountainview Heights 3 (G) - Russell Gardens Building Ltd.

PURCHASERS: MARIO G YOUSIF and LAURA DEMIANA YOUSIF

TEL: RES.: 289-400-3340

LOT / PHASE 330 / 3	REG. PLAN # 62M-1266	HOUSE TYPE Valleycreek Twelve Elev 1		
------------------------	-------------------------	---	--	--

1 - TILE - UPGRADE 1 FLOOR TILE - - ENSUITE BATHROOM - FLOOR

26Aug21 Note:

CONSTRUCTION

1 - SMOOTH CEILINGS ON FIRST FLOOR ONLY - DET

26Aug21 Note:

ELECTRICAL

1 - PLUG - ELECTRICAL PLUG - MASTER ENSUITE BATHROOM - ADD TO OPPOSITE SIDE OF VANITY

26Aug21 Note:

1 - FRONT PORTICO - RELOCATE STANDARD LIGHT TO SOFFIT - IF CONSTRUCTION PERMITS

26Aug21 Note:

1 - PLUG - ELECTRICAL PLUG - TO BE INSTALLED OVER FIREPLACE

26Aug21 Note:

1 - ABOVE KITCHEN ISLAND - ADD LIGHT AND SWITCH - NO FIXTURE INCLUDED - WIRED TO SAME SWITCH AS STANDARD LIGHT

26Aug21 Note:

1 - RELOCATE STANDARD KITCHEN LIGHT TO BE OVER ISLAND

26Aug21 Note:

FIREPLACE AND ACCESSORIES

1 - GAS LINE ROUGH-IN FOR BARBECUE - FIRST FLOOR

26Aug21 Note:

1 - GAS LINE ROUGH-IN FOR STOVE (INCLUDES ELECTRICAL OUTLET) - FIRST FLOOR

26Aug21 Note:

HARDWOOD FLOORING

1 - HARDWOOD - GROUP B SERIES 5 INCH - IN LIEU OF STANDARD TILE - KITCHEN & BREAKFAST

26Aug21 Note:

1 - LAMINATE – UPGRADE TO PARKLANE SERIES IN LIEU OF STANDARD LAMINATE

26Aug21 Note:

1 - HARDWOOD - GROUP B SERIES 5 INCH - IN LIEU OF 2 1/4 INCH NATURAL RED OAK - - LIBRARY/DEN

26Aug21 Note:

1 - HARDWOOD - GROUP B SERIES 5 INCH - IN LIEU OF 2 1/4 INCH NATURAL RED OAK - - FAMILY ROOM

26Aug21 Note:

1 - HARDWOOD - GROUP B SERIES 5 INCH - IN LIEU OF 2 1/4 INCH NATURAL RED OAK - - DINING ROOM

26Aug21 Note:

MIRRORS AND GLASS

1 - MASTER ENSUITE – FRAMELESS GLASS SHOWER ENCLOSURE – INCLUDES CHROME KNOB AND HINGES

26Aug21 Note:



CONSTRUCTION SUMMARY

Mountainview Heights 3 (G) - Russell Gardens Building Ltd.

PURCHASERS: MARIO G YOUSIF and LAURA DEMIANA YOUSIF

TEL: RES.: 289-400-3340

LOT / PHASE 330 / 3	REG. PLAN # 62M-1266	HOUSE TYPE Valleycreek Twelve Elev 1		
------------------------	-------------------------	---	--	--

1 - ALL BATHROOMS - DELETE STANDARD MIRRORS - DO NOT INSTALL
26Aug21 Note:

PLUMBING

1 - WATER LINE FOR FRIDGE - ROUGH-IN ONLY
26Aug21 Note:

PROMOTIONAL

1 - LESS CREDIT FROM PURCHASER EXTRA SHEET IN OFFER
26Aug21 Note:

STAIRS AND RAILINGS

1 - STAIRCASE - EUROLINE 1 IRON PICKETS - BLACK
26Aug21 Note:

1 - STAINED STAIRS – STANDARD STAIRCASE - PRICE IS PER SET
26Aug21 Note:

EXTRAS AS PER OFFER

(1) The Vendor agrees that notwithstanding any other term or provision in this Agreement included in the Purchase Price and in addition to those items detailed in Schedule GP to the Agreement of Purchase and Sale, the Purchaser is entitled to a credit of
Worksheet Note:

PURCHASER(S) ACKNOWLEDGES THAT THE PURCHASE PRICE IS INCLUSIVE OF ALL CREDITS AND PROMOTIONAL PACKAGES AVAILABLE AT TIME OF PURCHASE.
Worksheet Note:

This Document is Extremely Time Sensitive - Printed 27 Aug 21 at 13:52

Purchasers:

MARIO G YOUSIF & LAURA DEMIANA YOUSIF

Property: 330

Telephone Res. / Bus:

(289) 400-3340 /

Project: Russell Gardens Building Ltd.

Decor Advisor:

Candace Forza

Model and Elevation: Valleycreek Twelve Elev 1

Lock Date:

26-Aug-21

26-Aug-21

Plan #: 62M-1266

Layout Changes:

☐ Yes ☒ No

Sketch Attached:

☒ Yes ☐ No

Exterior Colour Scheme:

1. Cabinetry

	Style and Colour	Hardware
Kitchen / Breakfast	PERIMETER-SONATA SATIN SNOW *** ISLAND SONATA CHARCOAL	447SA
Laundry Room	ELISSE	Standard
Powder Room	DORAL H3078 HACIENDA WHITE	431SA
Master Ensuite Bathroom	SONATA SATIN SNOW	447SA
Ensuite Bath - Bedroom 2/3	DORAL W-500	447SA
Ensuite Bath - Bedroom 4	SABRA 347 OYSTER	431SA
	N/A	N/A
	N/A	N/A
	N/A	N/A

Appliances:

Built In Appliances ☐ Yes ☒ No

Slide In Stove ☐ Yes ☒ No

Dishwasher Cabinet ☐ Closed ☒ Open

41" Upper Cabinets ☒ Yes ☐ No

Please NOTE: Standard Cabinet Height is 30"

Stove Opening

NOTE: If not specified, opening will be set to builder's standard opening of approximately 30" width

Fridge Opening

NOTE: If not specified, opening will be set to builder's standard opening of approximately 37" width x 74" height

** Refer to Construction Summary

2. Counters

	Counter	Edge
Kitchen / Breakfast	LAMINATE-WHITE CARRARA 4924-38	
Laundry Room	N/A	
Powder Room	LAMINATE-WHITE TIGRIS 4783-60	
Master Ensuite Bathroom	LAMINATE-WHITE CARRARA 4924-38	
Ensuite Bath - Bedroom 2/3	LAMINATE-WHITE CARRARA 4924-38	
Ensuite Bath - Bedroom 4	LAMINATE-PALOMA POLAR 6698-46	
	N/A	
	N/A	
	N/A	

** Refer to Construction Summary

Initials:

M-Y

LM

Purchasers:

MARIO G YOUSIF & LAURA DEMIANA YOUSIF

Property: 330

Telephone Res. / Bus:

(289) 400-3340 /

Project: Russell Gardens Building Ltd.

Decor Advisor:

Candace Forza

Model and Elevation: Valleycreek Twelve Elev 1

Lock Date:

26-Aug-21

26-Aug-21

Plan #:

62M-1266

3. Ceramic Flooring

At a 45 Threshold-If App.

Entrance Vestibule	TILE-STONE WHITE-12 1/4 X 24 1/4	<input type="checkbox"/>	metal strip where applicable
Main Hall	STRIP	<input type="checkbox"/>	
Kitchen / Breakfast	STRIP	<input type="checkbox"/>	
Laundry Room	TILE-RAINBOW LIGHT GREY-13X13	<input type="checkbox"/>	
Powder Room	TILE-STONE WHITE-12 1/4 X 24 1/4	<input type="checkbox"/>	
Master Ensuite Bathroom	TILE-STONE WHITE-12 1/4 X 24 1/4	<input type="checkbox"/>	
Ensuite Bath - Bedroom 2/3	TILE-RAINBOW LIGHT GREY-13X13	<input type="checkbox"/>	
Ensuite Bath - Bedroom 4	TILE-COLOURS NERO-13X13	<input type="checkbox"/>	
SIDE/GARAGE ENTRY	TILE-STONE WHITE-12 1/4 X 24 1/4	<input type="checkbox"/>	
	N/A	<input type="checkbox"/>	
	N/A	<input type="checkbox"/>	

** Refer to Construction Summary

4. Ceramic Wall Tile

Master Ensuite Bathroom	Selection	Describe
Tub Deck Wall	N/A	
Tub Deck	N/A	
Tub Deck Skirt	N/A	
Shower Stall	TILE-BIANCO MATTE-8X16	
Bathtub Enclosure Walls	N/A	
Ensuite Bath - Bedroom 2/3	TILE-BIANCO MATTE-8X16	
Ensuite Bath - Bedroom 4	TILE-BIANCO MATTE-8X16	
SIDE/GARAGE ENTRY	N/A	
	N/A	
	N/A	
Kitchen Backsplash	N/A	

** Refer to Construction Summary - STANDARD GROUT THROUGHOUT UNLESS SPECIFIED

5. Plumbing Fixtures

All Bathrooms

White

N/A

N/A

Whirlpool

N/A

☐ Yes

☒ No

Dishwasher Rough-In

☒ Yes

☐ No

Waterline for Fridge

☒ Yes

☐ No

** Refer to Construction Summary

6. Trim Carpentry

Interior Doors	CARRARA-SMOOTH
Interior Trim	As Per Construction Specifications
Door Handles	As Per Construction Specifications
Exterior Front Door Handle	As Per Construction Specifications

** Refer to Construction Summary

Purchasers:

MARIO G YOUSIF & LAURA DEMIANA YOUSIF

Property:

330

Telephone Res. / Bus:

(289) 400-3340 /

Project:

Russell Gardens Building Ltd.

Decor Advisor:

Candace Forza

Model and Elevation:

Valleycreek Twelve Elev 1

Lock Date:

26-Aug-21

26-Aug-21

Plan #:

62M-1266

7. Other Flooring

Main Hall	N/A	
Living Room	N/A	
Dining Room	STRIP-MIRAGE-SWEET MEMORIES-CHARACTER-BRUSHED-WHITE OAK-DURAMATT-SANDCASTLE-5"	
Family Room	STRIP-MIRAGE-SWEET MEMORIES-CHARACTER-BRUSHED-WHITE OAK-DURAMATT-SANDCASTLE-5"	
Den / Library / Study	STRIP-MIRAGE-SWEET MEMORIES-CHARACTER-BRUSHED-WHITE OAK-DURAMATT-SANDCASTLE-5"	
Basement Landing(If Applies)	N/A	
Lower Landing (If Applies)	STRIP-MIRAGE-SWEET MEMORIES-CHARACTER-BRUSHED-WHITE OAK-DURAMATT-SANDCASTLE-5"	
Upper Landing	STRIP-MIRAGE-SWEET MEMORIES-CHARACTER-BRUSHED-WHITE OAK-DURAMATT-SANDCASTLE-5"	
Upper Hall	LAMINATE-PARKLANE-OLD OAK MATT OILED-TL-EL-312	
Master Bedroom	LAMINATE-PARKLANE-OLD OAK MATT OILED-TL-EL-312	
Bedroom #2	LAMINATE-PARKLANE-OLD OAK MATT OILED-TL-EL-312	
Bedroom #3	LAMINATE-PARKLANE-OLD OAK MATT OILED-TL-EL-312	
Bedroom #4	LAMINATE-PARKLANE-OLD OAK MATT OILED-TL-EL-312	
Bedroom #5	N/A	
KITCHEN & BREAKFAST	STRIP-MIRAGE-SWEET MEMORIES-CHARACTER-BRUSHED-WHITE OAK-DURAMATT-SANDCASTLE-5"	
	N/A	
	N/A	
Underpad	Type	Area
	N/A	N/A

** Refer to Construction Summary

8. Railings and Pickets

Railing Type	AS PER CONSTRUCTION SPECIFICATIONS	Complimentary Colour	MIRAGE SANDCASTLE WHITE OAK
Picket Type	EUROLINE 1	Complimentary Colour	BLACK
Stringer / Riser	AS PER CONSTRUCTION SPECIFICATIO	Complimentary Colour	MIRAGE SANDCASTLE WHITE OAK
Treads	AS PER CONSTRUCTION SPECIFICATIO	Complimentary Colour	MIRAGE SANDCASTLE WHITE OAK
Red Oak Stairs <input checked="" type="radio"/> Yes <input type="radio"/> No			

** Refer to Construction Summary THE STAIN COLOURS OR FINISH AVAILABLE ON RISERS, TREADS, PICKETS AND RAILS (STAIRCASES), WILL NOT BE AN EXACT MATCH TO PREFINISHED HARDWOOD OR LAMINATE FLOORS.

9. Wall Paint Flat Finish

Main & Upper Hall	22 WARM GREY	Master Bedroom	22 WARM GREY
Living Room	N/A	Bedroom #2	22 WARM GREY
Dining Room	22 WARM GREY	Bedroom #3	22 WARM GREY
Kitchen / Breakfast	22 WARM GREY	Bedroom #4	22 WARM GREY
Family Room	22 WARM GREY	Bedroom #5	N/A
Powder Room	22 WARM GREY	Master Ensuite	22 WARM GREY
Laundry Room	22 WARM GREY	Ensuite Bath - Bedroom 2/3	22 WARM GREY
Den/Library	22 WARM GREY	Ensuite Bath - Bedroom 4	22 WARM GREY
Trim & Door Paint-Semi Gloss	BIRCH WHITE		N/A
	N/A		N/A
	N/A		N/A
Smooth Ceilings First Floor <input checked="" type="radio"/> Yes <input type="radio"/> No			

** Refer to Construction Summary

Initials:

M-Y

Y4

Purchasers: MARIO G YOUSIF & LAURA DEMIANA YOUSIF

Property: 330

Telephone Res. / Bus: (289) 400-3340 /

Project: Russell Gardens Building Ltd.

Decor Advisor: Candace Forza

Model and Elevation: Valleycreek Twelve Elev 1

Lock Date: 26-Aug-21

26-Aug-21

Plan #: 62M-1266

10. Plaster Mouldings and Medallions

Entrance Vestibule	N/A	N/A	Kitchen/Breakfast	N/A	N/A
Main Hall	N/A	N/A	Den/Library	N/A	N/A
Living Room	N/A	N/A	Lower Landing	N/A	N/A
Dining Room	N/A	N/A		N/A	N/A
Family Room	N/A	N/A			

** Refer to Construction Summary

11. Fireplace

Living Room			Family Room			Other Room - Specify		
Purchased	As Per Plan	N/A	Purchased	As Per Plan	N/A	Purchased	As Per Plan	N/A
<input type="radio"/>	<input type="radio"/>	<input checked="" type="radio"/>	<input type="radio"/>	<input checked="" type="radio"/>	<input type="radio"/>	<input type="radio"/>	<input type="radio"/>	<input checked="" type="radio"/>
Fireplace Type	N/A		FLAT ON WALL		N/A			
Mantle Type	N/A		MANTLE M2-STANDARD		N/A			
Colour / Stain	N/A		AS PER CONSTRUCTION SPECIFICATIONS		N/A			
Surround	N/A		BIANCO		N/A			
Hearth	N/A		NO		N/A			

** Refer to Construction Summary

12. Heating and Air Conditioning

Air Conditioning	NO	Gas Provisions Stove	YES
Gas Provisions Dryer	NO	Gas Provisions Barbecue	YES
Comment			

** Refer to Construction Summary

13. Electrical

Plugs and Switches	<input checked="" type="radio"/> White	DECOR	Above Kitchen Cabinet Light	<input type="radio"/> Yes	<input checked="" type="radio"/> No
Hood Fan	STANDARD WHITE TEMP.		Below Kitchen Cabinet Light	<input type="radio"/> Yes	<input checked="" type="radio"/> No
Appliances	Built in Cooktop	Built in Oven	Gas Stove	Microwave	
	<input type="radio"/> Yes <input checked="" type="radio"/> No	<input type="radio"/> Yes <input checked="" type="radio"/> No	<input checked="" type="radio"/> Yes <input type="radio"/> No	<input type="radio"/> Yes <input checked="" type="radio"/> No	
Dishwasher Rough-in	Yes				


** Refer to Construction Summary


14. General Comments

** Refer to Construction Summary

Disclaimers and Notes


- 1) Colours of all materials are as close as possible to builder's selection, but not necessarily identical due to variances in manufacturing.
- 2) Any extras listed above are null and void unless accompanied by a separate invoice/amendment. Said invoice must be paid in full.
- 3) The Purchaser agrees that this colour selection is final and that no changes will be permitted, unless required by the Vendor.
- 4) The Purchaser acknowledges reading and accepting document which contains other miscellaneous disclaimers.

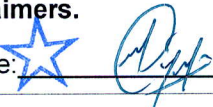
Signature:  Date: Aug 26/21

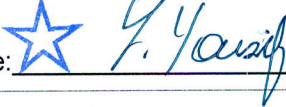
Signature:  Date: Aug 26/21

Kitchen

- upg. 2 Sonata Cabinetry
- Different Colour Cabinet On Island.

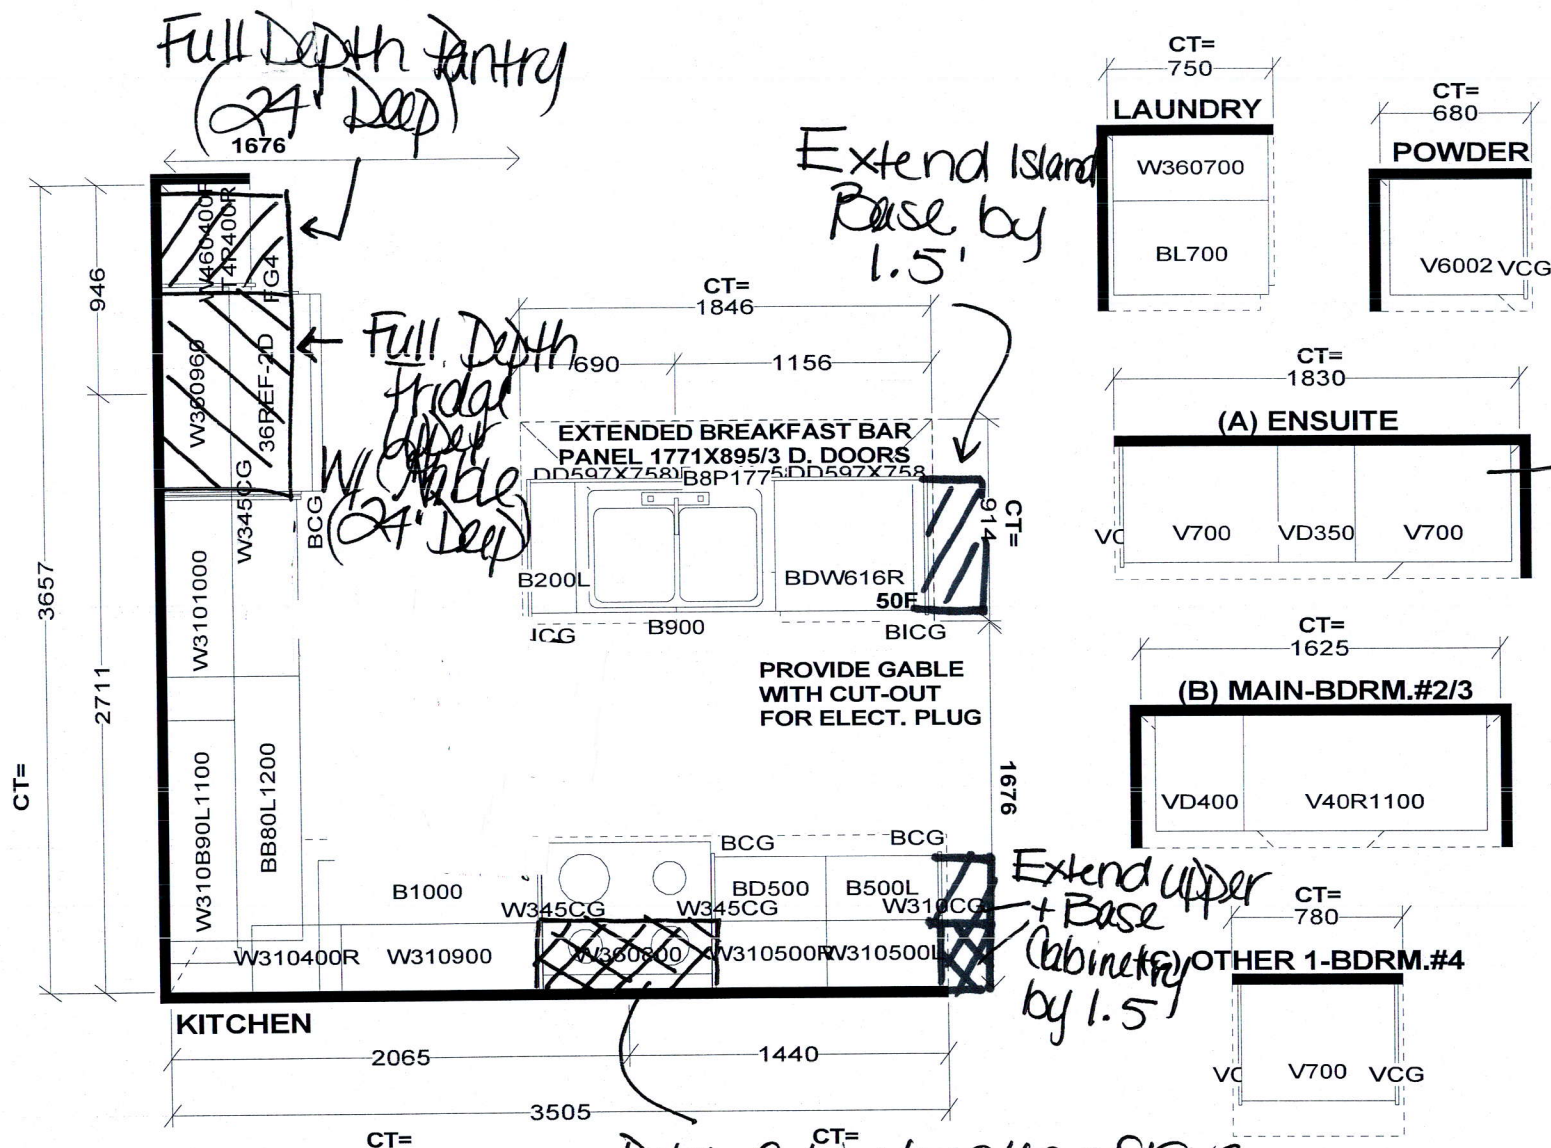

Selba Industries			J#
W WIDTH	W HGHT	W CNT	JOB NUMBER: BUILDER: GREENPARK SITE: RUSSELL GARDENS PH.3 MODEL: VALLEYCREEK 12X EL 1,2,3 LOT #:
FLOOR HGHT	DOOR HGHT		
ST. CENT	2X4	VENT BOX COVER	
<small>This drawing is the intellectual property of SELBA INDUSTRIES INC. and is an original design which must not be released or copied unless applicable fee has been paid or job order placed.</small>			
			DESIGNER: KS DATE: MAY 13 20

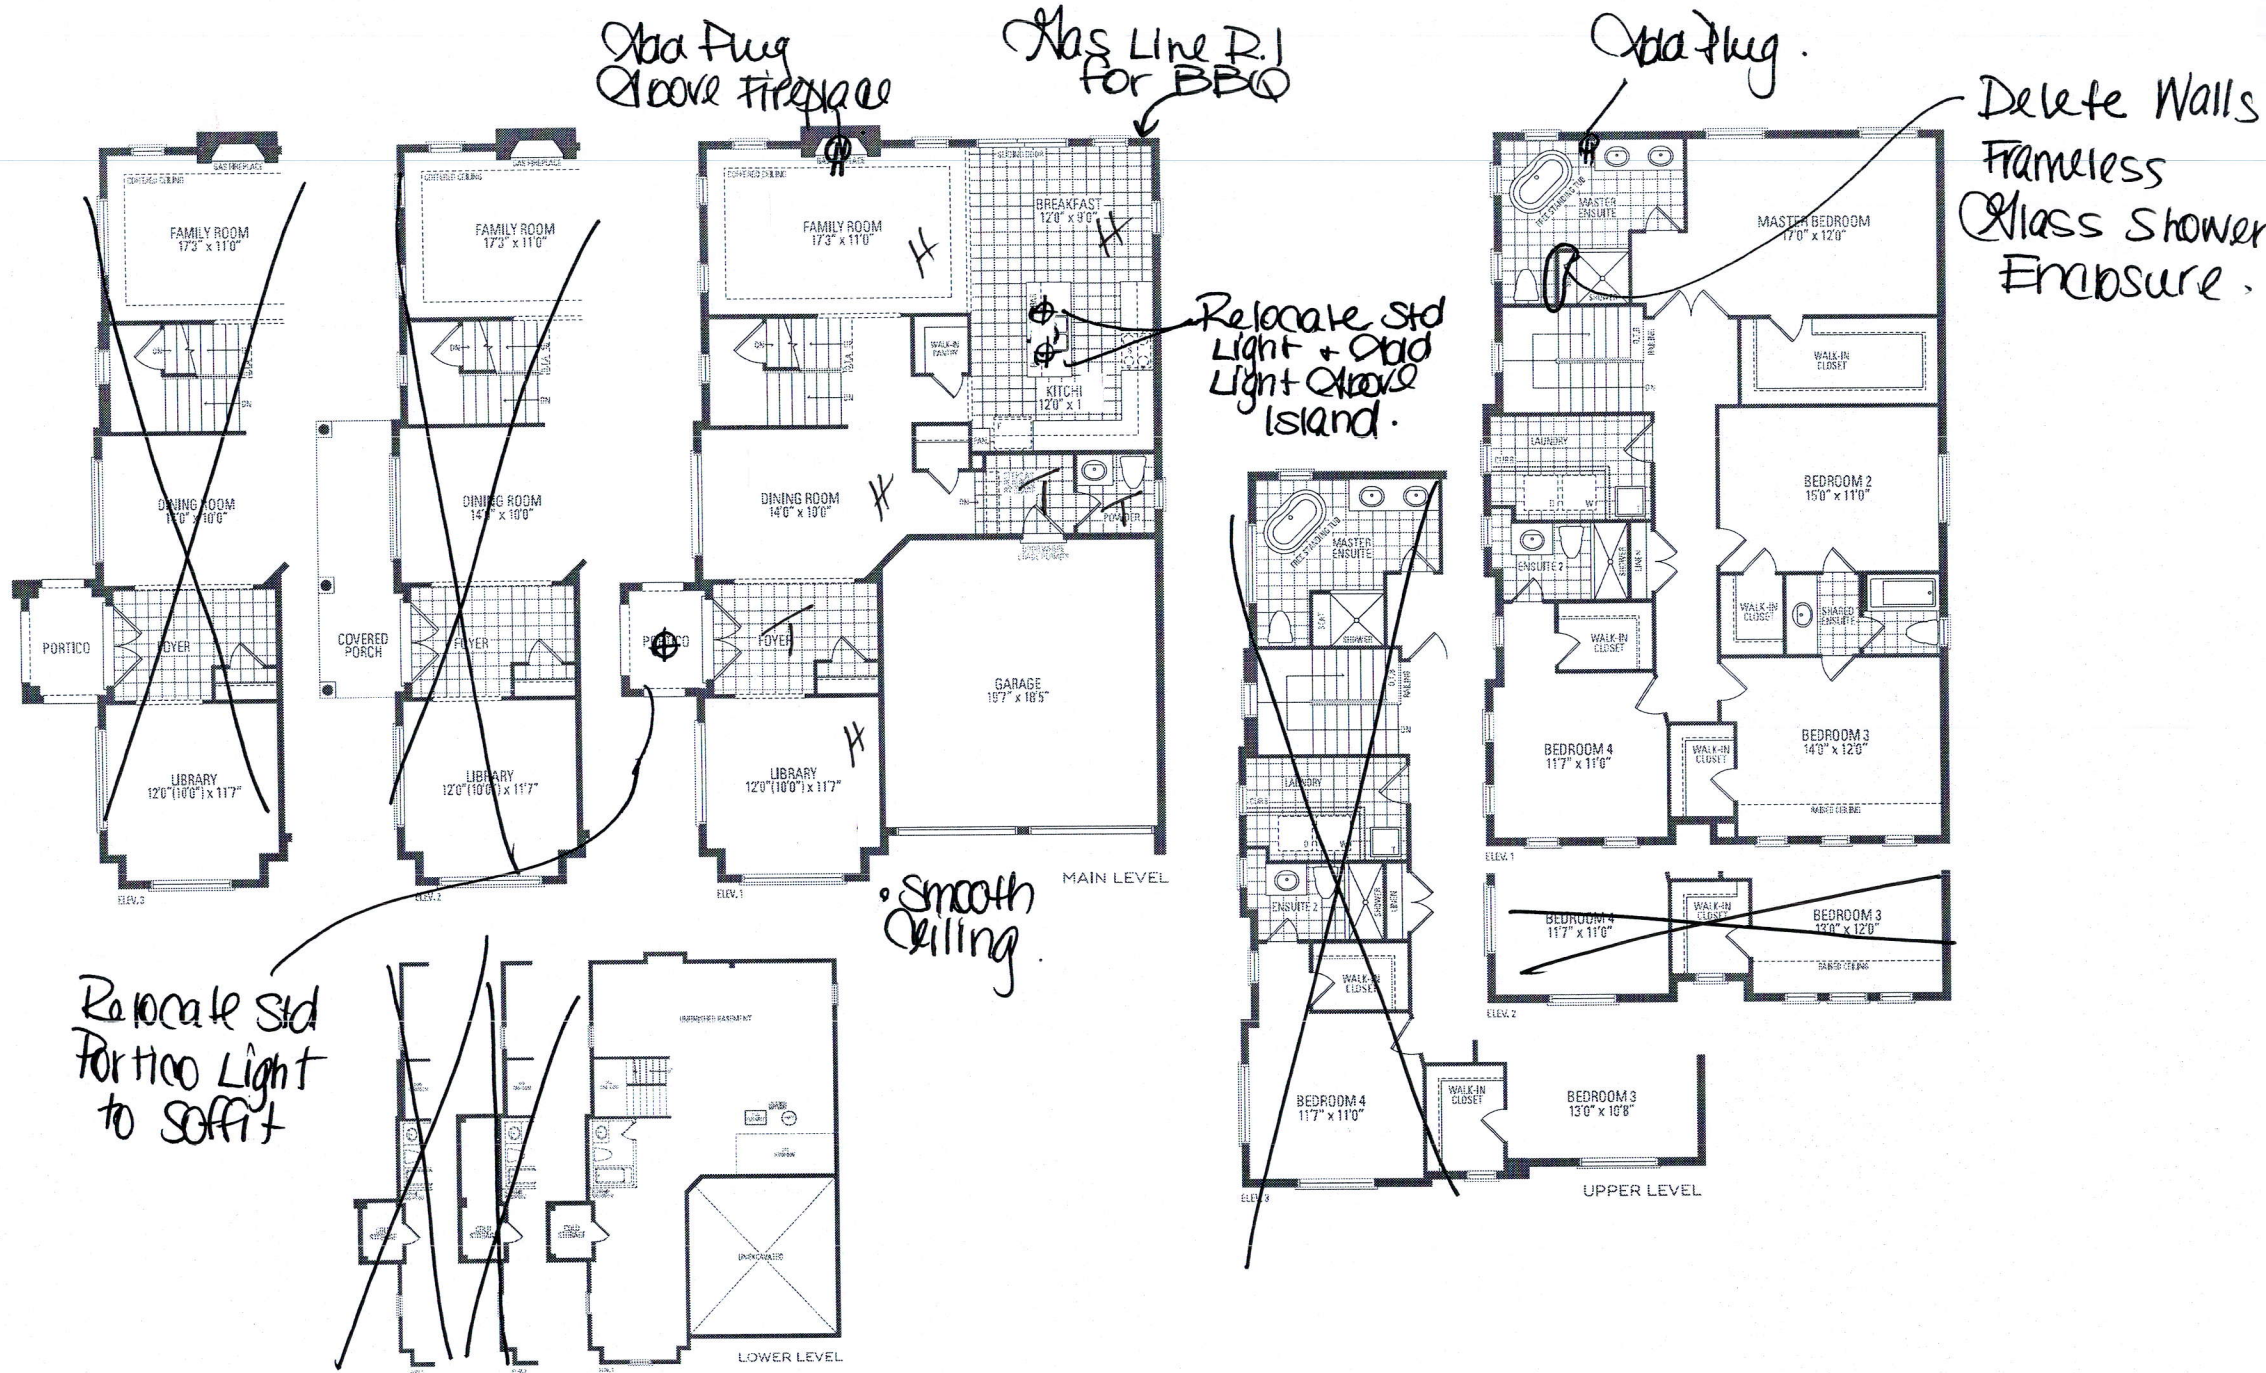

VALLEYCREEK TWELVE ELEV. 1 • 2,742 sq.ft. | ELEV. 2 • 2,740 sq.ft. | ELEV. 3 • 2,729 sq.ft.

Orientation of home may be reversed and purchaser agrees to accept the same. Steps and porches may vary at any exterior entrance ways due to grading variance. Actual usable floor space may vary from the stated floor areas. All renderings are artist's concept. Dimensions, specifications and architectural detailing subject to modifications. Roofline and adjoining model types may vary due to siting. E. & O. E. May 2020