Greenpark.

Revised-Sketch Attached,

## **CONSTRUCTION SUMMARY**

Mountainview Heights 3 (G) - Russell Gardens Building Ltd.

OCT 2 5 2021

PURCHASERS: ANTONIO DE STASIO and ANTONINA DE STASIO

TEL: RES.: 905-462-1715


LOT / PHASE 236 / 3	REG. PLAN # 62M-1266	HOUSE TYPE Mountainash Twelve Elev 1		
CONSTRUCTION				
1 - SMOOTH CEILINGS ON 07Apr21 Note:	FIRST FLOOR ONLY	- DET		
ELECTRICAL				
1 - RELOCATE STANDARI 07Apr21 Note:	O KITCHEN LIGHT TO	BE CENTERED OVER ISLAND		
1 - PLUG - ELECTRICAL P. 07Apr21 Note:	LUG - GARAGE			
1 - POT LIGHT - LED - SEC 07Apr21 Note:	COND FLOOR INSTALL	ATION - WIRE TO SEPERATE SWITCH FROM STAN	DARD LIGHT - FLEX	ROOM
1 - POT LIGHT - LED - SEC 07Apr21 Note:	COND FLOOR INSTALL	ATION WIRE TO SEPERATE SWITCH FROM STAI	NDARD LIGHT - UPPE	ER HALL
1 - POT LIGHT - LED - FIR: BREAKFAST 07Apr21 Note:	ST FLOOR INSTALLAT	TON - WIRE TO SEPERATE SWITCH FROM STANDA	RD LIGHT - KITCHEN	I
1 - POT LIGHT - LED - FIR: WORKSPACE 07Apr21 Note:	ST FLOOR INSTALLAT	TON - WIRE TO SEPERATE SWITCH FROM STANDA	RD LIGHT - KITCHEN	I .
1 - POT LIGHT - LED - FIR 07Apr21 Note:	ST FLOOR INSTALLAT	TON - WIRE TO SEPERATE SWITCH FROM STANDA	RD LIGHT - FAMILY	ROOM
1 - POT LIGHT - LED - FIRE ROOM 07Apr21 Note:	ST FLOOR INSTALLAT	TION - WIRE TO SEPERATE SWITCH FROM STANDA	RD LIGHT - LIVING/I	DINING
1 - POT LIGHT - LED - FIR 07Apr21 Note:	ST FLOOR INSTALLAT	TION - WIRE TO SEPERATE SWITCH FROM STANDA	RD LIGHT - LIBRARY	,
1 - POT LIGHT - LED - FIR 07Apr21 Note:	ST FLOOR INSTALLAT	TION - WIRE TO SEPERATE SWITCH FROM STANDA	RD LIGHT - MAIN HA	ALL
1 - POT LIGHT - LED - FIR 07Apr21 Note:	ST FLOOR INSTALLAT	TION - WIRE TO SEPERATE SWITCH FROM STANDA	RD LIGHT - FOYER	
2 - PLUG - ELECTRICAL P 07Apr21 Note:	LUG WITH GFI AND S	WITCH - FOR FESTIVE LIGHTING  LOCATION	Altach	edt
1 - STANDARD DINING ROOM LIGHT TO BE CENTERED BETWEEN LIVING AND DINING ROOM  07Apr21 Note:				
HARDWOOD FLOORING				
1 - AS PER PURCHASERS	REQUEST - INSTALL I	AMINATE FROM BUILDERS STANDARD SAMPLES	ON FIRST FLOOR -S	TANDARD

NON-TILED AREAS ONLY

1 - LAMINATE – UPGRADE TO FJORD SERIES IN LIEU OF STANDARD LAMINATE

07Apr21 Note:

07Apr21 Note:

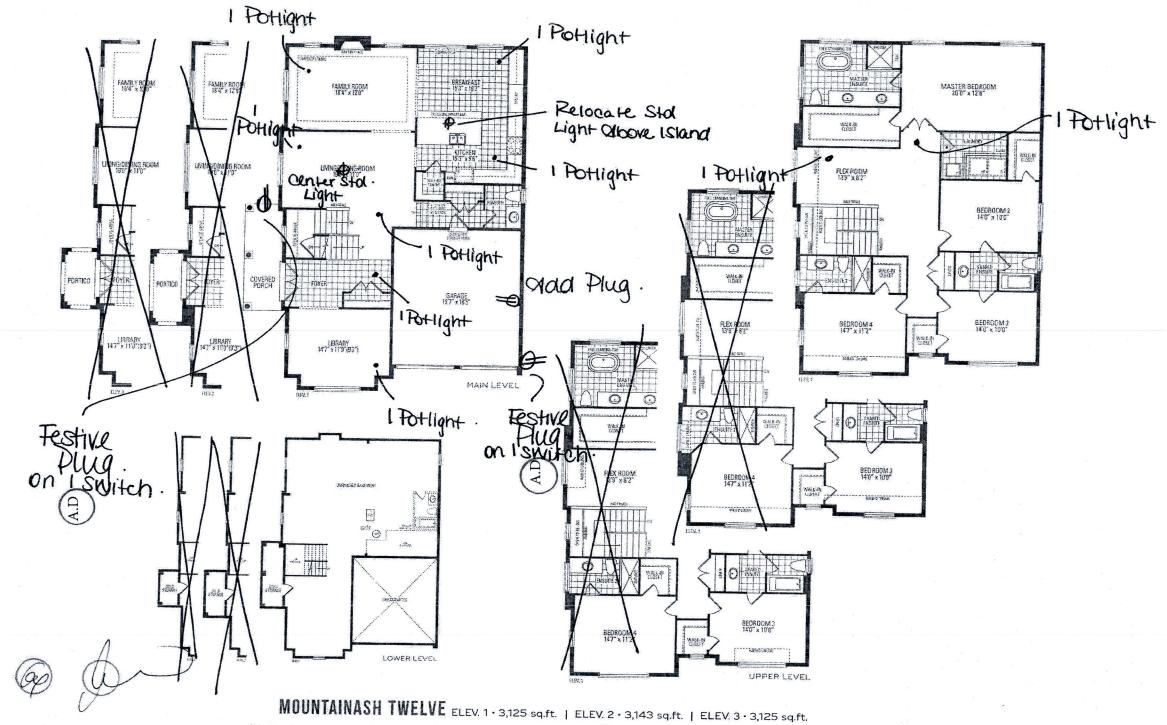

Orientation of home may be reversed and purchaser agraes to addept the same. Steps and purchas may vary at any exterior outrance ways due to grading variance. Actual isable floor space may vary from the stated floor areas. All renderings are actions concept. Dimensions, specifications and architectural detailing subject to modifications. Roofine and arigining model types may vary due to string. E. & D. E. May 2020