

CONSTRUCTION SUMMARY

Mountainview Heights 3 (G) - Russell Gardens Building Ltd.

PURCHASERS: Paramjit SINGH and Baljinder K. MULTANI

TEL: RES.: 647-470-9940

LOT / PHASE	REG. PLAN #	HOUSE TYPE		
294 / 3	62M-1266	Mountainash Five (4 Bedroom) Elev 2		

CABINETRY


1 - CABINETRY - KITCHEN - LIGHT VALENCE - NO ELECTRICAL 03Mar21 Note:	
1 - CABINETRY - KITCHEN - CM3 CROWN MOULDING 03Mar21 Note:	
1 - KITCHEN CABINETRY - DIFFERENT COLOUR ISLAND - FLAT FEE 03Mar21 Note:	
1 - CABINETRY - KITCHEN - HARDWARE UPGRADE 1 03Mar21 Note:	
1 - CABINETRY - KITCHEN - UPGRADE 3 03Mar21 Note:	
1 - CABINETRY PROVISION - PROVISION FOR PLUG ON ISLAND (PLUG EXTRA ORDERED SEPARATELY) 03Mar21 Note:	

CABINETRY ACCESSORIES

1 - KICTHEN - RELOCATE BANK OF DRAWERS TO ISLAND 24Nov21 Note:	New	★
1 - KITCHEN CABINETRY BASE - POT/PAN DRAWERS (CABINET) - UPGRADE 3 - INSTALLED IN ISLAND 24Nov21 Note:	New	★
1 - KITCHEN CABINETRY BASE - POT/PAN DRAWERS (CABINET) - UPGRADE 3 - INSTALLED BELOW COOKTOP 24Nov21 Note:	New	★
1 - CABINETRY FEE FOR FLUSH CUTOUT ON WALL OVEN/MICROWAVE COMBO CABINET ONLY 09Mar21 Note:		
1 - KITCHEN - BLU MOTION DRAWERS 03Mar21 Note:		
1 - KITCHEN - DELETE PANTRY TO ACCOMMODATE 42" FRIDGE 03Mar21 Note:		
1 - VANITY CABINETRY - RAISE VANITY TO 36" HIGH VANITY IN LIEU OF STANDARD HEIGHT - ENSUITE 4 BATHROOM 03Mar21 Note:		
1 - VANITY CABINETRY - RAISE VANITY TO 36" HIGH VANITY IN LIEU OF STANDARD HEIGHT - ENSUITE 2 BATHROOM 03Mar21 Note:		
1 - VANITY CABINETRY - RAISE VANITY TO 36" HIGH VANITY IN LIEU OF STANDARD HEIGHT - MASTER ENSUITE BATHROOM 03Mar21 Note:		
1 - VANITY CABINETRY - RAISE VANITY TO 36" HIGH VANITY IN LIEU OF STANDARD HEIGHT - POWDER ROOM 03Mar21 Note:		
1 - KITCHEN CABINETRY - APPLIANCE DOOR PANELS - 24" DISHWASHER DOOR PANEL (SUPPLY ONLY) - UPGRADE 3 03Mar21 Note:		

Kitchen

- Upg-3 Legacy Cabinetry
- 2nd Colour Cabinet On Island.
- Mini Stacked Upper Cabinetry
- cm 3 moulding
- Light Valance.
- Blumotion Drawers

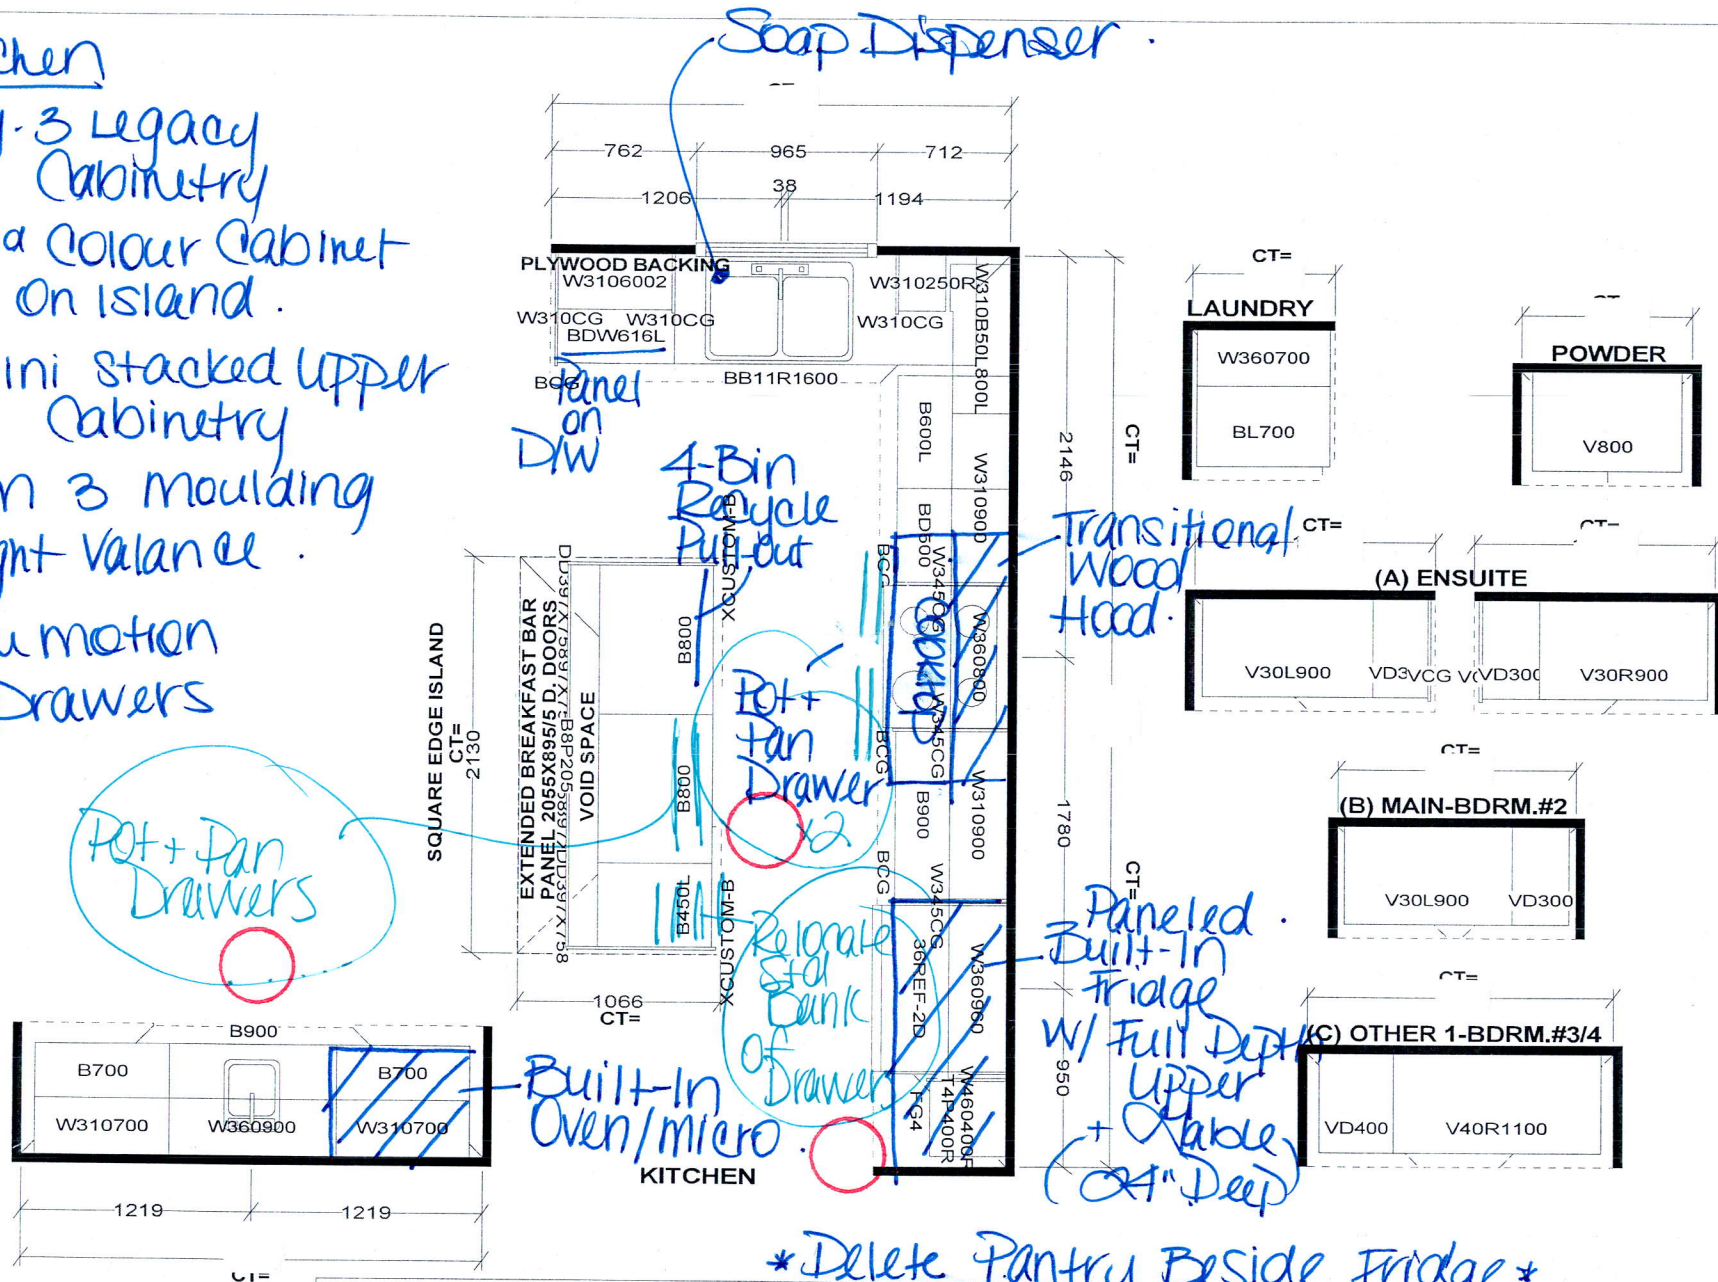

Delete Pantry Beside Fridge

Selba Industries J#			This drawing is the intellectual property of SELBA INDUSTRIES INC. and is an original design which must not be released or copied unless applicable fee has been paid or job order placed.	JOB NUMBER:
W WDTN _____ W HGHT _____ W CNT _____	BUILDER: GREENPARK		SITE: RUSSELL GARDENS PH.3 MODEL: MOUNTAINASH 5X EL 1,2,3 LOT #:	
FLOOR HGHT _____ DOOR HGHT _____	DESIGNER: KS DATE: MAY 13 20			
ST. CENT _____ 2X4 _____ VENT BOX COVER _____				