



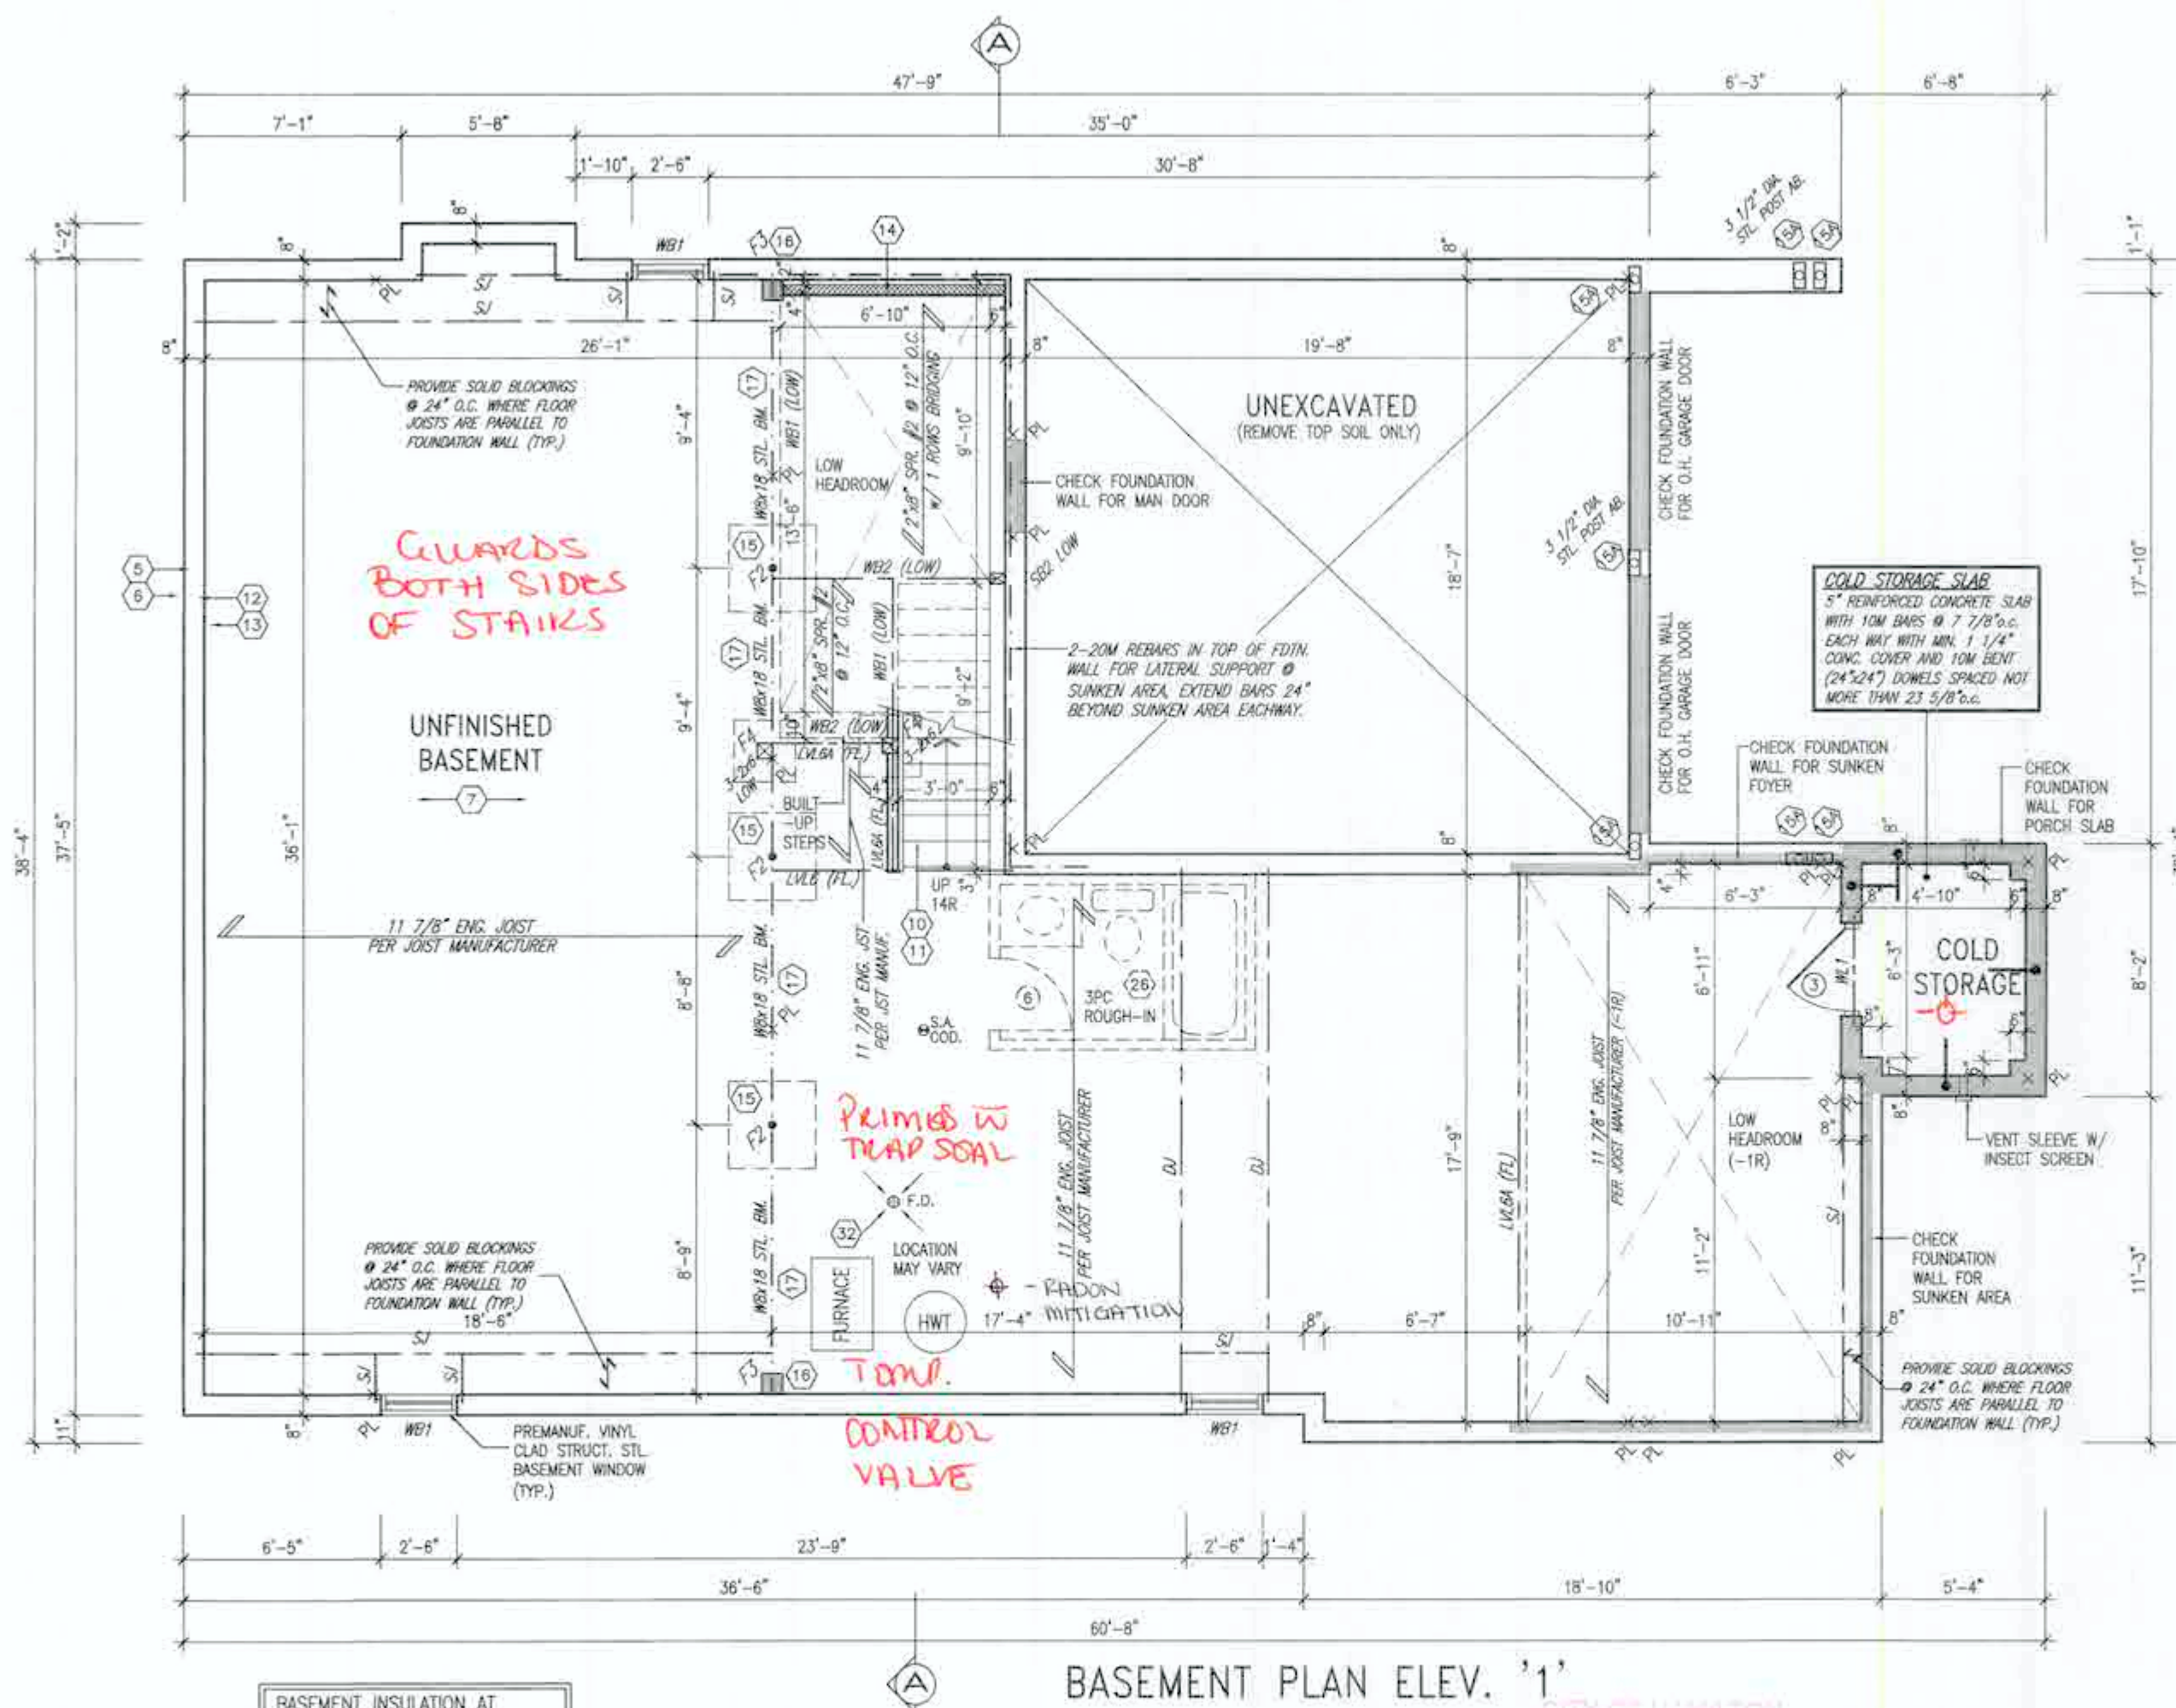

BASEMENT PLAN ELEV. '1'

21-141951

Dr. Dan 4/22

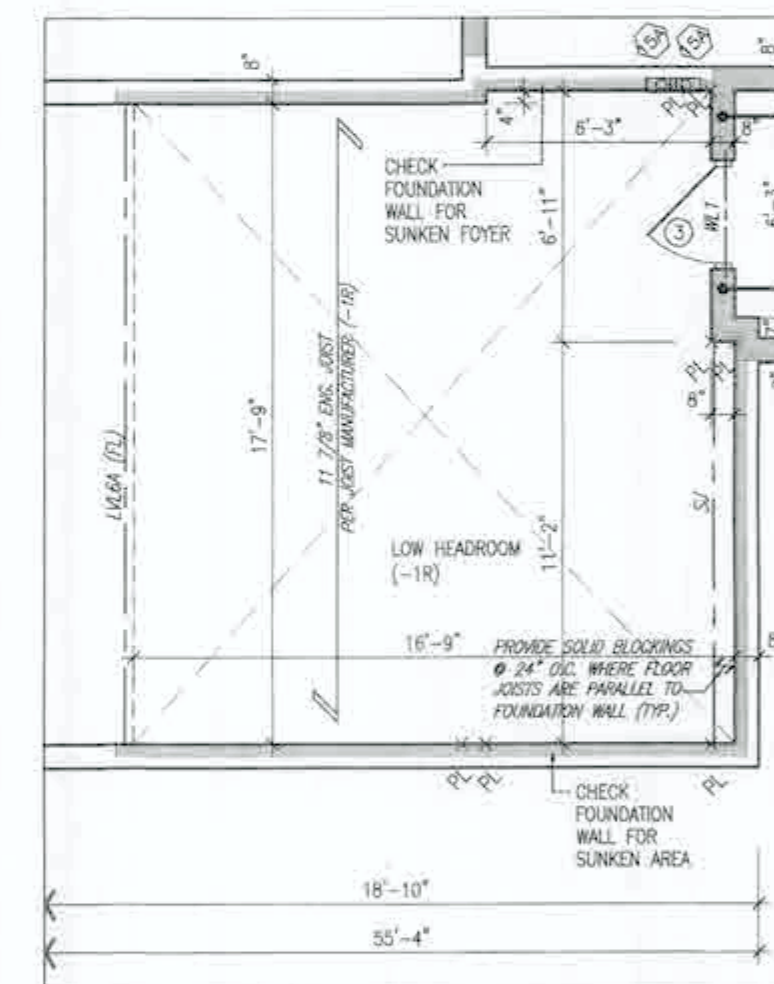

PART. BASEMENT PLAN ELEV. '1'
FOR OPT. GUEST SUITE COND.

It is the builder's complete responsibility to ensure that all plans submitted for approval fully comply with the Architectural Guidelines and all applicable regulations and requirements including zoning provisions and any provisions in the subdivision agreement. The Control Architect is not responsible in any way for examining or approving site (lotting) plans or working drawings with respect to any zoning or building code or permit matter of that any house can be properly built or located on its lot.

This is to certify that these plans comply with the applicable Architectural Design Guidelines approved by the City of HAMILTON

This is to certify that these plans comply with the applicable Architectural Control Guidelines approved by the City of HAMILTON

RUTH A. WILLIAMS LTD., ARCHITECT
ARCHITECTURAL CONTROL REVIEW
MID ATTACHED

Approved by me 
DATE AUG 15, 2012

This permit address compliance with the applicable
General Compliance only. All plans & permitted
structures are subject to inspection.



STRUDET INC.
FOR STRUCTURE ONLY

18					3	The undersigned has reviewed and takes responsibility for this design and and has the qualifications and meets the requirements set out in the Ontario Building Code to be a Designer.		VA3		project name		municipality		project no.	
17					2	Richard Vink		24488		RUSSELL GARDENS PH.4		HAMILTON, ON		200227	
16					1	signature		TCO						drawing no.	
15					6	VA3 Design Inc.		42556						A1	
14					5										
13					4										
12					3	ISSUED FOR PERMIT.		MAY 21/21						BASEMENT PLAN - ELEV. 1	
11					2	REV. PER CLIENT/PROOF/FL/ENG. COMMENTS		MAR. 31/21						date	
10					1	PRELIMINARY, ISSUED FOR CLIENT REVIEW.		MAR 12/21						CL	
9					no.	description		date						drawing no.	
8					no.	description		date						drawing no.	

All drawings, specifications, printed documents and design are the copyright property of V&I DESIGN. Reproduction of this property in whole or in part is strictly prohibited without V&I DESIGN's written permission.



REGISTERED PROFESSIONAL ENGINEER
B. MARINKOVIC
No. 110,000
STATE OF OHIO

MA 26/202

STRUDET INC.
FOR STRUCTURE ONLY

PART. BASEMENT PLAN ELEV. '3'
FOR OPT. GUEST SUITE COND.

SPRINGFIELD 3S
COMPLIANCE PACKAGE 'A1'

Greenpark. SPRINGFIELD 3S
14.30m



Greenpark. SPRINGFIELD 3S
14.30m

	project name	municipality	project no.
	RUSSELL GARDENS PH.4	HAMILTON, ON	20027
date	DOCUMENT PLAN - FLEV. 2		drawing no.

255 Consumers Rd Suite 120
Toronto, ON M2J 1R4
T: 416.630.2255, F: 416.630.4782
www.design.com

JANUARY, 2021


drawn by: _____ checked by: _____

CL $3/16" = 1'-0"$

20027 - SPRINGFIELD - 3S

A1b

[illegible]

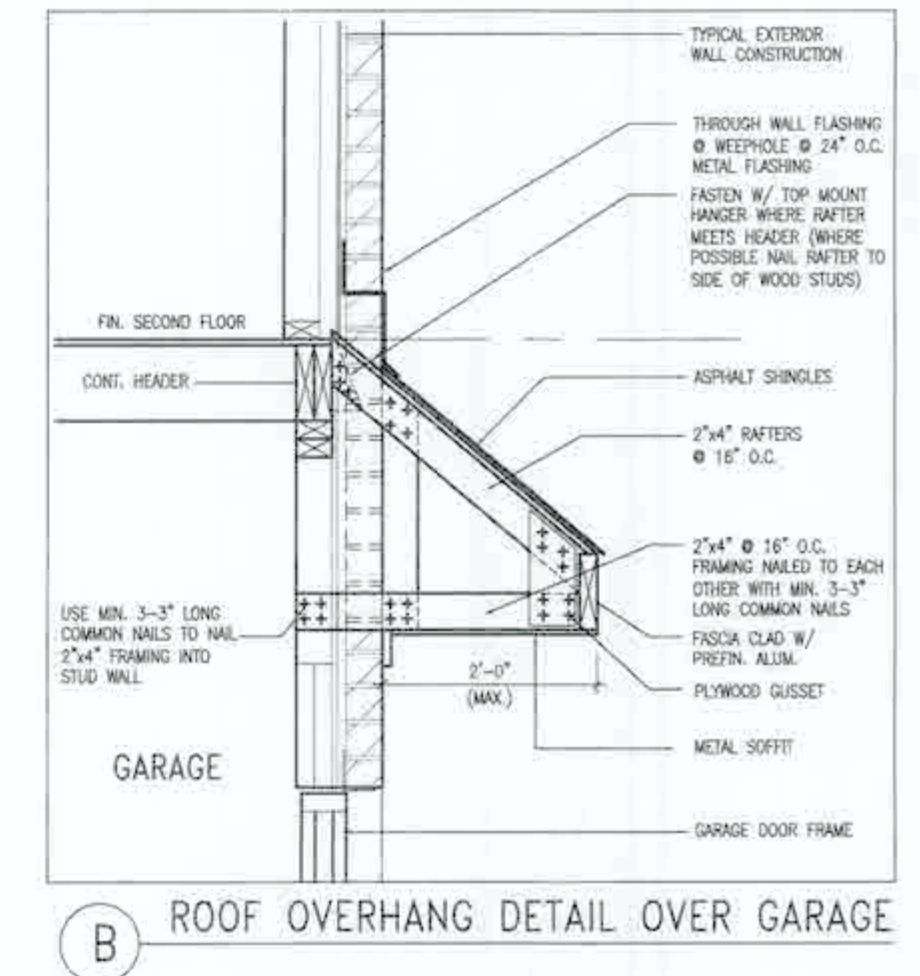

21-16/951


Sm Jan 4/22

All drawings, specifications, related documents and design are the copyright property of V&S DESIGN. Reproduction of this property in whole or in part is strictly prohibited without V&S DESIGN's written permission.

OUTDOOR AIR INTAKE SEPARATION
ALL OUTDOOR AIR INTAKE VENTS TO BE SEPARATED A MINIMUM DISTANCE FROM SOURCES OF CONTAMINATION PER CBC, DIV. B- TABLE 6.2.3.12.

* KITCHEN EXHAUST	3.0m
* DRIVEWAY, PARKING SPACE, ROAD	1.5m
* SOLID FUEL APPLIANCE EXHAUST	3.0m

6.1-33-NBC-2000

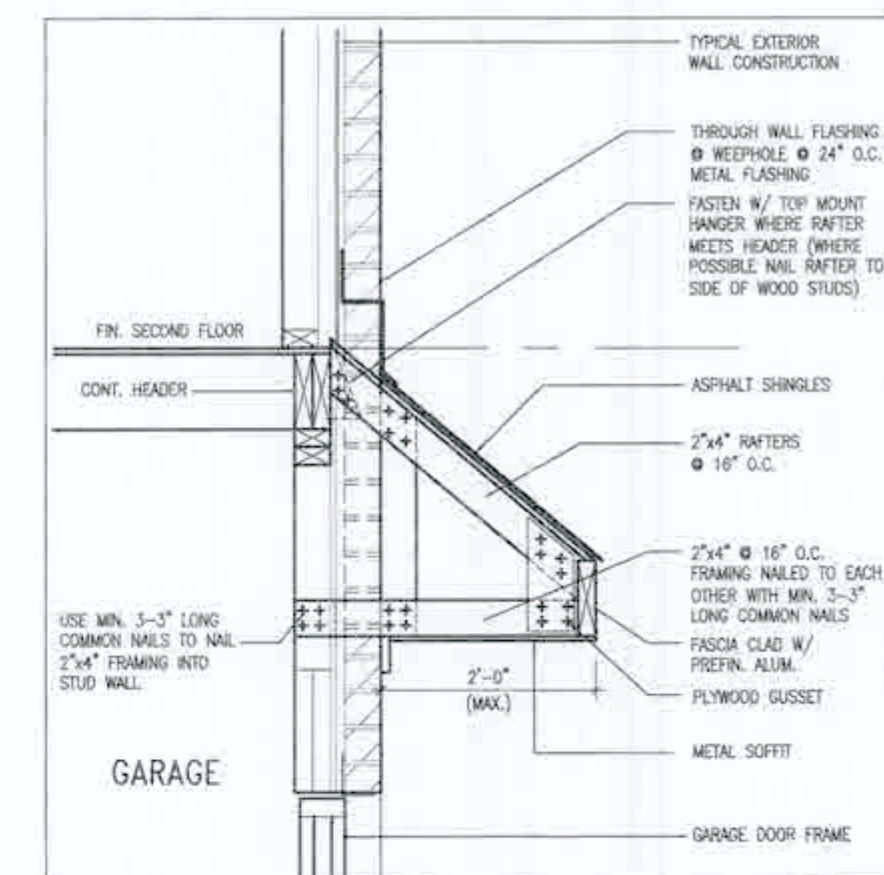

(D) ROOF OVERHANG DETAIL OVER GARAGE

21-141951

8m Jan 4/22

NOTE 1:
FLAT ROOF FRAMING (TYP.)
2"x8" @ 12" O.C. P.T. CLG. JS
w/ 2"x4" @ 12" O.C. P.T.
DIAGONALLY CUT CROSS PURLINE
w/ 5/8" EXTERIOR GRADE
SHEATHING + SINGLE PLY ROOF
MEMBRANE (SLOPE TO DRAIN)

It is the builder's complete responsibility to ensure that all plans submitted for approval fully comply with the Architectural Guidelines and applicable regulations and requirements including zoning provisions and any provisions in the subdivision agreement. The Control Architect is not responsible in any way for examining or approving site (lotting) plans or zoning drawings with respect to any zoning or building code or permit matter or that any house can be properly built or located on its lot.

This is to certify that these plans comply with the applicable Architectural Design Guidelines approved by the City of HAMILTON

JOHAN C. WILLIAMS LTD., ARCHITECT
ARCHITECTURAL CONTROL NUMBER
AND ADDRESS

Architect's Stamp
DATE AUG 17, 2012

This stamp certifies compliance with the applicable
Building Code requirements for the project.



STRUDET INC.
FOR STRUCTURE ONLY

[illegible]


All design specifications, related documents and design are the copyright property of VAI DESIGN. Reproduction of this artwork in whole or in part is strictly prohibited without VAI DESIGN's written permission.



17			9				The undersigned has reviewed and takes responsibility for this design and any fees and qualifications and meets the requirements set out in the Ontario Building Code to be a Designer.	 255 Connaught Rd. Suite 120 Toronto ON M6Z 1R4 (416) 593-2225 • 416-593-4762 va3design.com	 project name RUSSELL GARDENS PH.4	municipality HAMILTON, ON	project no. 20027	drawing no. A2b	
16		8				Richard Vink	2488						
15		7				signature	2488						
14		6				name	2488						
13		5				registration information	42558						
12		4				VA3 Design Inc.							
11		3				ISSUED FOR PERMIT	MAY 21/21	ON					
10		2				REV. PER CLIENT/PROOF/FL/END COMMENTS	MAR. 31/21	ON					
9		1				PRELIMINARY ISSUED FOR CLIENT REVIEW	MAR. 12/21	ON					
8		0				description	date	by	description	date	by		

All drawing specifications, related documents and design are the copyright property of W3 DESIGN. Reproduction of this property in whole or in part is strictly prohibited without W3 DESIGN's written permission.

GRAB BAR NOTE:
STUD WALL REINFORCEMENT FOR FUTURE GRAB BARS IN MAIN BATHROOM.
REINFORCEMENT OF STUD WALLS SHALL BE INSTALLED ADJACENT TO WATER CLOSETS AND SHOWER OR BATHUB IN MAIN BATHROOM PER OBC, DIV. 8-8.5.2.1. REFER TO FOLLOWING SECTIONS FOR THE FIXTURES LISTED: WATER CLOSET: 3.8.3.8(3)(c) & 3.8.3.8(3)(c); SHOWER: 3.8.3.13(2)(c); BATHUB: 3.8.3.13(4)(c). FREE STANDING BATHUB EXCLUDED. SEE DETAILS PROVIDED. (201-NOTE-2022-04)

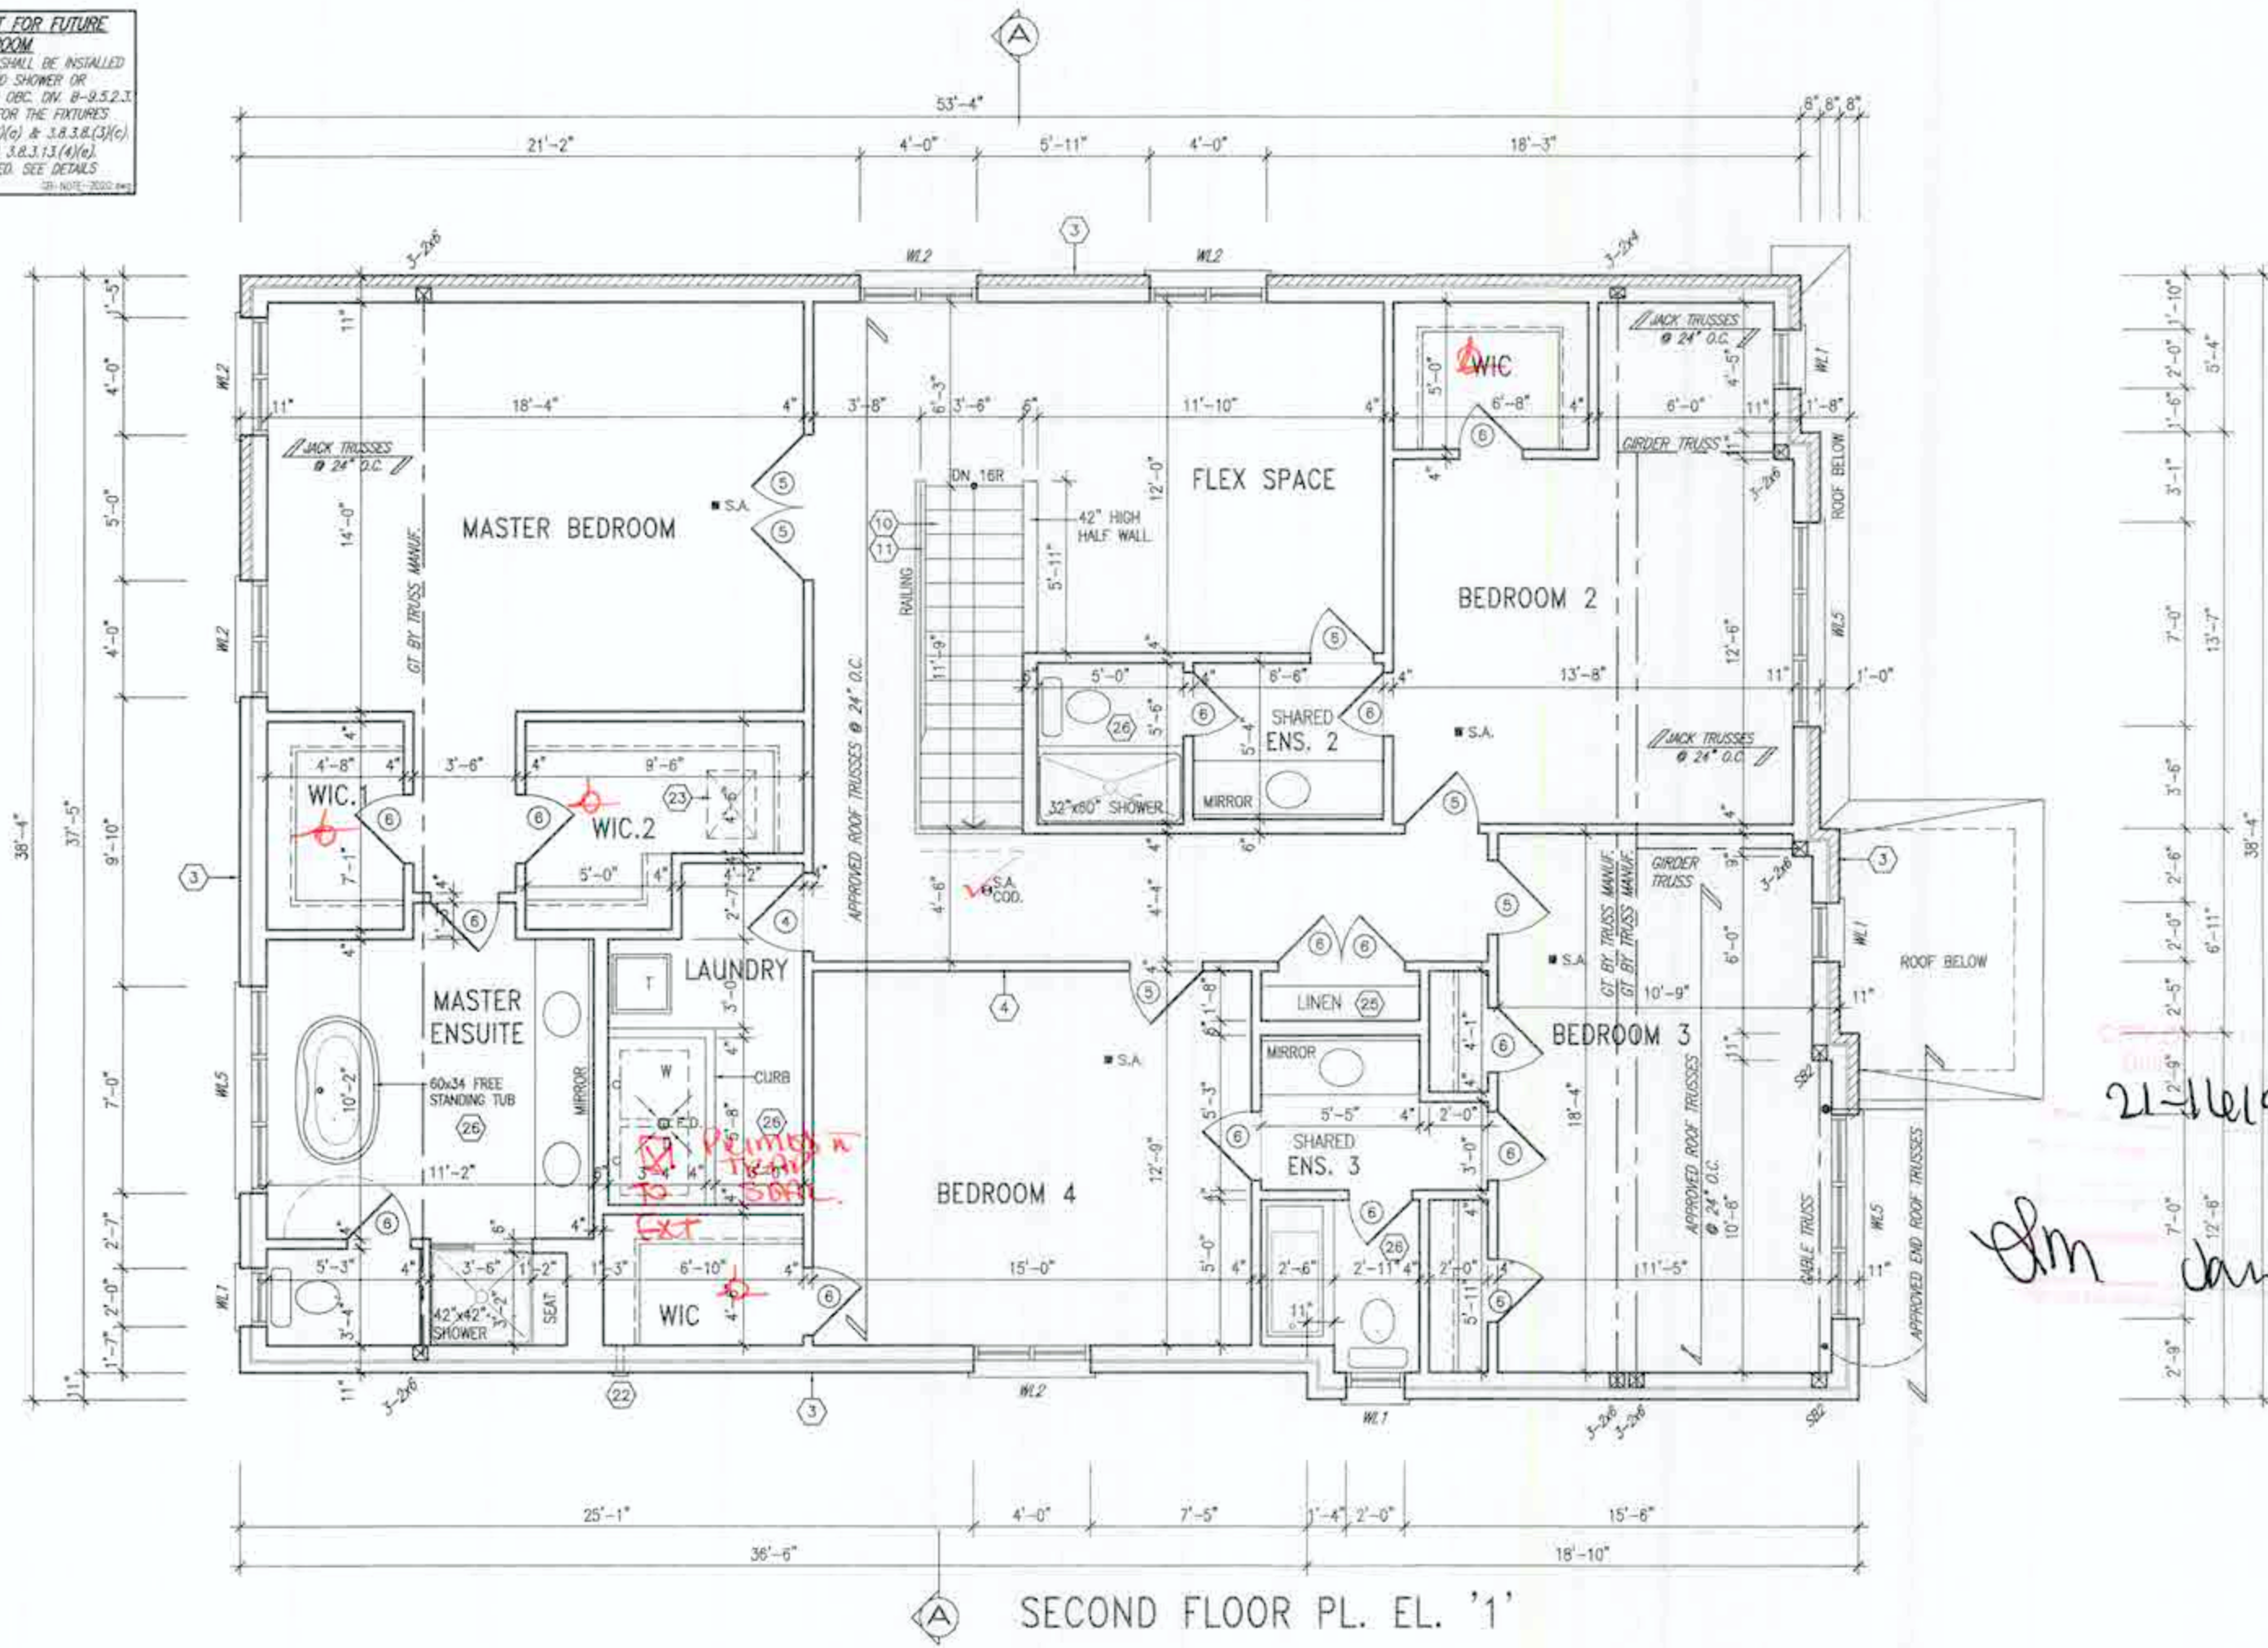

21-16/196
dm Jan 4/22

SECOND FLOOR PL. EL. '1'

It is the builder's complete responsibility to ensure that all plans submitted for approval fully comply with the Architectural Guidelines and all applicable regulations and requirements including zoning provisions and any provisions in the subdivision agreement. The Control Architect is not responsible in any way for examining or approving any (drawing) plans or working drawings with respect to any zoning or building code or permit matter or that any house can be properly built or located on its lot.

This is to certify that these plans comply with the applicable Architectural Design Guidelines approved by the City of Hamilton.

JOHN T. WILLIAMS LTD., ARCHITECT
ARCHITECTURAL CONTROL REVIEW
AND APPROVAL
DATE: AUG 17, 2021



STRUDET INC.
FOR STRUCTURE ONLY

18	ISSUED FOR PERMIT	MAY 21/21	OW
17	REV. PER CLIENT/ROOF/PL/ENG. COMMENTS	MAY 31/21	OW
16	PRELIMINARY ISSUED FOR CLIENT REVIEW	MAY 12/21	OW
15			
14			
The undersigned has reviewed and taken responsibility for this design and has the qualifications and meets the requirements set out in the Ontario Building Code to be a Designer.


signature: Richard Vink
name: Richard Vink
number: 24482
company: VAS Design Inc.
address: 24858



Greenpark. **SPRINGFIELD 3S**
COMPLIANCE PACKAGE 'A1'

project name: RUSSELL GARDENS PH.4
location: HAMILTON, ON
drawing no: 20027
date: JANUARY, 2021
sheet: 3/18" = 1'-0"
drawing title: SECOND FLOOR PLAN - ELEV. 1
drawing no: A3

GRAB BAR NOTE:
STUD WALL REINFORCEMENT FOR FUTURE GRAB BARS IN MAIN BATHROOM
 REINFORCEMENT OF STUD WALLS SHALL BE INSTALLED ADJACENT TO WATER CLOSET AND SHOWER OF BATHROOM IN MAIN BATHROOM PER O.C. DIV. B-9.5.2.3 REFER TO FOLLOWING SECTIONS FOR THE FIXTURES LISTED: WATER CLOSET: 3.8.3.8(3)(g) & 3.8.3.8(3)(c); SHOWER: 3.8.3.12(2)(g); BATHROOM: 3.8.3.13(4)(g). FREE STANDING BATHUB EXCLUDED. SEE DETAILS PROVIDED.
 20-10/2020-10/2020

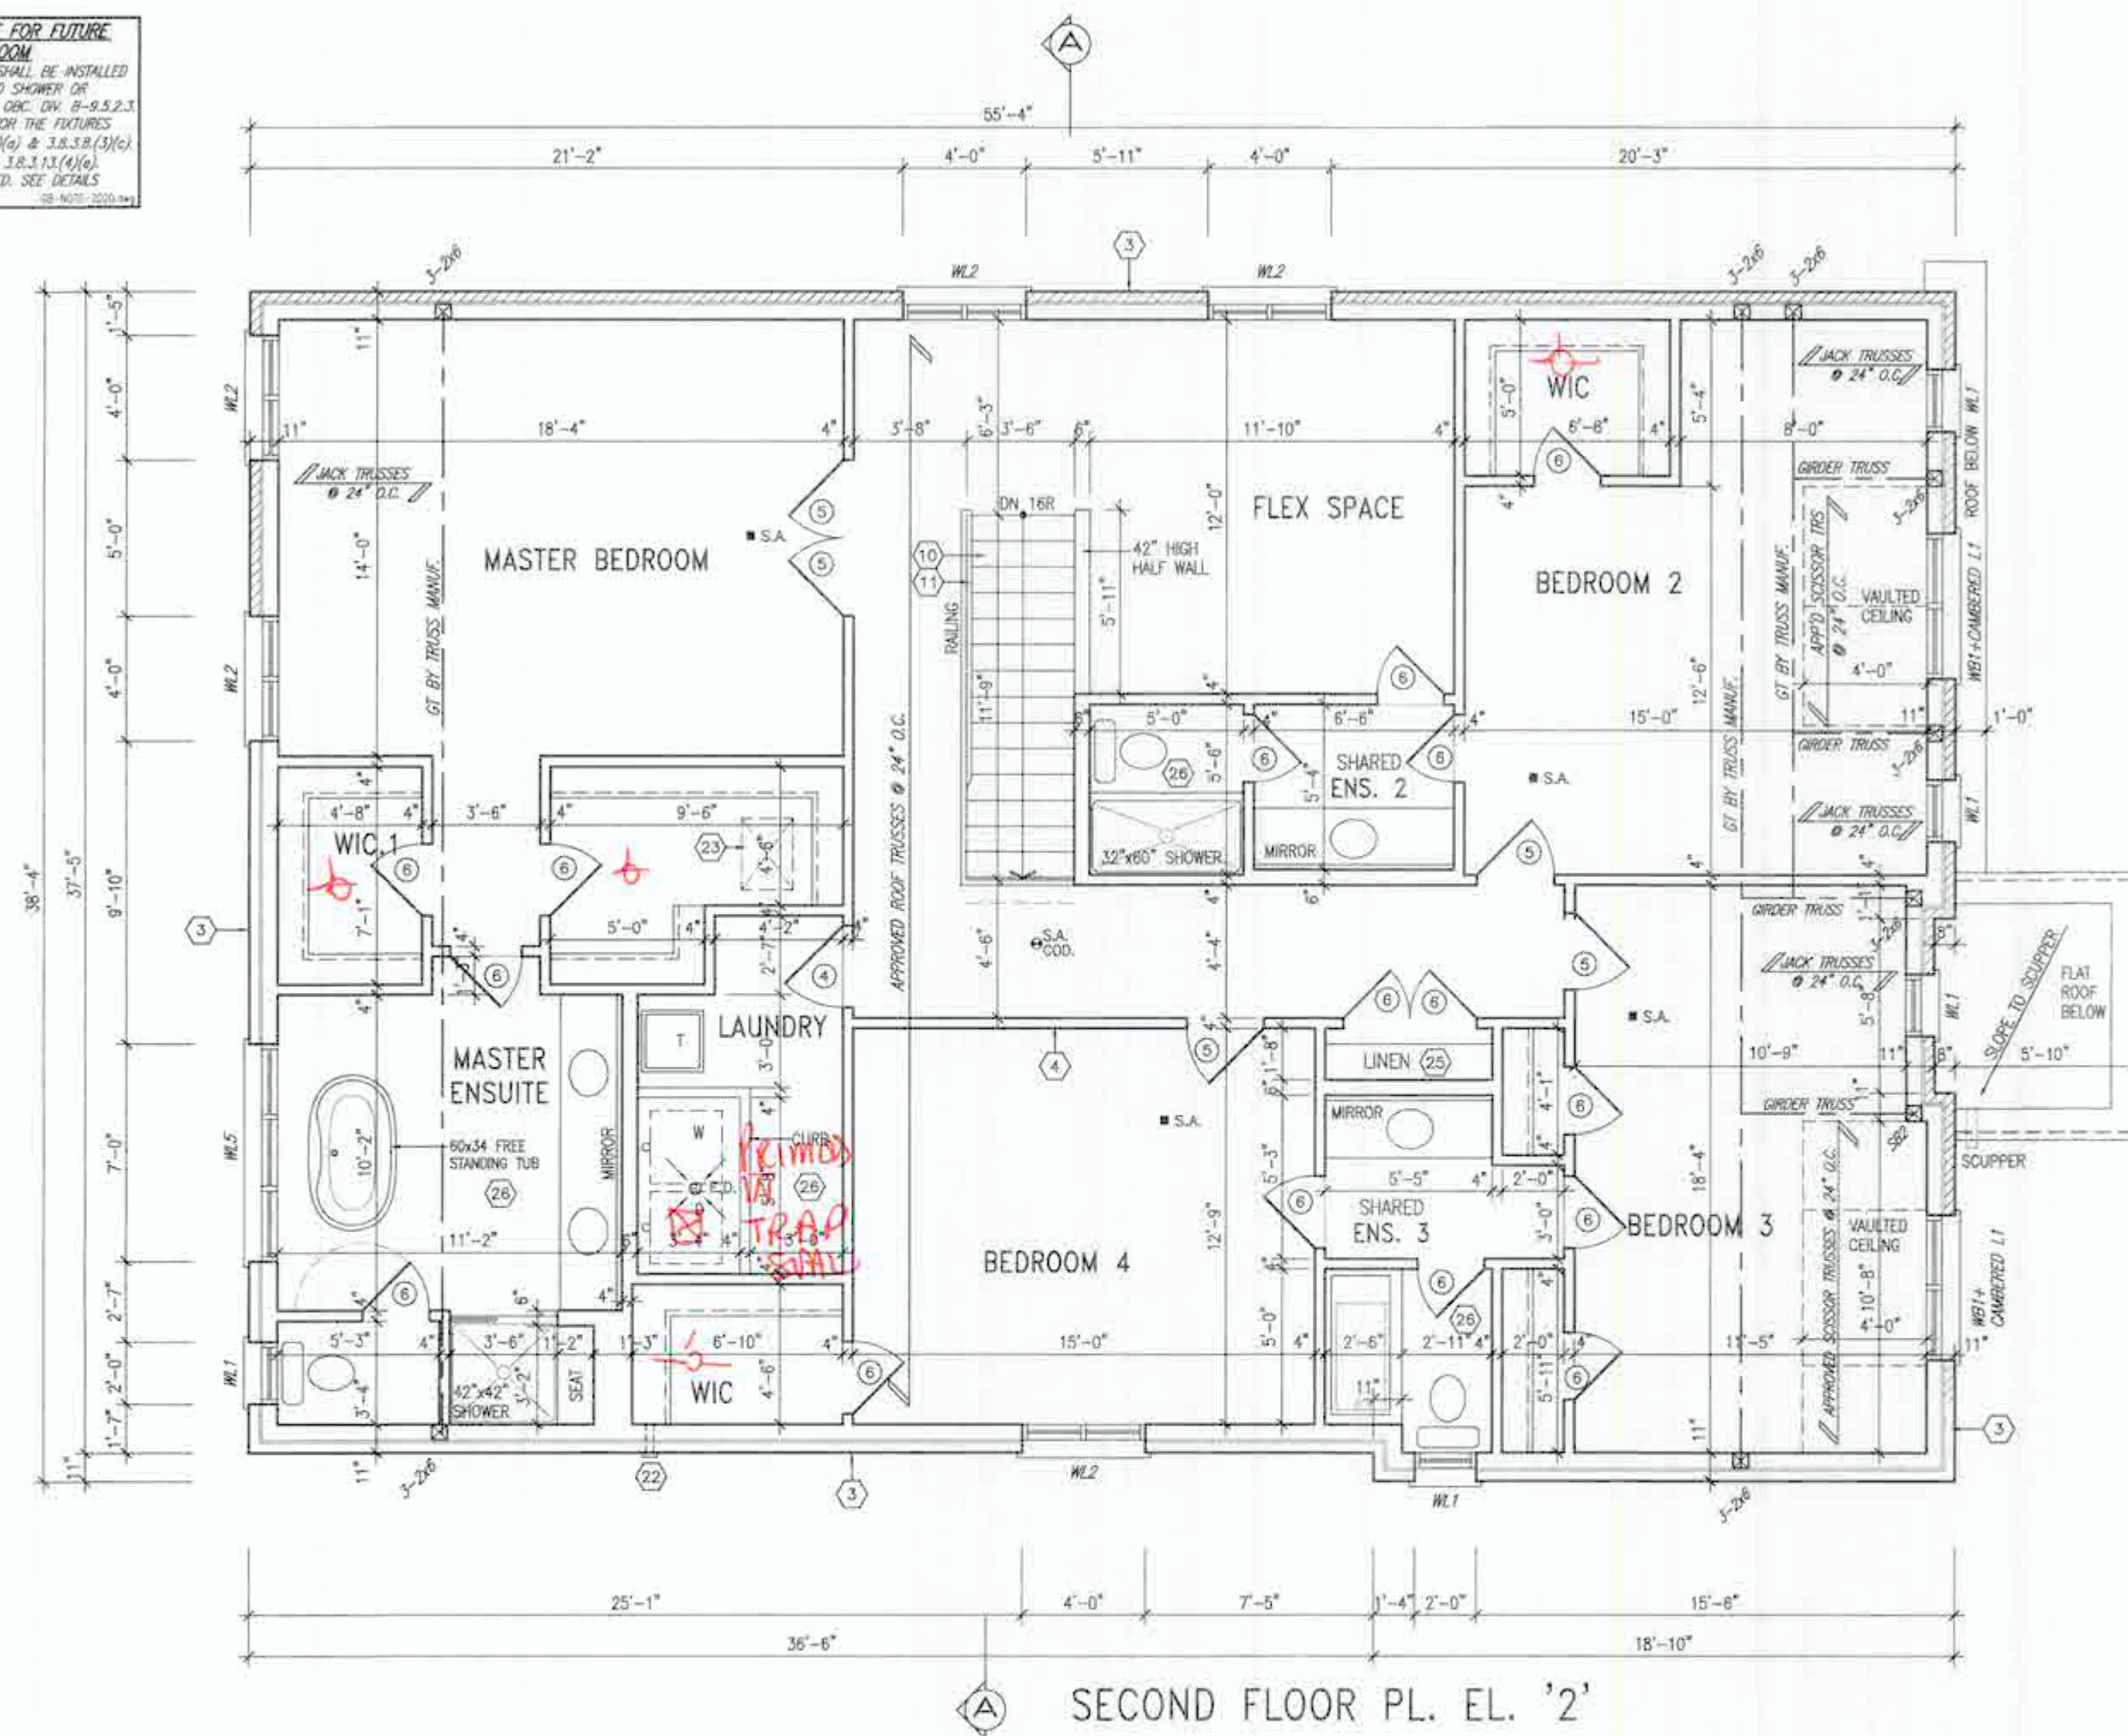

21-16/1951
 dm Jan 4/22

It is the builder's complete responsibility to ensure that all plans submitted for approval fully comply with the Architectural Guidelines and all applicable regulations and requirements including zoning provisions and any provisions in the subdivision agreement. The Control Architect is not responsible in any way for examining or approving site (posting) plans or working drawings with respect to any zoning or building code or permit matter or that any house can be properly built or located on its lot.

JOHN C. WILLIAMS LTD. ARCHITECT
 ARCHITECTURAL CONTROL SYSTEM
 1000 KENNEDY RD.
 UNIT 100
 SCARBOROUGH, ONTARIO M1T 3B4
 TEL: (416) 291-1884
 FAX: (416) 291-1885
 www.jcw.ca



STRUDET INC.
 FOR STRUCTURE ONLY

no.	description	date	by	no.	description	date	by
1	ISSUED FOR PERMIT	MAY 21/21	GW	1	ISSUED FOR PERMIT	MAY 21/21	GW
2	REV. PER CLIENT/ROOF/FL/ENG. COMMENTS	MAR. 31/21	GW	2	REV. PER CLIENT/ROOF/FL/ENG. COMMENTS	MAR. 31/21	GW
3	PRELIMINARY, ISSUED FOR CLIENT REVIEW	MAR. 12/21	GW	3	PRELIMINARY, ISSUED FOR CLIENT REVIEW	MAR. 12/21	GW


The undersigned has reviewed and takes responsibility for this design and has the qualifications and meets the requirements set out in the Ontario Building Code to be a Designer.
 verification information
 Richard Vink 24488
 VAS Design Inc. 42658

VA3 DESIGN
 255 Commercial Rd Suite 120
 Toronto, ON M2J 1R4
 T 416.630.2255 F 416.630.4782
 va3design.com

Greenpark.
 project name: RUSSELL GARDENS PH.4
 location: HAMILTON, ON
 date: JANUARY, 2021
 scale: 3/16" = 1'-0"

SPRINGFIELD 3S
 COMPLIANCE PACKAGE 'A1'
 14.30m
 project no. 20027
 drawing no. A3a

GRAB BAR NOTE:
STUD WALL REINFORCEMENT FOR FUTURE GRAB BARS IN MAIN BATHROOM
REINFORCEMENT OF STUD WALLS SHALL BE INSTALLED ADJACENT TO WATER CLOSETS AND SHOWER OR BATHTUB IN MAIN BATHROOM PER CBC, DIV. 9-5.5.2.3 REFER TO FOLLOWING SECTIONS FOR THE FUTURES LISTED: WATER CLOSET: 3.8.3.8(1)(g) & 3.8.5.8(1)(c); SHOWER: 3.8.3.13(2)(g); BATHTUB: 3.8.3.13(4)(g). FREE STANDING BATHTUB EXCLUDED. SEE DETAILS PROVIDED.
20-1601-1-2020-140

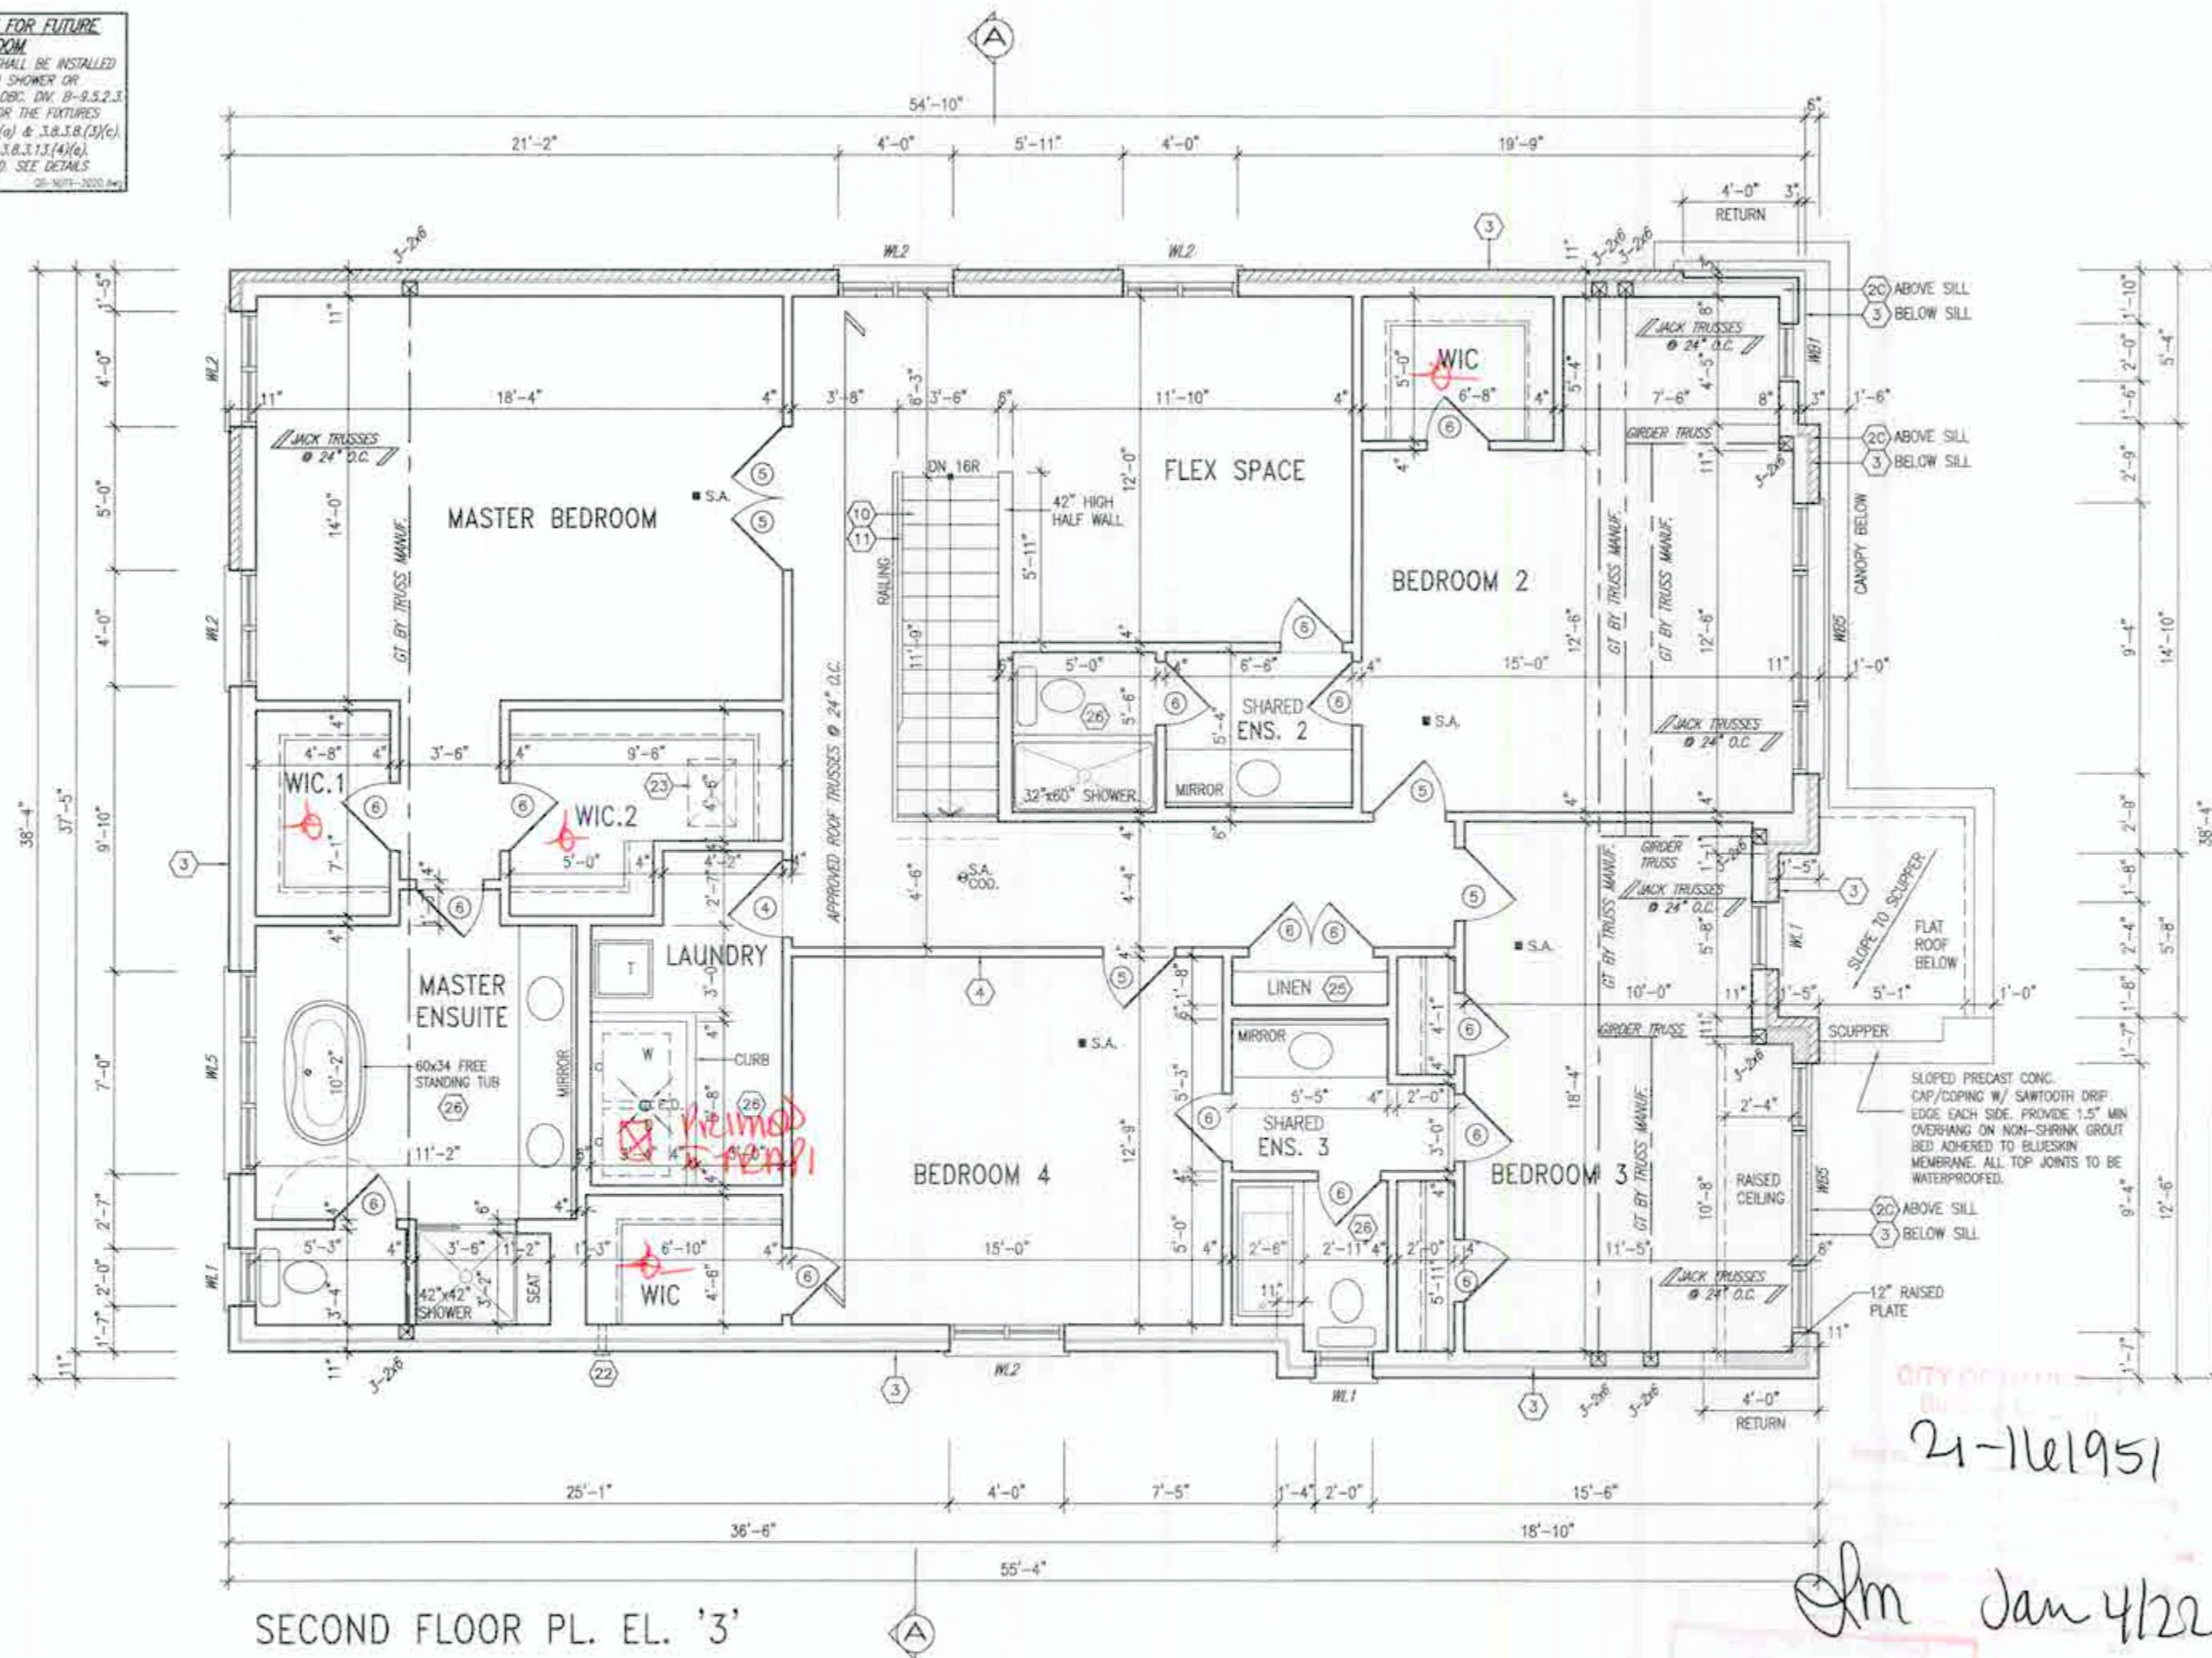

SECOND FLOOR PL. EL. '3'

2-1161951

Jan 4/22

It is the builder's complete responsibility to ensure that all plans submitted for approval fully comply with the Architectural Guidelines and all applicable regulations and requirements including zoning provisions and any provisions in the subdivision agreement. The Council Architect is not responsible in any way for examining or approving the (posting) plans or working drawings with respect to any zoning or building code or permit matter or that any house can be properly built or located on its lot.

This is to certify that these plans comply with the applicable Architectural Design Guidelines approved by the City of Hamilton.

JOHN G. WILLIAMS LTD., ARCHITECT
ARCHITECTURAL CONSULTANTS
AND APPROVAL

APPROVED BY: [Signature]
DATE: [Date]

FOR THE CITY OF HAMILTON



STRUDET INC.
FOR STRUCTURE ONLY

no.	description	date	by	no.	description	date	by
18				9			
17				8			
16				7			
15				6			
14				5			
13				4			
12				3	ISSUED FOR PERMIT	MAY 21/21	OW
11				2	REV. PER CLIENT/ROOF/FL/ENG. COMMENTS	MAR. 31/21	OW
10				1	PRELIMINARY ISSUED FOR CLIENT REVIEW	MAR. 12/21	OW

The undersigned has reviewed and takes responsibility for this design and has the qualifications and credentials to do so. The undersigned is a member of the Ontario Association of Architects (OAA) and is registered with the Ontario College of Architects (OCA).

Richard Yink
24488
OAC
signature

VA3 Design Inc.
42658

255 Consumers Rd Suite 120
Toronto, ON M2J 1R4
416.630.2255 / 416.630.4782
va3design.com



Greenpark. **SPRINGFIELD 3S**
COMPLIANCE PACKAGE 'A1'

project name: RUSSELL GARDENS PH.4
location: HAMILTON, ON
project no: 20027


date: JANUARY, 2021
drawn by: [Name]
checked by: [Name]
scale: 3/16" = 1'-0"

SECOND FLOOR PLAN - ELEV. 3
20027-SPRINGFIELD-3S
A3b



21-1161957

Jan 4/22

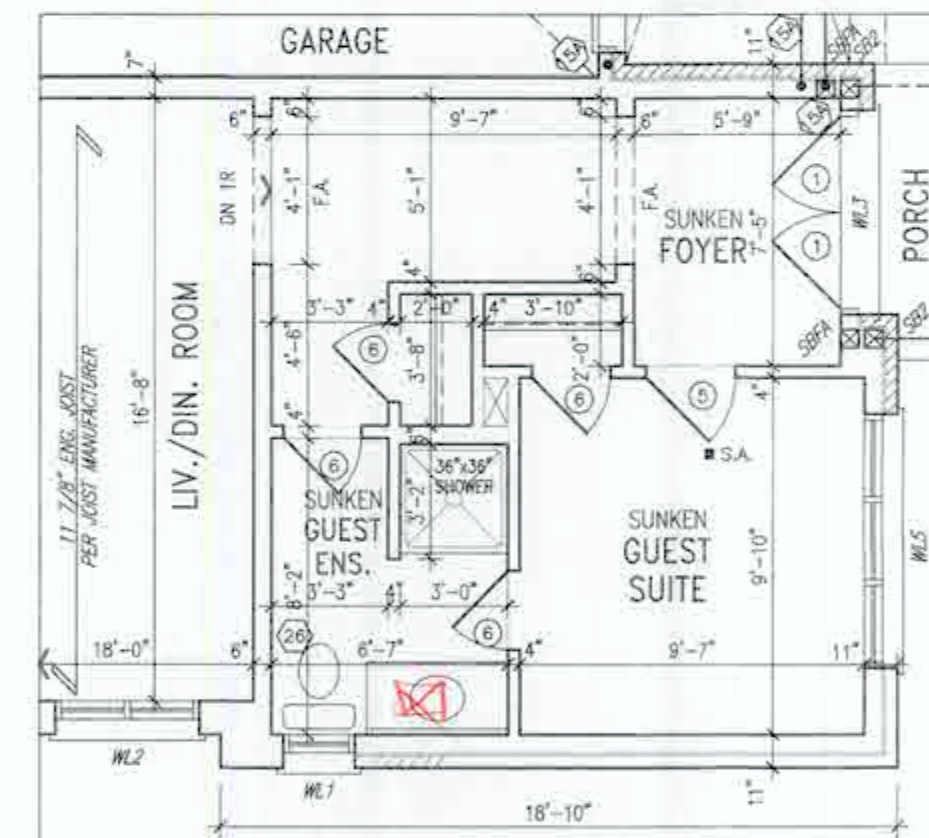

PART. GROUND FLOOR PLAN -ELEV. 1
W/ OPT. GUEST SUITE

SPRINGFIELD 3S
COMPLIANCE PACKAGE 'A1'

Greenpark. SPRINGFIELD 3S
14.30m

project name	municipality	project no.
RUSSELL GARDENS PH.4	HAMILTON, ON	20027

January, 2021 PART. PLANS - ELEV. 1 drawing on

20027-SPRINGFIELD-35 A4

Copyright © 2004 by V&I DESIGN. Reproduction of this property in whole or in part is strictly prohibited without V&I DESIGN's written permission.

17	18	19	1000
					The undersigned has reviewed and taken responsibility for this design and has the qualifications and meets the requirements set out in the Ontario Building Code to be a Designer.					24498					24658					250					250					
All drawings, specifications, related documents and design are the copyright property of V&A DESIGN. Reproduction of this property in whole or in part is strictly prohibited without V&A DESIGN's written permission.

[illegible]

21-161957

Jim Jan 4/22


SPRINGFIELD 3S
COMPLIANCE PACKAGE 'A1'

 Greenpark.		SPRINGFIELD 3S 14.30m	
project name MUSSELL GARDENS PH.4	city/province HAMILTON, ON	project no. 20027	
date JANUARY, 2021	PART, PLANS - ELEV. 2		drawing no. A4a
scale as shown	3/16" = 1'-0"	20027-SPRINGFIELD-3S	

[illegible]

All drawings, specifications, related documents and design are the copyright property of V&J DESIGN. Reproduction of this property in whole or in part is strictly prohibited without V&J DESIGN's written permission.


STRUDET INC.
FOR STRUCTURE ONLY

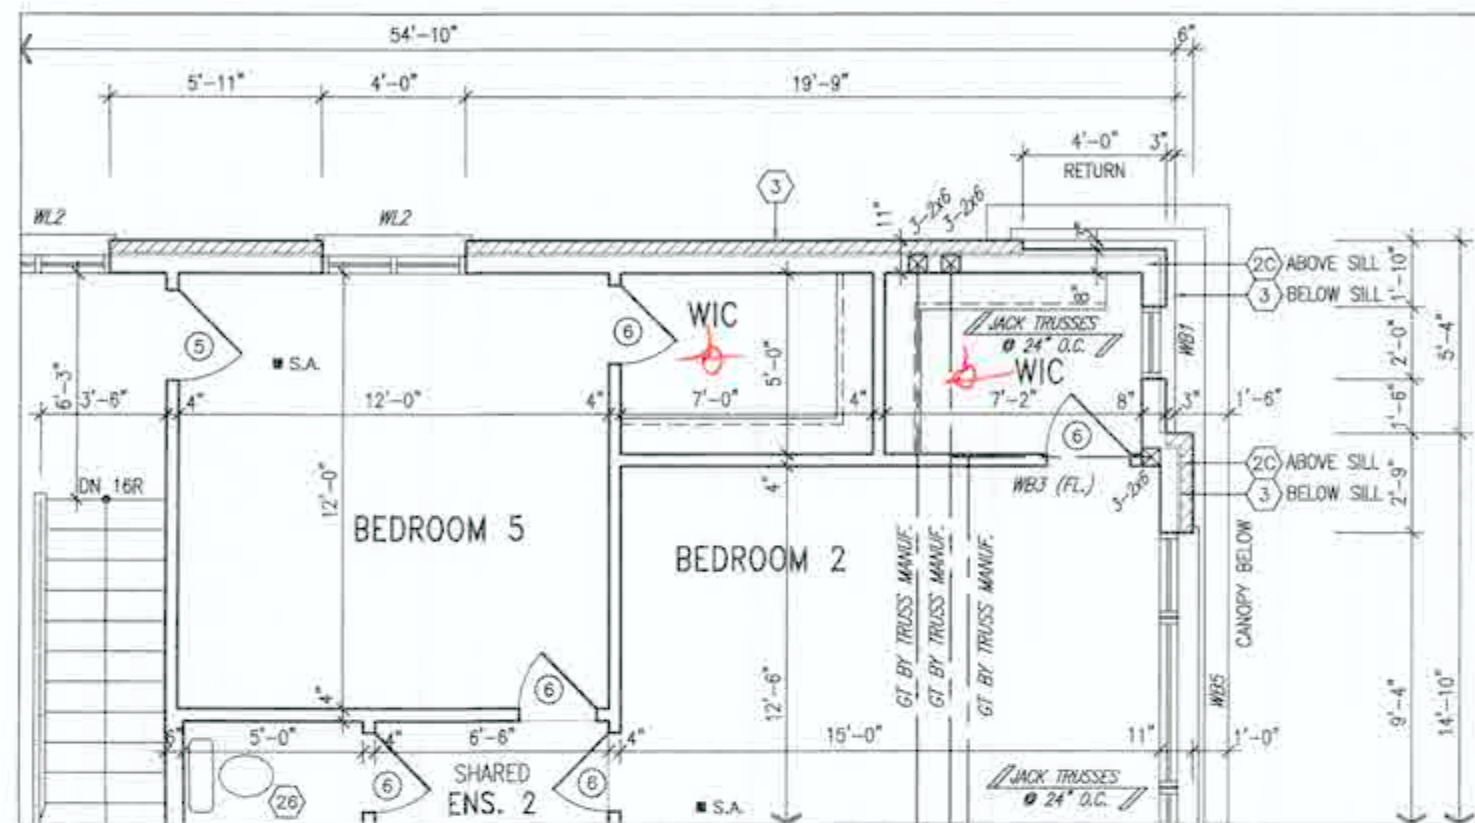

PART. SECOND FLOOR PLAN- ELEV. 3
W/ OPT. BEDROOM 5

2-16195

Im Jan 4/22

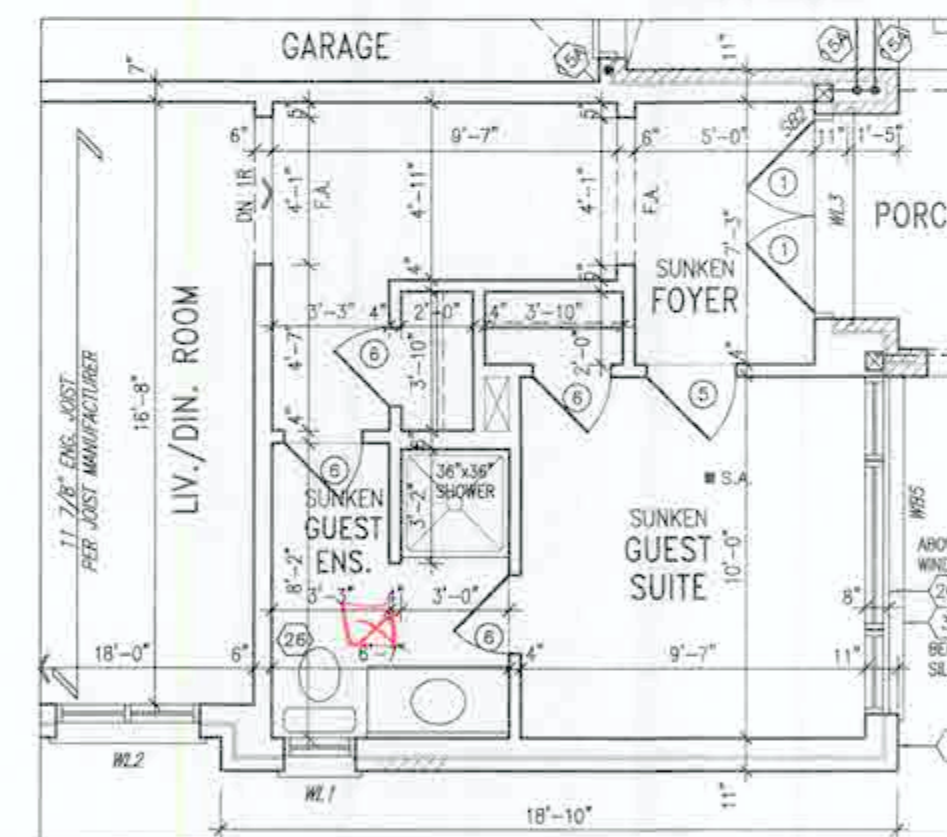

PART. GROUND FLOOR PLAN -ELEV. 3
W/ OPT. GUEST SUITE

SPRINGFIELD 3S
COMPLIANCE PACKAGE 'A1'

Greenpark. SPRINGFIELD 3S
14.30m

VA3
DESIGN

project name	municipality	project no.
RUSSELL GARDENS PH.4	HAMILTON, ON	20027

DATE: JANUARY 2021 PART. PLANS — ELEV. 3 DRAWING NO.

drawn by _____ stained by _____ scale _____ the name _____
 do _____ $2.16 \times 10^{-1} \text{ m}^2$ SAAT ROOMINGTON 26

[illegible]

© 2003 Intel Corporation. Intel, the Intel logo, and Itanium are trademarks or registered trademarks of Intel Corporation or its subsidiaries in the United States and other countries. All other trademarks are the property of their respective owners. Reproduction of this document in whole or in part is strictly prohibited without Intel Corporation's written permission.

						The undersigned has reviewed and takes responsibility for this design and has the qualifications and meets the requirements set out in the Ontario Building Code to be a Designer.						SPRINGFIELD 3S	
												14.30m	
						Richard Vink		24488		municipality		project no.	
						signature		RCM		HAMILTON, ON		20027	
						Registration Information:		42656					
						ISSUED FOR PERMIT.		MAY 21/21				PART. PLANS - ELEV. 3	
						REV. PER CLIENT/PROF./PL. ENG. COMMENTS		MAR. 31/21				drawing no.	
						PRELIMINARY ISSUED FOR CLIENT REVIEW.		MAR. 12/21				20027 - SPRINGFIELD-3S	
no.		description		date		by						A4b	
no.		description		date		by							

All drawings, specifications, related documents and design are the copyright property of V&T DESIGN. Reproduction of this property in whole or in part is strictly prohibited without V&T DESIGN's written permission.

[illegible]

PORCH STEPS (TYP.)
PRECAST CONCRETE STEPS
w/ MASONRY INSERTS WHERE
GRADE REQUIRES.

CITY OF HAMILTON
21-161951

Sm Jan 4/22

It is the builder's complete responsibility to ensure that all plans submitted for approval fully comply with the Architectural Guidelines and all applicable regulations and requirements including zoning provisions and any provisions in the subdivision agreement. The Control Architect is not responsible in any way for examining or approving site (lotting) plans or working drawings with respect to any zoning or building code or permit matter or that any house can be properly built or located on its lot.

This is to certify that these plans comply with the applicable Architectural Design Guidelines approved by the City of HAMILTON.

JOHN F. WILLIAMS LTD., ARCHITECT
ARCHITECTURAL CONTROL, DESIGN
AND CONSTRUCTION

DATE: Aug 22, 1977

THIS DRAWING represents a preliminary sketch and is not to be used for construction without the approval of the architect. It is the responsibility of the architect to ensure that the drawing is used for its intended purpose.

SPRINGFIELD 3S
COMPLIANCE PACKAGE 'A1'

[illegible]

All drawings, specifications, related documents and designs are the copyright property of VAI DESIGN. Reproduction of this property in whole or in part is strictly prohibited without VAI DESIGN's written permission.



LEFT SIDE ELEVATION - ELEV. '1'

ALLOWABLE GLAZED OPENINGS
 WALL AREA = 1171.22 SQ. FT.
 LIMITING DISTANCE 1.2 M (7'6")
 GLAZING ALLOWED = 81.99 SQ. FT.
 GLAZING PROVIDED = 62.20 SQ. FT.

WITH OPTIONAL 30"x24" BASEMENT WINDOWS
 GLAZING PROVIDED W/ OPT. 30"x24" BASEMENT WINDOWS = 65.20 SQ. FT.

It is the builder's complete responsibility to ensure that all plans submitted for approval fully comply with the Architectural Guidelines and all applicable regulations and requirements including zoning provisions and any provisions in the subdivision agreement. The Control Architect is not responsible in any way for examining or approving any (setting) plans or working drawings with respect to any zoning or building code or permit matter or that any house can be properly built or located on the lot.

This is to certify that these plans comply with the applicable Architectural Design Guidelines approved by the City of Hamilton.

JOHN G. WILLIAMS LTD., ARCHITECT
 ARCHITECTURAL CONTROL REVIEW
 AND APPROVAL
 Date: 11-01-2021
 This stamp certifies compliance with the regulations. Should a discrepancy arise, please refer to the relevant regulations.

18 17 16 15 14 13 12 11 10 9 8 7 6 5 4 3 2 1 0 no. description date by no. description date by				The undersigned has reviewed and taken responsibility for this design and has the qualifications and meets the requirements set out in the Ontario Building Code to be a Designer. signature: Richard Vink 24488 name registration information: VAS Design Inc. 42658 VAS Design Inc. 42658				VA3 DESIGN 255 Consumers Rd. Suite 120 Toronto, ON M2J 1R4 T 416.630.2255 F 416.630.4782 va3design.com				Greenpark. project name: RUSSELL GARDENS PH.4 location: HAMILTON, ON project no.: 20027 date: JANUARY, 2021 drawn by: [signature] checked by: [signature] scale: 3/16" = 1'-0" sheet: 20027-SPRINGFIELD-3S title: LEFT SIDE ELEVATION - ELEV. 1 drawing no.: A6			
---	--	--	--	--	--	--	--	---	--	--	--	---	--	--	--

SPRINGFIELD 3S
 COMPLIANCE PACKAGE 'A1'

SPRINGFIELD 3S
 14.30m

project no.
20027

drawing no.
A6

[illegible]

<u>ALLOWABLE GLAZED OPENINGS</u>	
WALL AREA	=1059.62 SQ. FT.
LIMITING DISTANCE	1.2 M (7%)
GLAZING ALLOWED	=74.17 SQ. FT.
GLAZING PROVIDED	=37.33 SQ. FT.
<u>WITH OPTIONAL 30"x24" BASEMENT WINDOWS</u>	
GLAZING PROVIDED W/ OPT.	
30"x24" BASEMENT WINDOWS	=38.83 SQ. FT.

It is the planner's complete responsibility to ensure that all plans submitted for approval fully comply with the Architectural Guidelines and all applicable regulations and requirements including zoning provisions and any provisions in the subdivision agreement. The Control Authority is not responsible in any way for examining or approving site/planning plans or working drawings with respect to any zoning or building codes or permit, master or final map issue can be properly built or located on the lot.


This is to certify that these plans comply with the applicable Architectural Design Guidelines approved by the City of HAMILTON.

JOSEPH C. WILLIAMS, FID., ARCHT. &
ARCHT. SERVICES, INC. (SEAL)

DATE: 08/15/2011

By signing, certifies compliance with the regulations.

16	17	18	1000
ISSUED FOR PERMIT			MAY 21/21			ON	CONTRACTOR MUST VERIFY ALL DIMENSIONS ON THE JOB AND REPORT ANY DISCREPANCIES TO THE DESIGNER BEFORE PROCEEDING WITH ANY WORK. ALL DRAWINGS AND SPECIFICATIONS ARE INSTRUMENTS OF SERVICE AND THE PROPERTY OF THE DESIGNER WHICH MUST BE RETURNED AT THE COMPLETION OF THE WORK. THEREAFTER THEY ARE TO BE DESTROYED.			255 Consumers Rd. Suite 120 Toronto, ON M2H 1L4 1 416 632 2252 / 1 416 632 4782 v3design.com			project name RUSSELL GARDENS PH.4			municipality HAMILTON, ON			project no. 20027			drawing no. A7																																																																																																																																																																																																																																																																																																																																																																																																																																																																																																																																																																																																																																																																																																																																																																																																																																																																																																																																																																																																		
REV. PER CLIENT/PROOF/FLG. COMMENTS			MAR. 31/21			ON							date JANUARY, 2021			RIGHT SIDE ELEVATION - ELEV. 1																																																																																																																																																																																																																																																																																																																																																																																																																																																																																																																																																																																																																																																																																																																																																																																																																																																																																																																																																																																																								
PRELIMINARY ISSUED FOR CLIENT REVIEW			MAR. 12/21			ON							checked by 3/16" = 1'-0"			20027-SPRINGFIELD-3S																																																																																																																																																																																																																																																																																																																																																																																																																																																																																																																																																																																																																																																																																																																																																																																																																																																																																																																																																																																																								
no. description			date			by	no. description			date			by																																																																																																																																																																																																																																																																																																																																																																																																																																																																																																																																																																																																																																																																																																																																																																																																																																																																																																																																																																																																											

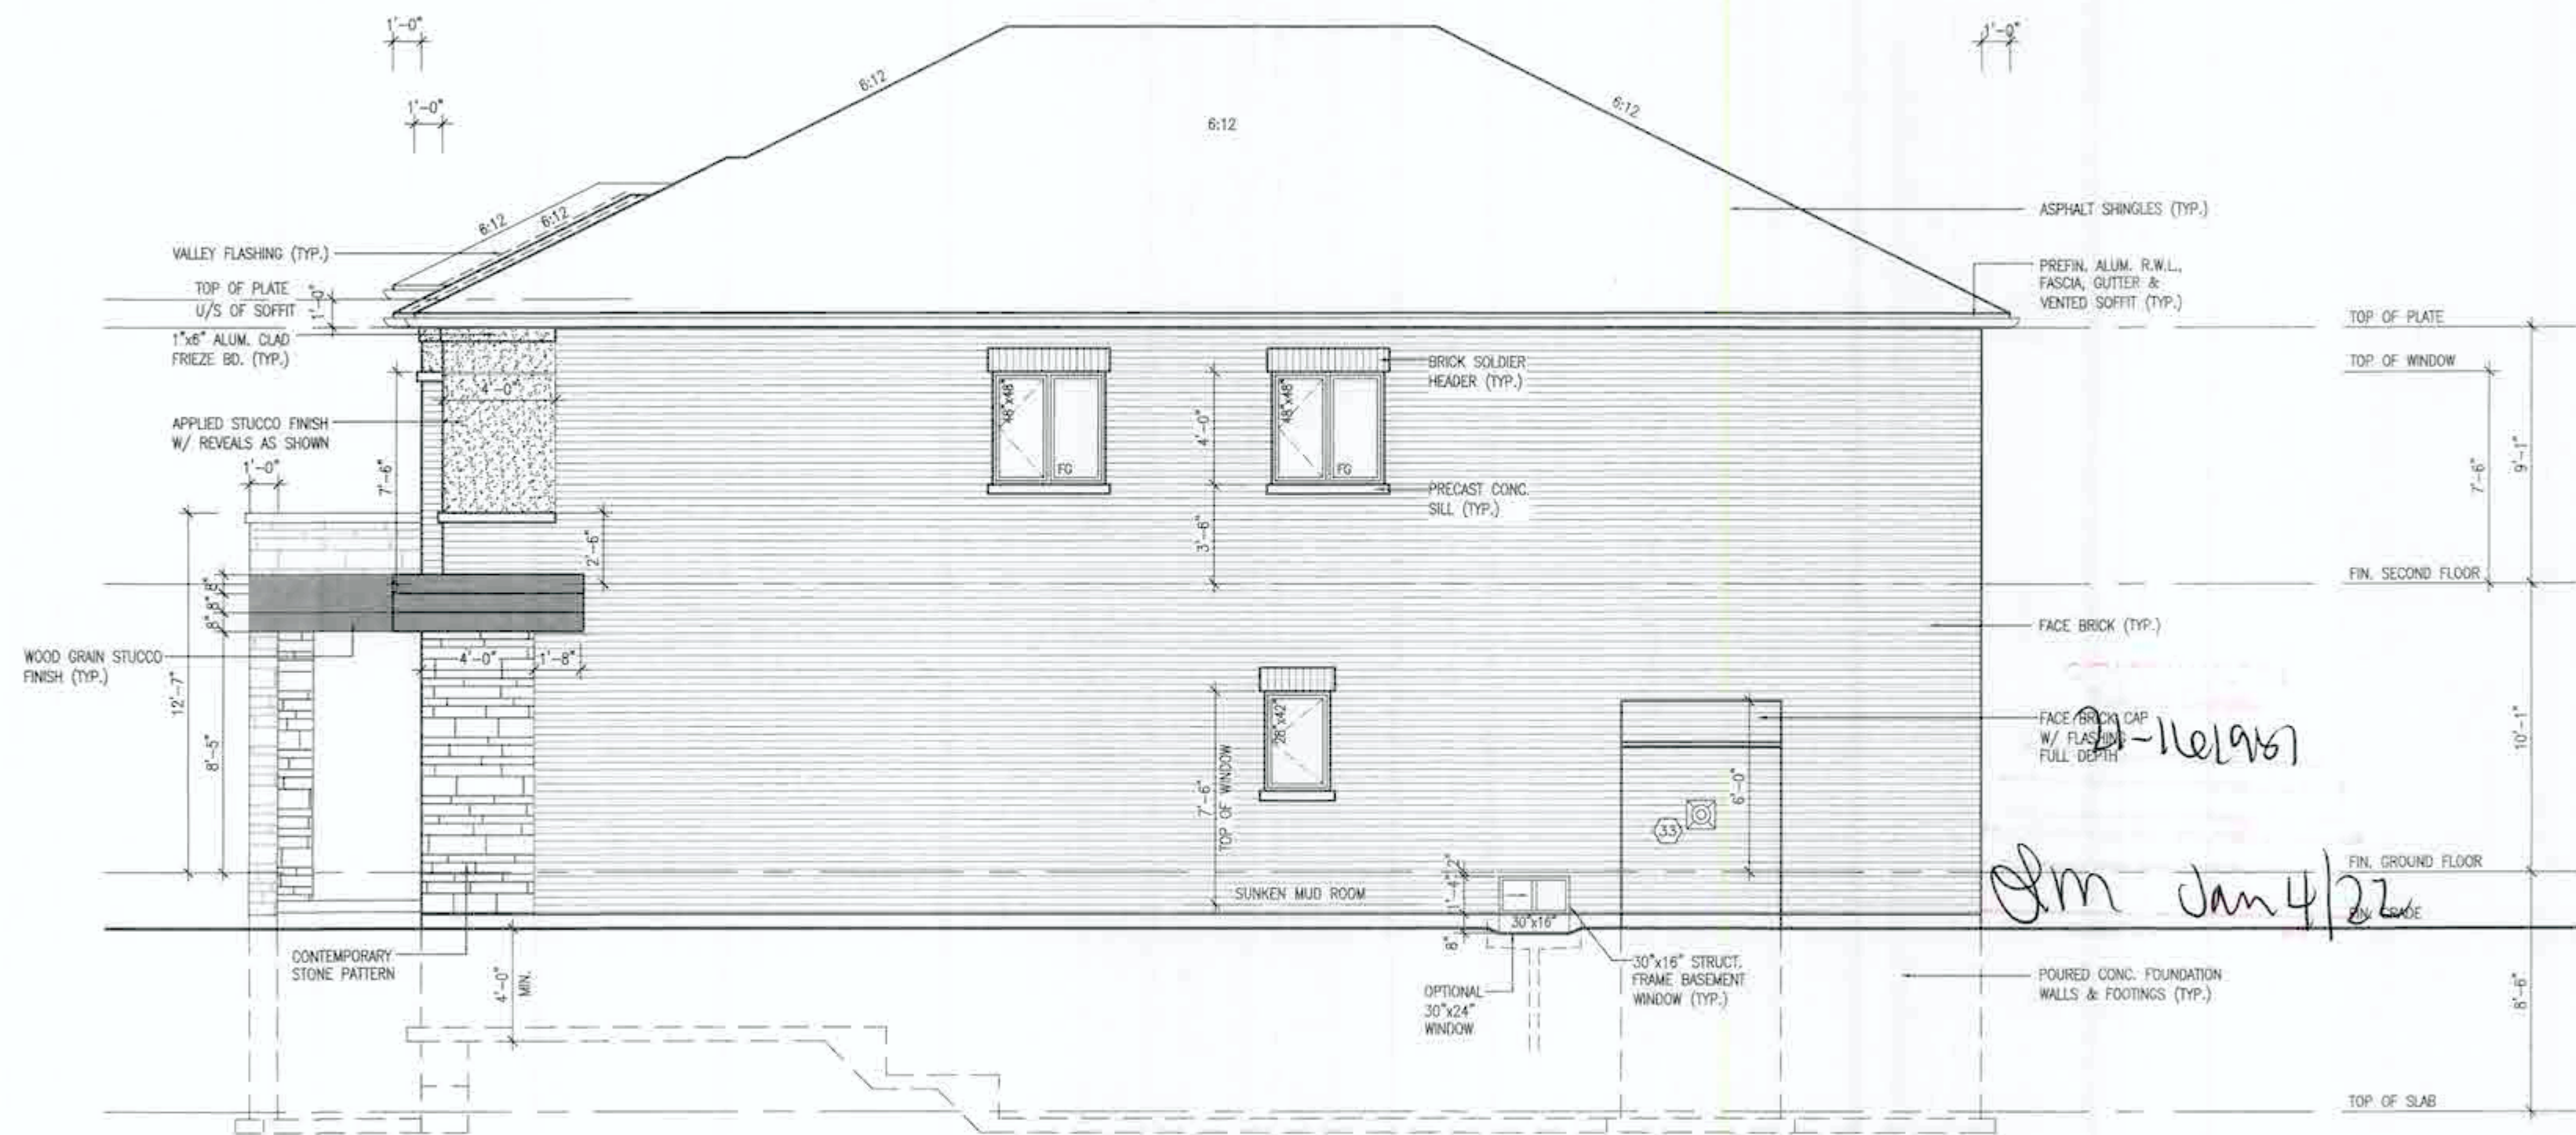

RIGHT SIDE ELEVATION - ELEV. '3'

ALLOWABLE GLAZED OPENINGS
 WALL AREA = 1074.74 SQ. FT.
 LIMITING DISTANCE 1.2 M (7%)
 GLAZING ALLOWED = 75.23 SQ. FT.
 GLAZING PROVIDED = 37.33 SQ. FT.
 WITH OPTIONAL 30"x24" BASEMENT WINDOWS
 GLAZING PROVIDED W/ OPT. 30"x24" BASEMENT WINDOWS = 38.83 SQ. FT.

It is the builder's complete responsibility to ensure that all plans submitted for approval fully comply with the Architectural Guidelines and all applicable regulations and requirements including zoning provisions and any provisions in the subdivision agreement. The Control Architect is not responsible in any way for examining or approving site (lotting) plans or working drawings with respect to any zoning or building code or permit matter or that any tower can be properly built or located on its lot.

This is to certify that these plans comply with the applicable Architectural Design Guidelines approved by the City of HAMILTON.

JERRY G. WILLIAMS LTD., ARCHITECT
 ARCHITECTURAL DESIGN
 1000 KENNEDY RD. UNIT 100
 SCARBOROUGH, ONTARIO M1T 3B4
 TEL: (416) 291-1111
 FAX: (416) 291-1112
 DATE: AUG 17, 2021
 DRAWN BY: JG
 CHECKED BY: JG
 DESIGN: JG
 APPROVED BY: JG

VA3 DESIGN 255 Consumers Rd Suite 120 Toronto, ON M2J 1B4 T 416.630.2255 F 416.630.4782 va3design.com		Greenpark. 14.30m project no. 20027 drawing no. A7b	
project name: RUSSELL GARDENS PH.4 location: HAMILTON, ON date: JANUARY, 2021 drawn by: JG checked by: JG scale: 3/16" = 1'-0" title: RIGHT SIDE ELEVATION - ELEV. 3		project no. 20027 drawing no. A7b title: RIGHT SIDE ELEVATION - ELEV. 3	

3601 SF.



REAR ELEVATION - ELEV. '1'

It is the builder's complete responsibility to ensure that all plans submitted for approval fully comply with the Architectural Guidelines and all applicable regulations and requirements including zoning provisions and any provisions in the subdivision agreement. The Control Architect is not responsible in any way for examining or approving site (lotting) plans or working drawings with respect to any zoning or building code or permit matter or that any house can be properly built or located on its lot.

This is to certify that these plans comply with the applicable Architectural Design Guidelines approved by the City of HAMILTON

JAMES C. WILLIAMS LTD., ARCHITECT
 ARCHITECTURAL CONTROL ROOM
 500 ARDEN
 10/10/2001
 DATE: AUG 17, 2001
 The drawing is submitted in accordance with the conditions
 of the contract and is not to be used for any other
 purpose without the written consent of the architect.

18				9		
17				8		
16				7		
15				6		
14				5		
13				4		
12				3	ISSUED FOR PERMIT.	MAY 21/21
11				2	REV. PER CLIENT/ROOF/FL/ENG. COMMENTS	MAR 31/21
10				1	PRELIMINARY ISSUED FOR CLIENT REVIEW	MAR 12/21
no	description	date	by	no	description	date

The undersigned has reviewed and takes responsibility for this design and has the qualifications and meets the requirements set out in the Online Bidding Code to be a Designer:	
qualification information	
Richard Vink	244
name	
signature	
VAS Design Inc.	428
Contractor must verify all disbursements on the job cost report are emergency to the Designer before proceeding with the work. All disbursements and specifications are instruments of service and the property of the Designer which must be returned at the completion of the project. Disbursements are not to be copied.	

VA3
DESIGN
255 Consumers Rd. Suite 101
Toronto, ON M2J 1R9
T 416.630.2255 F 416.630.2256
va3design.com

 **Greenpark.**

Project name: **RUSSELL GARDENS PH.4** Municipality: **HAMILTON, ONTARIO**

Date: **JANUARY, 2021** Rear elevation: **REAR ELEVATION**

Checked by: **3/10" = 1'-0"**

SPRINGFIELD 3S 14.30m	
ATION - ELEV. 1 the name 20027-SPRINGFIELD-3S 20027-SPRINGFIELD-3S	project no. 20027 drawing no. A8

SPRINGFIELD 3S
COMPLIANCE PACKAGE 'A1'

All drawings, specifications, related documents and design are the copyright property of VAS DESIGN. Reproduction of this property in whole or in part is strictly prohibited without VAS DESIGN's written permission.


Architectural elevation drawing of a building facade. The drawing includes the following elements and dimensions:

- Roof:** Gabled roof with a pitch of 6:12. Eave overhang is 1'-0".
- Exterior Wall:**
 - Top section: 4'-0" high, containing four windows (two 48" x 60", two 24" x 42").
 - Middle section: 3'-5" high, containing a large window (96" x 60") and a central door (6'-0" x 8'-0").
 - Bottom section: 2'-8" high, containing a small window (48" x 60").
- Roofing Details:** ASPHALT SHINGLES (TYP.), VALLEY FLASHING (TYP.), PREFIN. ALUM. R.W.L., FASCIA, GUTTER & VENTED SOFFIT (TYP.).
- Window/Door Details:** BRICK SOLDIER COURSE HEADER (TYP.), PRECAST CONC. SILL (TYP.), FACE BRICK (TYP.), 6'-0" SLIDING DOOR, 12" HIGH TRANSOM.
- Foundation:** PRECAST CONC. STEP (TYP.), POURED CONC. FOUNDATION WALLS & FOOTINGS (TYP.).
- Handwritten Notes:**
 - 21-161951
 - gm Jan 4/22
- Dimensions:**
 - Overall height: 10'-1" (from FIN. GRADE to TOP OF PLATE).
 - Overall width: 24'-0" (from FIN. GRADE to TOP OF PLATE).
 - Overall depth: 8'-6" (from FIN. GRADE to TOP OF SLAB).

JOHN C. WILLIAMS LTD., ARCHITECT
ARCHITECTURAL OFFICE 18-000
480-6996/04
SIGNED: 
DATE: 08/27/04
This document contains proprietary information
designed to be used only by the architect.
Unauthorized reproduction is prohibited.

16			9			The undersigned has reviewed and takes responsibility for this design and has the specifications and made the requirements set out in the Ontario Building Code to be a Designer.	 255 Consumers Rd Suite 120 Toronto ON M2M 1A8 T 416-635-2255 F 416-635-4752 www.va3design.com	 14.30m project name RUSSELL GARDENS PH.4 municipality HAMILTON, ON project no. 20027	drawing no. A8b
17		8			qualification information Richard Vink  signature 24489 FCM				
18		7			reputation information VA3 Design Inc. 42656				
19		6							
20		5							
21		4							
22		3	ISSUED FOR PERMIT.	MAY 21/21	ON				
23		2	REV. PER CLIENT/PROF./EL/ENG COMMENTS	MAR. 31/21	ON	Contractor must verify all dimensions on the job and report any variations to the Designer before proceeding with the work. All drawings and specifications are instruments of service and the property of the Designer which will be returned at the completion of the work. Drawings are not to be altered.			
24		1	PRELIMINARY ISSUED FOR CLIENT REVIEW	MAR. 12/21	ON				
25	no. description	date	by no. description	date	by				

All documents, materials, and data are the confidential property of H3C US, INC. Reproduction of this property in whole or in part is strictly prohibited without H3C US, INC.'s written consent.

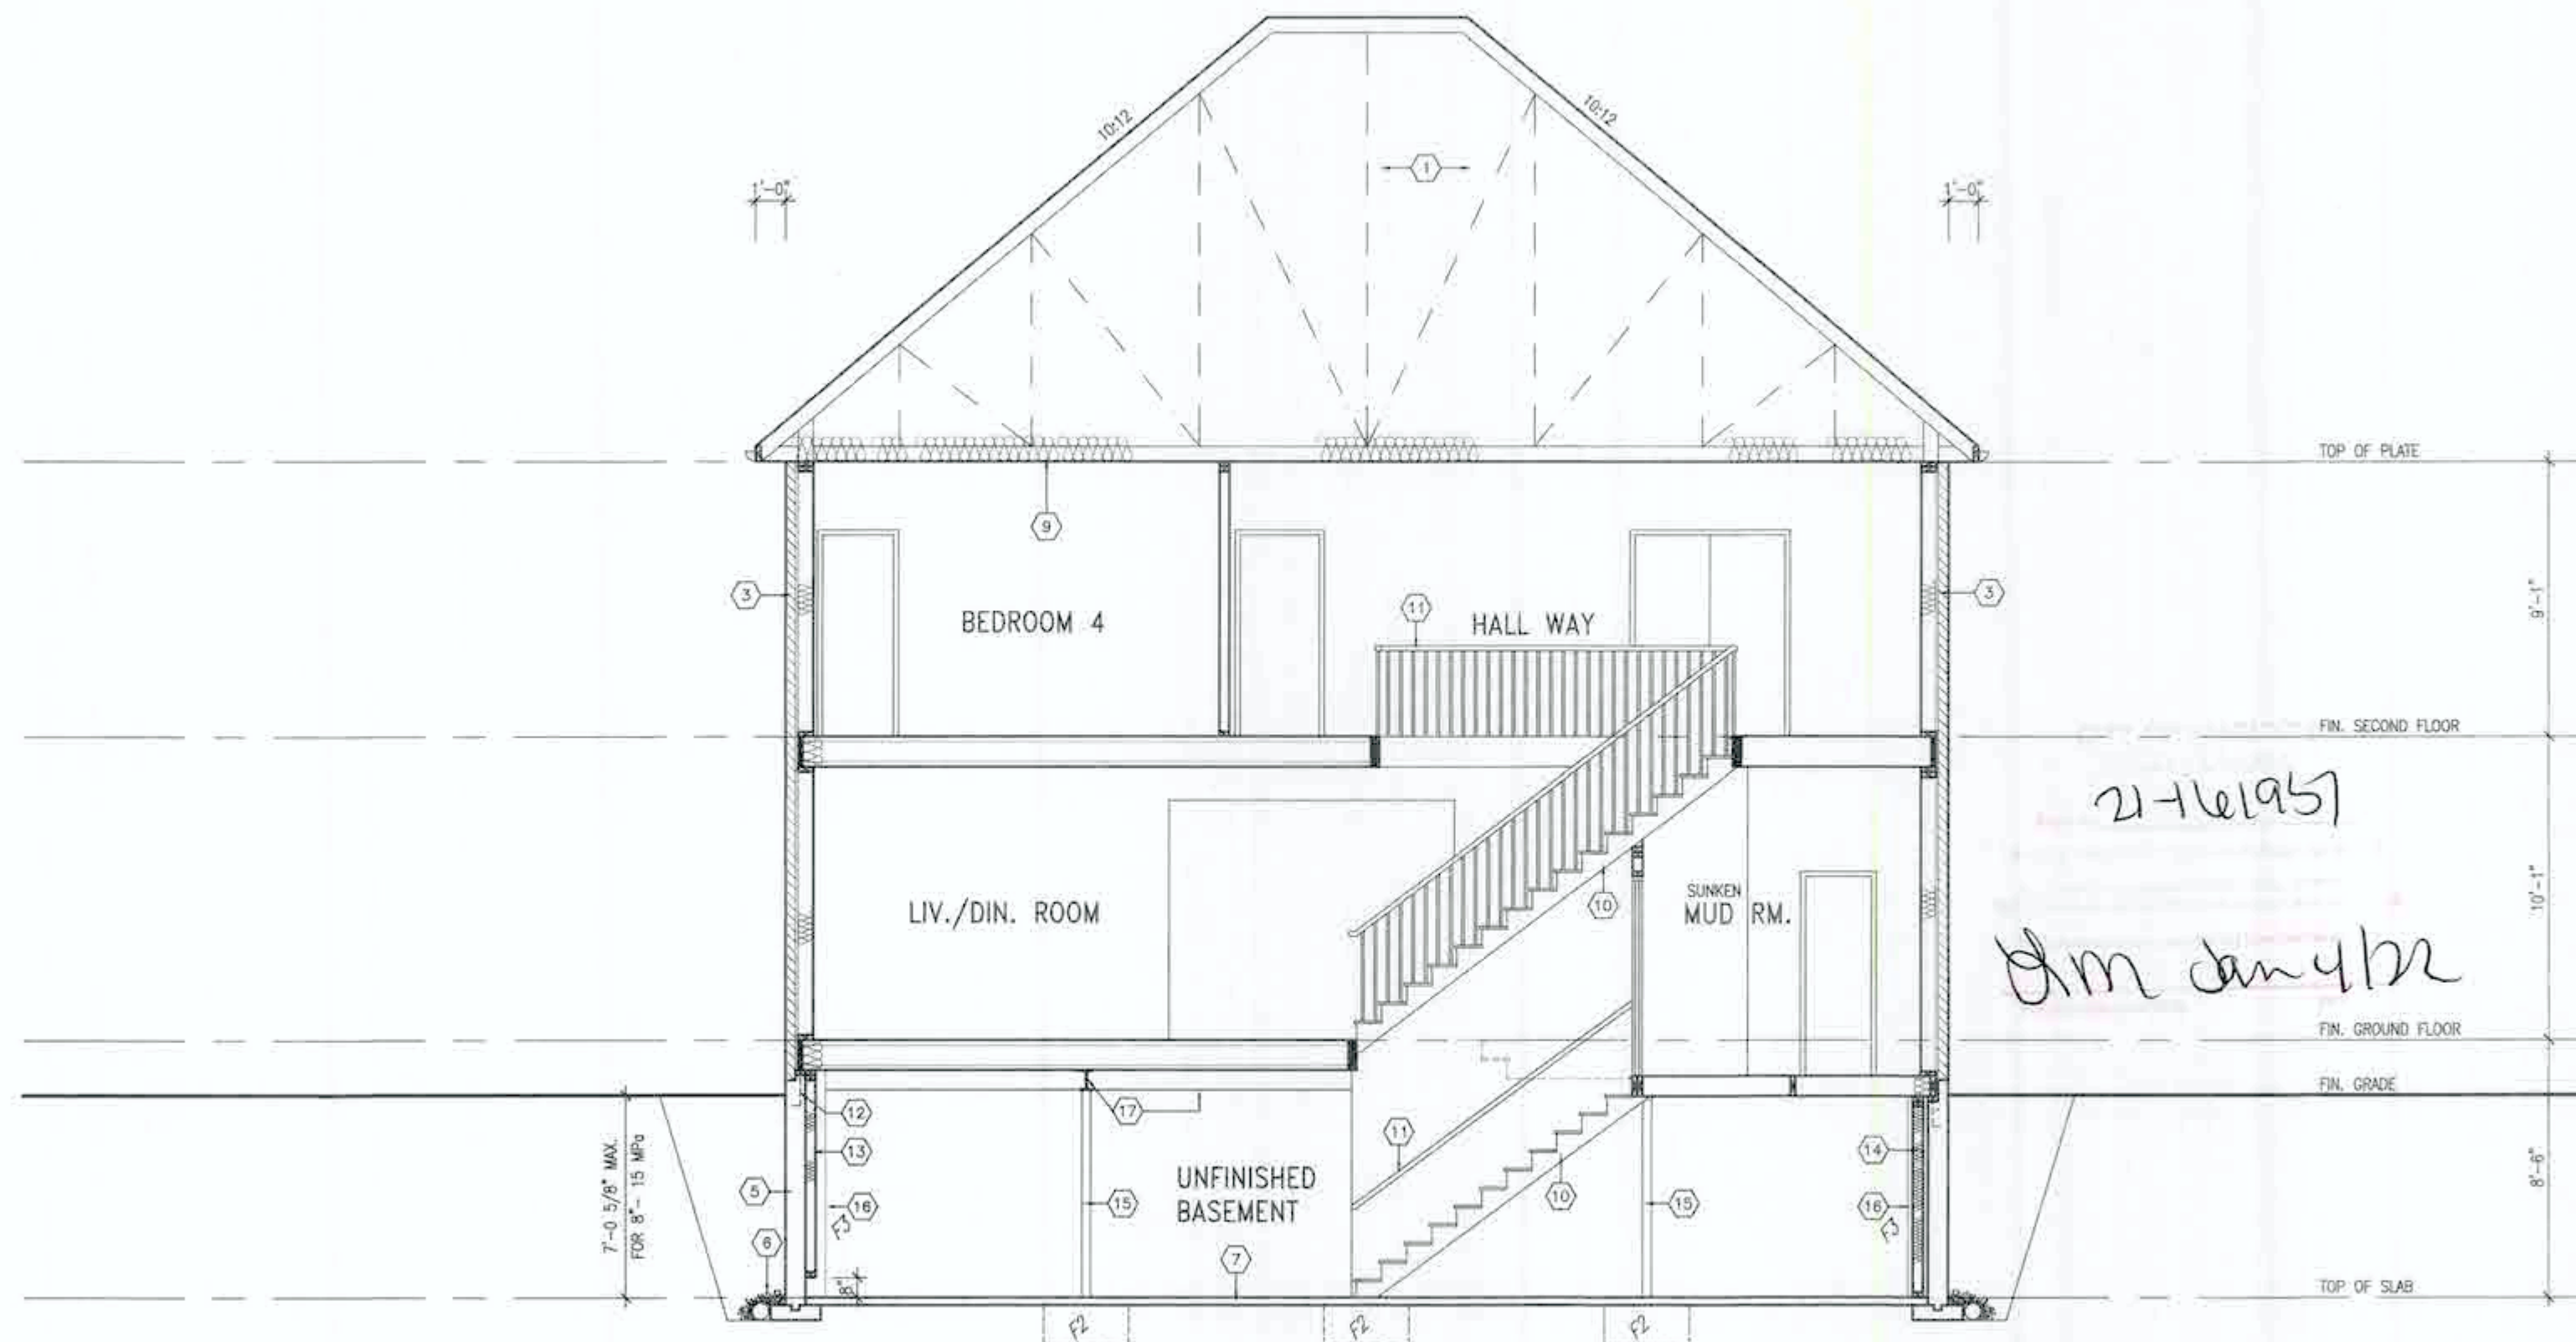

SECTION A-A ELEVATION '2'

It is the builder's complete responsibility to ensure that all plans submitted for approval fully comply with the Architectural Guidelines and all applicable regulations and requirements in the subdivision agreement. The Contractor/Architect is not responsible in any way for examining or approving side setting plans or working drawings with respect to any zoning or building code of permit matter or that any house can be properly built or located on its lot.


This is to certify that these plans comply with the applicable Architectural Design Guidelines approved by the City of Hamilton.



18 17 16 15 14 13 12 11 10 9 8 7 6 5 4 3 2 1	18 17 16 15 14 13 12 11 10 9 8 7 6 5 4 3 2 1	18 17 16 15 14 13 12 11 10 9 8 7 6 5 4 3 2 1	18 17 16 15 14 13 12 11 10 9 8 7 6 5 4 3 2 1	18 17 16 15 14 13 12 11 10 9 8 7 6 5 4 3 2 1
--	--	--	--	--

SPRINGFIELD 3S
COMPLIANCE PACKAGE 'A1'

255 256 257 300	255 256 257 300
---	---

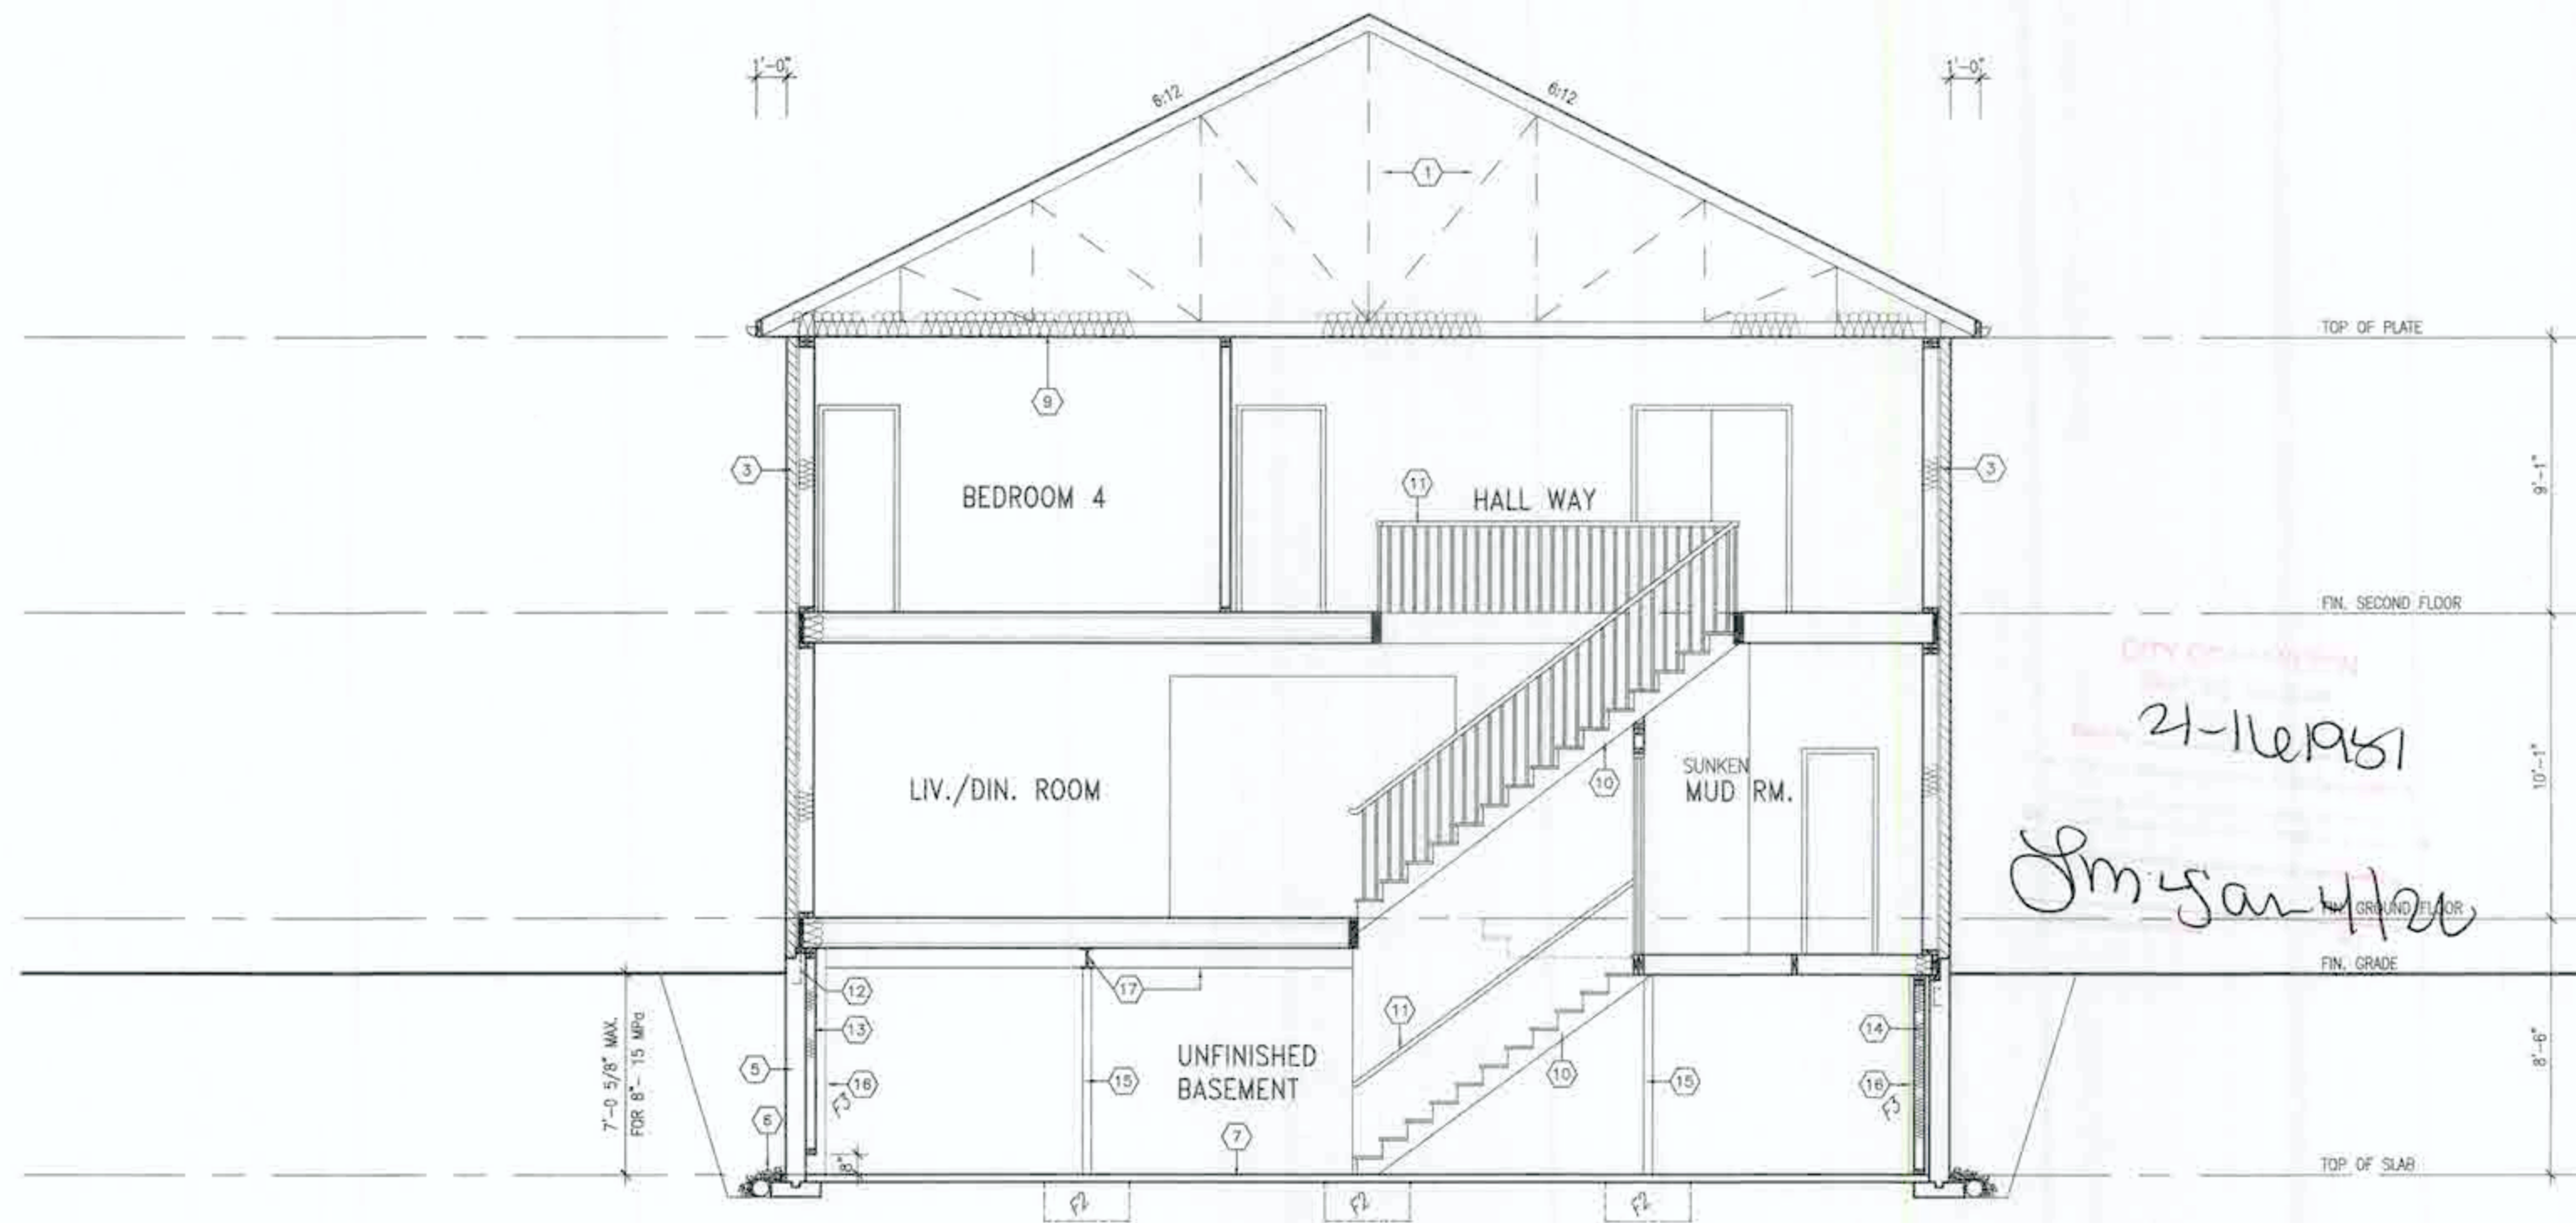

SECTION A-A ELEVATION '3'

It is the builder's complete responsibility to ensure that all plans submitted for approval fully comply with the Architectural Guidelines and all applicable regulations and requirements including zoning provisions and any provisions in the subdivision agreement. The Control Architect is not responsible in any way for examining or approving site (lotting) plans or working drawings with respect to any zoning or building code or permit matter or that any house can be properly built or located on its lot.

This is to certify that these plans comply with the applicable Architectural Design Guidelines approved by the City of HAMILTON.



18 17 16 15 14 13 12 11 10 9 8 7 6 5 4 3 2 1				18 17 16 15 14 13 12 11 10 9 8 7 6 5 4 3 2 1				18 17 16 15 14 13 12 11 10 9 8 7 6 5 4 3 2 1				18 17 16 15 14 13 12 11 10 9 8 7 6 5 4 3 2 1				18 17 16 15 14 13 12 11 10 9 8 7 6 5 4 3 2 1				18 17 16 15 14 13 12 11 10 9 8 7 6 5 4 3 2 1				18 17 16 15 14 13 12 11 10 9 8 7 6 5 4 3 2 1				18 17 16 15 14 13 12 11 10 9 8 7 6 5 4 3 2 1				18 17 16 15 14 13 12 11 10 9 8 7 6 5 4 3 2 1				18 17 16 15 14 13 12 11 10 9 8 7 6 5 4 3 2 1				18 17 16 15 14 13 12 11 10 9 8 7 6 5 4 3 2 1				18 17 16 15 14 13 12 11 10 9 8 7 6 5 4 3 2 1				18 17 16 15 14 13 12 11 10 9 8 7 6 5 4 3 2 1				18 17 16 15 14 13 12 11 10 9 8 7 6 5 4 3 2 1				18 17 16 15 14 13 12 11 10 9 8 7 6 5 4 3 2 1				18 17 16 15 14 13 12 11 10 9 8 7 6 5 4 3 2 1				18 17 16 15 14 13 12 11 10 9 8 7 6 5 4 3 2 1				18 17 16 15 14 13 12 11 10 9 8 7 6 5 4 3 2 1				18 17 16 15 14 13 12 11 10 9 8 7 6 5 4 3 2 1				18 17 16 15 14 13 12 NOTE:
REFER TO STANDARD FLOOR PLANS
FOR ADDITIONAL INFORMATION.



PLANS AND ELEVATION ILLUSTRATE DECK
CONDITIONS WHERE GRADE PERMITS. BASEMENT
WINDOWS APPLY TO CONDITIONS OF A MINIMUM
4'-6" FROM FINISHED FIRST FLOOR TO GRADE.

VENEER CUT
WHEN VENEER CUT IS GREATER
THAN 26", A 10" POURED
CONCRETE FOUNDATION WALL IS
REQUIRED.

WOOD DECK DETAILS
REFER TO STANDARD DETAIL PACKAGE (PAGE 5)
FOR ADDITIONAL WOOD DECK INFORMATION.

BASEMENT WALL INSULATION
(TYP) 13
-6" (R20) CONTINUOUS BLANKET
INSULATION. INSULATION
UNINTERRUPTED BY FRAMING

BASEMENT INSULATION AT
STAIR/SUNKEN AREAS
-2" (R10) CONTINUOUS INSULATION
(RIGID OR SPRAY FOAM).
-2"x4" @ 16"o.c. w/ R12 BATT
INSULATION & 1/2" DRYWALL FINISH
-EXTEND EXTERIOR WALL FOOTING TO
SUPPORT 2"x4" WALL WHERE LOAD
BEARING.

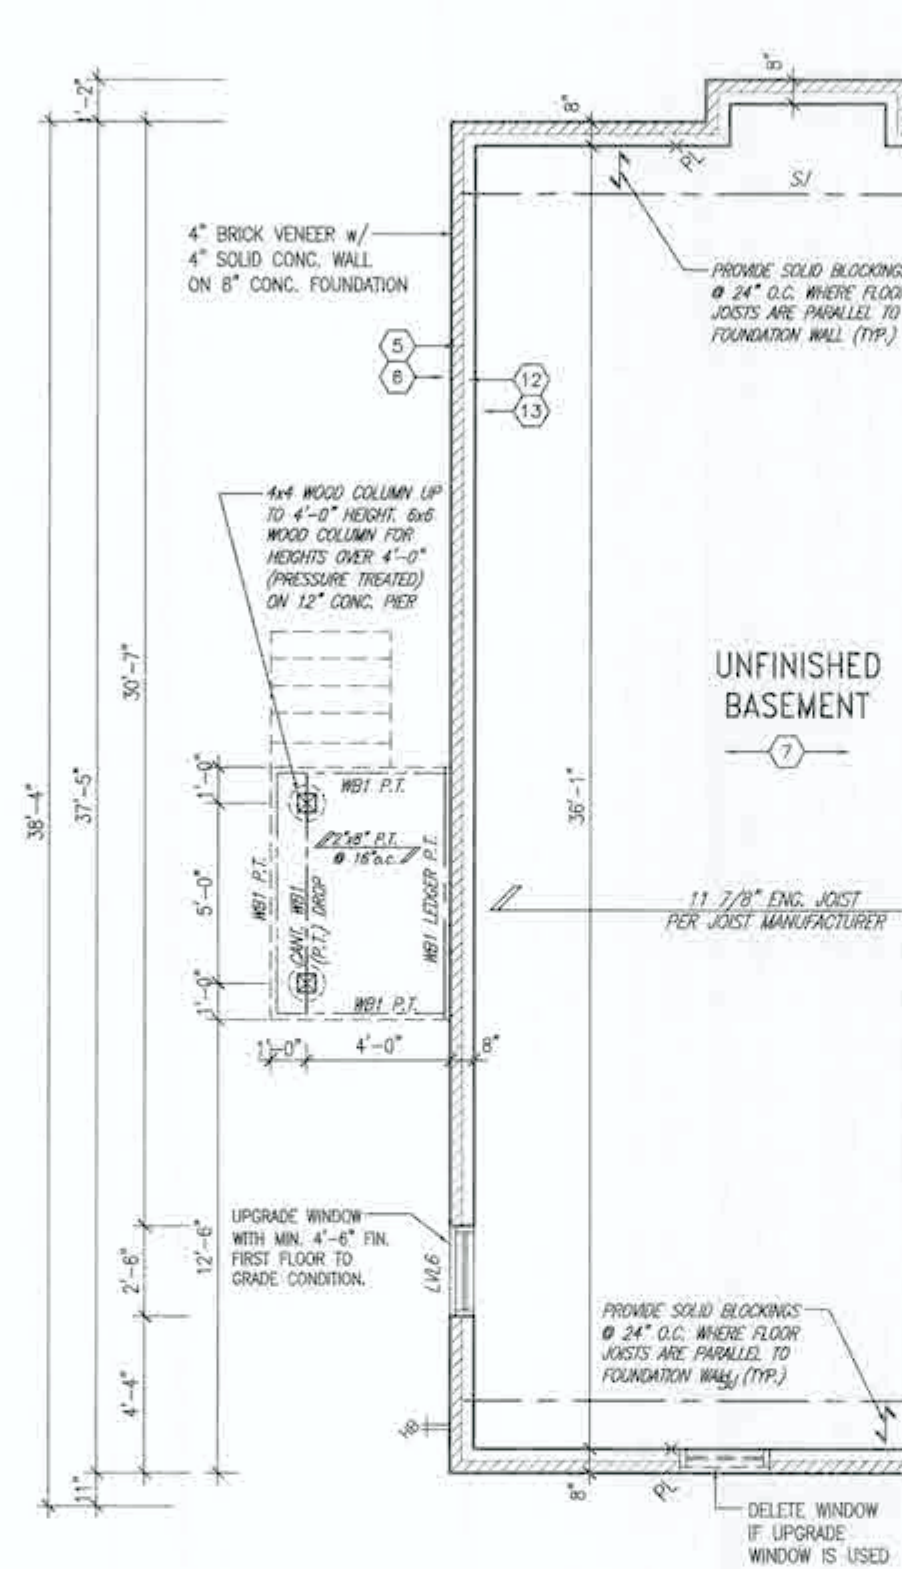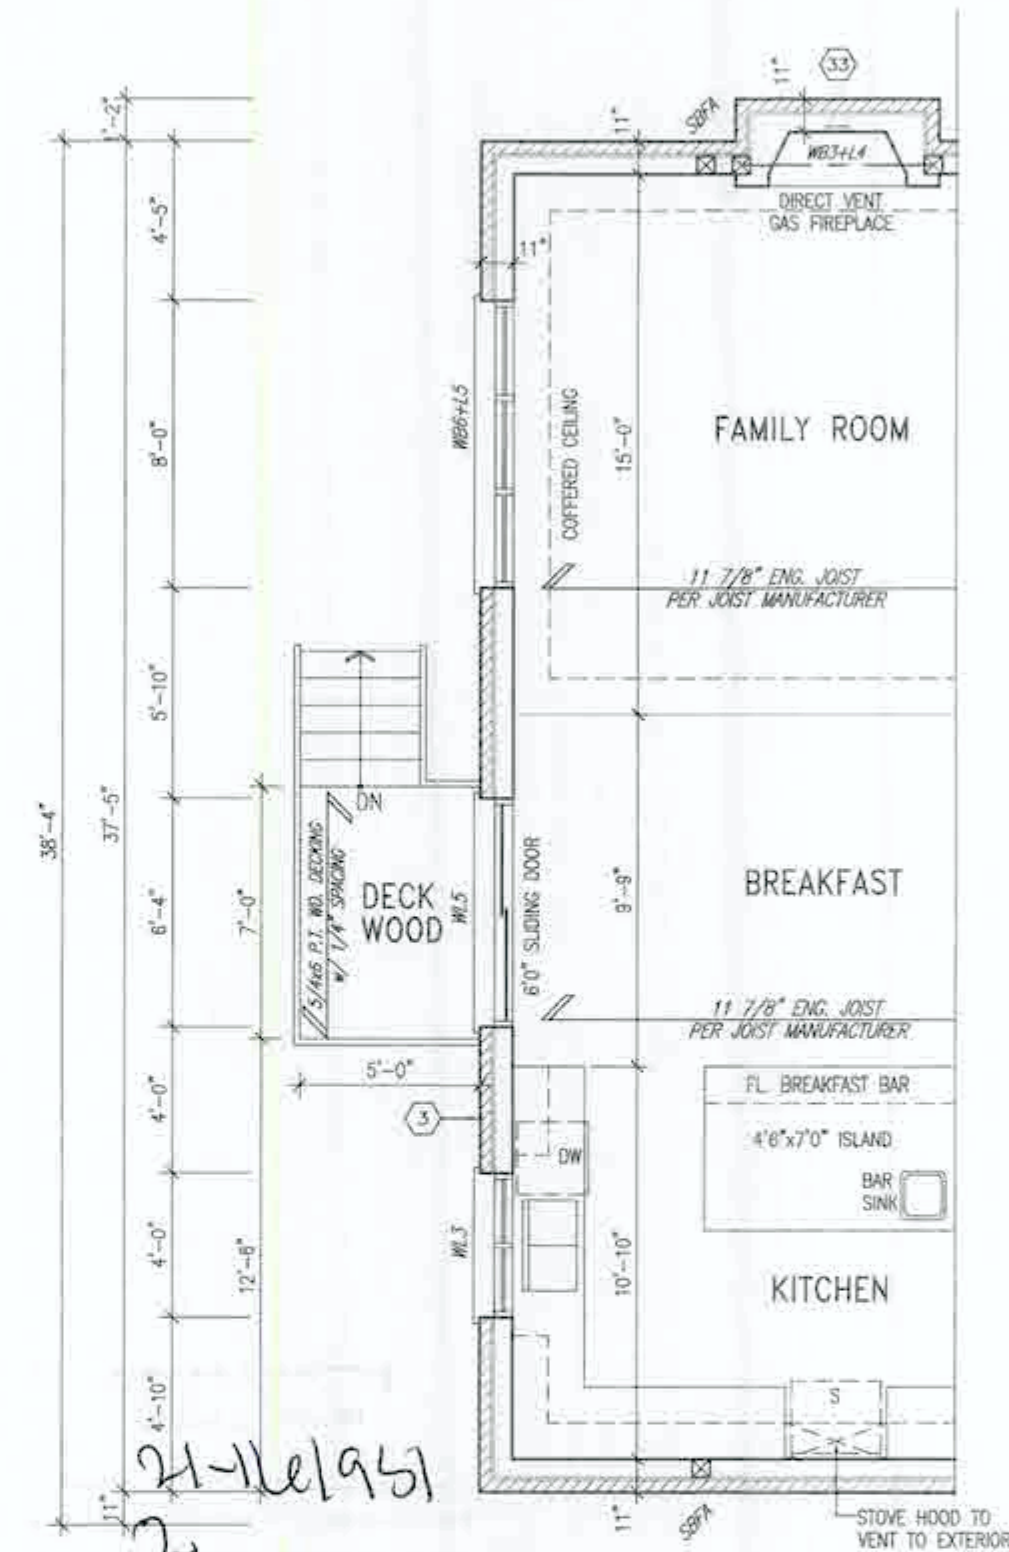PARTIAL BASEMENT PLAN
DECK CONDITION

PARTIAL GROUND FLOOR PLAN
DECK CONDITION

It is the builder's complete responsibility to ensure that all plans submitted for approval fully comply with the Architectural Guidelines and all applicable regulations and requirements including zoning provisions and any provisions in the subdivision agreement. The Control Architect is not responsible in any way for examining or approving site (lotting) plans or working drawings with respect to any zoning or building code or permit matter or that any house can be properly built or located on its lot.

This is to certify that these plans comply with the applicable Architectural Design Guidelines approved by the City of HAMILTON.



STRUDET, INC.
FOR STRUCTURE ONLY

18				9		
17				8		
16				7		
15				6		
14				5		
13				4		
12				3	ISSUED FOR PAYMENT.	MAY 21/21
11				2	REV. PER CLIENT/ROOF/FL/ENG. COMMENTS	MAR. 31/21
10				1	PRELIMINARY. ISSUED FOR CLIENT REVIEW	MAR 12/21
no.	description	date	by	no.	description	date

	The undersigned has reviewed and takes responsibility for this design and has the qualifications and meets the requirements set out in the Ontario Building Code to be a Designer:		
	qualification information		
	Richard Vink	<i>R Vink</i>	24
	name	signature	
	registration information		
	V&S Design Inc.		42
GW	Contractor must verify all details on the job and report any discrepancy to the Designer before proceeding with the work. All drawings and specifications are instruments of service and the property of the Designer which must be returned at the completion of the project. Drawings not to be copied.		
GW			
GW			
GW			

VA3
DESIGN
255 Consumers Rd Suite
Toronto ON M2J 1R4
T 416.630.2255 F 416.630.
va3design.com

 Greenpark.		SPRINGFIELD 3S 14.30m	
project name RUSSELL GARDENS PH.4		municipality HAMILTON, ON	
date JANUARY, 2021		drawing no. 20027	
checked by CL		PART. PLANS W.O.D. CONDITION 20027-SPRINGFIELD-3S	
scale 3/16" = 1'-0"		A10	

SPRINGFIELD 3S
COMPLIANCE PACKAGE 'A1'

SPRINGFIELD 3S
14.30m

20027

D. CONDITION

027-SPRINGFIELD-3S A10



EXTERIOR RAILINGS:
3'-6" HIGH RAILING IF LANDING IS MORE
THAN 5'-11" ABOVE FINISHED GRADE
AND 3'-0" HIGH RAILING WHEN LANDING
IS LESS THAN 5'-11" ABOVE ADJACENT
FINISHED GRADE

REAR ELEVATION - ELEV. '2' W.O.D

ELEVATIONS NOT DRAWN TO ACTUAL GRADE
REFER TO FINAL GRADING PLAN.

It is the builder's complete responsibility to ensure that all plans submitted for approval fully comply with the Architectural Guidelines and all applicable regulations and requirements including zoning provisions and any provisions in the subdivision agreement. The Control Architect is not responsible in any way for examining or approving site (lotting) plans or working drawings with respect to any zoning or building code or permit matter or that any house can be properly built or located on its lot.

This is to certify that these plans comply with the applicable Architectural Design Guidelines approved by the City of HAMILTON.

JOHN G. WILLIAMS LTD., ARCHITECTS
ARCHITECTURAL - DESIGN - BUILD
1800 JEFFERSON

DATE: 2006-12-20

16		9			The undersigned has reviewed and takes responsibility for this record and has the qualifications and meets the requirements set out in the Ontario Building Code as it is a Designer.
17		8			qualification information
18		7			Richard Vink  2
19		6			registration information
20		5			VDS Design Inc. 42
21		4			
22		3	ISSUED FOR PERMIT	MAY 21/21	CM
23		2	REV. PER CLIENT/ROOF/FLOOR/ENG. COMMENTS	MAR. 31/21	CM
24		1	PRELIMINARY ISSUED FOR CLIENT REVIEW	MAR 12/21	CM
25	rev. description	date	by no description	date	by

GW GW GW GW	The undersigned has reviewed and takes responsibility for this Review and has the qualifications and meets the requirements set out in the Defect Building Code to be a Designer. Qualification Information Richard Vink <i>R. Vink</i> 24 name Signature VA3 Design Inc. 42 Contractor must verify all dimensions on the job and report any discrepancy to the Designer before proceeding with the work. All drawings and specifications are instruments of service and the property of the Designer which must be returned at the completion of the project. Drawings are not to be copied.	24 42
----------------------	---	----------





Greenpark
PROJECT: RUSSELL GARDENS PH.4
HAMILTON, ONTARIO

SPRINGFIELD 3S
14.30m


SPRINGFIELD 3S
COMPLIANCE PACKAGE 'A1'

2
-3S A11a

RE: American Intelligence - United States and Canada - the essential elements of the SYSTEMS component of the research to which we are not to be admitted without ANY NOTICE, without comment.

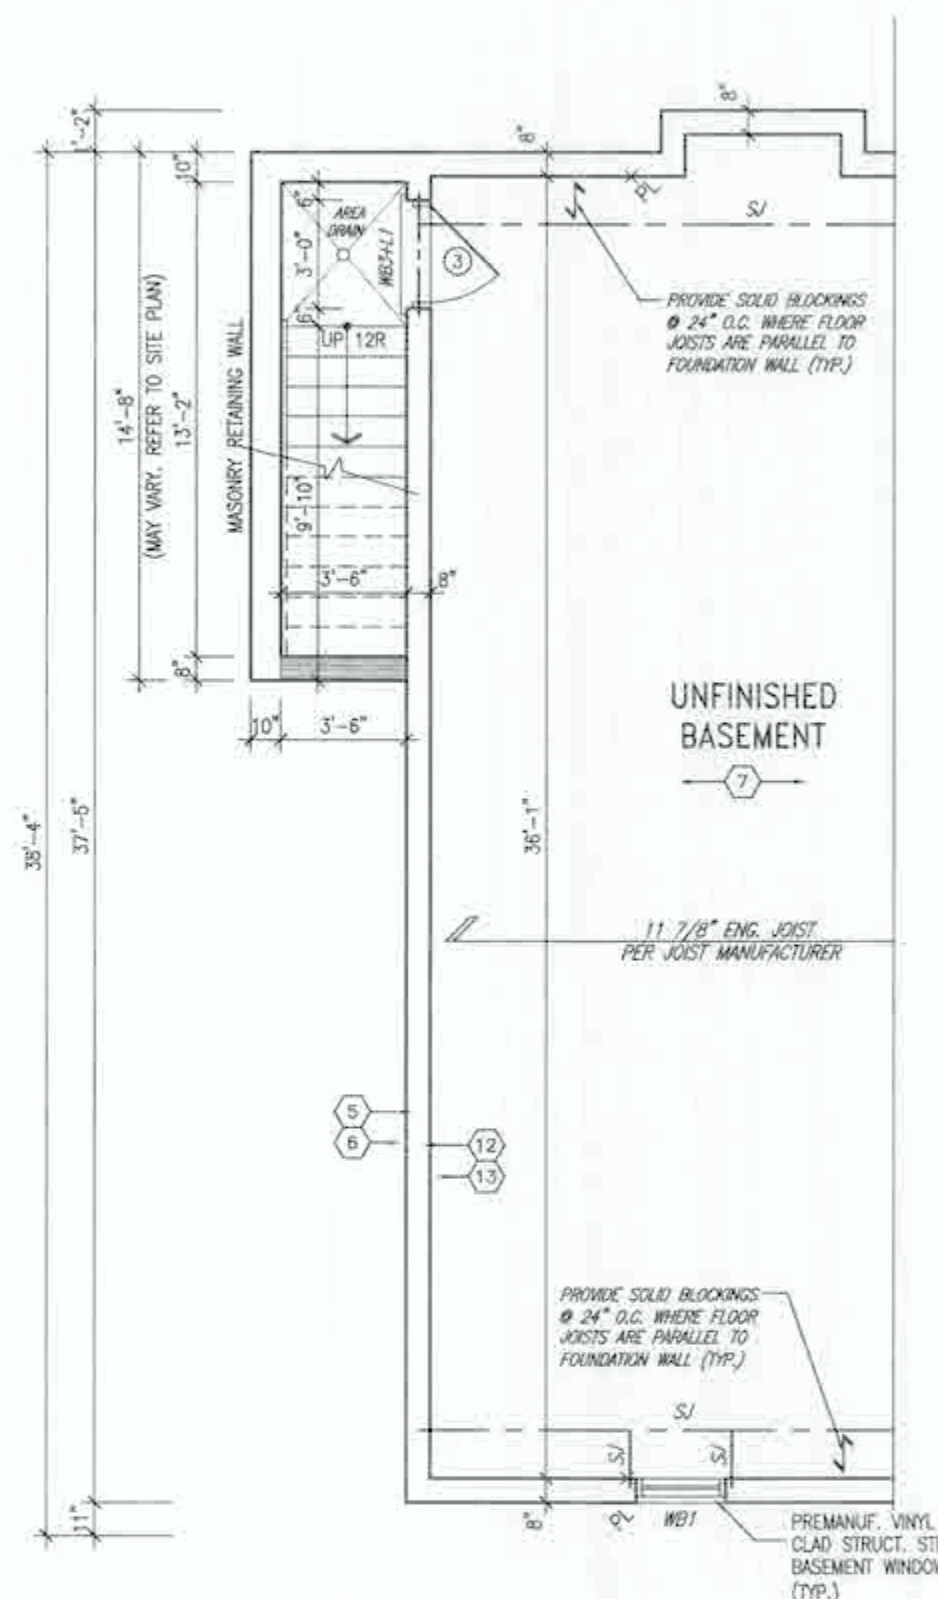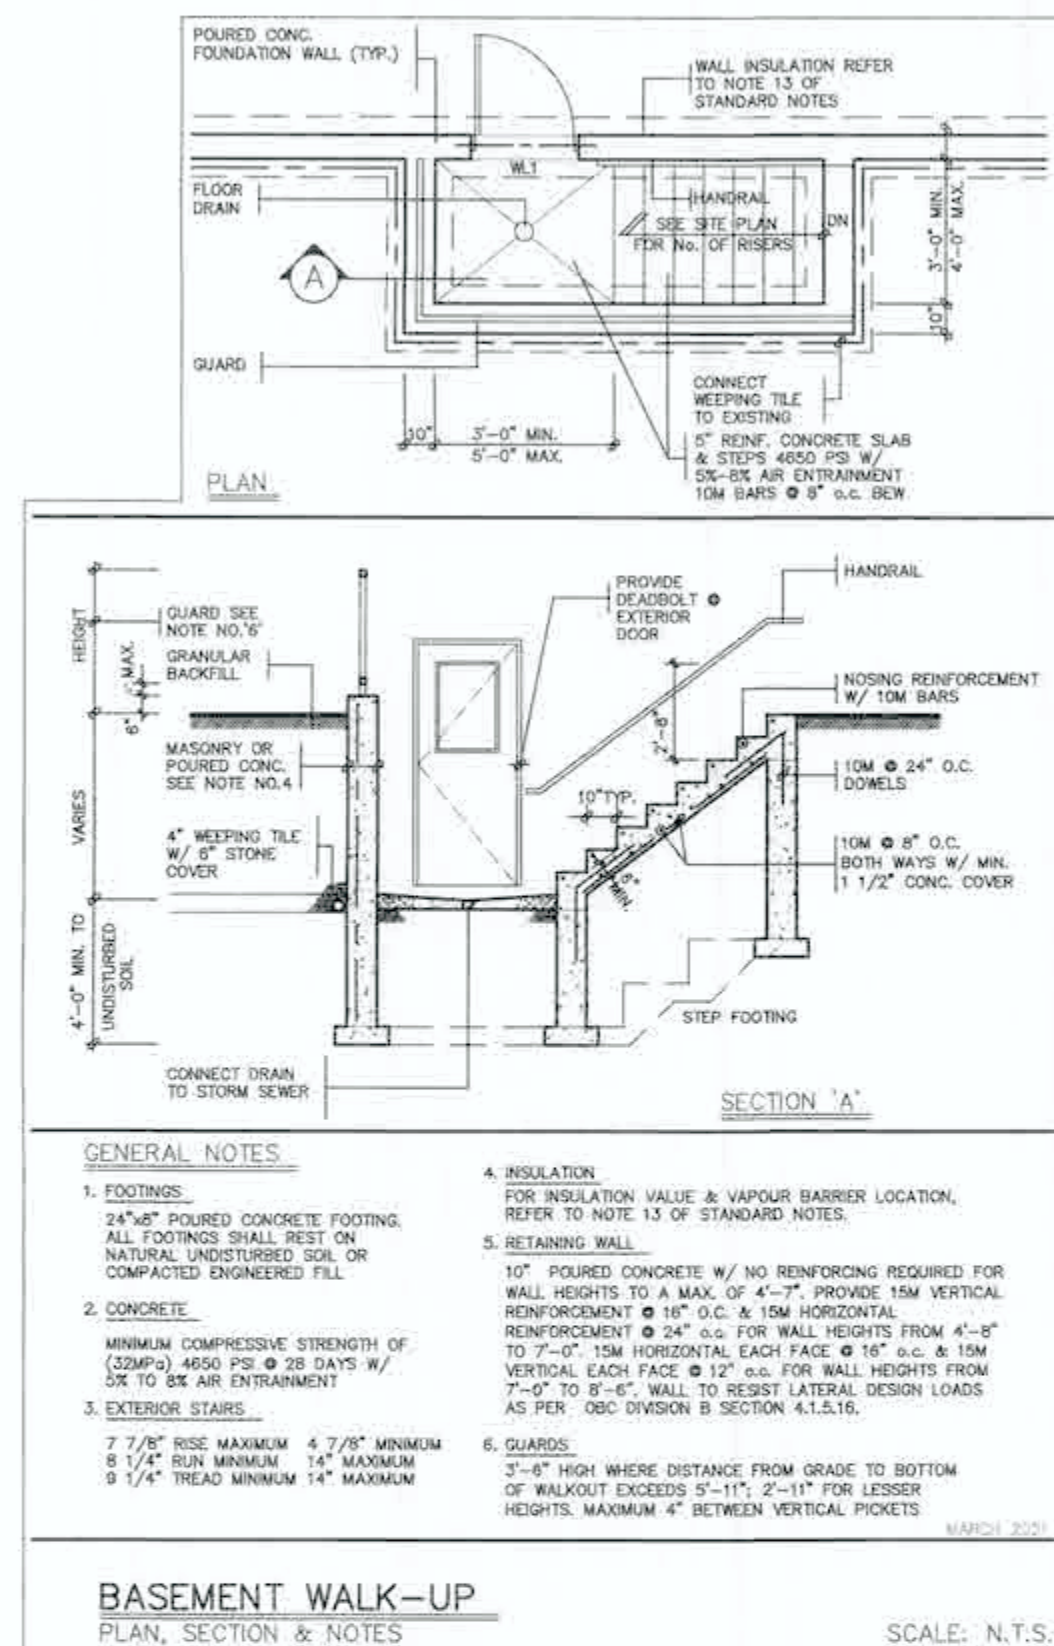

PARTIAL BASEMENT PLAN
w/ OPT. WALK-UP STAIRS

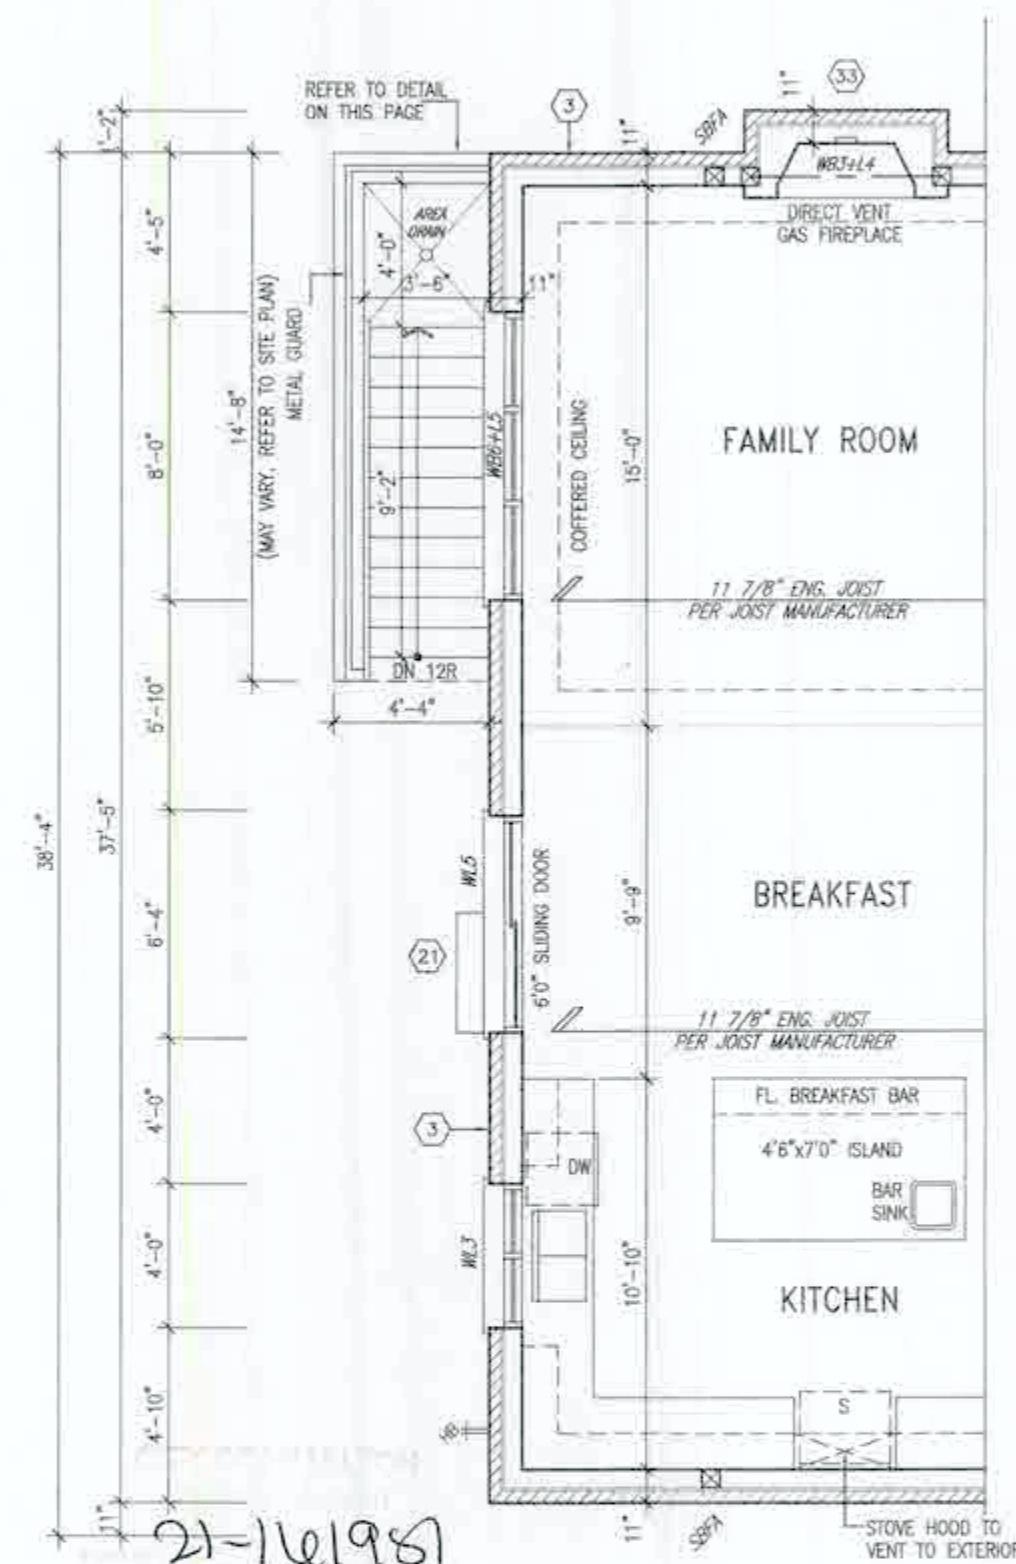

Jan 4/24 PARTIAL GROUND FLOOR PLAN
w/ OPT. WALK-UP STAIRS

NOTE:
REFER TO STANDARD FLOOR PLANS
FOR ADDITIONAL INFORMATION.

VENUE CUT
WHEN VENEER CUT IS GREATER
THAN 26", A 10" POURED
CONCRETE FOUNDATION WALL IS
REQUIRED.

BASEMENT WALL INSULATION
(TYP.) (13)
-6" (R20) CONTINUOUS BLANKET
INSULATION. INSULATION
UNINTERRUPTED BY FRAMING.

**BASEMENT INSULATION AT
STAIR/SUNKEN AREAS**
-2" (R10) CONTINUOUS INSULATION
(RIGID OR SPRAY FOAM).
-2"x4" @ 16" o.c. w/ R12 BATT
INSULATION & 1/2" DRYWALL FINISH
-EXTEND EXTERIOR WALL FOOTING TO
SUPPORT 2"x4" WALL WHERE LOAD
BEARING.

It is the builder's complete responsibility to ensure that all plans submitted for approval fully comply with the Architectural Guidelines and all applicable regulations and requirements including zoning provisions and any provisions in the subdivision agreement. The Control Architect is not responsible in any way for examining or approving site (noting) plans or working drawings with respect to any zoning or building code or permit matter or that any house can be properly built or located on its lot.

This is to certify that these plans comply with the applicable Architectural Design Guidelines approved by the City of HAMILTON.

JOHN C. WILLIAMS LTD., ARCHITECT
ARCHITECTURAL, PLANNING, DESIGN
AND APPROVAL

APPROVED BY: [Signature]
DATE: AUG 17, 2021

The owner certifies compliance with the application.
Design documents (eng. and arch.) do not include
compliance (zoning/land use)



18 17 16 15 14 13 12 11 10 9 8 7 6 5 4 3 2 1 no. description	18 17 16 15 14 13 12 11 10 9 8 7 6 5 4 3 2 1 no. description	18 17 16 15 14 13 12 11 10 9 8 7 6 5 4 3 2 1 no. description	18 17 16 15 14 13 12 11 10 9 8 7 6 5 4 3 2 1 no. description	18 17 16 15 14 13 12 11 10 9 8 7 6 5 4 3 2 1 no. description
---	---	---	---	---

SPRINGFIELD 3S
COMPLIANCE PACKAGE 'A1'

Greenpark. project name RUSSELL GARDENS PH.4 location HAMILTON, ON date JANUARY, 2021 drawn by CL checked by 3/16" = 1'-0" scale 20027-SPRINGFIELD-3S drawn no. A12	VA3 DESIGN 250 Consumers Rd Suite 120 Toronto, ON M2J 1H4 416.630.2255 / 416.630.4782 va3design.com project name RUSSELL GARDENS PH.4 location HAMILTON, ON date JANUARY, 2021 drawn by CL checked by 3/16" = 1'-0" scale 20027-SPRINGFIELD-3S drawn no. A12
--	--

3601 SF.



REAR ELEVATION - ELEV. '1'
WALK-UP STAIRS

ELEVATIONS NOT DRAWN TO ACTUAL GRADE.
REFER TO FINAL GRADING PLAN.

It is the builder's complete responsibility to ensure that all plans submitted for approval fully comply with the Architectural Guidelines and all applicable regulations and requirements including zoning provisions and any provisions in the subdivision agreement. The Control Architect is not responsible in any way for examining or approving site (lotting) plans or working drawings with respect to any zoning or building code or permit number or that any house can be properly built or located on its lot.

This is to certify that these plans comply with the applicable Architectural Design Guidelines approved by the City of HAMILTON.

JENNIFER WILLIAMS LTD., ARCHITECT
ARCHITECTURAL CONTROL NUMBER
440 40000000
APPROVED BY: *[Signature]*
DATE: AUG 27 2021
This stamp, getting, endorsement, and the signature of the Architect, is not a seal of the City of Hamilton.

18 17 16 15 14 13 12 11 10 9 8 7 6 5 4 3 2 1 no. description	9 8 7 6 5 4 3 2 1 no. description	10 9 8 7 6 5 4 3 2 1 no. description	10 9 8 7 6 5 4 3 2 1 no. description	10 9 8 7 6 5 4 3 2 1 no. description	10 9 8 7 6 5 4 3 2 1 no. description
---	---	---	---	---	---

SPRINGFIELD 3S
COMPLIANCE PACKAGE 'A1'

Greenpark. **SPRINGFIELD 3S**
14.30m

project name: RUSSELL GARDENS PH.4 municipality: HAMILTON, ON project no: 20027

date: JANUARY, 2021 sheet no: 1 of 1

drawn by: CL checked by: 3/16" = 1'-0" 20027-SPRINGFIELD-3S

A13



It is the builder's complete responsibility to ensure that all plans submitted for approval fully comply with the Architectural Guidelines and all applicable regulations and requirements including zoning provisions and any provisions in the subdivision agreement. The Control Architect is not responsible in any way for examining or approving site (lotting) plans or working drawings with respect to any zoning or building code or permit matter or that any house can be properly built or located on its lot.

This is to certify that these plans comply with the applicable Architectural Design Guidelines approved by the City of HAMILTON.

JOHN C. WILHELM (T.D.) ARCHITECT
ARCHITECTURAL CONTROL REVIEW
AND APPROVAL
DATE: 2022-01-11
BY: [Signature]
2022-01-11

18 17 16 15 14 13 12 11 10 9 8 7 6 5 4 3 2 1 no. description				18 17 16 15 14 13 12 11 10 9 8 7 6 5 4 3 2 1 no. description				18 17 16 15 14 13 12 11 10 9 8 7 6 5 4 3 2 1 no. description				18 17 16 15 14 13 12 11 10 9 8 7 6 5 4 3 2 1 no. description				18 17 16 15 14 13 12 11 10 9 8 7 6 5 4 3 2 1 no. description				18 17 16 15 14 13 12 11 10 9 8 7 6 5 4 3 2 1 no. description				18 17 16 15 14 13 12 11 10 9 8 7 6 5 4 3 2 1 no. description				18 17 16 15 14 13 12 11 10 9 8 7 6 5 4 3 2 1 no. description				18 17 16 15 14 13 12 11 10 9 8 7 6 5 4 3 2 1 no. description				18 17 16 15 14 13 12 11 10 9 8 7 6 5 4 3 2 1 no. description				18 17 16 15 14 13 12 11 10 9 8 7 6 5 4 3 2 1 no. description				18 17 16 15 14 13 12 11 10 9 8 7 6 5 4 3 2 1 no. description				18 17 16 15 14 13 12 11 10 9 8 7 6 5 4 3 2 1 no. description				18 17 16 15 14 13 12 11 10 9 8 7 6 5 4 3 2 1 no. description				18 17 16 15 14 13 12 11 10 9 8 7 6 5 4 3 2 1 no. description				18 17 16 15 14 13 12 11 10 9 8 7 6 5 4 3 2 1 no. description				18 17 16 15 14 13 12 11 10 9 8 7 6 5 4 3 2 1 no. description				18 17 16 15 14 13 12 11 10 9 8 7 16 15 14 13 12 11 10 9 8 7 6 5 4 3 2 1 no. description				18 17 16 15 14 13 12 11 10 9 8 7 6 5 4 3 2 1 no. description				18 17 16 15 14 13 12 11 10 9 8 7 6 5 4 3 2 1 no. description				18 17 16 15 14 13 12 11 10 9 8 7 6 5 4 3 2 1 no. description				18 17 16 15 14 13 12 11 10 9 8 7 6 5 4 3 2 1 no. description				18 17 16 15 14 13 12 11 10 9 8 7 6 5 4 3 2 1 no. description				18 17 16 15 14 13 12 1
---	--	--	--	---	--	--	--	--

[illegible]

REAR ELEVATION - ELEV. '3'
WALK-UP STAIRS

ELEVATIONS NOT DRAWN TO ACTUAL GRADE.
REFER TO FINAL GRADING PLAN.

It is the builder's complete responsibility to ensure that all plans submitted for approval fully comply with the Architectural Guidelines and all applicable regulations and requirements including zoning provisions and any provisions in the subdivision agreement. The Control Architect is not responsible in any way for examining or approving site (lotting) plans or working drawings with respect to any zoning or building code or permit matter or that any house can be properly built or located on its lot.

This is to certify that these plans comply with the applicable Architectural Design Guidelines approved by the City of HAMILTON


JOHN C. WILLIAMS LTD. ARCHITECTS

MONITORING CONTROL ROOM
440 APPROX
NO. 2111 87
DATE 2-10-77 2544

THE above notice appears in all the appropriate
 Design-Contract only and need not be repeated
 elsewhere.

[illegible]

All drawings, specifications, model documents and design are the copyright property of VAS (V20K). Reproduction of this property in whole or in part is strictly prohibited without VAS (V20K)'s written permission.

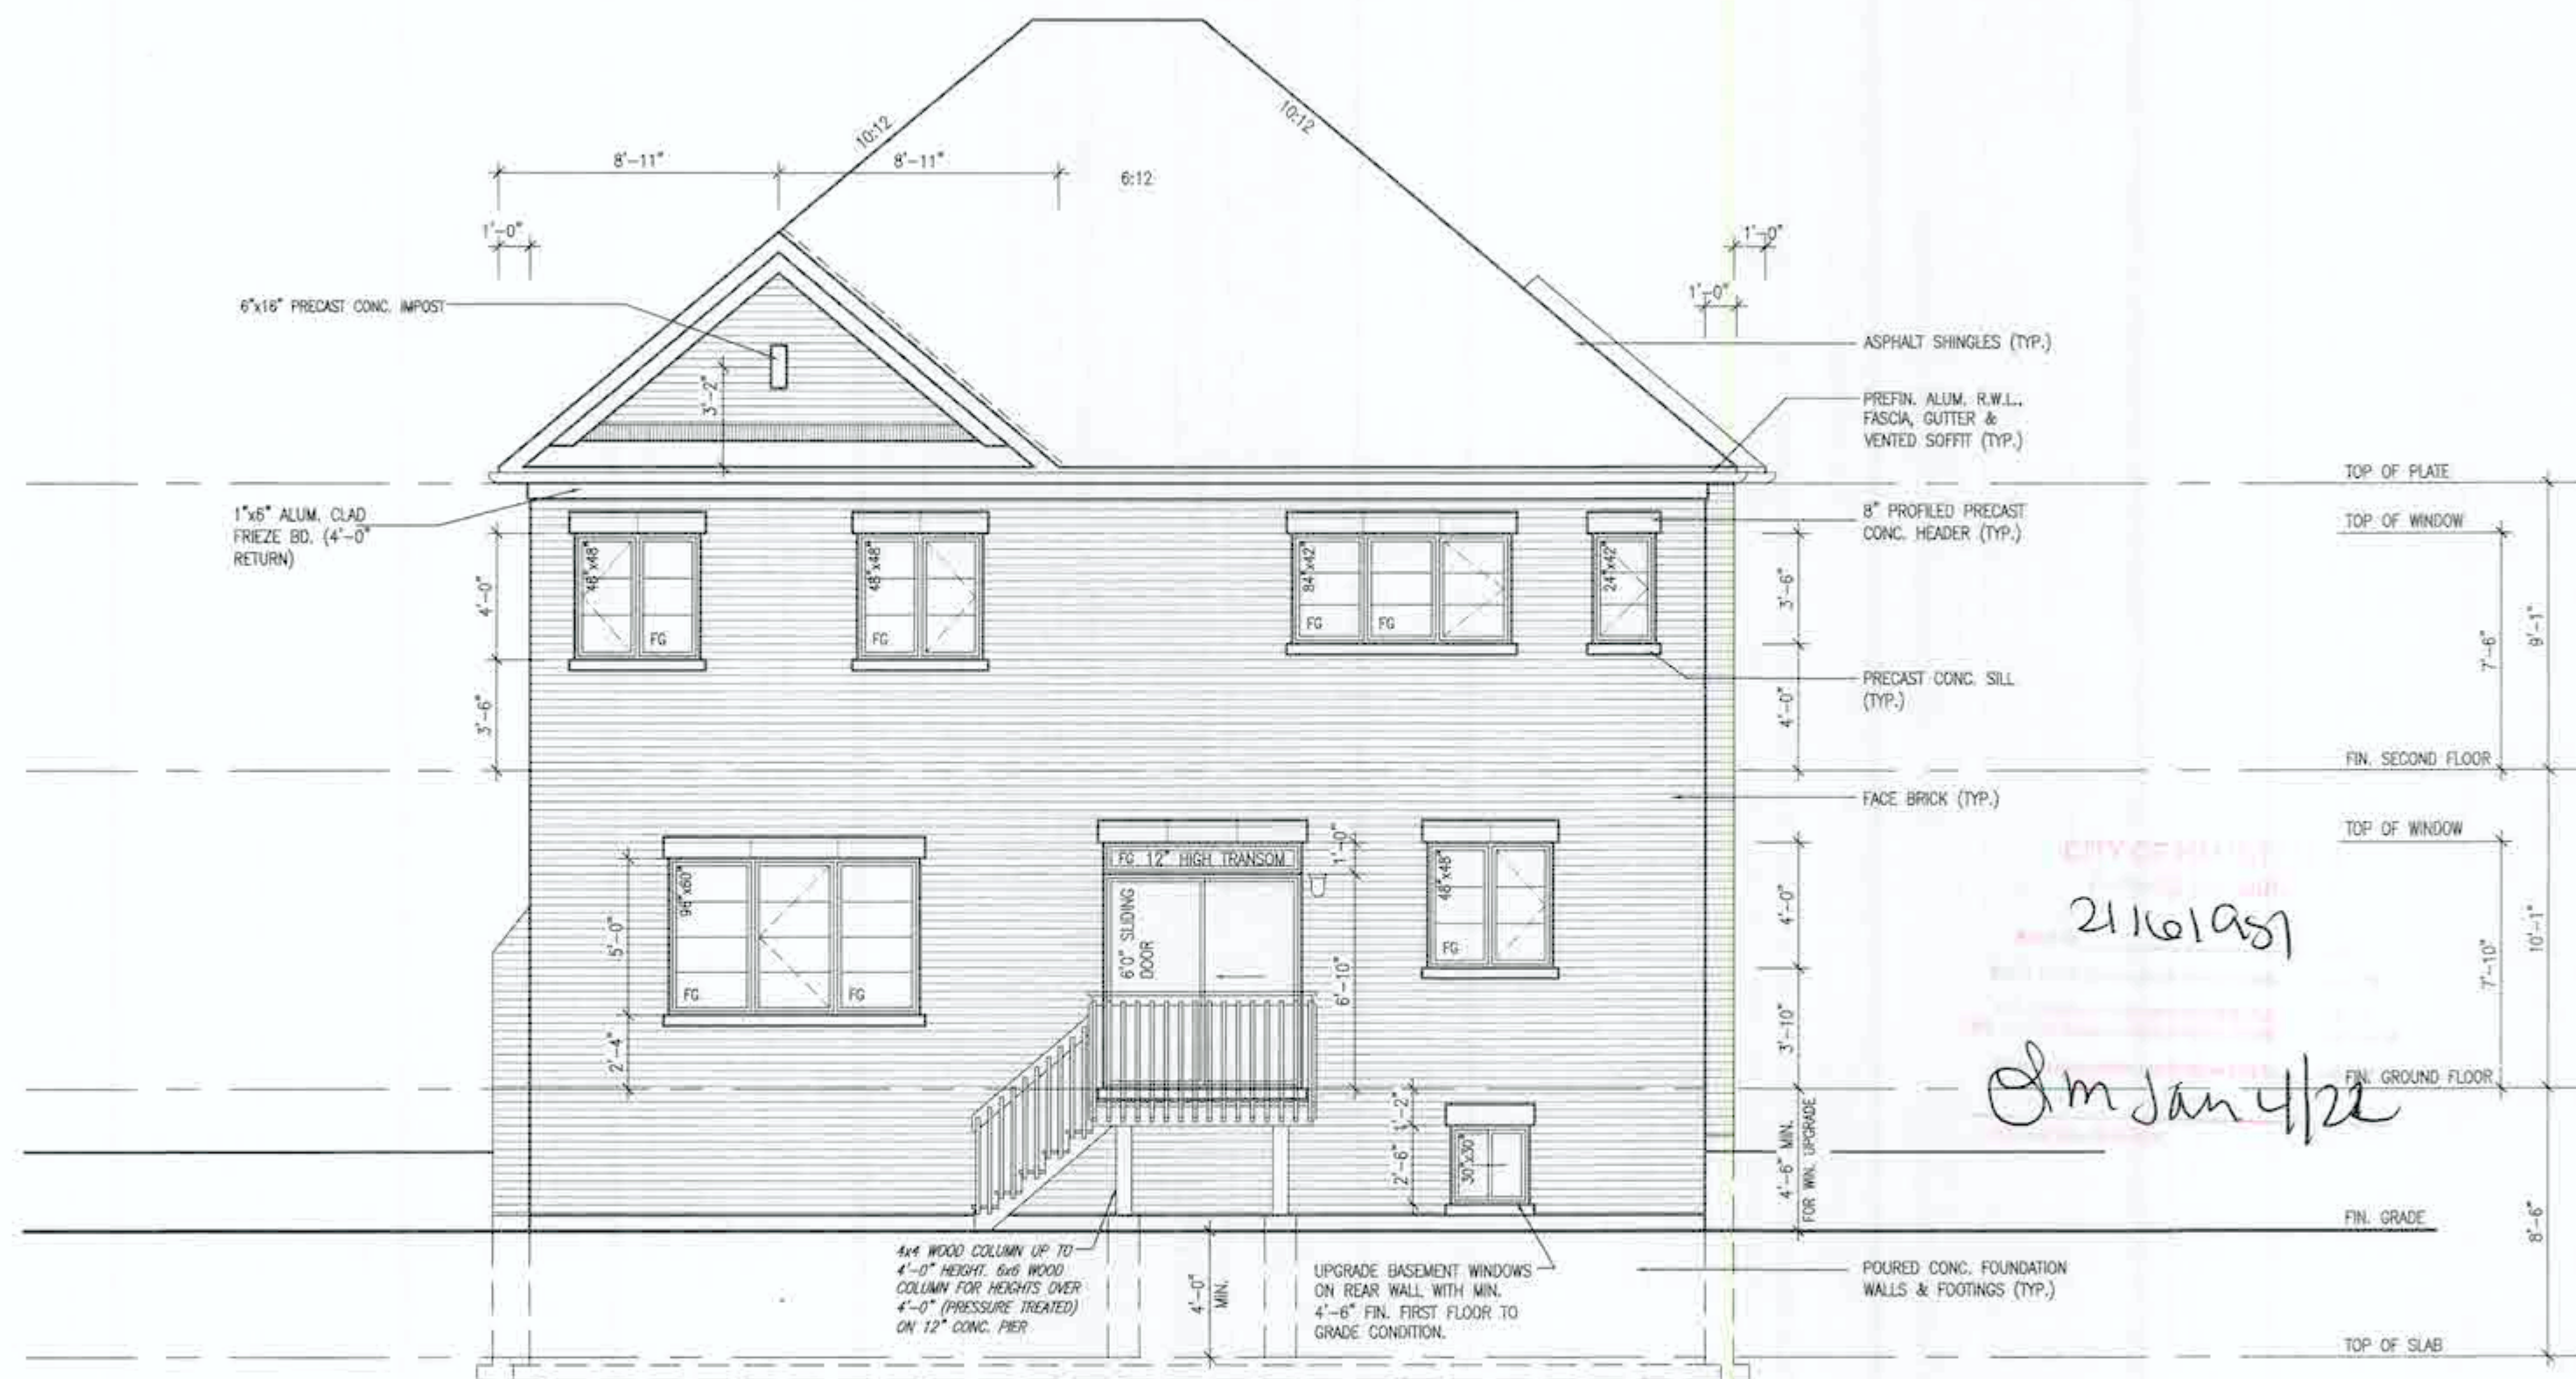

EXTERIOR RAILINGS:
3'-6" HIGH RAILING IF LANDING IS MORE
THAN 5'-11" ABOVE FINISHED GRADE
AND 3'-0" HIGH RAILING WHEN LANDING
IS LESS THAN 5'-11" ABOVE ADJACENT
FINISHED GRADE.

UPGRADED REAR ELEVATION -
ELEV. '2' W.O.D

ELEVATIONS NOT DRAWN TO ACTUAL GRADE.
REFER TO FINAL GRADING PLAN.

It is the builder's complete responsibility to ensure that all plans submitted for approval fully comply with the Architectural Guidelines and all applicable regulations and requirements including zoning provisions and any provisions in the subdivision agreement. The Control Architect is not responsible in any way for examining or approving site (lotting) plans or working drawings with respect to any zoning or building code or permit matter or that any house can be properly built or located on its lot.

This is to certify that these plans comply with the applicable Architectural Design Guidelines approved by the City of HAMILTON

JOHN C. WILLIAMS LTD., ARCHITECT
ARCHITECTURAL, ENGINEERING
AND INTERIOR

APPROVED BY _____
DATE: SEP 21 2001

The undersigned, corporate officer or authorized
Design Professional and Seal on this
document, representing:

[illegible]

All drawings, specifications, related documents and design are the copyright property of VAS DESIGN. Reproduction of this property in whole or in part is strictly prohibited without VAS DESIGN's written permission.