


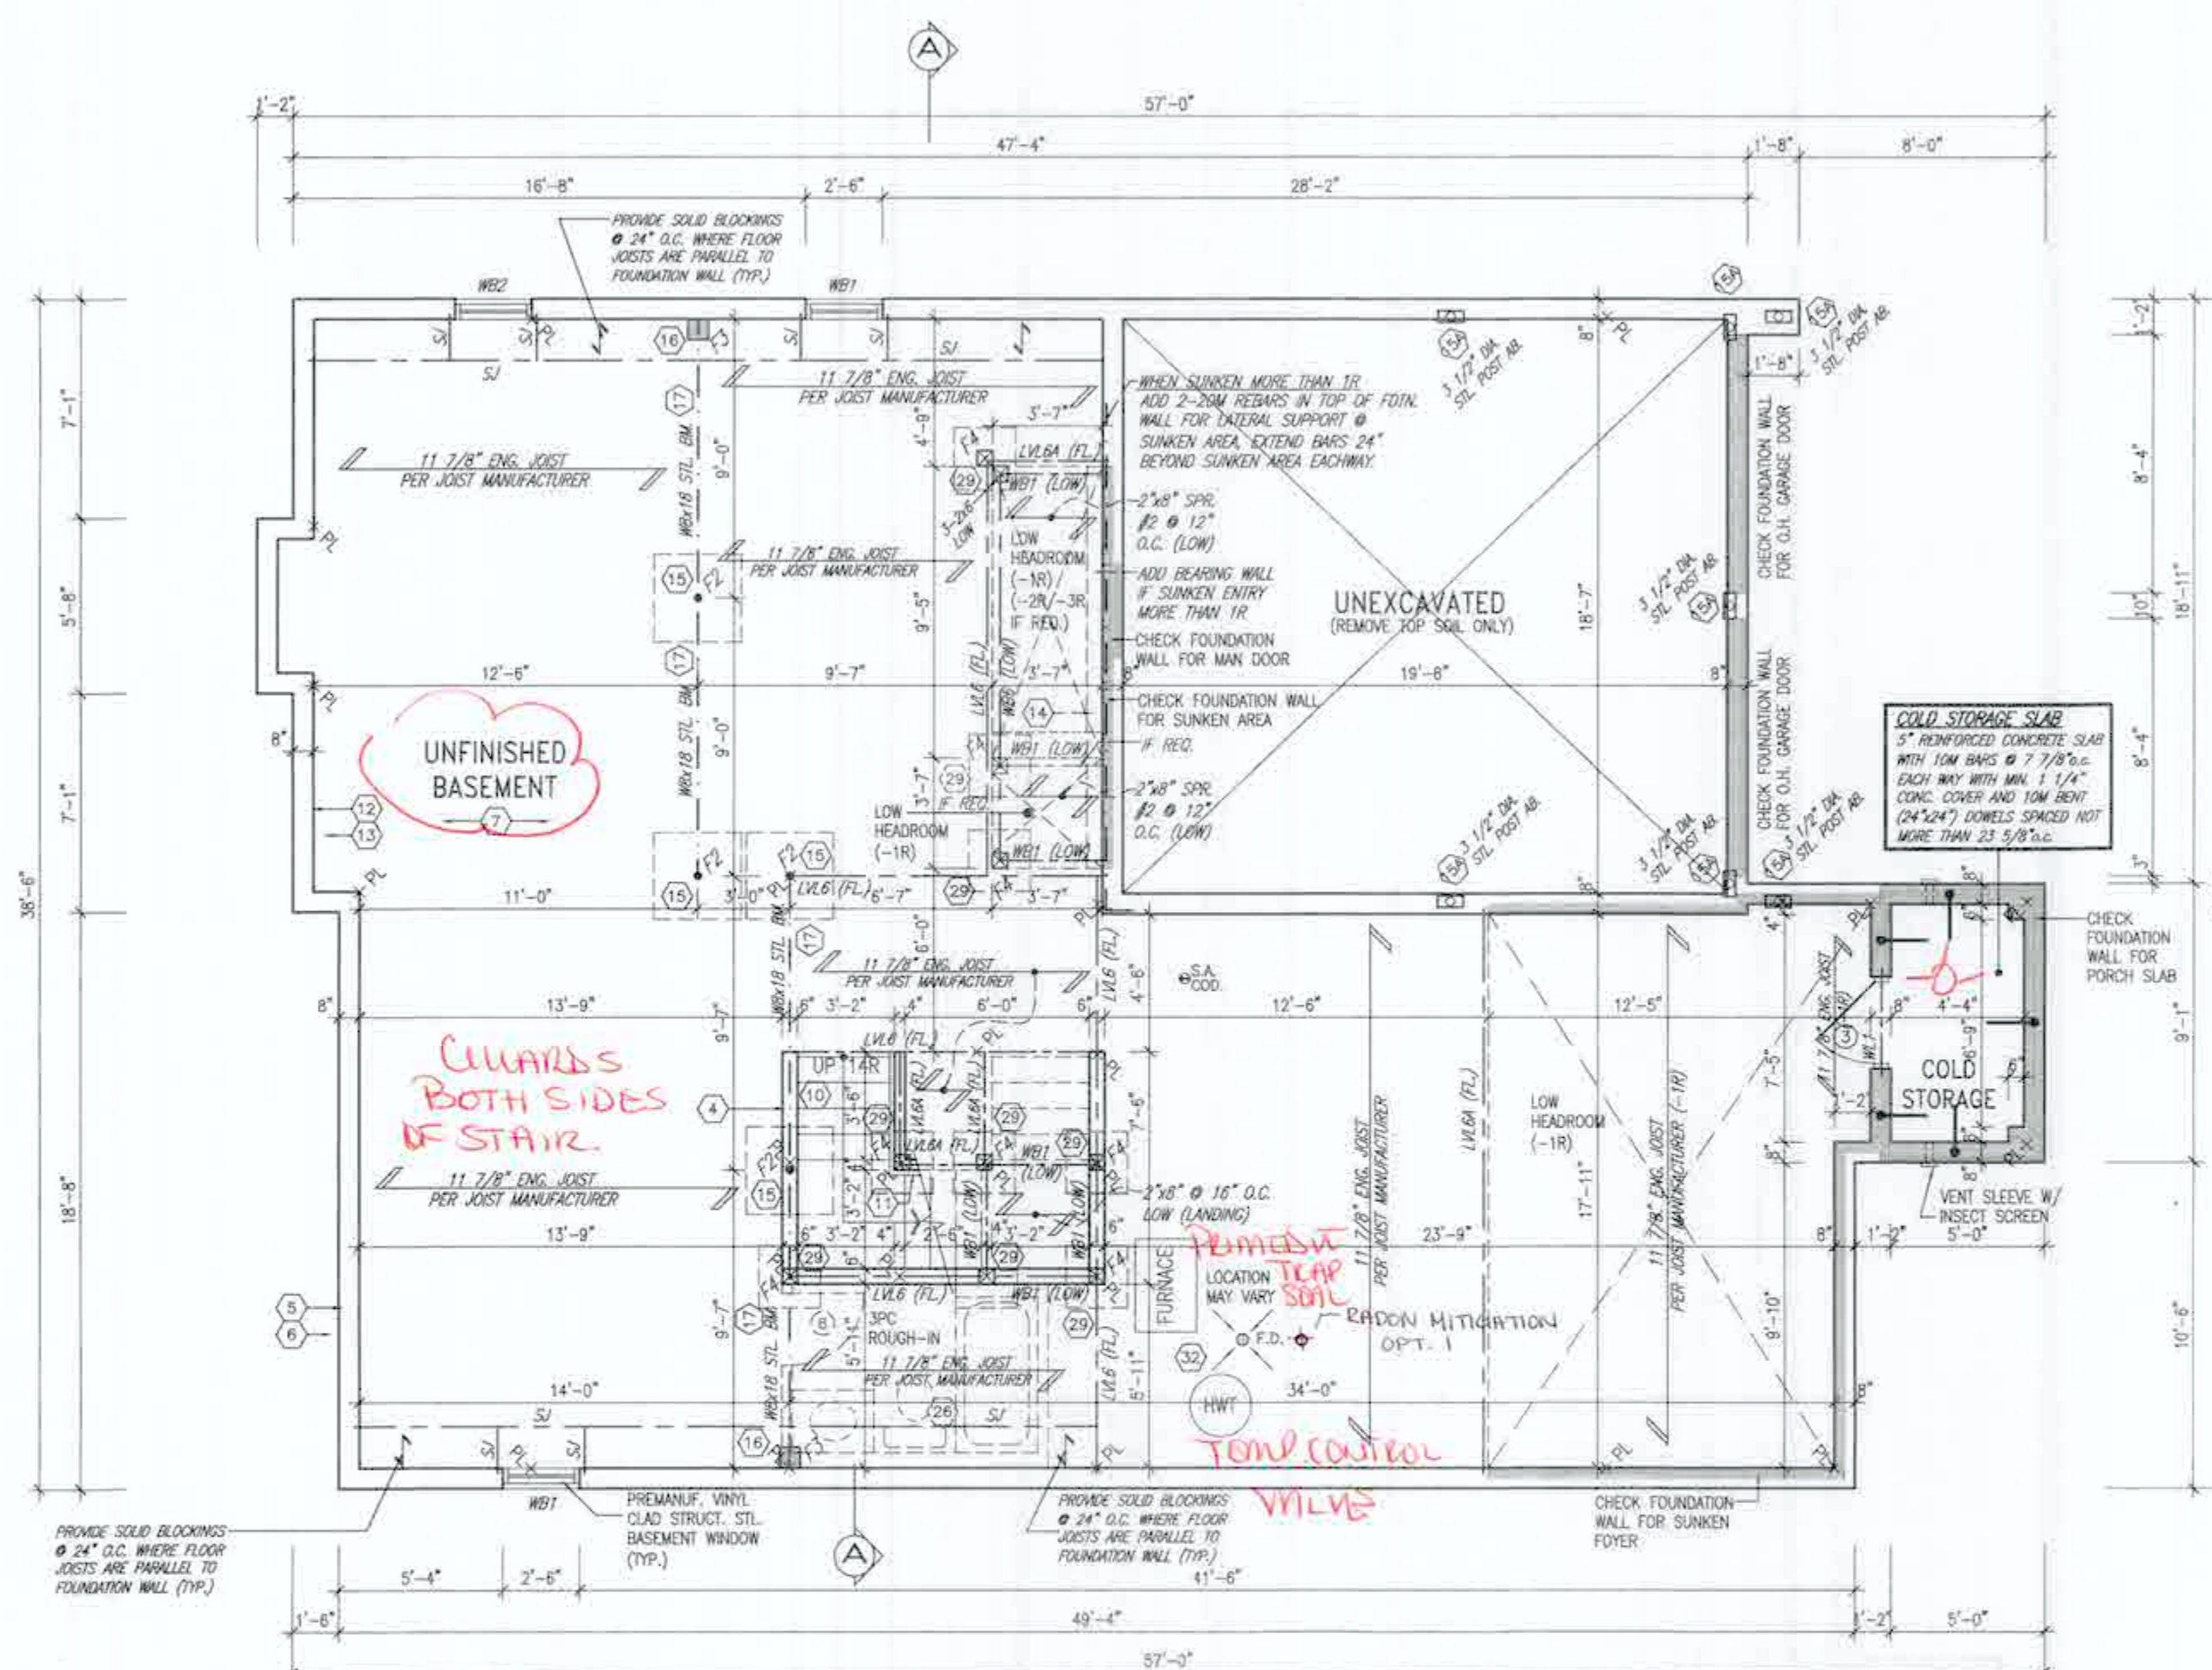

BASEMENT PLAN '1'

BASEMENT INSULATION AT
STAIR/SUNKEN AREAS
-2" (R10) CONTINUOUS INSULATION
(RIGID OR SPRAY FOAM).
-2"x4" @ 16" o.c. w/ R12 BATT
INSULATION & 1/2" DRYWALL FINISH.
-EXTEND EXTERIOR WALL FOOTING TO
SUPPORT 2"x4" WALL WHERE LOAD
BEARING.

BASEMENT WALL INSULATION
(TYP) 13
-6" (R20) CONTINUOUS BLANKET
INSULATION. INSULATION
UNINTERRUPTED BY FRAMING

It is the builder's complete responsibility to ensure that all plans submitted for approval fully comply with the Architectural Guidelines and all applicable regulations and requirements including zoning provisions and any provisions in the subdivision agreement. The Control Architect is not responsible in any way for examining or approving site (lotting) plans of working drawings with respect to any zoning or building code or permit matter or that any house can be properly built or located on the lot.

This is to certify that these plans comply with the applicable Architectural Design Guidelines approved by the City of HAMILTON

JOHN G. WILLIAMS LTD., ARCHITECTS
ARCHITECTURAL CONTROL SYSTEMS
AND SERVICES
DATE: APR 27 1987
This is a true and correct copy of the original as shown to the undersigned on the date above.
BY: JOHN G. WILLIAMS LTD.



STRUDET INC.
FOR STRUCTURE ONLY

21-16193a

Sm Jansz

SPRINGFIELD 1S
COMPLIANCE PACKAGE 'A1'

SPRINGFIELD 1
14.3m

Greenpark


VA3
DESIGN

project name	project location	project year
RUSSELL GARDENS PH. 4	HAMILTON, ON.	2002
date	drawing no.	
1004	BASEMENT PLAN - FLEV 5	

FEB. 2021 drawn by D. BURTON	checked by 	scale 3/16" = 1'-0"	title 20027-SPRINGFIELD-1S
---	--------------------	-------------------------------	--------------------------------------

161			9		The undersigned has reviewed and takes responsibility for this design and has the qualifications and meets the requirements set out in the Ontario Building Code to be a Designer.
171			8		
181			7		qualification information:
191			6		
201			5		Richards Vink 244
211			4		signature
221			3	ISSUED FOR PERMIT MAY 21/21	
231			2	REV. PER CLIENT/PROOF/TL/ENG. COMMENTS APR 26/21	regulatory information VAS Design Inc. 426
241			1	REVISED FOR CLIENT/ENG. & LUMBER MAR 31/21	
251			0	PRELIMINARY. ISSUED FOR CLIENT REVIEW MAR 12/21	Contractor must verify all dimensions on the job and report any discrepancy to the Designer before proceeding with the work. All drawings and specifications are preliminary of service and the approval of the Designer, which must be returned at the completion of the design. One set to be maintained by the Designer.
261	Association	Address	City	Province	

All design specifications, initial documents and design are the confidential property of VAI DESIGN. Reproduction of this property in whole or in part is strictly prohibited without VAI DESIGN's written permission.

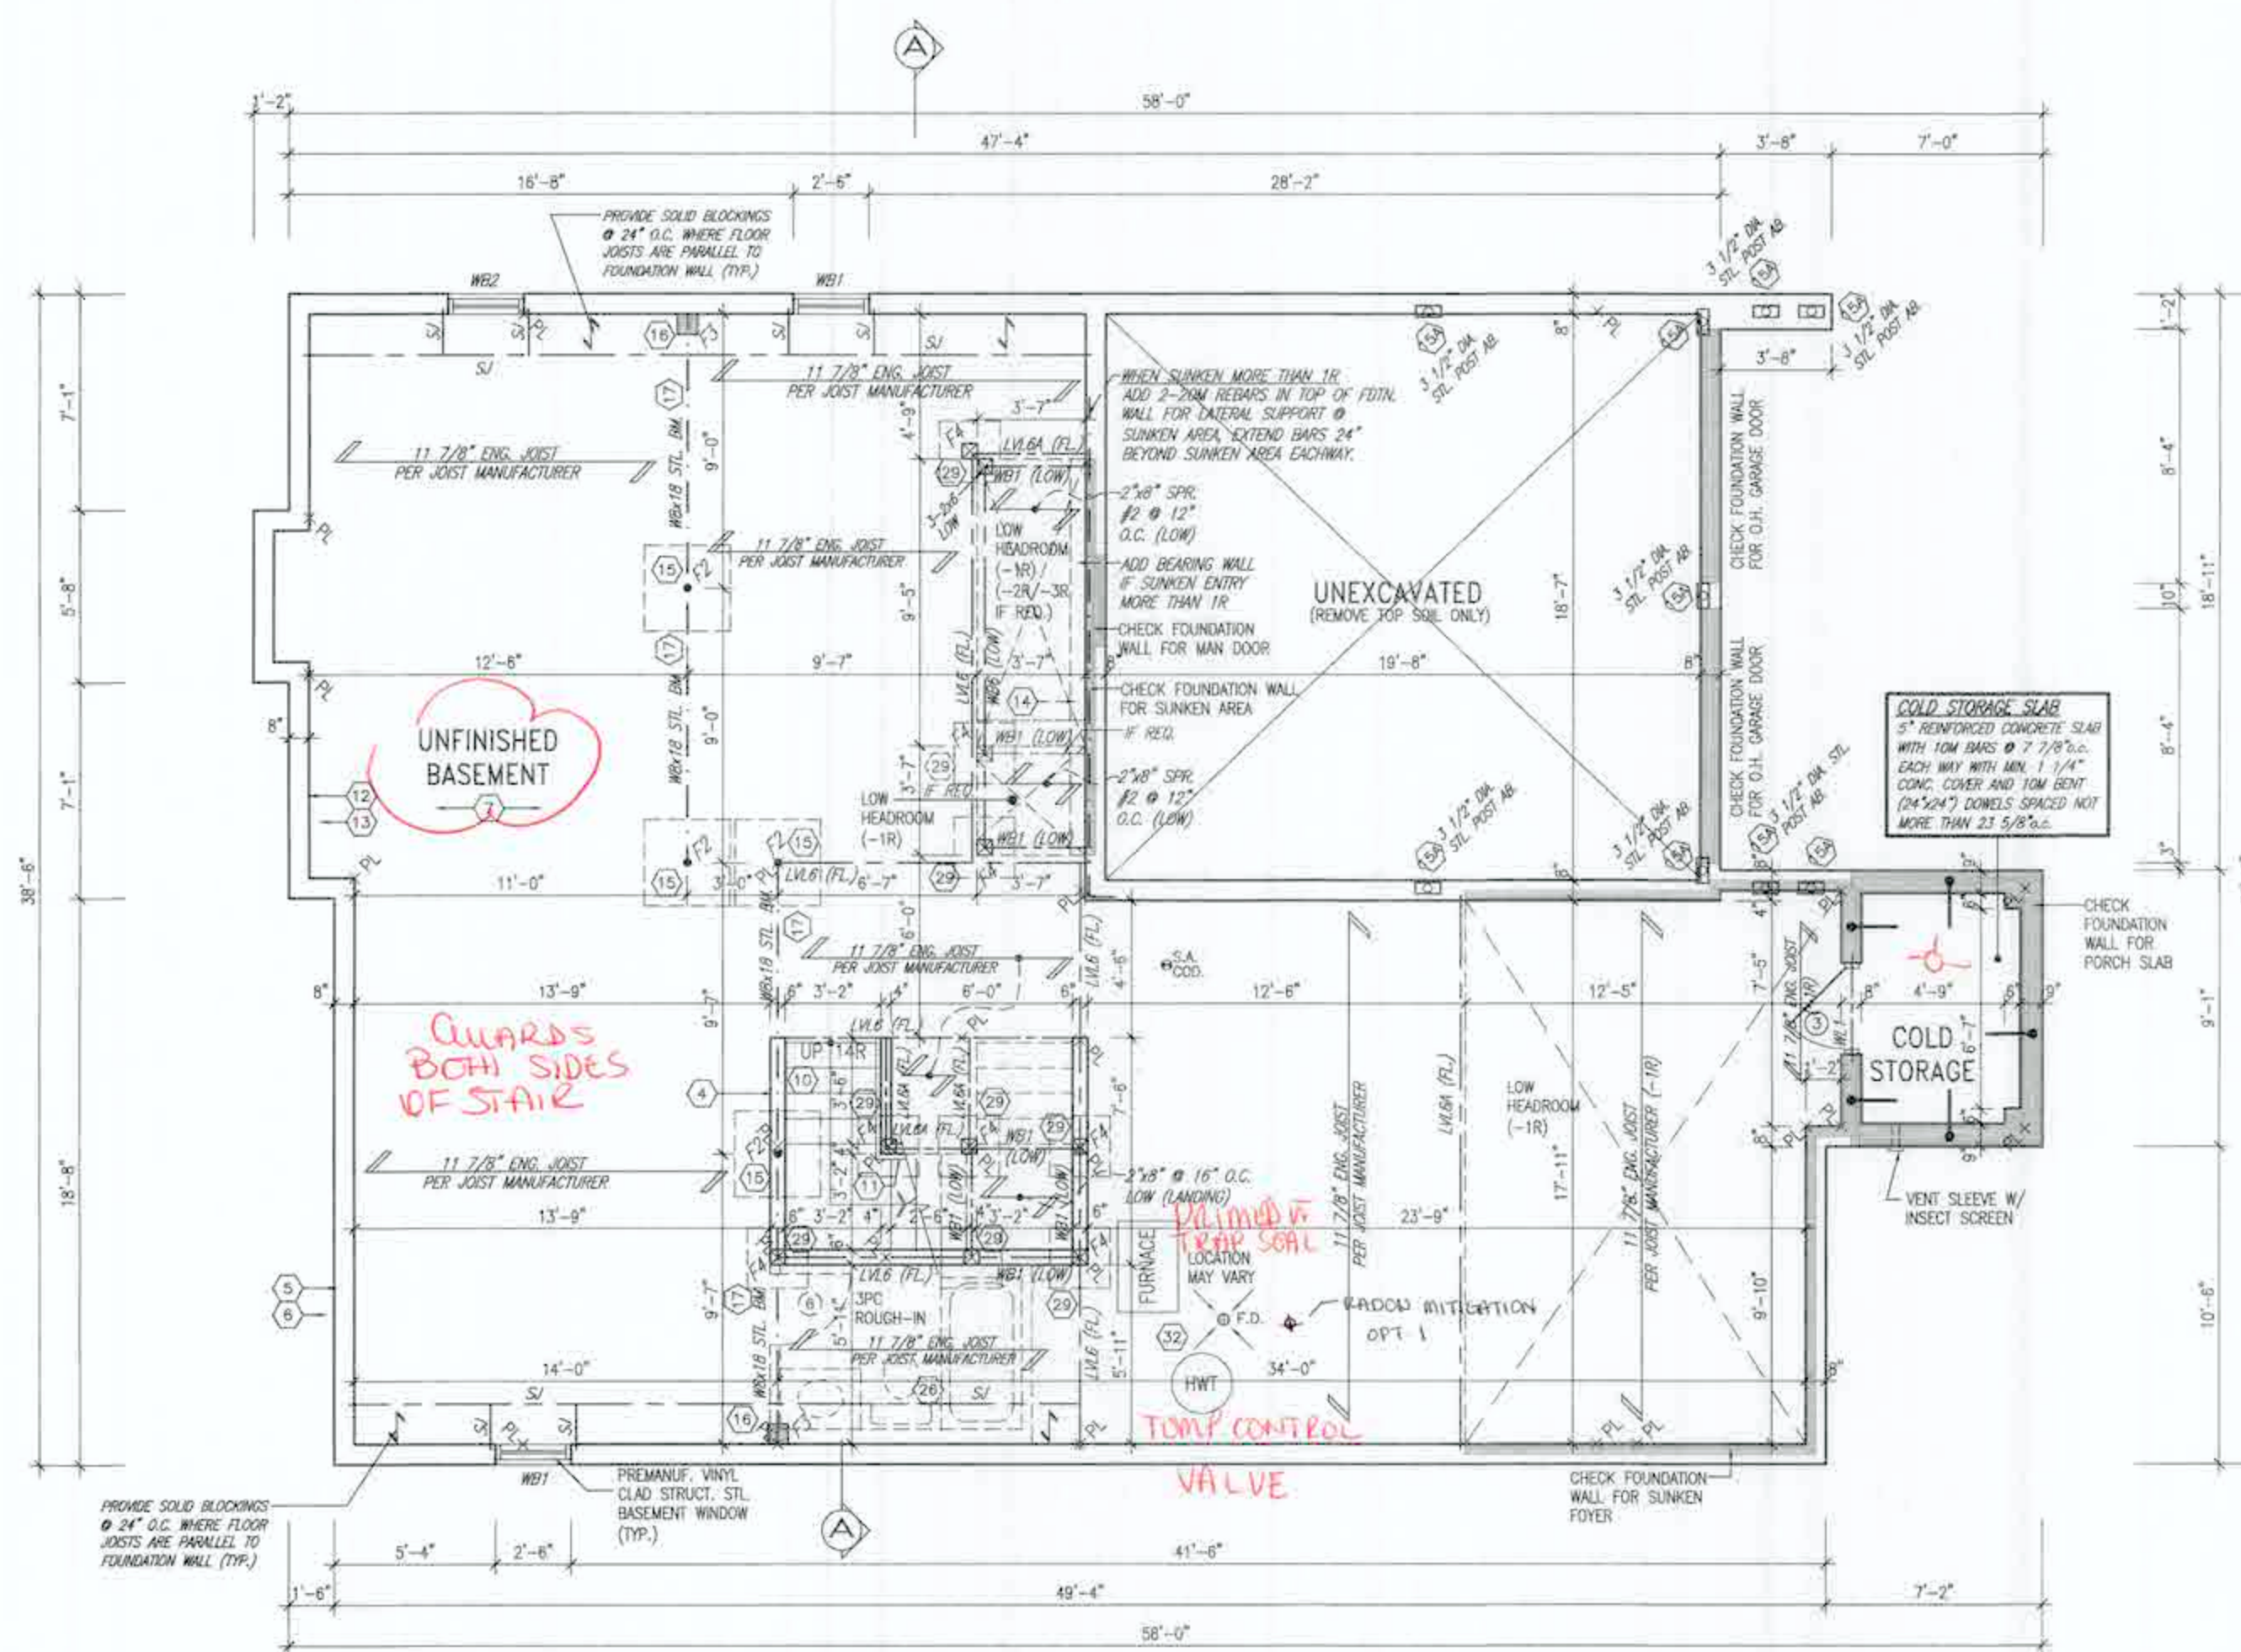

BASEMENT PLAN '2'

**BASEMENT INSULATION AT
STAIR/SUNKEN AREAS**
-2" (R10) CONTINUOUS INSULATION
(RGIO or SPRAY FOAM).
-2"x4" @ 16"o.c. w/ R12 BATT
INSULATION & 1/2" DRYWALL FINISH
-EXTEND EXTERIOR WALL FOOTING TO
SUPPORT 2"x4" WALL WHERE LOAD
BEARING.

BASEMENT WALL INSULATION
(TYP) 13
-6" (R20) CONTINUOUS BLANKET
INSULATION. INSULATION
UNINTERRUPTED BY FRAMING

It is the builder's complete responsibility to ensure that all plans submitted for approval fully comply with the Architectural Guidelines and all applicable regulations and requirements including zoning provisions and any provisions in the subdivision agreement. The Control Architect is not responsible in any way for examining or approving site (lotting) plans or working drawings with respect to any zoning or building code or permit matter or that any house can be properly built or located on its lot.

This is to certify that these plans comply with the applicable Architectural Design Guidelines approved by the City of HAMILTON


JOHN G. WHITMAN LTD., ARCHITECT
ARCHITECTURAL CENTER BUILDING
7000 WILSON BLVD.
ANN ARBOR, MI 48106-1500
TEL: 734/769-1000 FAX: 734/769-1001
WWW.JGWHITMAN.COM



STRUDET INC.
FOR STRUCTURE ONLY

[illegible]

All mission visualizations, related documents and design are the copyright property of NASA DSOCS. Redistribution of this property is made in its full and is strictly prohibited without NASA DSOCS's written permission.

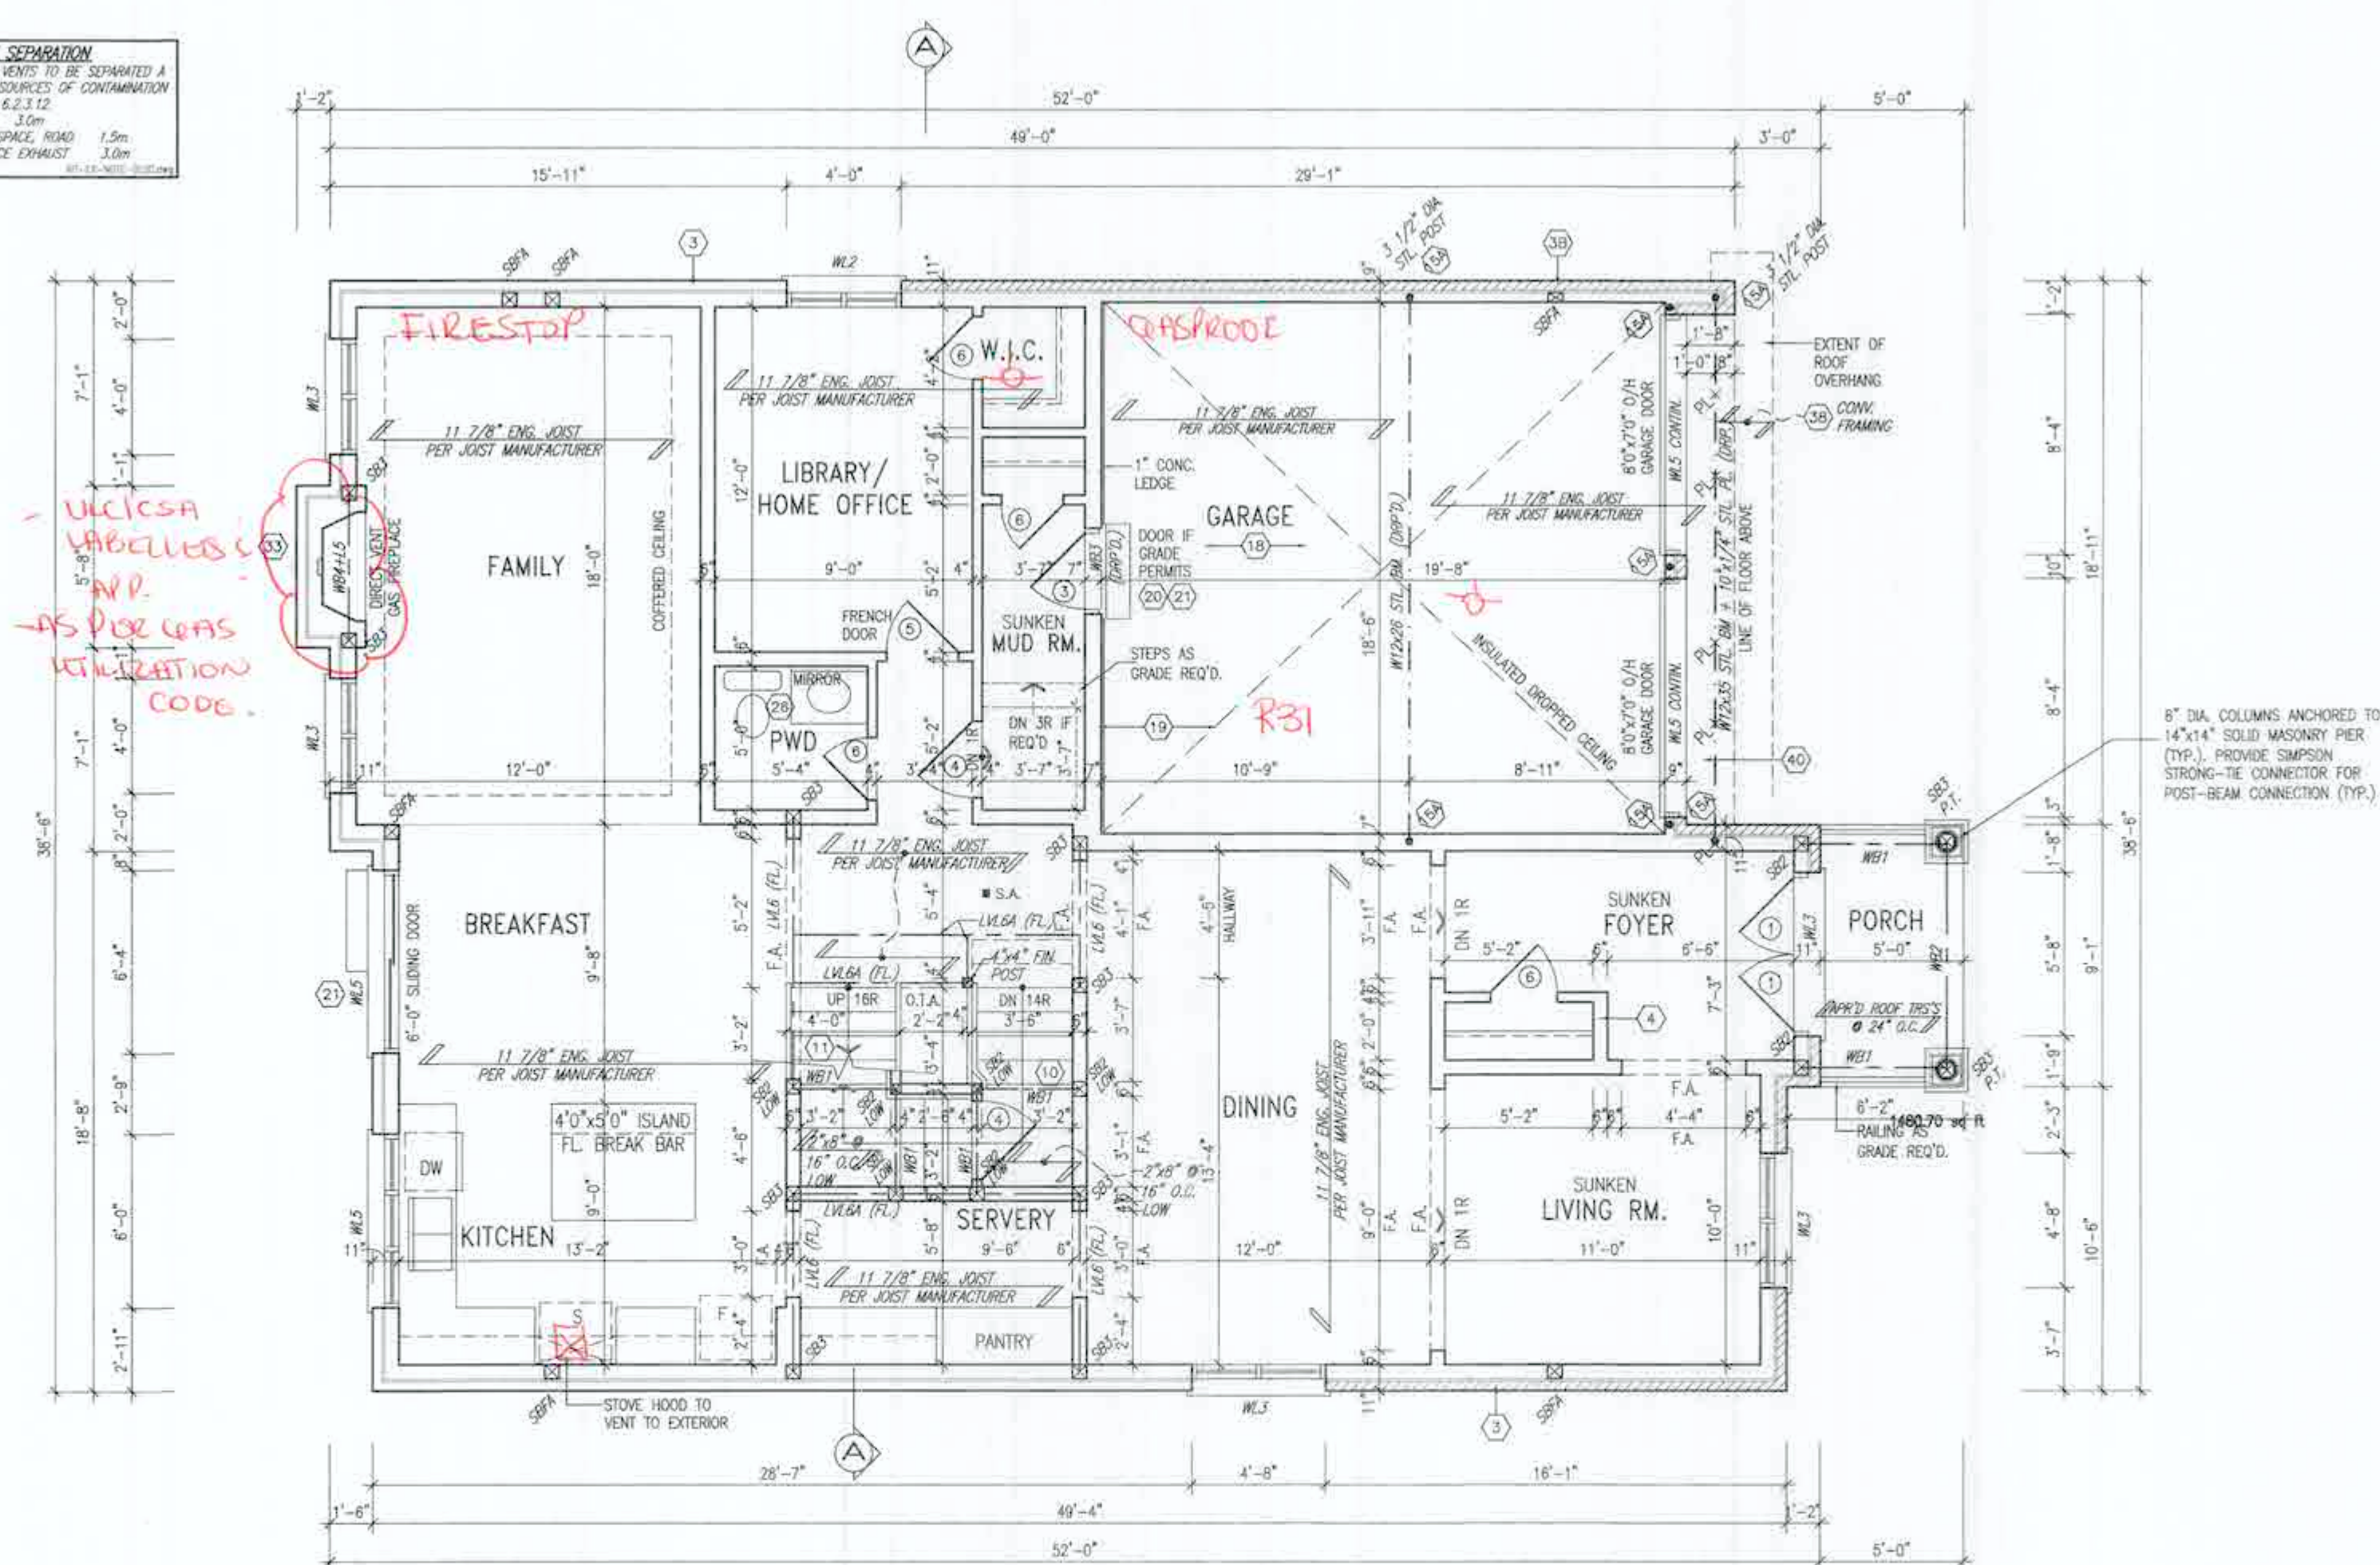

It is the builder's complete responsibility to ensure that all plans submitted for approval fully comply with the Architectural Guidelines and all applicable regulations and requirements including zoning provisions and any provisions in the subdivision agreement. The Control Architect is not responsible in any way for examining or approving site (polling) plans or working drawings with respect to any zoning or building code or permit matter or that any house can be properly built or located on its lot.

This is to certify that these plans comply with the applicable Architectural Design Guidelines approved by the City of HAMILTON.



JOHN G. WILLIAMS LTD., ARCHITECT
ARCHITECTURAL CONSULTANTS
AND ENGINEERS
CORPORATED IN
DATE AUG 27 1974
The above contract documents with all amendments
therein shall be the basis of the contract between the
owner and the contractor.

18	-	9	-	-	The undersigned has reviewed and takes responsibility for this design and for the qualifications and meets the requirements set out in the Ontario Building Code to be a Designer.
17	-	8	-	-	qualification information
16	-	7	-	-	Richard Yink
15	-	6	-	-	signature
14	-	5	-	-	42
13	-	4	ISSUED FOR PERMIT.	MAY 21/21	ON
12	-	3	REV. PER CLIENT/PROF./LNG. COMMENTS	APR 28/21	ON
11	-	2	REVISED PER CLIENT/ENG. & LUMBER	MAR. 31/21	ON
10	-	1	PRELIMINARY ISSUED FOR CLIENT REVIEW	MAR. 12/21	ON
9	description	date	by	date	by



Greenpark

SPRINGFIELD 1
14-3m


project name: **RUSSELL GARDENS PH. 4** municipality: **HAMILTON, ON.** project #: **2002**

date: **FEB. 2021**

drawn by: **D. BURTON** checked by: **[signature]** scale: **3/16" = 1'-0"**

sheet no.: **2002-SPRINGFIELD-15** drawing no.: **A2**

A2

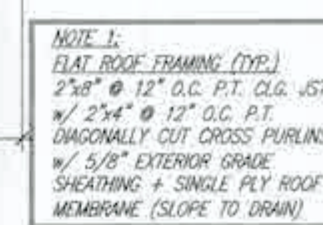

21-161939

Jim van der

JOHN G. WILLIAMS LTD., ARCHITECT
ARCHITECTURAL CONTROL, REVIEW
AND APPROVAL

APPROVED BY: 
DATE: 10/17/2007

This being a limited corporation and its representative
John G. Williams Ltd., not being a partner
in the above corporation.

18				9	The undersigned has reviewed and takes responsibility for this design.
17				8	and lists the qualifications and meets the requirements set out in the
16				7	Ordering Guidebook to be a Designer.
15				6	qualifications information.
14				5	Richard Vink
13				4	signature
12				3	Registration Information
11				2	VAS Design Inc.
10				1	conductor must verify all dimensions on the job and report any discrepancy to the Designer before proceeding with the work. All drawings and specifications are instruments of service and the property of the Designer which must be returned at the completion of the project. Drawings are not to be altered.
9	no.	description	date	by no.	description
8	3	REV. PER CLIENT/ROOF/F/L/ENG. COMMENTS	MAY 21/21	GW	
7	2	REVISED PER CLIENT/ENG. & LUMBER	MAR. 31/21	GW	
6	1	PRELIMINARY ISSUED FOR CLIENT REVIEW	MAR. 12/21	GW	



DESIGN
255 Consumers Rd Suite
Toronto ON M2J 1R4
416.630.2255 / 416.630.
vo3design.com



Greenpark.

SPRINGFIELD 1
14.3m


PROJECT NAME	MUNICIPALITY	PROJECT YEAR
RUSSELL GARDENS PH. 4	HAMILTON, ON.	2002

FEB. 2021
 drawn by
 D. BURTON
 checked by
 3/16" = 1'-0"
 20027-SPRINGFIELD-15
 drawing no.
 A2a

[illegible]

All drawings, specifications, printed documents and design are the copyright property of VAI DESIGN. Reproduction in whole or in part is strictly prohibited without VAI DESIGN's written permission.

NOTE: 3- CANOPY FLAT ROOF CONSTRUCTION
ONE PLY WATERPROOF MEMBRANE (DURADEK) ADHERE
TO EXT. TYPE 5/8" T&G PLYWOOD SHEATHING OVER
2"x6" FRAMING OVER ENGINEERED FLOOR JOISTS.
SLOPE TO EXTERIOR WITH WOOD SLEEPERS. PREFIN.
METAL CAP & FLASHING (WITH DRIP EDGE). EXTERIOR
FINISH AND HEIGHT PER UNIT DIMS.

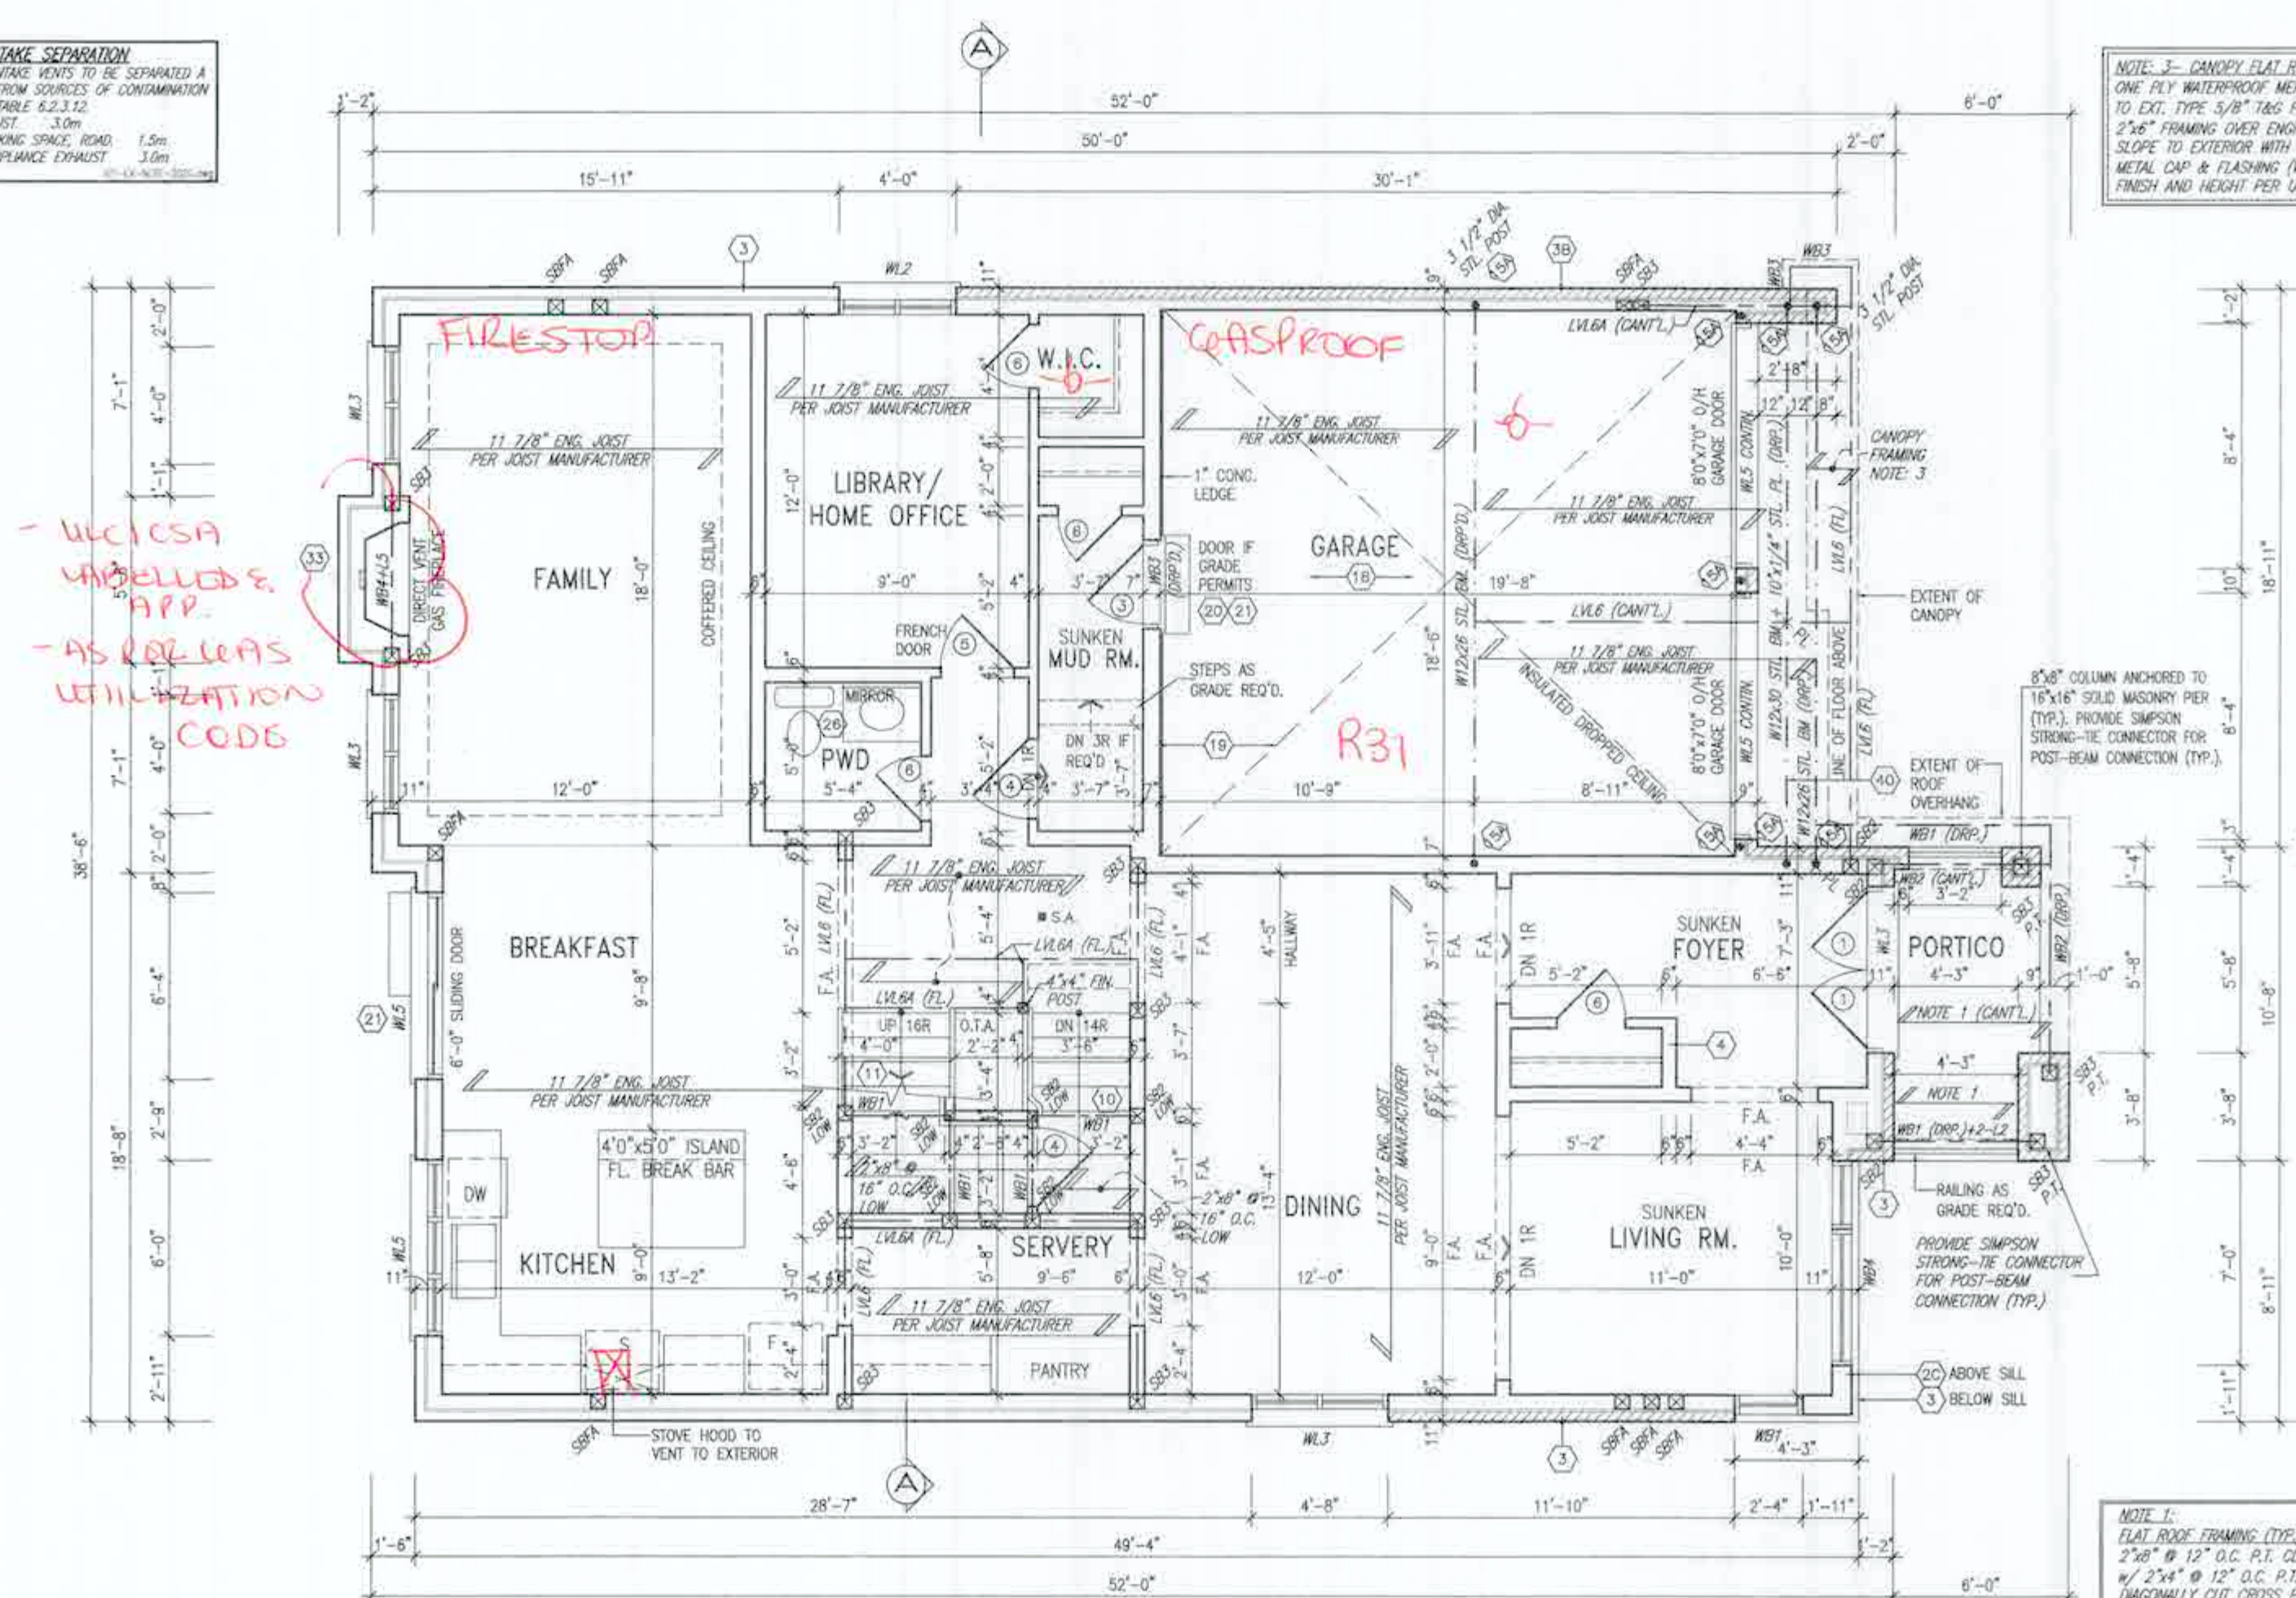

NOTE 1:
FLAT ROOF FRAMING (TYPE)
2"x8" @ 12" O.C. P.T. CLG. JS
w/ 2"x4" @ 12" O.C. P.T.
DIAGONALLY CUT CROSS PURLIN
w/ 5/8" EXTERIOR GRADE
SHEATHING + SINGLE PLY ROOF
MEMBRANE (SLOPE TO DRAIN)

21-11-1930

Sm Jan 5/22

It is the builder's complete responsibility to ensure that all plans submitted for approval fully comply with the Architectural Guidelines and all applicable regulations and requirements including zoning provisions and any provisions in the subdivision agreement. The Control Architect is not responsible in any way for constraints or approving any (lotting) plans or working drawings with respect to any zoning or building code or permit matter or that any house can be properly built or located on its lot.

This is to certify that these plans comply with the applicable Architectural Design Guidelines approved by the City of HAMILTON

JOHN G. WILLIAMS LTD., ARCHITECT
INCORPORATED, CONTROL SYSTEMS
100 W. 42ND ST.
NEW YORK, N.Y. 10018
TELEPHONE: (212) 691-1100
FAX: (212) 691-1101
CIRCLE 10 ON READER SERVICE CARD




STRUDET INC.
FOR STRUCTURE ONLY

[illegible]

All drawings, specifications, related documents and design are the copyright property of V&S DESIGN. Reproduction of this property is stricty prohibited without V&S DESIGN's written consent.

All drawings, specifications, related documents and design are the copyright property of VAI DESIGN. Reproduction of this property in whole or in part is strictly prohibited without VAI DESIGN's written permission.

GRAB BAR NOTE:
STUD WALL REINFORCEMENT FOR FUTURE GRAB BARS IN MAIN BATHROOM
 REINFORCEMENT OF STUD WALLS SHALL BE INSTALLED ADJACENT TO WATER CLOSETS AND SHOWER OR BATHUB IN MAIN BATHROOM PER UBC, DIV. 8-6.5.2.3. REFER TO FOLLOWING SECTIONS FOR THE FUTURES LISTED: WATER CLOSET, 3.8.3.8.(3)(a) & 3.8.3.8.(3)(c); SHOWER, 3.8.3.13.(2)(a); BATHUB, 3.8.3.13.(4)(a). FREE STANDING BATHUB EXCLUDED. SEE DETAILS PROVIDED.

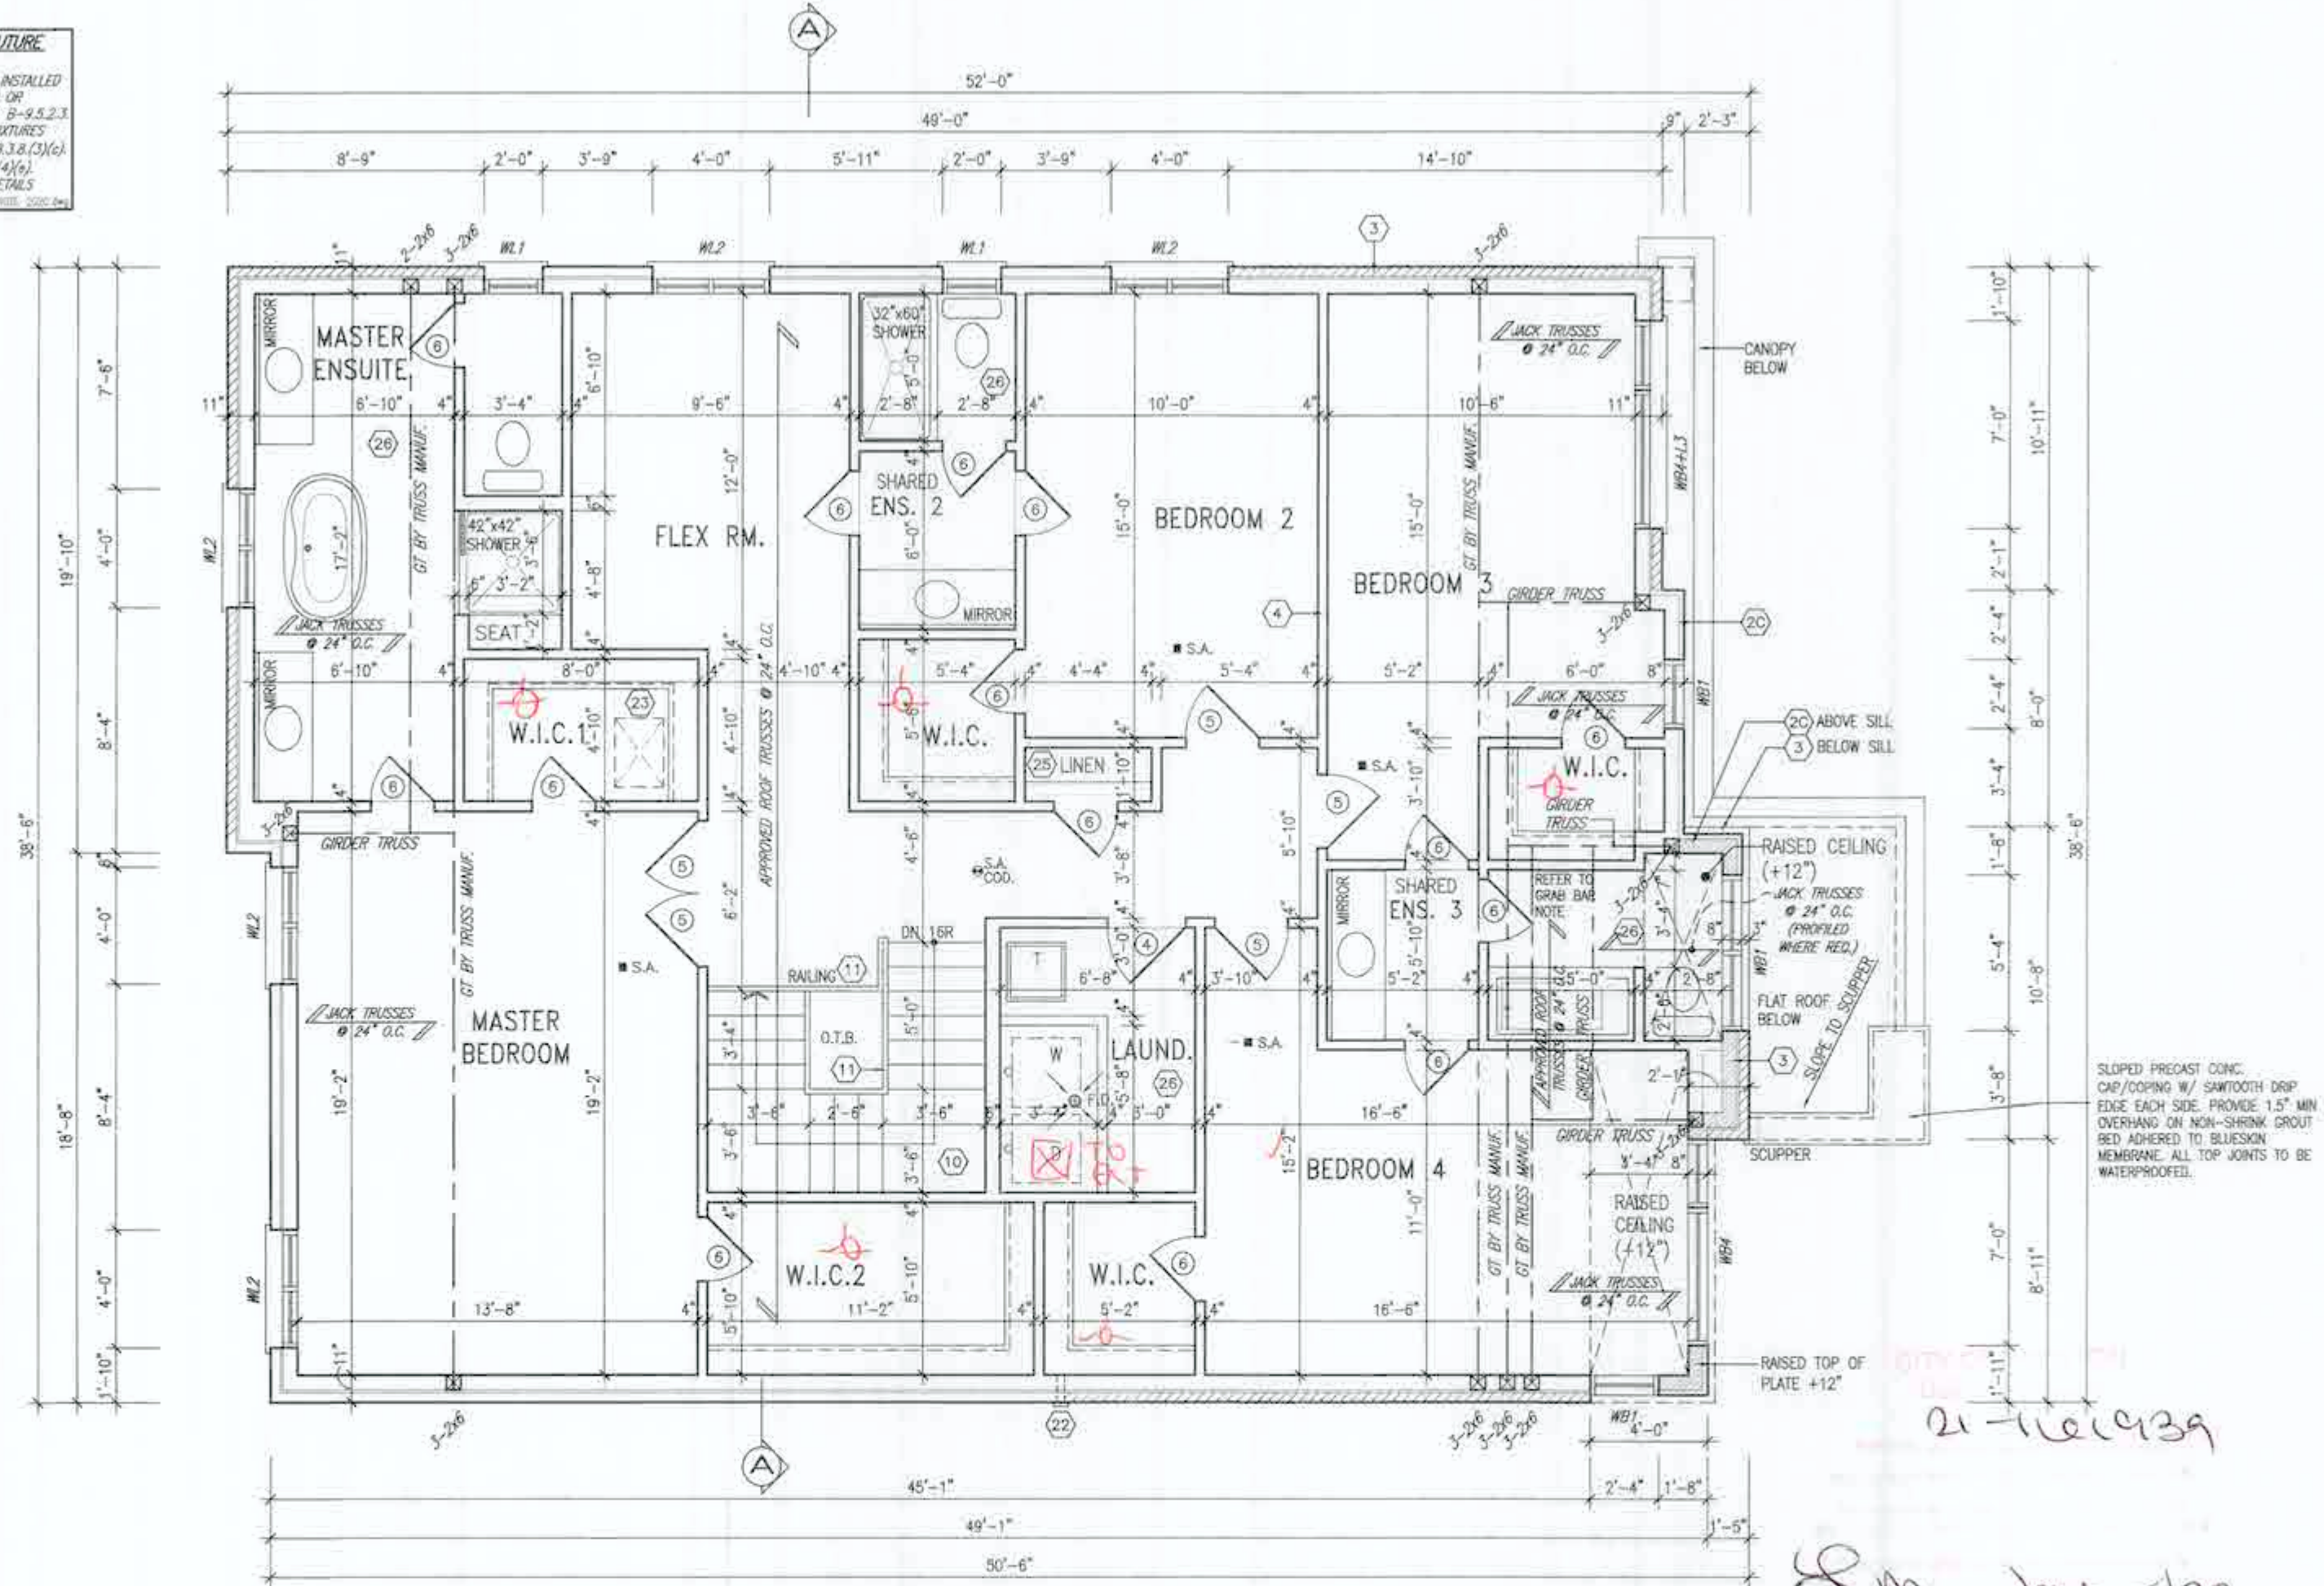

SECOND FLOOR PLAN '3'

It is the builder's complete responsibility to ensure that all plans submitted for approval fully comply with the Architectural Guidelines and all applicable regulations and requirements including zoning provisions and any provisions in the subdivision agreement. The Control Architect is not responsible in any way for reviewing or approving any (existing) plans or working drawings with respect to any zoning or building code or permit matter or that any house can be properly built or located on its lot.

This is to certify that these plans comply with the applicable Architectural Design Guidelines approved by the City of Hamilton.

JOHN C. WILLIAMS LTD., ARCHITECT
 ARCHITECTURAL CONTROL NUMBER
 20027-SPRINGFIELD-15
 14.3m



STRUDET INC.
 FOR STRUCTURE ONLY


no.	description	date	by	no.	description	date	by
18				5			
17				6			
16				7			
15				8			
14				9			
13				10			
12				11			
11				12			
10				13			
9				14			
8				15			
7				16			
6				17			
5				18			

The undersigned has reviewed and taken responsibility for this design and has the qualifications and meets the requirements set out in the Ontario Building Code to be a Designer.
 qualification information
 Richard Vink 24488
 registration information
 VAS Design Inc. 42658

VA3 DESIGN
 250 Consumers Rd Suite 120
 Toronto, ON M2J 1P4
 1.416.630.2255 / 1.416.630.4782
 info@va3design.com


Greenpark.
 project name
 RUSSELL GARDENS PH. 4
 location
 HAMILTON, ON.
 date
 FEB. 2021
 drawn by
 D. BURTON
 checked by
 3/16" = 1'-0"

SPRINGFIELD 1
 14.3m
 project no.
 20027
 drawing no.
 A3b
 SECOND FLOOR PLAN - ELEV. 3

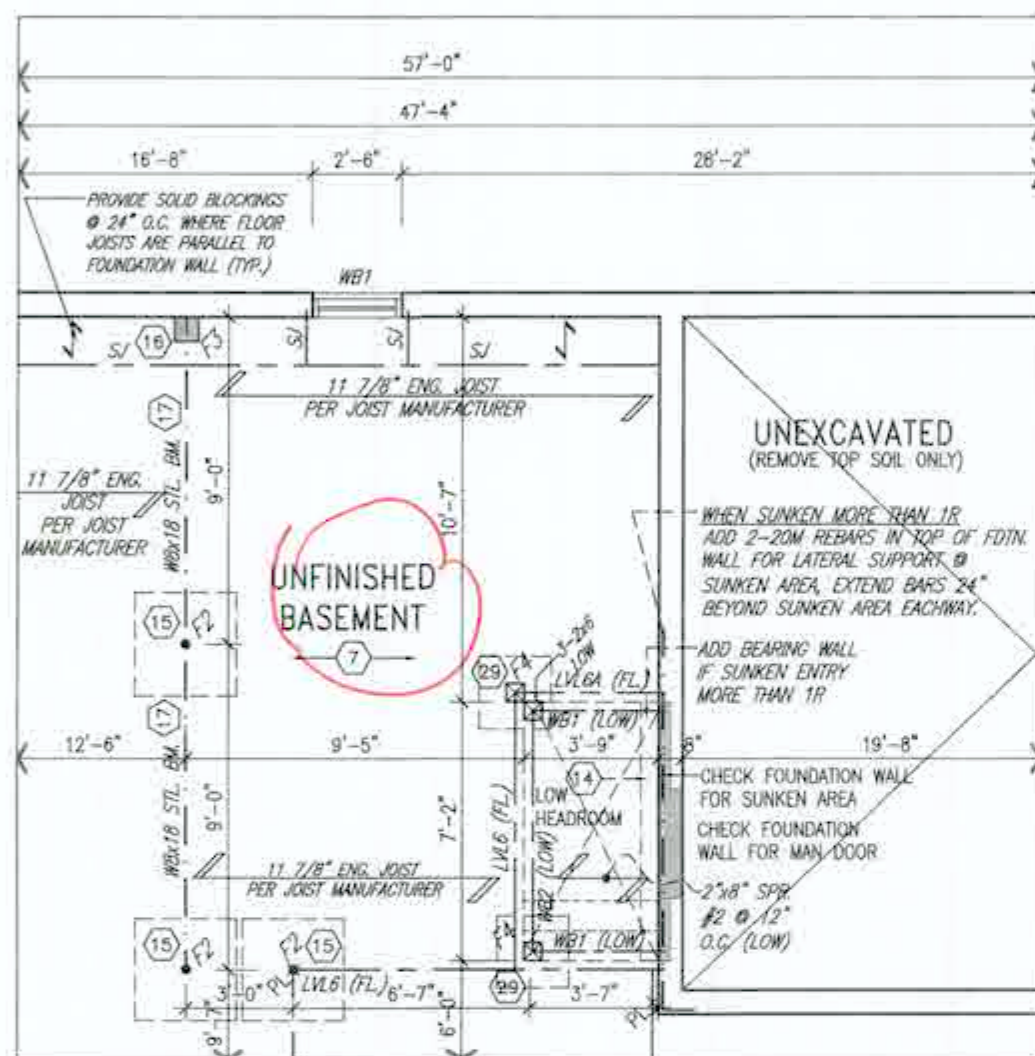


PARTIAL BASEMENT PLAN '1'
W/ OPTIONAL GUEST SUITE

NOTE:
REFER TO STANDARD FLOOR PLANS
FOR ADDITIONAL INFORMATION.

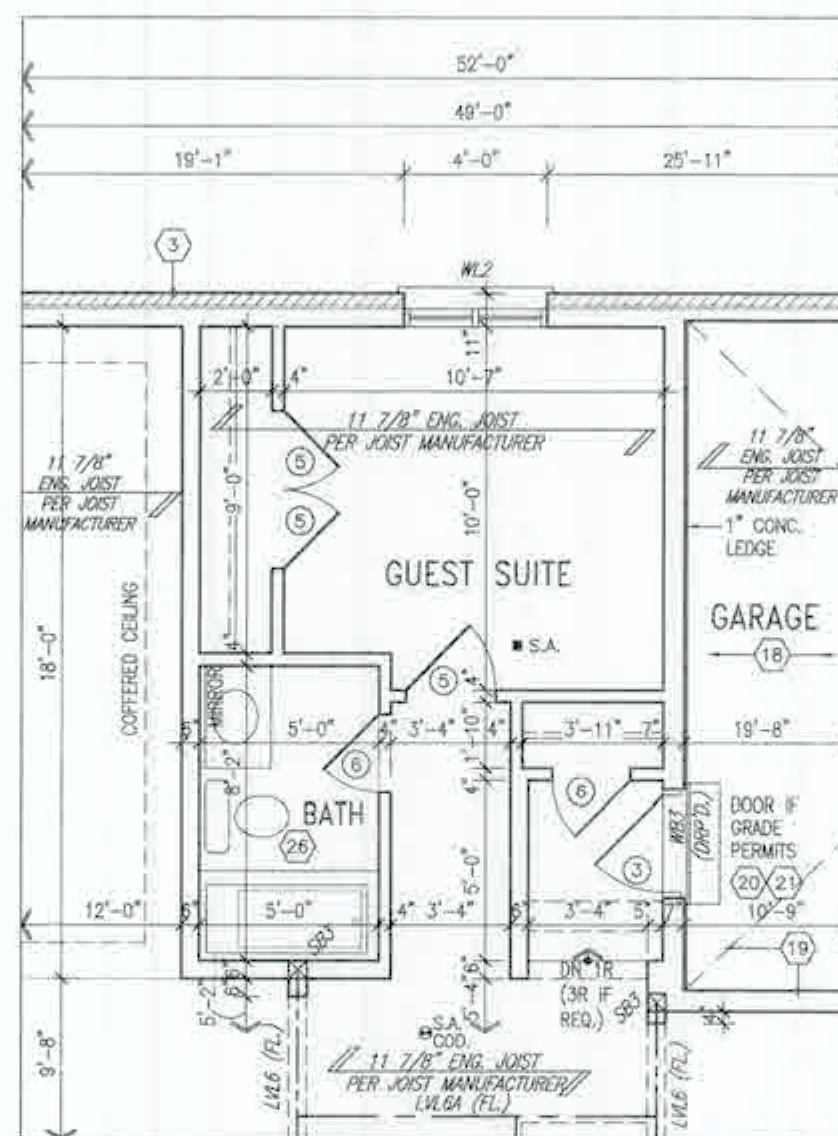

PARTIAL GROUND FLOOR PLAN '1'
W/ OPTIONAL GUEST SUITE

NOTE:
REFER TO STANDARD FLOOR PLANS
FOR ADDITIONAL INFORMATION.

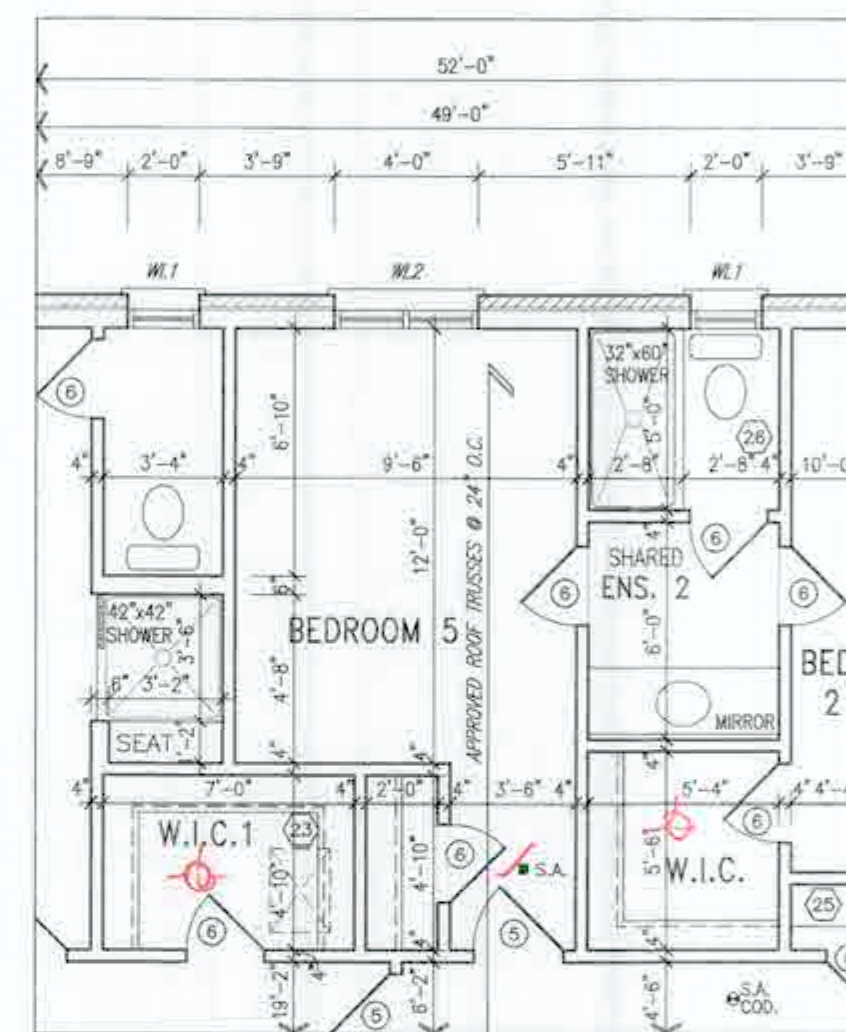

PARTIAL SECOND FLOOR PLAN '1'
W/ OPTIONAL 5 BEDROOM

NOTE:
REFER TO STANDARD FLOOR PLANS
FOR ADDITIONAL INFORMATION.

It is the builder's complete responsibility to ensure that all plans submitted for approval fully comply with the Architectural Guidelines and all applicable regulations and requirements including zoning provisions and any provisions in the subdivision agreement. The Control Architect is not responsible in any way for loanmaking or approving site (lotting) plans or working drawings with respect to any zoning or building code or permit matter or that any house can be properly built or located on its lot.

This is to certify that these plans comply with the applicable Architectural Design Guidelines approved by the City of HAMILTON


JOHN C. WILLIAMS, III, ARCHITECT
ARCHITECTURAL CONTROL BOARD
JAW-00000000
DATE: AUG 22, 2002
THE DATE OF THIS DOCUMENT IS THE DATE OF THE
ISSUANCE OF THE ARCHITECTURAL CONTROL BOARD
CERTIFICATE OF REGISTRATION.



MAY 20 2021
STRUDET INC.
FOR STRUCTURE ONLY


18		19		20		1051		
----	--	----	--	-----	--	-----	--	------	--	------	--	--

All drawings, specifications, related documents and design are the copyright property of VAO (ESON). Reproduction of this property in whole or in part is strictly prohibited without VAO (ESON)'s written permission.

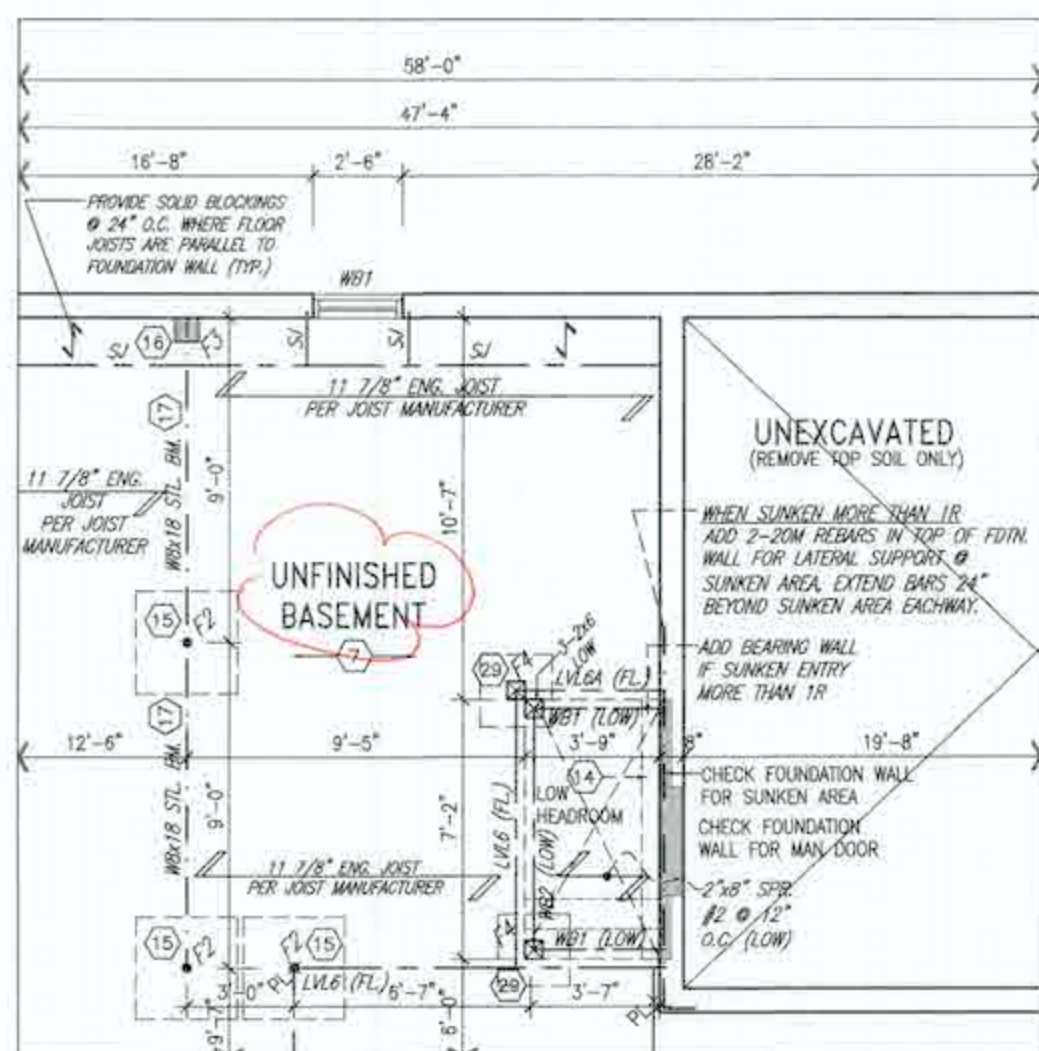


PARTIAL BASEMENT PLAN '3'
W/ OPTIONAL GUEST SUITE

NOTE:
REFER TO STANDARD FLOOR PLANS
FOR ADDITIONAL INFORMATION.

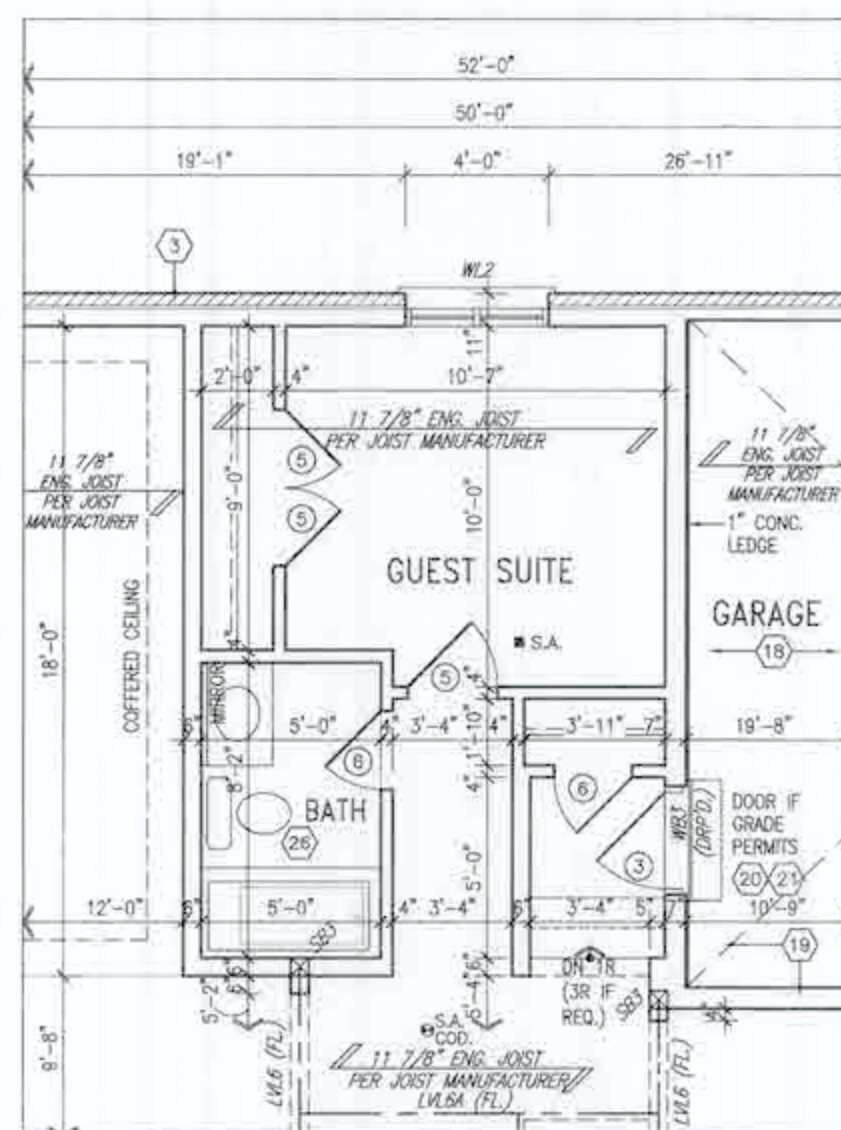

PARTIAL GROUND FLOOR PLAN '3'
W/ OPTIONAL GUEST SUITE

NOTE:
REFER TO STANDARD FLOOR PLANS
FOR ADDITIONAL INFORMATION.

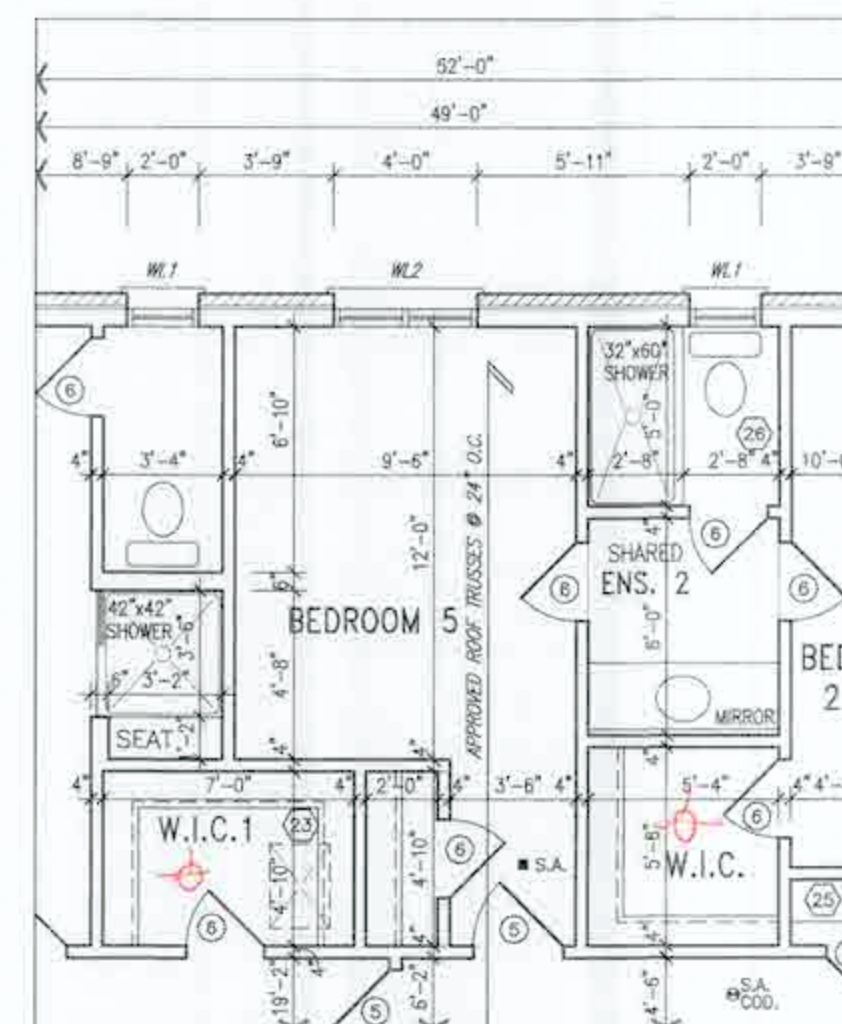

PARTIAL SECOND FLOOR PLAN '3'
W/ OPTIONAL 5 BEDROOM

NOTE:
REFER TO STANDARD FLOOR PLANS
FOR ADDITIONAL INFORMATION.

21-141939

Sm Jan 5/27

It is the builder's complete responsibility to ensure that all plans submitted for approval fully comply with the Architectural Guidelines and all applicable regulations and requirements including zoning provisions and any provisions in the subdivision agreement. The Control Architect is not responsible in any way for examining or approving site (lotting) plans or working drawings with respect to any zoning or building code or permit matter or that any house can be properly built or located on its lot.

This is to certify that these plans comply with the applicable Architectural Design Guidelines approved by the City of HAMILTON



MAY 26/202

STRUDET INC.
FOR STRUCTURE ONLY.

18		3		3	The undersigned has reviewed and taken responsibility for this design and has the qualifications and meets the requirements set out in § 16-102 of the Design Law.
17		6		6	Outside Building Code to be a Designer.
16		7		7	Qualification Information
15		8		8	Richard Vink
14		9		9	Signature
13		10		10	Signature
12		11		11	Signature
11		12		12	Signature
10		13		13	Signature
9		14		14	Signature
8		15		15	Signature
7		16		16	Signature
6		17		17	Signature
5		18		18	Signature
4		19		19	Signature
3		20		20	Signature
2		21		21	Signature
1		22		22	Signature

The undersigned has reviewed and takes responsibility for this design and has the qualifications and meets the requirements set out in the Ontario Building Code to be a Designer.

qualifications information

Richard Vink 24

name signature

registration information

VA3 Design Inc. 42

Contractor must verify all dimensions on the job and report any discrepancy to the Designer before proceeding with the work. All drawings and specifications are instruments of service and the property of the Designer which must be returned at the completion of the work. Drawings are not to be copied.



255 Consumers Rd. Suite 12
Toronto, ON M2J 1R4
1 416.630.2255 | 416.630.47
vo3design.com

Greenpark

SPRINGFIELD 1
14.3m

project name
RUSSELL GARDENS PH. 4

municipality
HAMILTON, ON.

project area
2002

date
FEB. 2021

drawing no.
0

optional partial plans '3'

drawn by
D.BURTON

checked by
3/16/21

scale
1"=0'

file name
2002-SPRINGFIELD-1S

drawing no.
A4b

SPRINGFIELD 1S
COMPLIANCE PACKAGE 'A1'

All machine specifications, related documents and design are the copyright property of VAX DESIGN. Reproduction of this property in whole or in part is strictly prohibited without VAX DESIGN's written permission.

Architectural drawing of the front elevation of a two-story house. The drawing includes detailed dimensions, material specifications, and structural notes.

Dimensions:

- Overall width: 25'-10" [7.87M]
- Overall height: 10'-1" (to top of transom)
- Roof pitch: 6:12 (main), 10:12 (gables)
- Window heights: 7'-6" (second floor), 5'-0" (first floor)
- Garage door height: 7'-10" (1/3 of soffit)
- Foundation height: 4'-0" MIN.

Materials and Finishes:

- 6"x16" STUCCO GABLE DETAIL
- APPLIED STUCCO FINISH
- FACE BRICK (TYP.)
- ASPHALT SHINGLES (TYP.)
- BRICK SOLDIER ARCH HEADER W/ KEYSTONE ON BRICK STACKS
- 1"x6" ALUM. CLAD FRIEZE BD. (TYP.)
- CONT. PRECAST CONC. SILL ON BRICK SOLDIER BAND (TYP.)
- BRICK SOLDIER ARCH HEADER W/ KEYSTONE (TYP.)
- POURED CONC. PORCH SLAB & DOOR SILL (TYP.)
- POURED CONC. FOUNDATION WALLS & FOOTINGS (TYP.)

Structural Notes:

- 8" DIA. COLUMNS ANCHORED TO 14"x14" SOLID MASONRY PIER (TYP.). PROVIDE SIMPSON STRONG-TIE CONNECTOR FOR POST-BEAM CONNECTION (TYP.)
- STEPPED FOOTING (30)

Other Details:

- SUNKEN FOYER
- 12" TRANSOM
- 8'-0"x7'-0" O/H GARAGE DOOR GD-18
- 8'-0"x7'-0" O/H GARAGE DOOR GD-18
- VALLEY FLASHING (TYP.)
- RAISED CEILING
- PREFIN. ALUM. R.W.L., FASCIA, GUTTER & VENTED SOFFIT (TYP.)

FRONT ELEVATION 1'


 Greenpark.		SPRINGFIELD 1 14.3m	
project name RUSSELL GARDENS PH. 4		municipality HAMILTON, ON.	
date FEB. 2021		project no. 20027	
drawn by D.BURTON		sheeted by scale 1" = 6'	
FRONT		ELEVATION '1' file name D0027-SPRINGFIELD 1-5	
A5		drawing no.	

21-1161939

Jim Jan 5/22

SPRINGFIELD 1S
COMPLIANCE PACKAGE 'A1'

 Greenpark.		SPRINGFIELD 1 14.3m	
client name MUSSELL GARDENS PH. 4	municipality HAMILTON, ON.	project no. 20037	
date 8. 2021	FRONT ELEVATION '1'		drawing no. A5
designed by BUKTON	checked by 3/16" = 1" = 0"	file name 20037-SPRINGFIELD-15	

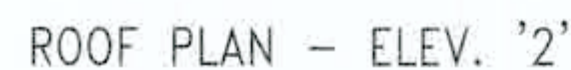

PORCH STEPS (TYP.)
PRECAST CONCRETE STEPS
w/ MASONRY INSERTS WHERE
GRADE REQUIRES.

It is the builder's complete responsibility to ensure that all plans submitted for approval fully comply with the Architectural Guidelines and all applicable regulations and requirements including zoning provisions and any provisions in the subdivision agreement. The Control Architect is not responsible in any way for examining or approving site (lotting), plans or working drawings with respect to any zoning or building code or permit matter or that any house can be properly built or located on its lot.

This is to certify that these plans comply with the applicable Architectural Design Guidelines approved by the City of HAMILTON

JAMES G. WIGGINS C.E., ARCHITECT
 6000 E. 9TH AVE., SUITE 100
 DENVER, CO 80231
 TEL: 733-1111 FAX: 733-1112
 WWW.JGWIGGINS.COM

[illegible]

44. American universities have related documents and lesson are the translated versions of US HISTORY. Searchable in whole or in part in digital format. Approx. US HISTORY's million entries.



 Greenpark.		SPRINGFIELD 1 14.3m	
project name RUSSELL GARDENS PH. 4		municipality HAMILTON, ON.	
date FEB. 2021		project name 20027	
created by DJBURTON		drawing no. A6	
checked by -		LEFT SIDE ELEVATION '1' 3/16" = 1'-0"	
date 20027-SPRINGFIELD-15		date 2021-03-27	

Sm Jan 5/22

SPRINGFIELD 1S
COMPLIANCE PACKAGE 'A1'


 Greenpark.		SPRINGFIELD 1 14.3m	
project name MUSSELL GARDENS PH. 4	municipality HAMILTON, ON.	project no. 20027	
date 2021	LEFT SIDE ELEVATION '1'		drawing no. A6
checked by MURTON	scale 3/16" = 1'-0"	file name 20027-SPRINGFIELD-1S	

21-161939

Jim Jansen

[illegible]

18			9			The undersigned has reviewed and takes responsibility for this design and does not have qualifications or meet the requirements set out in the Ontario Building Code to be a Designer.
17			8			
16			7			qualifications information:
15			6			Richard Yink
14			5			signature
13			4			Registration information
12			3			ISSUED FOR PERMIT MAY 21/21 CW 24488
11			2			REV. PER CLIENT / ROOF / FLN / COMMENTS APPR 26/21 CW RCH
10			1			2 REVISED PER CLIENT & LUMBER MAR. 31/21 CW 42554
9			PRELIMINARY ISSUED FOR CLIENT REVIEW MAY 12/21 CW			
8			Description	Date	by	Description

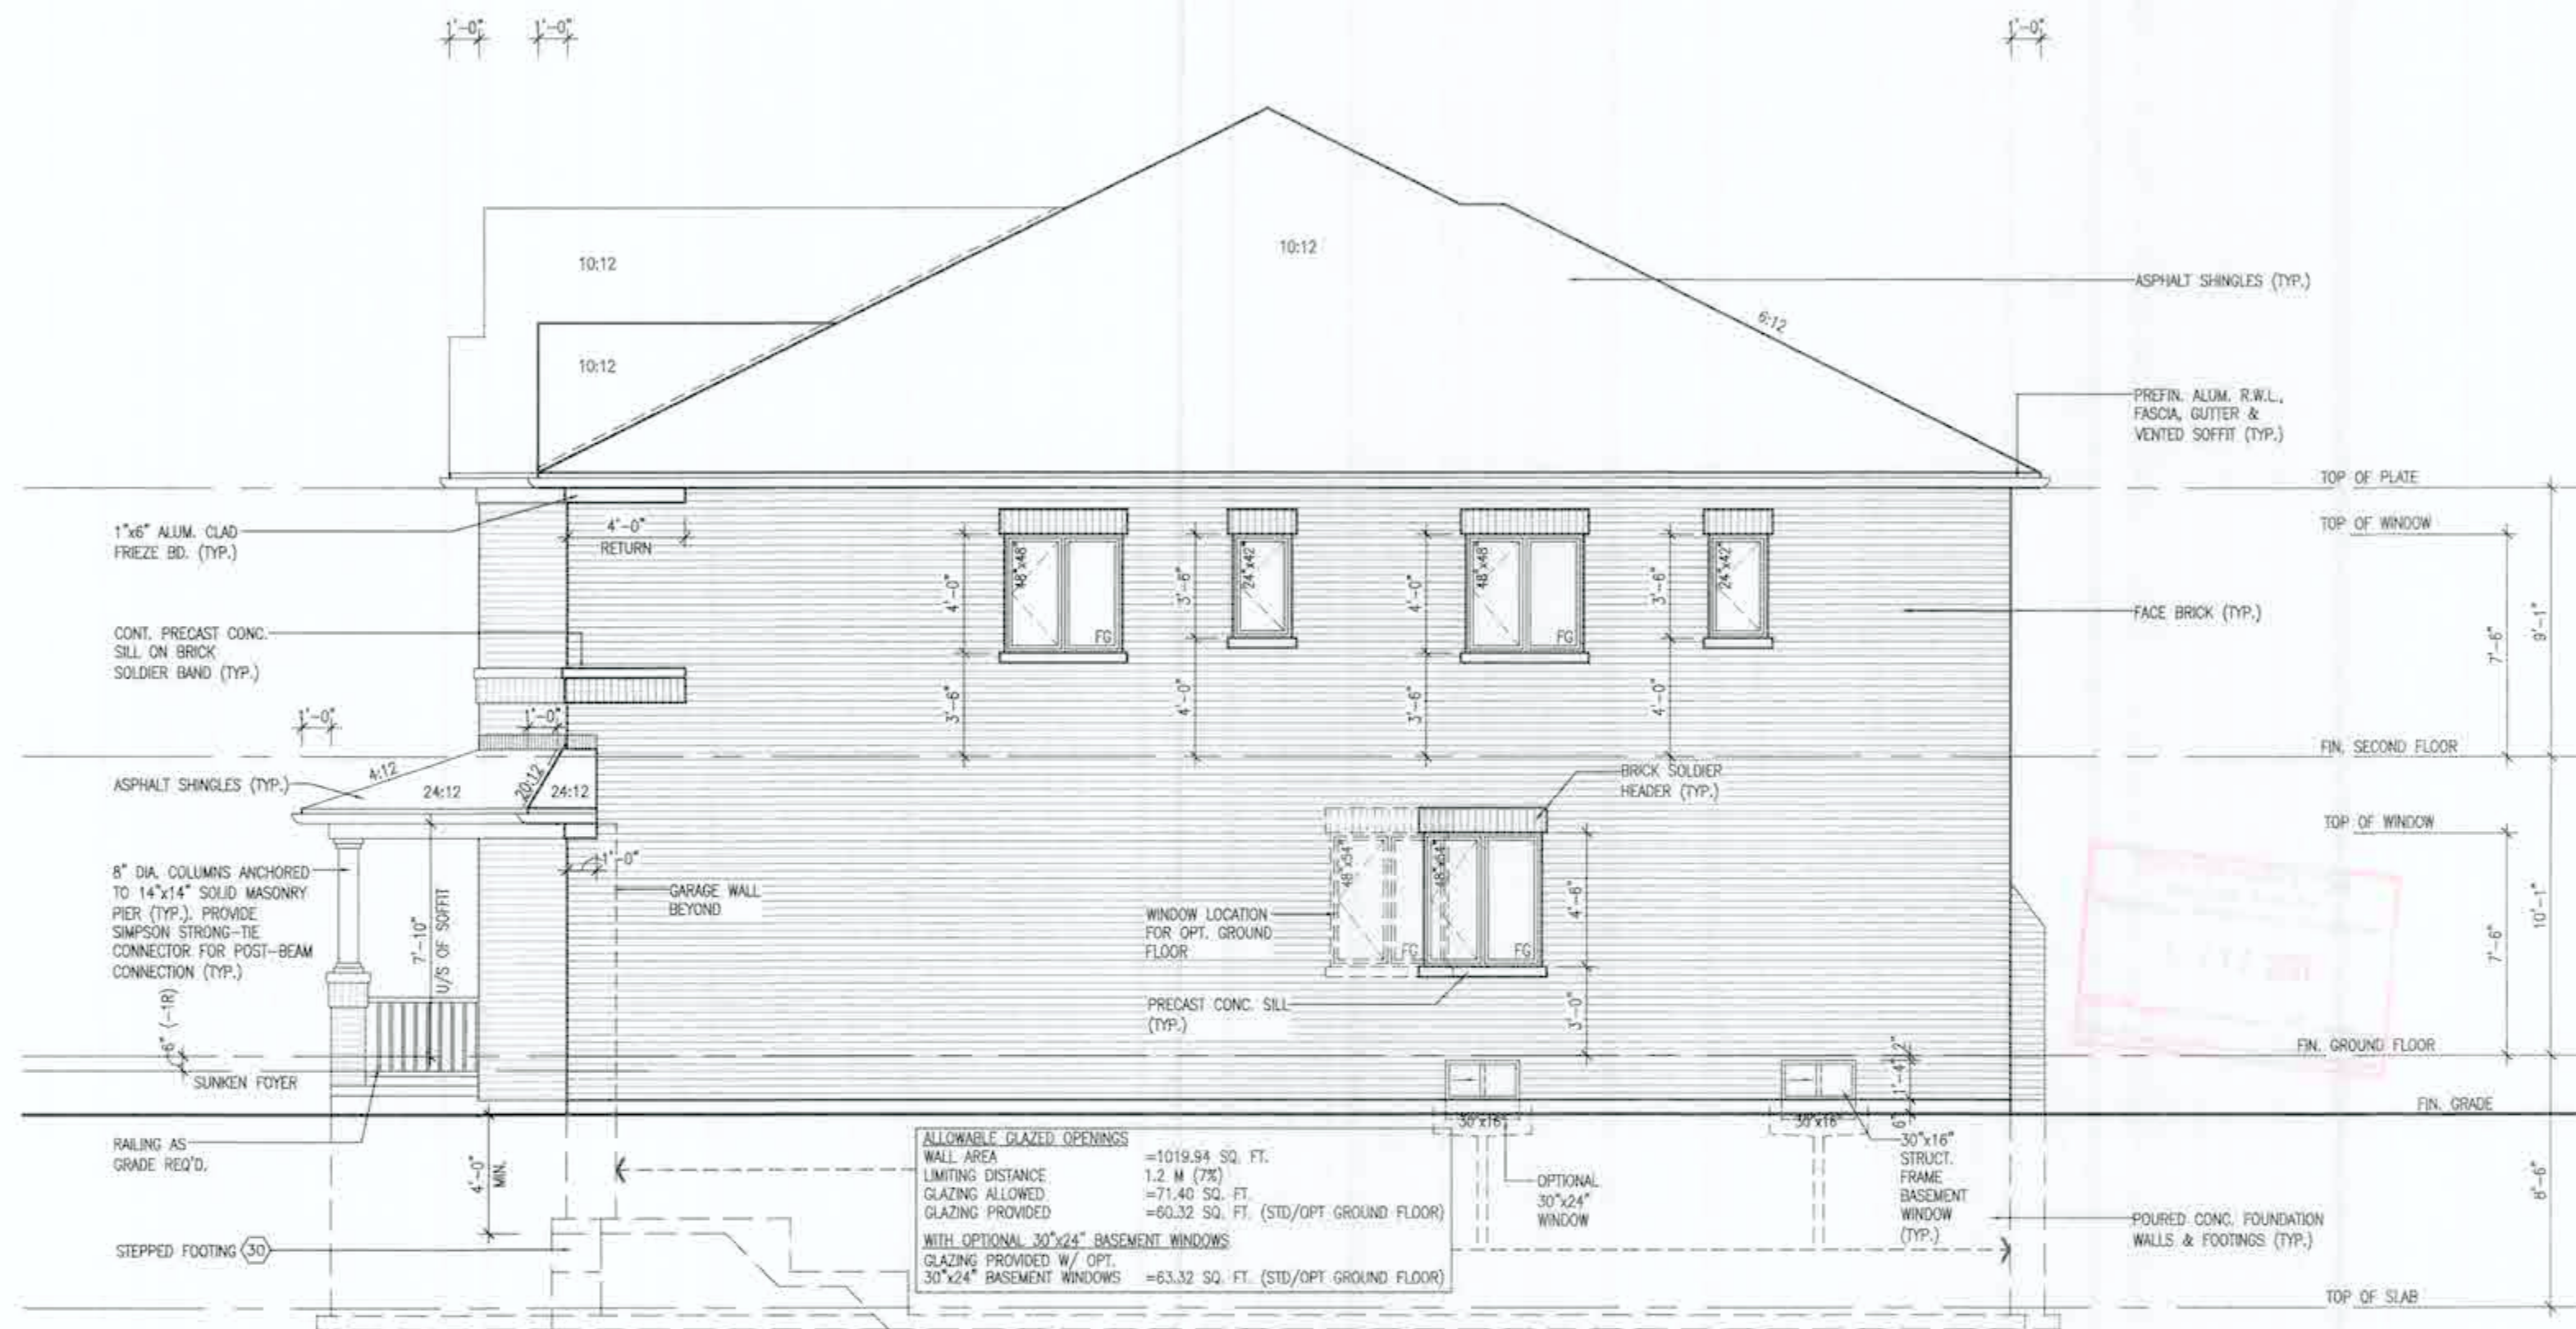

RIGHT SIDE ELEVATION '1'

It is the builder's complete responsibility to ensure that all plans submitted for approval fully comply with the Architectural Guidelines and all applicable regulations and requirements including zoning provisions and any provisions in the subdivision agreement. The Control Architect is not responsible in any way for examining or approving site (lotting) plans or working drawings with respect to any zoning or building code or permit matter or that any house can be properly built or located on the lot.

This is to certify that these plans comply with the applicable Architectural Design Guidelines approved by the City of HAMILTON.

KIM C. WILLIAMS LTD., ARCHITECTS
ARCHITECTURAL CONSULTING FIRM
Architectural Firm

DATE: AUG 17, 2004

This agreement is made between the undersigned
architectural firm and the client as follows:

18				9	The undersigned has reviewed and takes responsibility for this design and the specifications and travels the requirements set out in the Ontario Building Code to be a Designer.									SPRINGFIELD 1 14.3m					
17				8				signature <i>R. Vink</i>			project name RUSSELL GARDENS PH. 4			municipality HAMILTON, ON.			project no. 20027		
16				7				name Richard Vink			date FEB. 2021			sheet no. RIGHT SIDE ELEVATION '1'			drawing no. A7		
15				6				signature <i>R. Vink</i>			checked by D. BURTON			scale 3/16" = 1'-0"			file name 20027-SPRINGFIELD-1S		
14				5				registration information VAB3 Design Inc.			title DESIGNER			date 2020-07-15			sheet no. 15		
13				4	ISSUED FOR PERMIT. MAY 21/21 GW			name Richard Vink			title DESIGNER			date 2020-07-15			sheet no. 15		
12				3	REV. PER CLIENT/PROF./E.L./ENG. COMMENTS APR 26/21 GW			name Richard Vink			title DESIGNER			date 2020-07-15			sheet no. 15		
11				2	REVISED PER CLIENT/ENG. & LUMBER MAR. 31/21 GW			name Richard Vink			title DESIGNER			date 2020-07-15			sheet no. 15		
10				1	PRELIMINARY, ISSUED FOR CLIENT REVIEW. MAR. 12/21 GW			name Richard Vink			title DESIGNER			date 2020-07-15			sheet no. 15		
9				0	description date by description			name Richard Vink			title DESIGNER			date 2020-07-15			sheet no. 15		

All drawings, specifications, related documents and designs are the copyright property of VMS DESIGN. Reproduction of this property in whole or in part is strictly prohibited without VMS DESIGN's written permission.



RIGHT SIDE ELEVATION '2'

It is the builder's complete responsibility to ensure that all plans submitted for approval fully comply with the Architectural Guidelines and all applicable regulations and requirements, including zoning provisions and any provisions in the subdivision agreement. The Control Architect is not responsible in any way for examining or approving site (lotting) plans or working drawings with respect to any zoning or building code or permit matter or that any house can be properly built or located on the lot.


This is to certify that these plans comply with the applicable Architectural Design Guidelines approved by the City of HAMILTON.

WIRTSCHAFTS UNIVERSITÄT WIEN
UNIVERSITY OF ECONOMICS AND BUSINESS
WU
Name: _____
Matrikelnummer: _____
Datum: 20.02.2021

The exam contains questions with the following
General Guidelines: you are asked to test or
confirm your knowledge.

[illegible]

All documents, correspondence, related documents and data are the confidential property of SAS INSTITUTE. Reproduction of this material in whole or in part is strictly prohibited without SAS INSTITUTE's written permission.

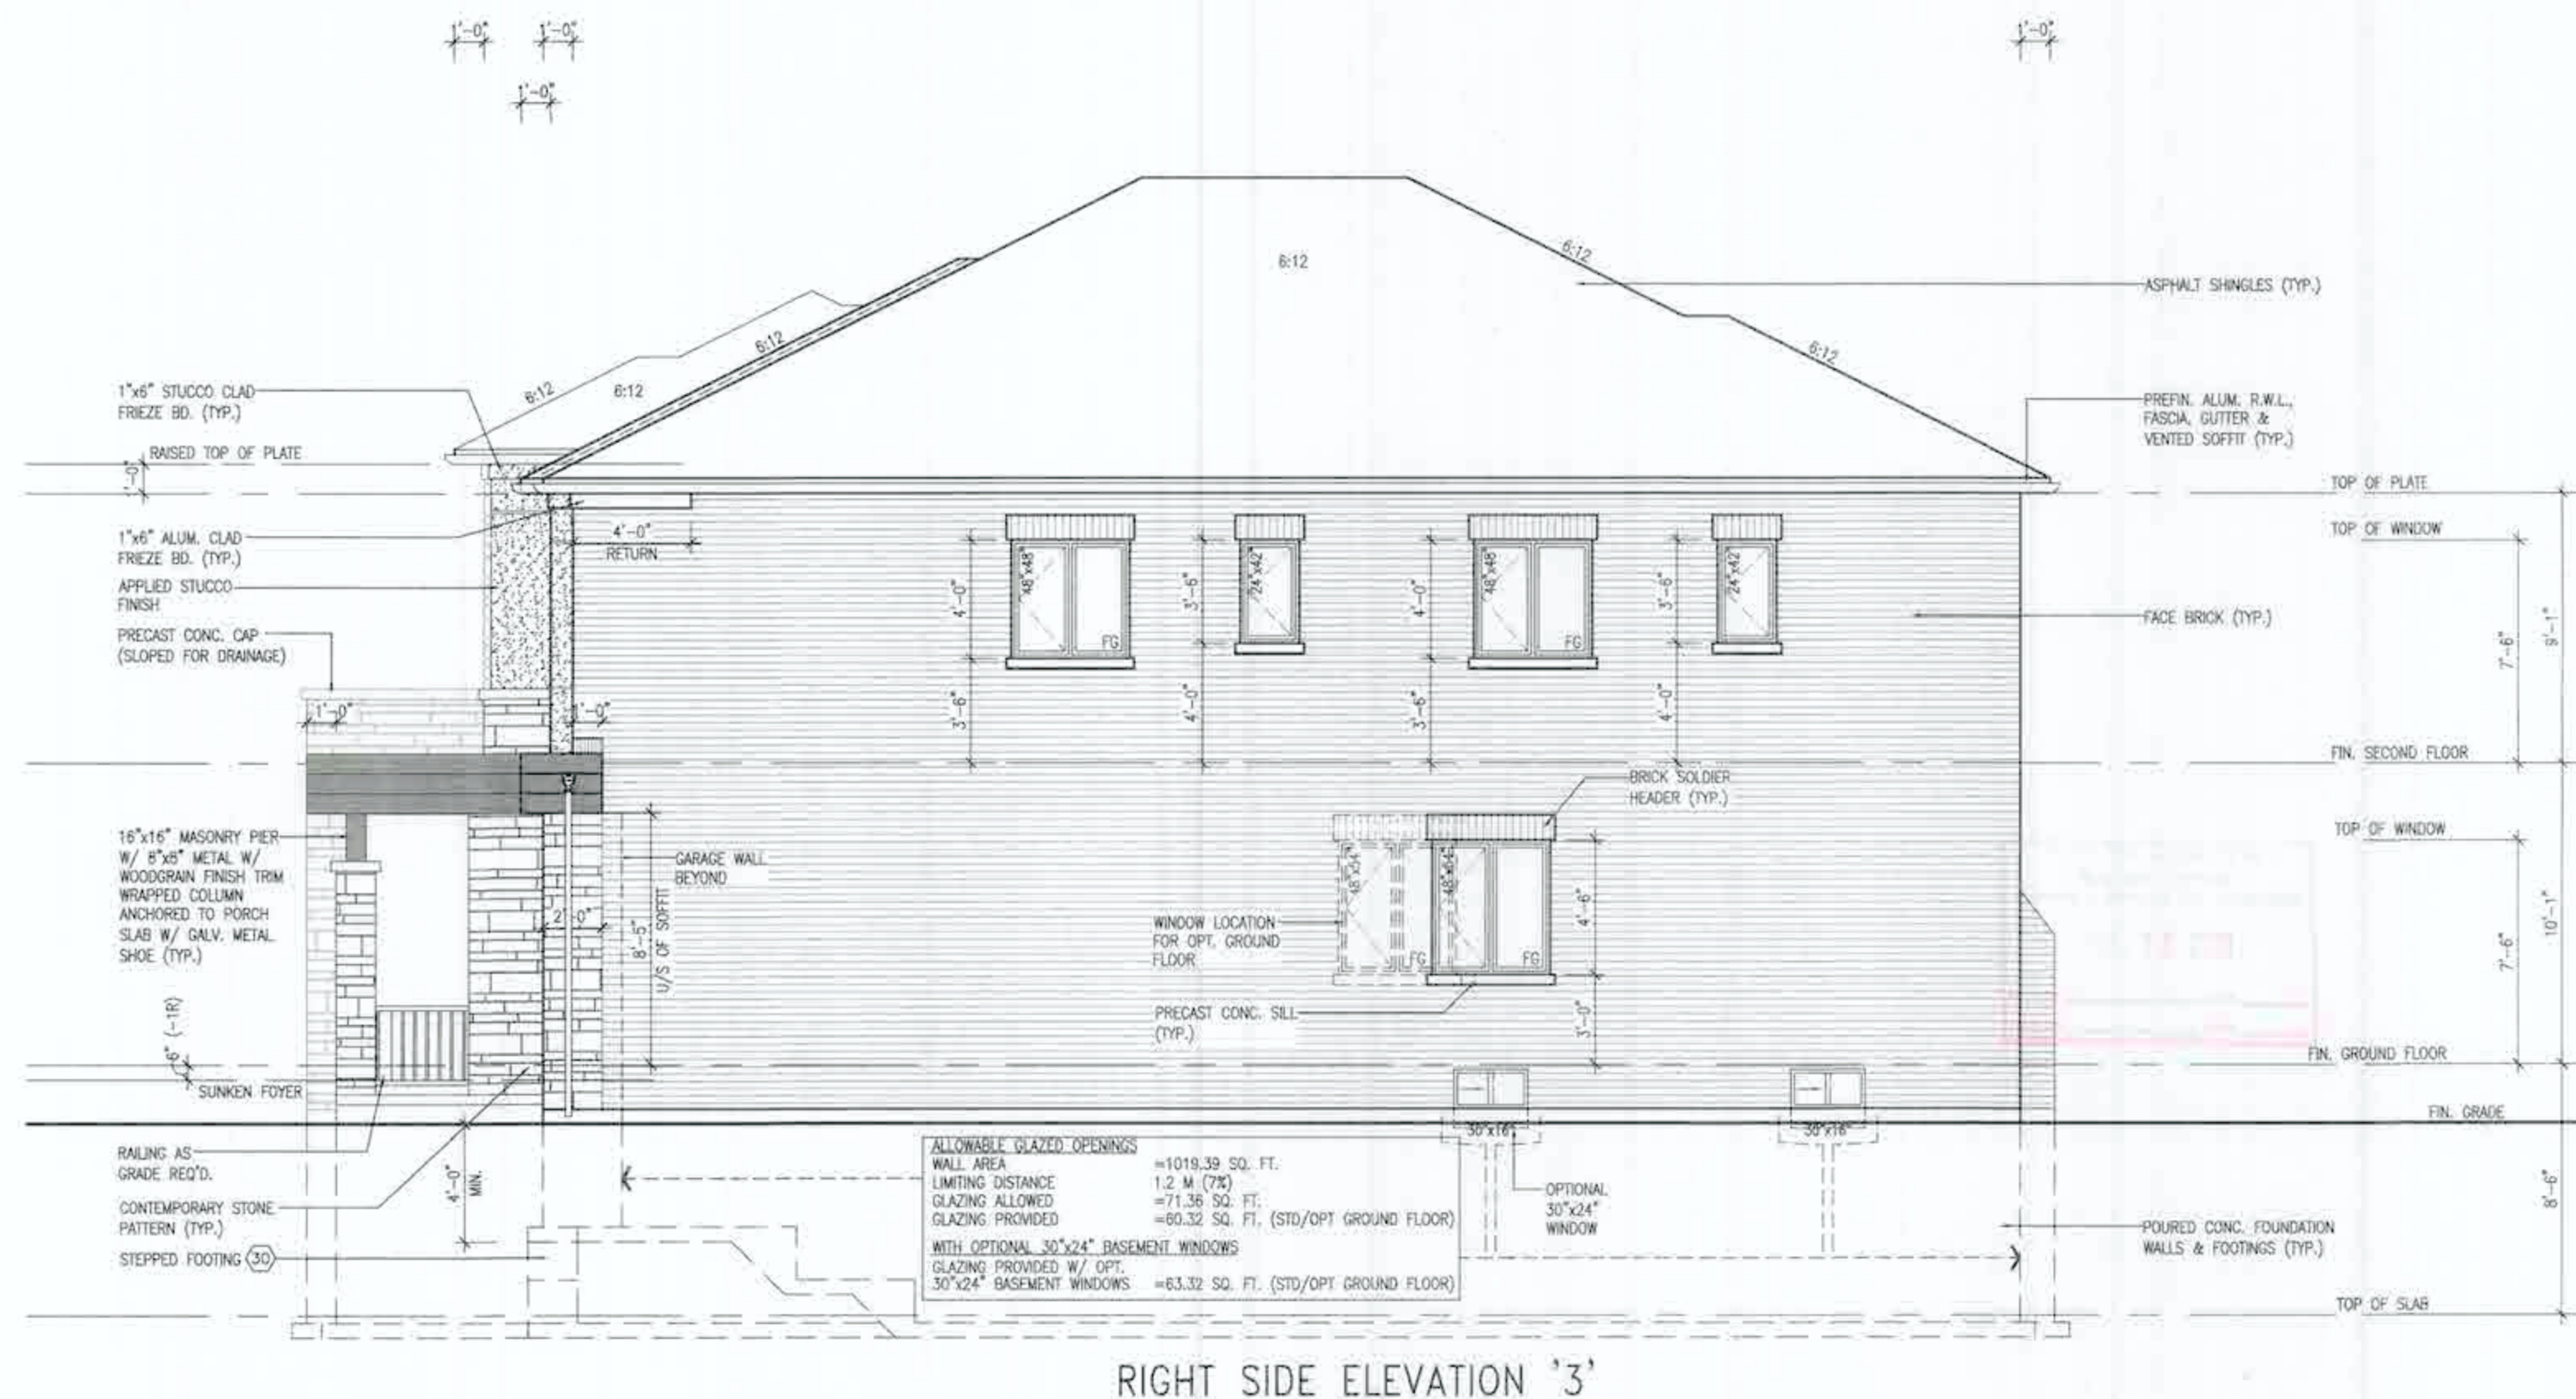

21-161929

Jm Jan 5/22

It is the builder's complete responsibility to ensure that all plans submitted for approval fully comply with the Architectural Guidelines and all applicable regulations and requirements including zoning provisions and any provisions in the subdivision agreement. The Control Architect is not responsible in any way for examining or approving site (lotting) plans or working drawings with respect to any zoning or building code or permit matter or that any house can be properly built or located on its lot.

This is to certify that these plans comply with the applicable Architectural Design Guidelines approved by the City of HAMILTON.

JOHN L. WESTRAAR LTD. ARCHITECT
ARCHITECTURAL CONTROL SYSTEM
HAMILTON, ONT.
ARCHITECT'S SEAL
DATE: 01/05/22
Drawing: 20027-SPRINGFIELD-1S
greenpark.com/20027

SPRINGFIELD 1S
COMPLIANCE PACKAGE 'A1'

18 17 16 15 14 13 12 11 10 9 8 7 6 5 4 3 2 1	18 17 16 15 14 13 12 11 10 9 8 7 6 5 4 3 2 1	18 17 16 15 14 13 12 11 10 9 8 7 6 5 4 3 2 1	18 17 16 15 14 13 12 11 10 9 8 7 6 5 4 3 2 1	18 17 16 15 14 13 12 11 10 9 8 7 6 5 4 3 2 1
---	---	---	---	---

VAS
DESIGN

Greenpark.

SPRINGFIELD 1
14.3m

project name: RUSSELL GARDENS PH. 4
location: HAMILTON, ON.
date: FEB, 2021
drawn by: D.BURTON
checked by: 3/16" = 1'-0"
scale: 20027-SPRINGFIELD-1S
drawing no.: A7b

All drawings, specifications, related documents and design are the copyright property of VAS DESIGN. Reproduction of this property in whole or in part is strictly prohibited without VAS DESIGN's written permission.



REAR ELEVATION '1'

21-141939

Sm. Jan 5/22

It is the builder's concurrent responsibility to ensure that all plans submitted for approval fully comply with the Architectural Guidelines and all applicable regulations and requirements including zoning provisions and any provisions in the subdivision agreement. The Control Architect is not responsible in any way for examining or approving site (lotting) plans or working drawings with respect to any zoning or building code or permit matter or that any house can be properly built or located on its lot.

This is to certify that these plans comply with the applicable Architectural Design Guidelines approved by the City of HAMILTON.

JOHN C. WILLIAMS FOR ARCHITECT
 MEDIANUTURAL CONTROL, RESIDE
 AND-ENGINEERING
 AUTHORIZED BY _____
 DATE: 10/10/10

This is a true and correct copy of the original
 design submitted to the City of Dallas
 for the proposed project.

[illegible]

© 2004 Hewlett-Packard Development Company, L.P. All rights reserved. Reproduction of this document in whole or in part is strictly prohibited without HP/HPD's written permission.



21-161930

Im Jan 5/22

IRWIN G. WILLIAMS LTD., ARCHITECT
BUILDINGS, CONTROL ROOMS
AND OFFICES

CONSTRUCTION
1960-1961


The Williams Group

checked by	scale	file name
	3/16" = 1'-0"	20027-SPRINGFIELD-1S

A8b

[illegible]

All document translations, edited documents and letters use the approved version of UNCTAD/OSCE. Reproduction of this report is whole or in part is strictly prohibited without UNCTAD/OSCE's written permission.

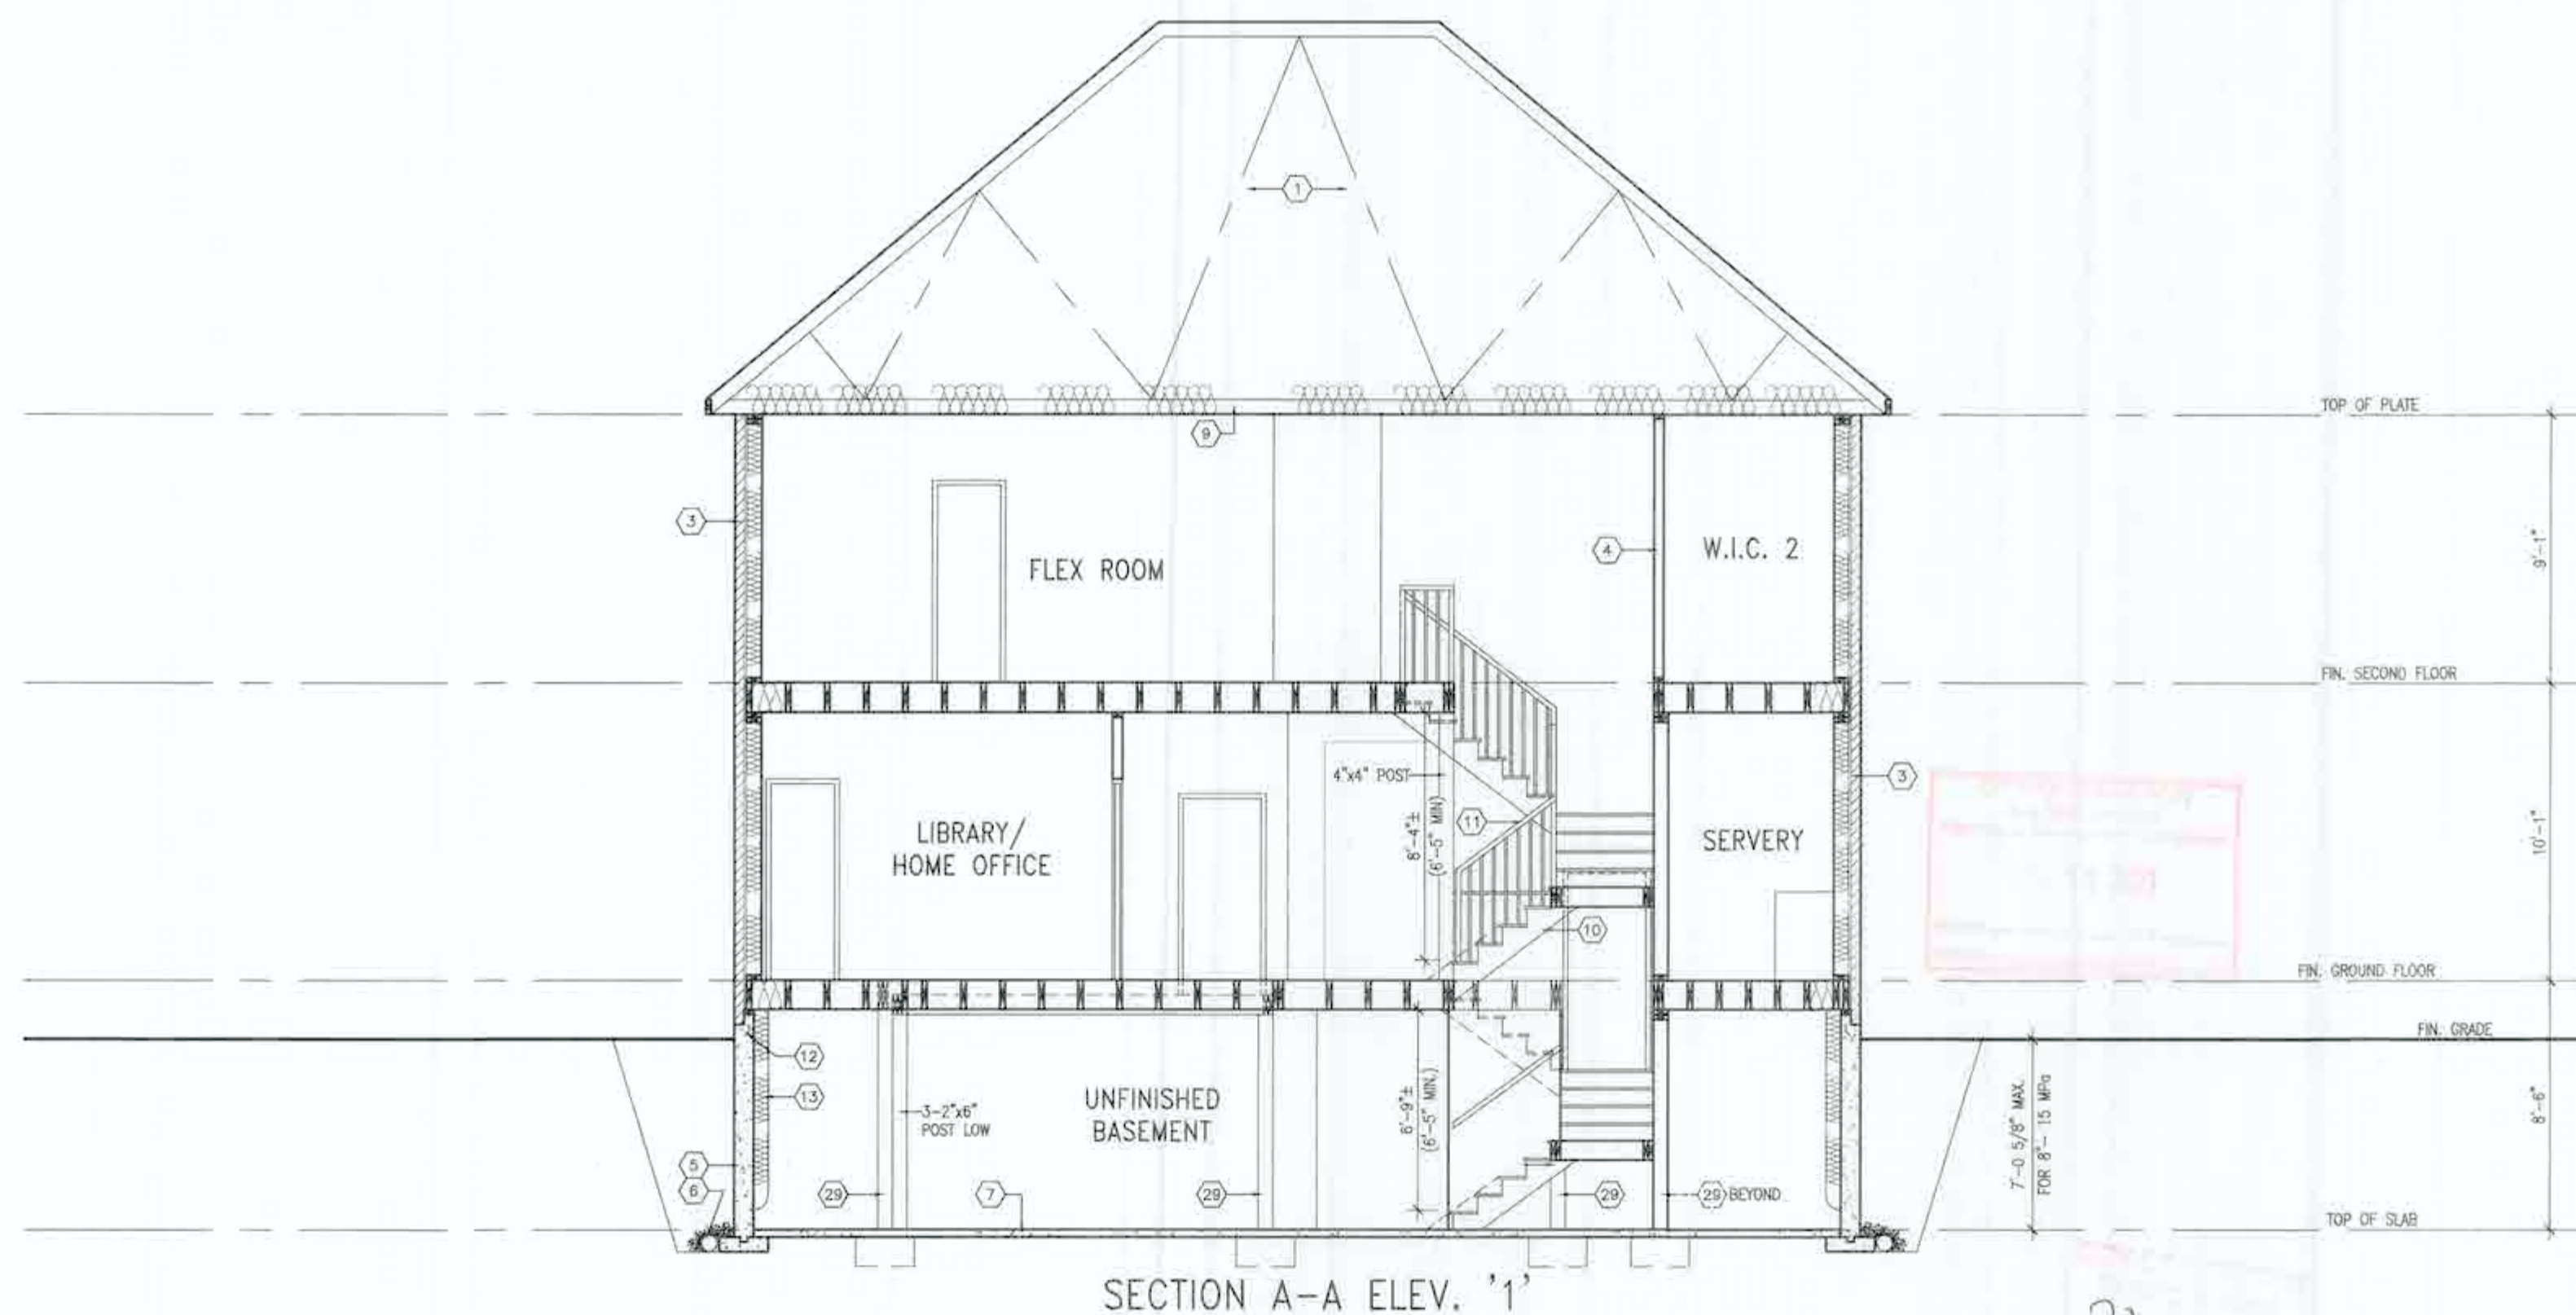

SECTION A-A ELEV. '1'

21-161939

Sm Jan 5/22

It is the builder's complete responsibility to ensure that all plans submitted for approval fully comply with the Architectural Guidelines and all applicable regulations and requirements including zoning provisions and any provisions in the subdivision agreement. The Control Architect is not responsible in any way for examining or approving any (other) plans or working drawings with respect to any zoning or building code or permit matter or that any house can be properly built or located on the lot.


This is to certify that these plans comply with the applicable Architectural Design Guidelines approved by the City of Hamilton.



18 17 16 15 14 13 12 11 10 9 8 7 6 5 4 3 2 1	18 17 16 15 14 13 12 11 10 9 8 7 6 5 4 3 2 1	18 17 16 15 14 13 12 11 10 9 8 7 6 5 4 3 2 1	18 17 16 15 14 13 12 11 10 9 8 7 6 5 4 3 2 1	18 17 16 15 14 13 12 11 10 9 8 7 6 5 4 3 2 1	18 17 16 15 14 13 12 11 10 9 8 7 6 5 4 3 2 1
--	--	--	--	--	--

SPRINGFIELD 1S COMPLIANCE PACKAGE 'A1'

Greenpark. RUSSELL GARDENS PH. 4 HAMILTON, ON.	SPRINGFIELD 1 14.3m SECTION A-A ELEV. '1' 20027-SPRINGFIELD-1S A9
--	---

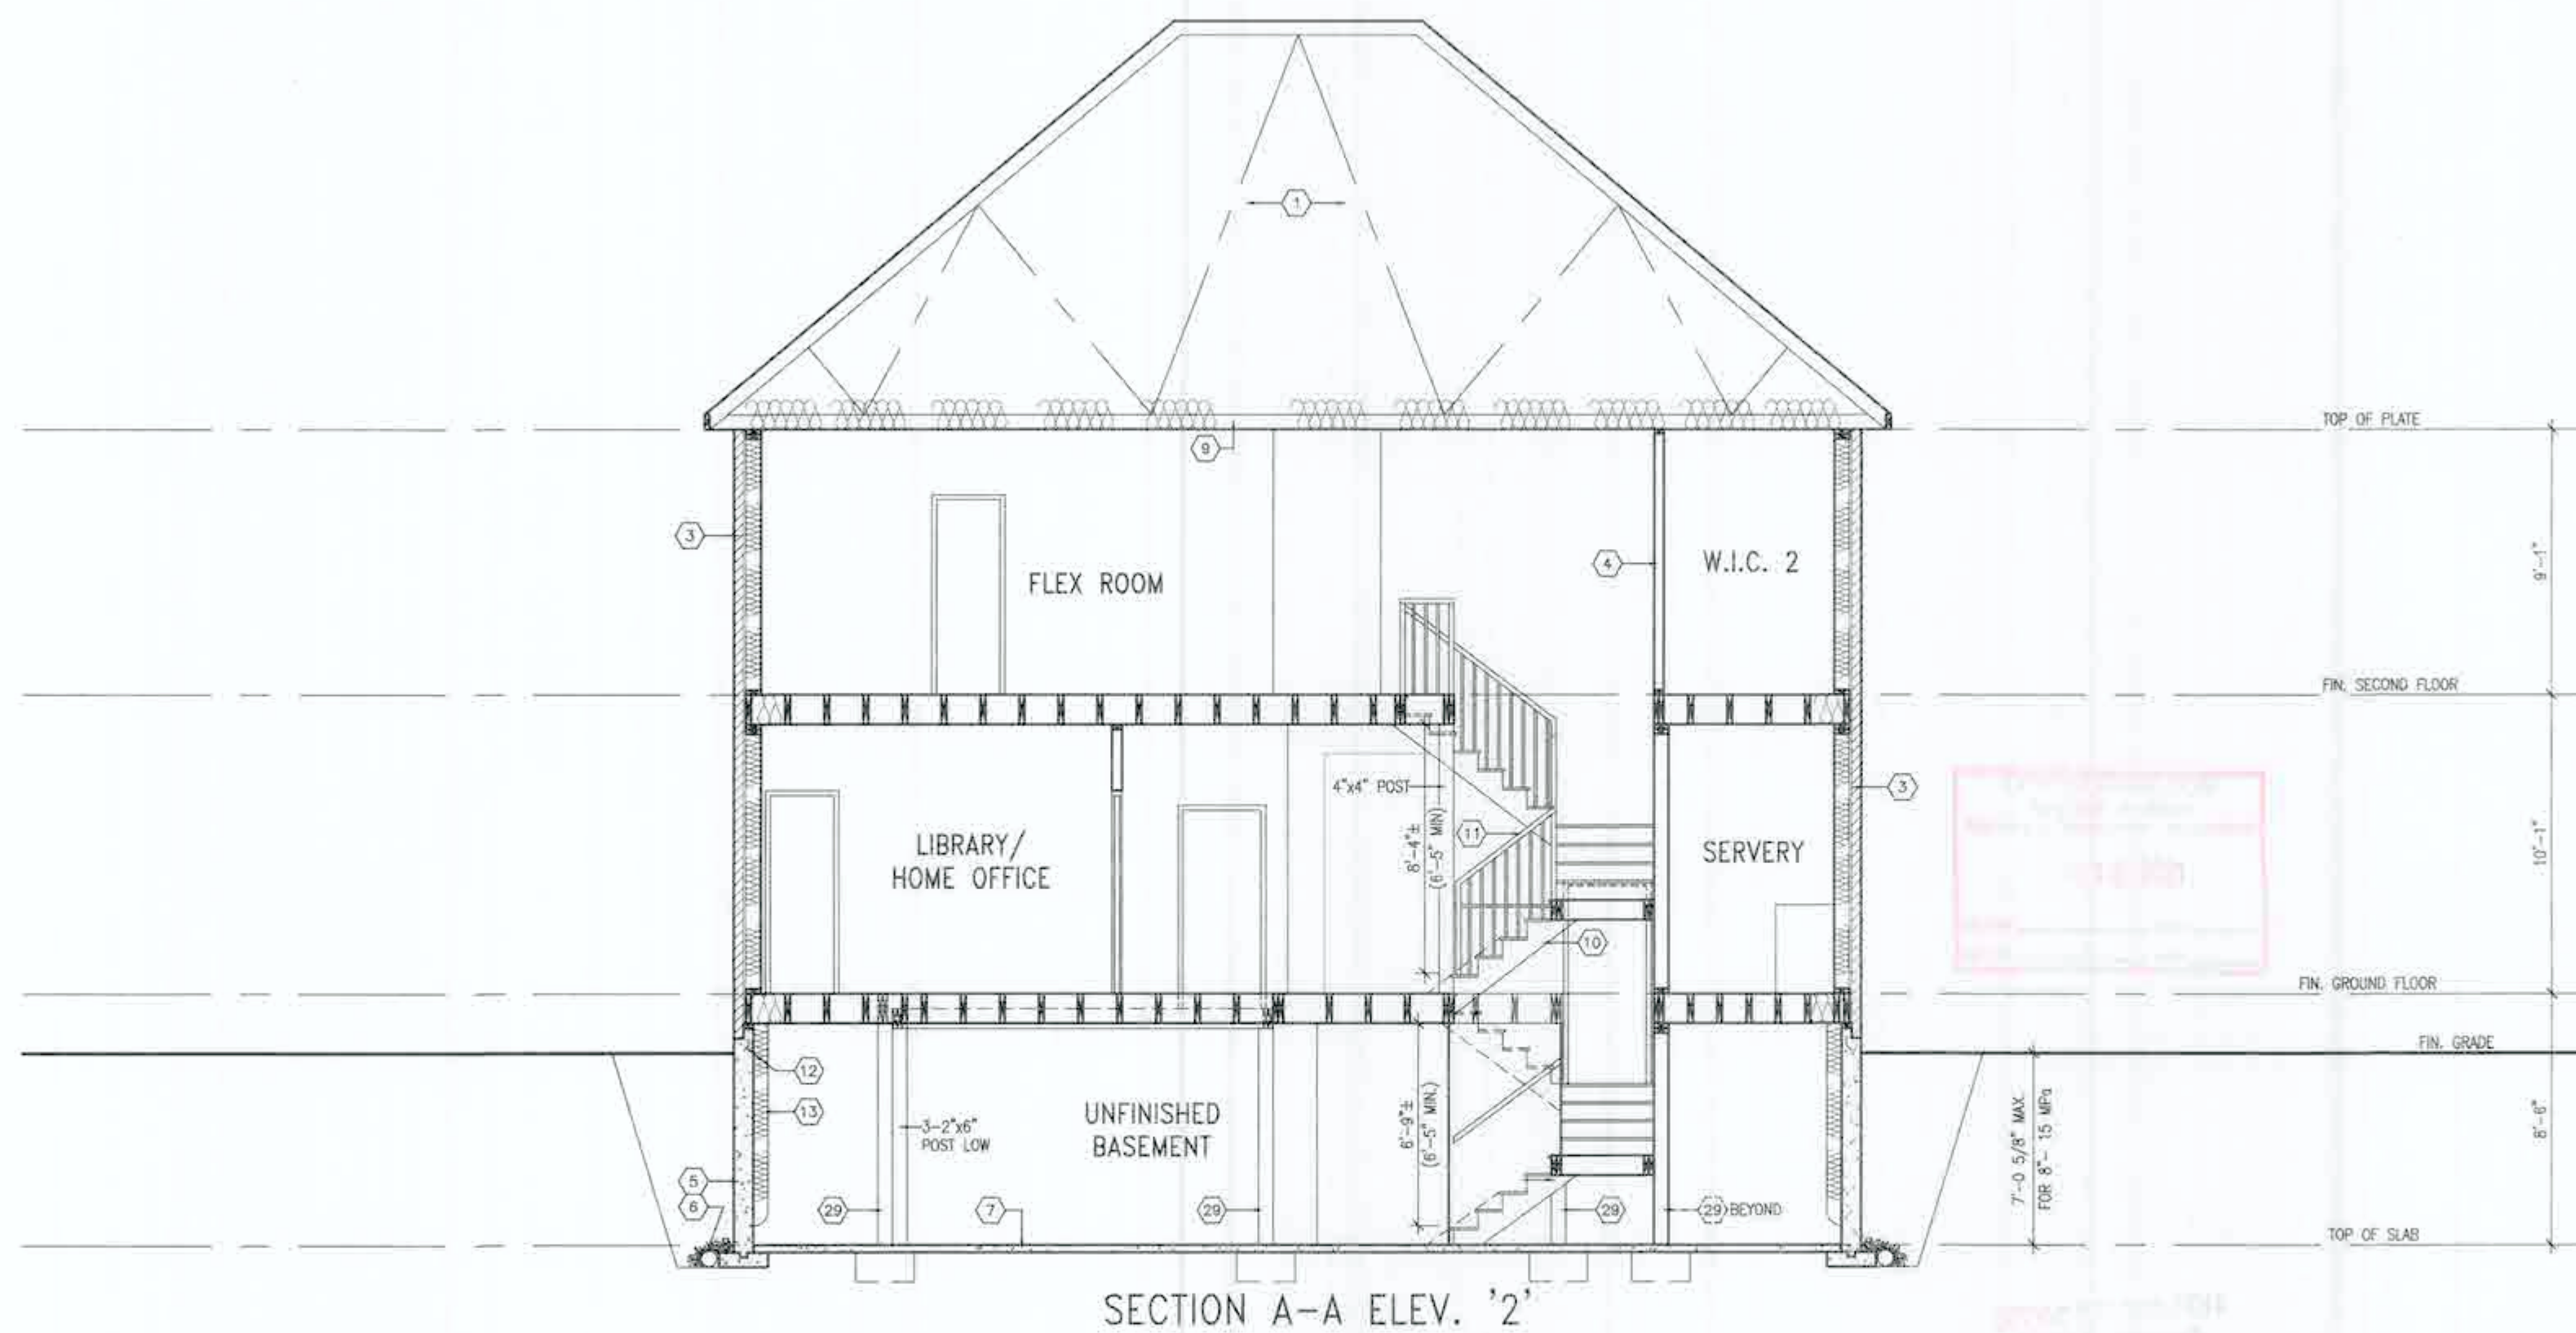

Jim San 5/22

It is the builder's complete responsibility to ensure that all plans submitted for approval fully comply with the Architectural Guidelines and all applicable regulations and requirements including zoning provisions and any provisions in the subdivision agreement. The Control Architect is not responsible in any way for examining or approving site (lotting) plans or working drawings with respect to any zoning or building code or permit matter or that any house can be properly built or located on its lot.


This is to certify that these plans comply with the applicable Architectural Design Guidelines approved by the City of HAMILTON.



STRUDET INC.
FOR STRUCTURE ONLY

[illegible]

All drawings, specifications, related documents and design are the copyright property of VAI DESIGN. Reproduction of this property in whole or in part is strictly prohibited without VAI DESIGN's written permission.

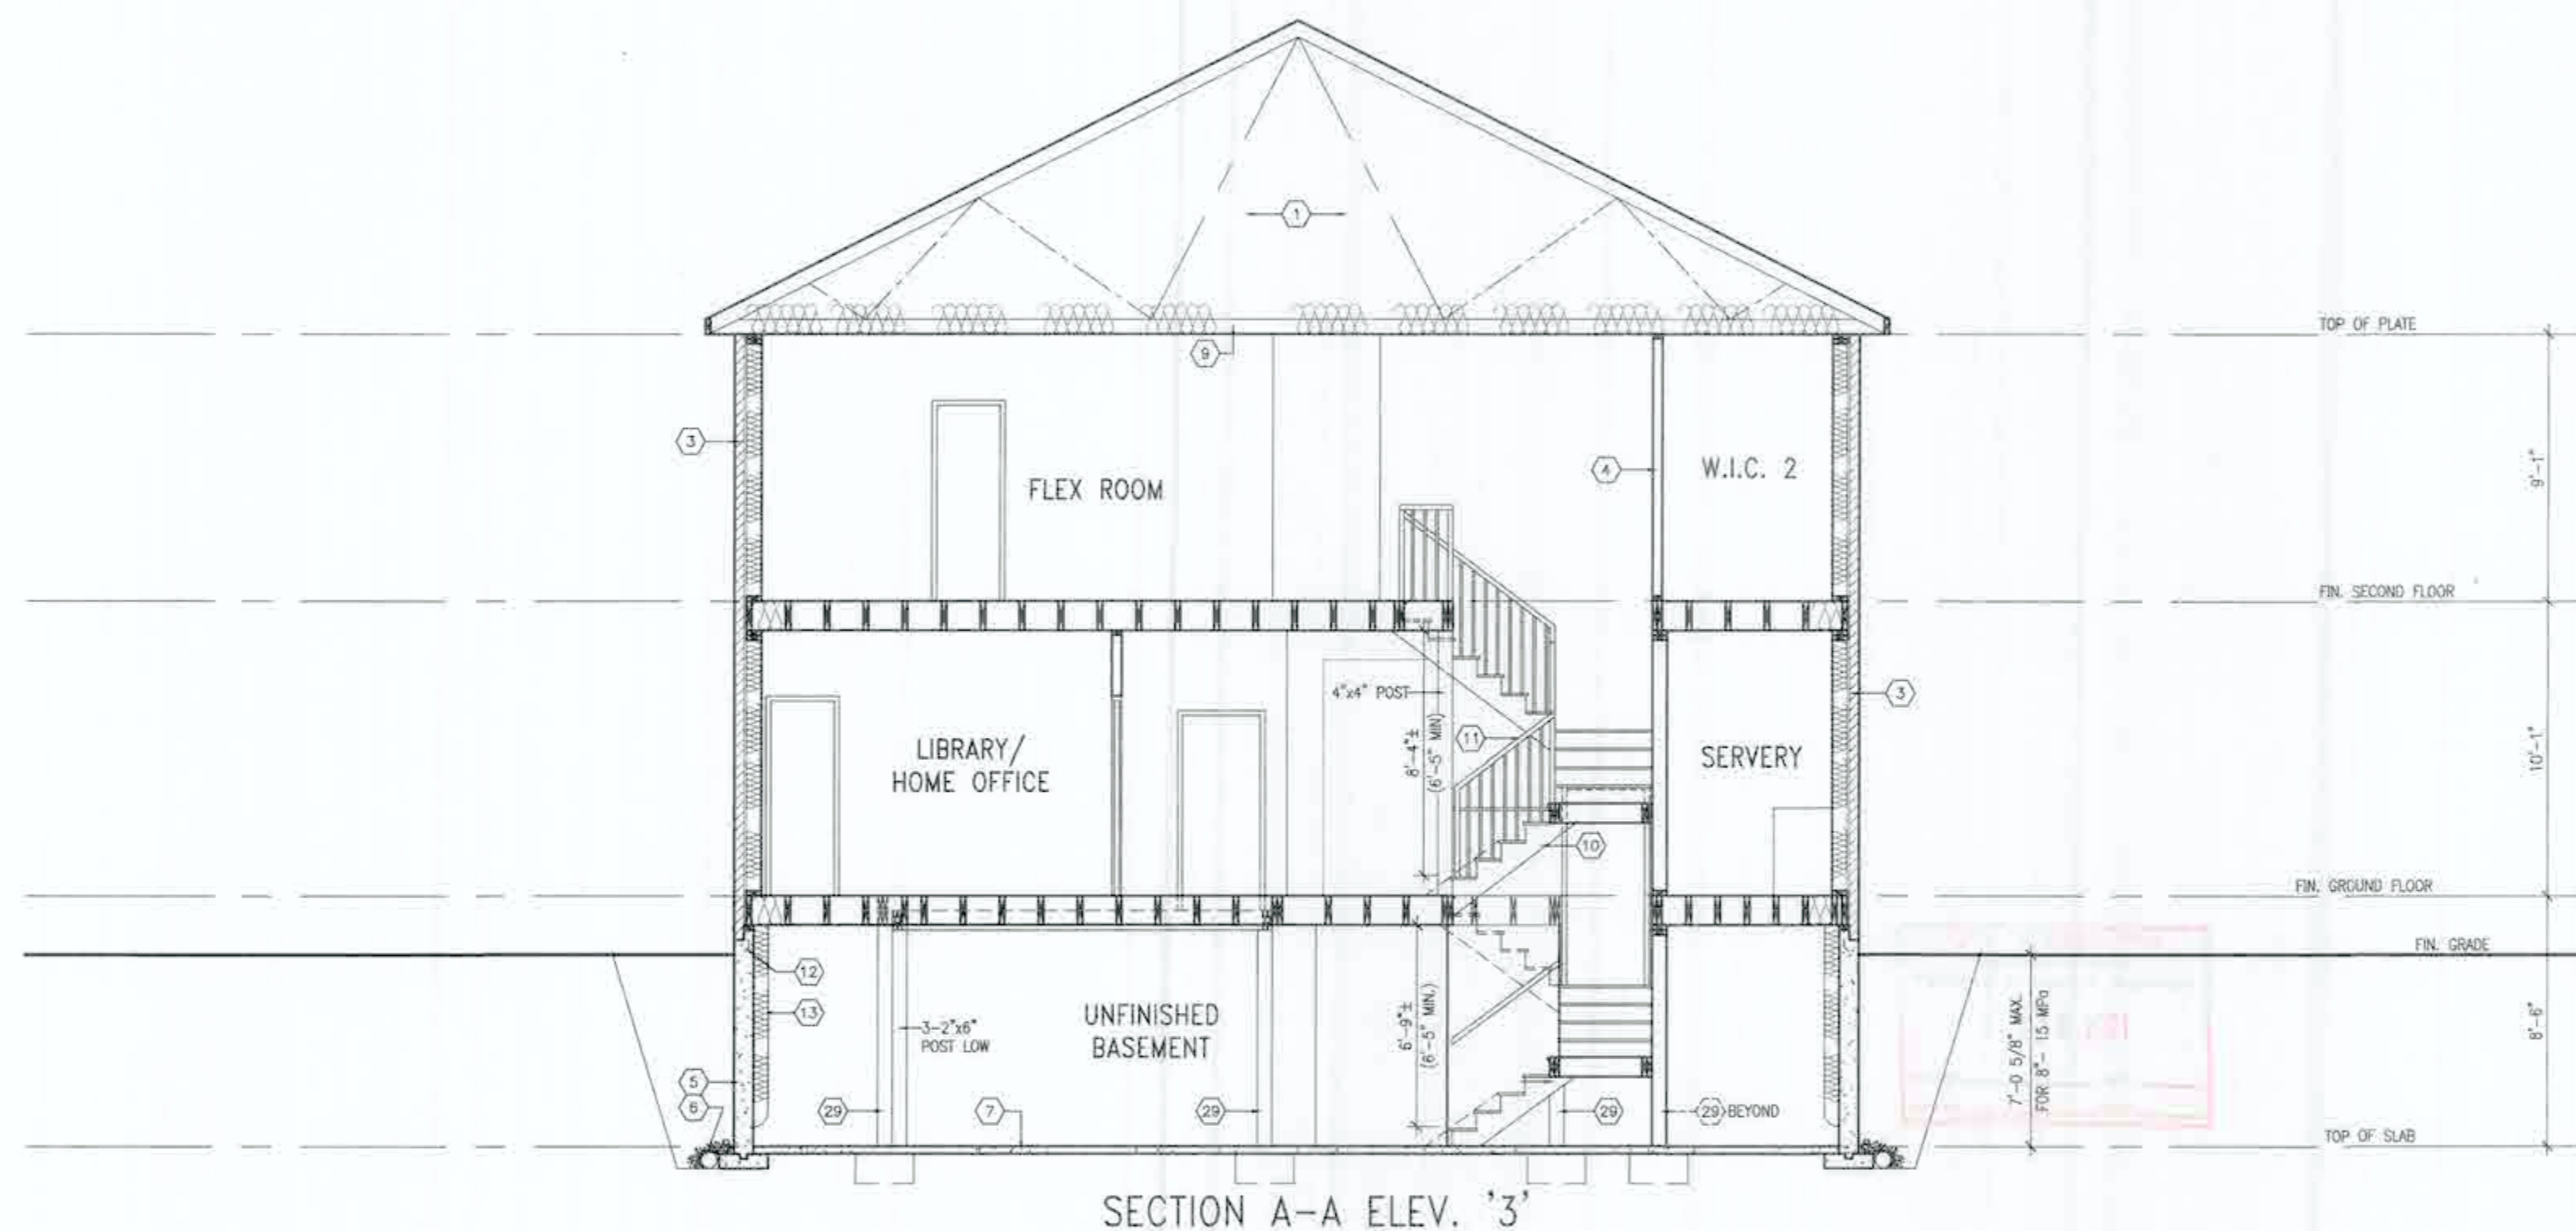

SECTION A-A ELEV. '3'

21-1161939

Jm Jan 5/22

It is the builder's complete responsibility to ensure that all plans submitted for approval fully comply with the Architectural Guidelines and all applicable regulations and requirements including zoning provisions and any provisions in the subdivision agreement. The Control Architect is not responsible in any way for examining or approving any (noting) plans or working drawings with respect to any zoning or building code or permit matter or that any house can be properly built or located on its lot.

This is to certify that these plans comply with the applicable Architectural Design Guidelines approved by the City of HAMILTON.



18		9			
17		8			
16		7			
15		6			
14		5			
13		4	ISSUED FOR PERMIT	MAY 21/21	OW
12		3	REV. PER CLIENT/PROF/EL/ENG. COMMENTS	APR 26/21	OW
11		2	REVISED PER CLIENT/ENG. & LUMBER	MAR 31/21	OW
10		1	PRELIMINARY ISSUED FOR CLIENT REVIEW	MAR 12/21	OW
9					
8					
7					
6					
5					
4					
3					
2					
1					
0					

The undersigned has reviewed and takes responsibility for this design and has the qualifications and meets the requirements set out in the Ontario Building Code to be a Designer.

signature: Richard Vink 24485
42655

registration information:
VAS Design Ltd.

Contractor must verify all dimensions on the job and report any discrepancy to the Designer before proceeding with the work. All drawings and specifications are submitted for review and the property of the Designer which must be returned at the completion of the work. Drawings are not to be used.

VAS DESIGN

255 Consumers Rd Suite 120
Toronto, ON M2J 1B4
1 416.630.2255 | 416.630.4702
vasdesign.com

Greenpark.

project name: RUSSELL GARDENS PH. 4
location: HAMILTON, ON.

SPRINGFIELD 1
14.3m

project no: 20027



date: FEB. 2021
drawn by: D. BURTON
checked by: 3/16" = 1'-0"

SECTION A-A ELEV. '3'

20027-SPRINGFIELD-15

drawing no: A9b

BASEMENT INSULATION AT STAIR/SUNKEN AREAS
 -2" (R10) CONTINUOUS INSULATION (RIGID or SPRAY FOAM),
 -2"x4" @ 16" o.c. w/ R12 BATT INSULATION & 1/2" DRYWALL FINISH.
 -EXTEND EXTERIOR WALL FOOTING TO SUPPORT 2"x4" WALL WHERE LOAD BEARING.

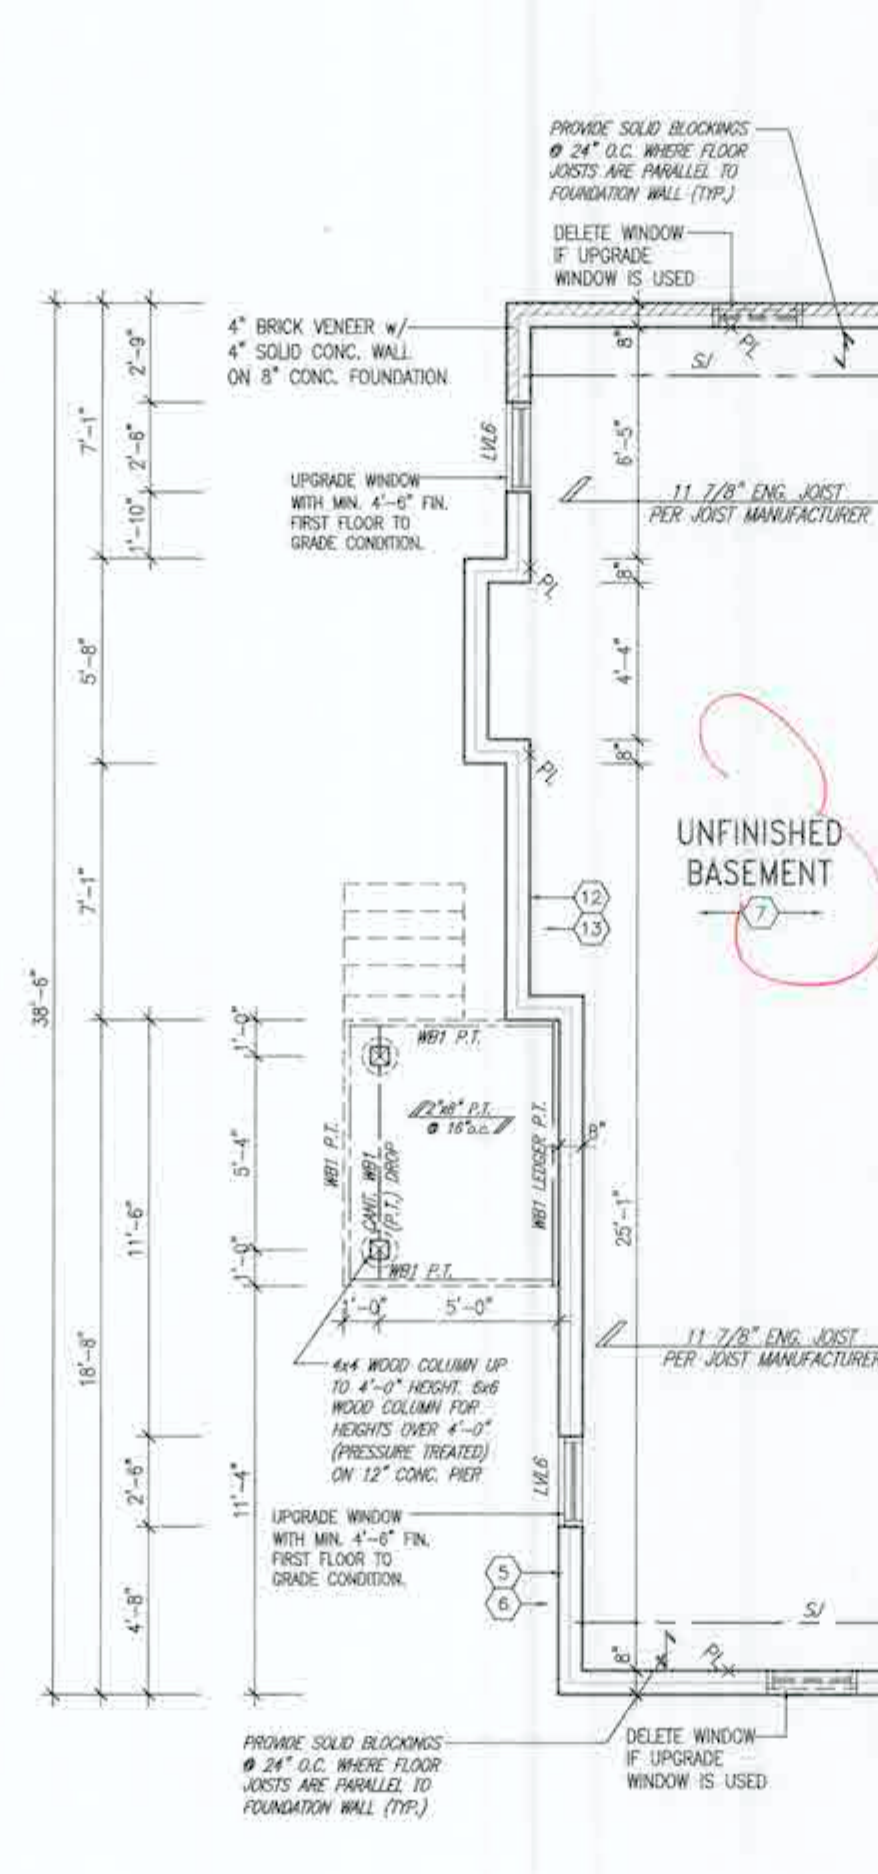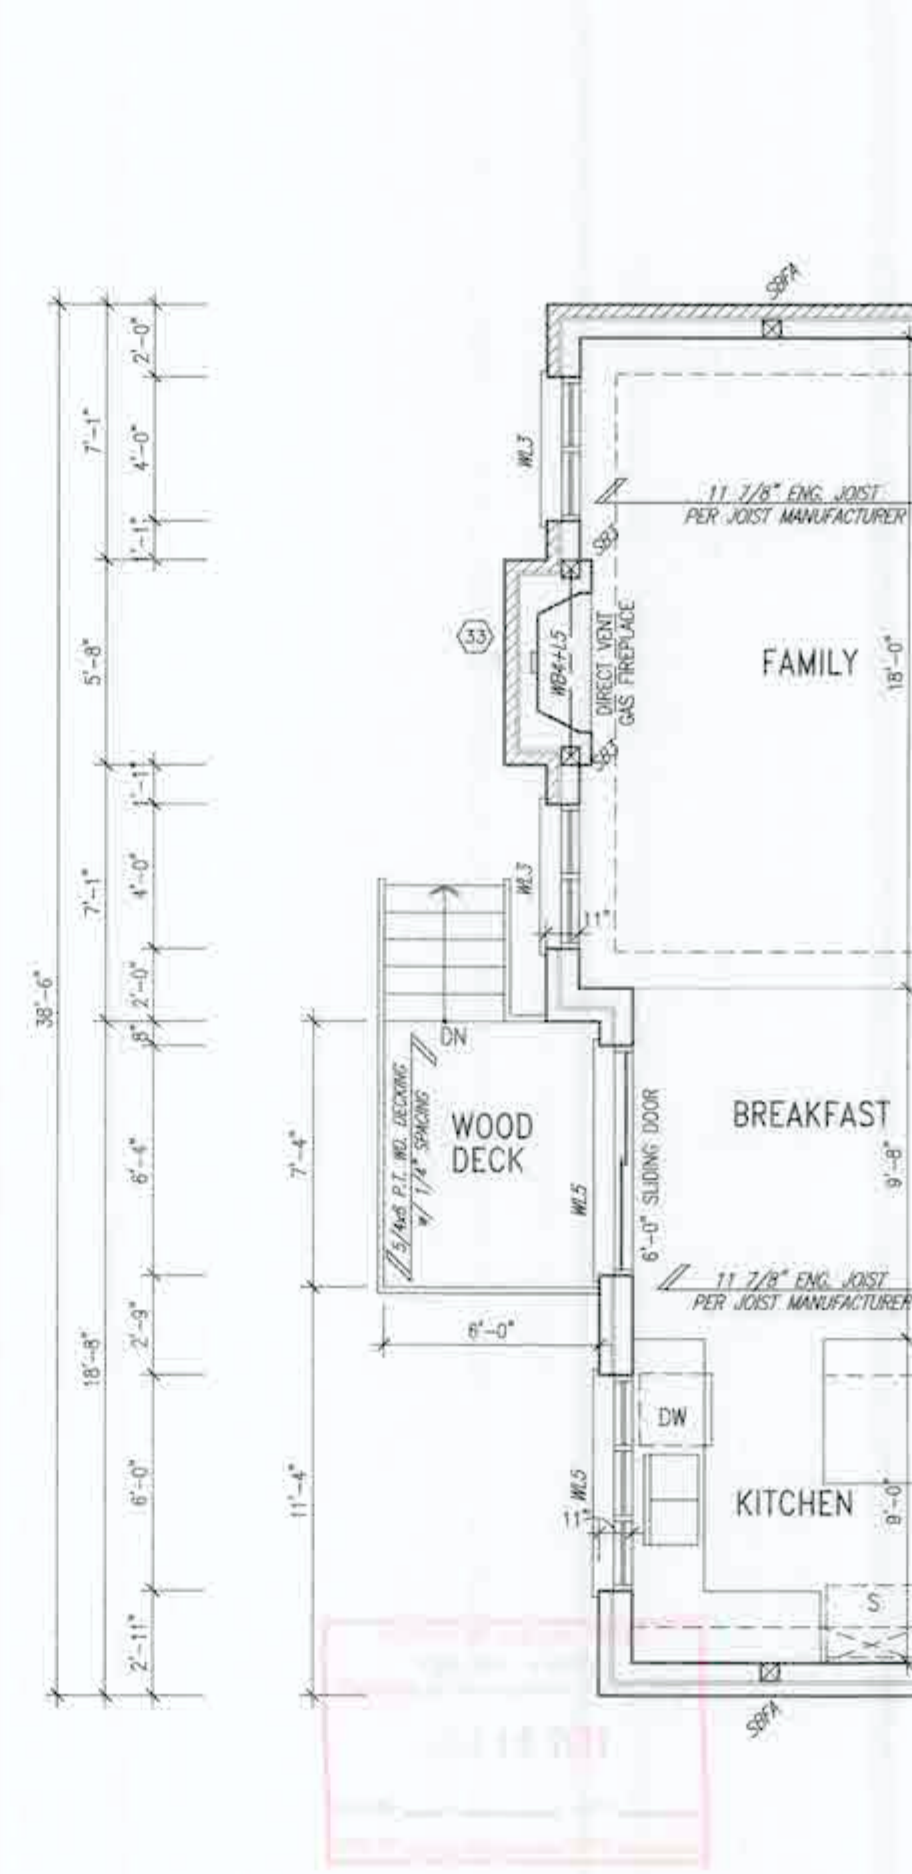PARTIAL BASEMENT PLAN
DECK CONDITION

PARTIAL GROUND FLOOR PLAN
DECK CONDITION

21-161938

Ok Jan 5/22

STRUDET INC.
FOR STRUCTURE ONLY

[illegible]

Figure 1. Schematic representation of the experimental design. The subjects were divided into two groups: the control group (CG) and the experimental group (EG). The CG was divided into two subgroups: the control group (CG) and the control group (CG). The EG was divided into two subgroups: the experimental group (EG) and the experimental group (EG). The CG was divided into two subgroups: the control group (CG) and the control group (CG). The EG was divided into two subgroups: the experimental group (EG) and the experimental group (EG).



EXTERIOR RAILINGS:
3'-6" HIGH RAILING IF LANDING IS MORE
THAN 5'-11" ABOVE FINISHED GRADE
AND 3'-0" HIGH RAILING WHEN LANDING
IS LESS THAN 5'-11" ABOVE ADJACENT
FINISHED GRADE.

ELEVATIONS NOT DRAWN TO ACTUAL GRADE.
REFER TO FINAL GRADING PLAN.

REAR ELEVATION '1'
DECK CONDITION

21-161939

8m Jan 5/22

It is the builder's complete responsibility to ensure that all plans submitted for approval fully comply with the Architectural Guidelines and all applicable regulations and requirements including zoning provisions and any provisions in the subdivision agreement. The Control Architect is not responsible in any way for examining or approving site (lotting) plans or working drawings with respect to any zoning or building code or permit matter or that any house can be properly built or located on the lot.

This is to certify that these plans comply with the applicable Architectural Design Guidelines approved by the City of HAMILTON

JORUN C. WILLIAMS LTD., ARCHITECT
ARCHITECTS, TORONTO, ONTARIO

DRAWN BY [Signature]
CHECKED BY [Signature]

DATE: JULY 6, 1987

This plan was prepared by JCL/WJS for the purpose of illustrating the proposed building.

[illegible]

All documents, specifications, related documents and design are the copyright property of VAI OFFICE. Reproduction of this report in whole or in part is strictly prohibited without VAI OFFICE's written permission.



EXTERIOR RAILINGS:
3'-6" HIGH RAILING IF LANDING IS MORE
THAN 5'-11" ABOVE FINISHED GRADE
AND 3'-0" HIGH RAILING WHEN LANDING
IS LESS THAN 5'-11" ABOVE ADJACENT
FINISHED GRADE.

ELEVATIONS NOT DRAWN TO ACTUAL GRADE.
REFER TO FINAL GRADING PLAN.

REAR ELEVATION '2'
DECK CONDITION

21-1161939

Sm Jan 5/22

It is the builder's complete responsibility to ensure that all plans submitted for approval fully comply with the Architectural Guidelines and all applicable regulations and requirements including zoning provisions and any provisions in the subdivision agreement. The Control Architect is not responsible in any way for examining or approving site (lotting) plans or working drawings with respect to any zoning or building code or permit matter or that any house can be properly built or located on its lot.

This is to certify that these plans comply with the applicable Architectural Design Guidelines approved by the City of HAMILTON.

JOHN C. WILLIAMS LTD., ARCHITECT
ARCHITECTS-INTERIORS
400 WYNN
WYNNE
Aug 17 2025
To our clients, we are pleased to have you as our client.
We are pleased to have you as our client.
We are pleased to have you as our client.

[illegible]



EXTERIOR RAILINGS:
3'-6" HIGH RAILING IF LANDING IS MORE
THAN 5'-11" ABOVE FINISHED GRADE
AND 3'-0" HIGH RAILING WHEN LANDING
IS LESS THAN 5'-11" ABOVE ADJACENT
FINISHED GRADE.

ELEVATIONS NOT DRAWN TO ACTUAL GRADE.
REFER TO FINAL GRADING PLAN.

REAR ELEVATION '3'
DECK CONDITION

It is the builder's complete responsibility to ensure that all plans submitted for approval fully comply with the Architectural Guidelines and all applicable regulations and requirements including zoning provisions and any provisions in the subdivision agreement. The Contractor/Architect is not responsible in any way for existing or approved site (utility) plans or working drawings with respect to any zoning or building code or permit matter or that any house can be properly built or located on its lot.

This is to certify that these plans comply with the applicable Architectural Design Guidelines approved by the City of Hamilton.

JOHN F. WILLIAMS LTD., ARCHITECT
ARCHITECTURAL CONTROL NUMBER
445-00000000
DATE: AUG 27, 2022
THIS CERTIFICATE COMPLIES WITH THE REQUIREMENTS OF THE ARCHITECTURAL DESIGN GUIDELINES APPROVED BY THE CITY OF HAMILTON.

18		9			
17		8			
16		7			
15		6			
14		5			
13		4	ISSUED FOR PERMIT	MAY 21/21	OW
12		3	REV. PER CLIENT/ROOF/F/L/ENG COMMENTS	APR 26/21	OW
11		2	REVISED PER CLIENT/ENG & LUMBER	MAR 31/21	OW
10		1	PRELIMINARY ISSUED FOR CLIENT REVIEW	MAR 12/21	OW
9					
8					
7					
6					
5					
4					
3					
2					
1					
0					

The undersigned has reviewed and taken responsibility for this design and has the qualifications and meets the requirements set out in the Ontario Building Code to be a Designer.
qualification information:
Richard Vink
signature
24488
BCN
42658
VA3 Design Inc.
Contractor must verify all dimensions on the job and report any discrepancy to the Designer before proceeding with the work. All drawings and specifications are instruments of service and the property of the Designer which must be returned at the completion of the work. Drawings are not to be copied.

VA3 DESIGN
255 Consumers Rd. Suite 120
Toronto, ON M2J 1R4
1.416.630.2255 1.416.630.4782
va3design.com

Greenpark.
project name: RUSSELL GARDENS PH. 4
location: HAMILTON, ON.
date: FEB. 2021
drawn by: D.BURTON
checked by: 3/16" = 1'-0"

SPRINGFIELD 1S
COMPLIANCE PACKAGE 'A1'
14.3m
project no: 20027
drawing no: A11b
file name: 20027-SPRINGFIELD-1S

21-161939

Jim Jan 5/22

SPRINGFIELD 1S
COMPLIANCE PACKAGE 'A1'



REAR ELEVATION '1'
WALK-UP BASEMENT
CONDITION

21-16193a

Im san s/m

It is the builder's complete responsibility to ensure that all plans submitted for approval fully comply with the Architectural Guidelines and all applicable regulations and requirements including zoning provisions and any provisions in the subdivision agreement. The Control Architect is not responsible in any way for examining or approving any (all) plans or working designs with respect to zoning or building code permit matters or that any proposed design is in compliance with all applicable laws and regulations.

This is to certify that these plans comply with the applicable Architectural Design Guidelines approved by the City of HAMILTON

JOHN C. WILLIAMS LTD., ARCHITECTS
ARCHITECTS • PLANNERS • DESIGNERS
10000 W. 10th Ave., Suite 100, Denver, CO 80231
Tel: 303-751-1111
Fax: 303-751-1112
www.jcwlliams.com

[illegible]

All libraries, universities, colleges, documents and series are the copyright property of VRI/RSN. Reproduction of this material in whole or in part is strictly prohibited without VRI/RSN's written permission.



REAR ELEVATION '3'
WALK-UP BASEMENT
CONDITION

21-161935

2 m Jan 5/2

It is the builder's complete responsibility to ensure that all plans submitted for approval fully comply with the Architectural Guidelines and all applicable regulations and requirements including zoning provisions and any provisions in the subdivision agreement. The Control Architect is not responsible in any way for examining or approving site (lotting) plans or working drawings with respect to any zoning or building code or permit matter or that any house can be properly built or located on the lot.

This is to certify that these plans comply with the applicable Architectural Design Guidelines approved by the City of HAMILTON.

JENNIFER E. WILLIAMS LTD. ARCHITECT
ARCHITECTURAL CONCEPTS
2001 E. 10TH AVE.
DENVER, CO 80202
TEL: 303.733.1111
FAX: 303.733.1112
WWW.JEWELLARCHITECT.COM


SPRINGFIELD 1S
COMPLIANCE PACKAGE 'A1'

Greenpark™	SPRINGFIELD 1 14.3m
-------------------	-------------------------------

GARDENS PH. 4	HAMILTON, ON.	project no. 2002
DEAD ELEVATION 13'	WALK UP BASEMENT CONDITION	drawing no.

[illegible]

All diagram specifications, related documents and design are the copyright property of VAI DESIGN. Reproduction of this property in whole or in part is strictly prohibited without VAI DESIGN's written consent.

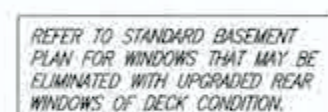


NOTE:
REFER TO STANDARD FLOOR PLANS
FOR ADDITIONAL INFORMATION.

VENEER CUT
WHEN VENEER CUT IS GREATER
THAN 26", A 10" POURED
CONCRETE FOUNDATION WALL IS
REQUIRED.


WOOD DECK AT WALKOUT DETAILS
REFER TO STANDARD DETAIL PACKAGE (PAGE 6)
FOR ADDITIONAL INFORMATION.

BASEMENT WALL INSULATION
(TYP) 13
-6" (R20) CONTINUOUS BLANKET
INSULATION. INSULATION
UNINTERRUPTED BY FRAMING.

**BASEMENT INSULATION AT
STAIR/SUNKEN AREAS**
-2" (R10) CONTINUOUS INSULATION
(RIGID OR SPRAY FOAM).
-2"x4" @ 16"o.c. w/ R12 BATT
INSULATION & 1/2" DRYWALL FINISH
-EXTEND EXTERIOR WALL FOOTING TO
SUPPORT 2"x4" WALL WHERE LOAD
BEARING.

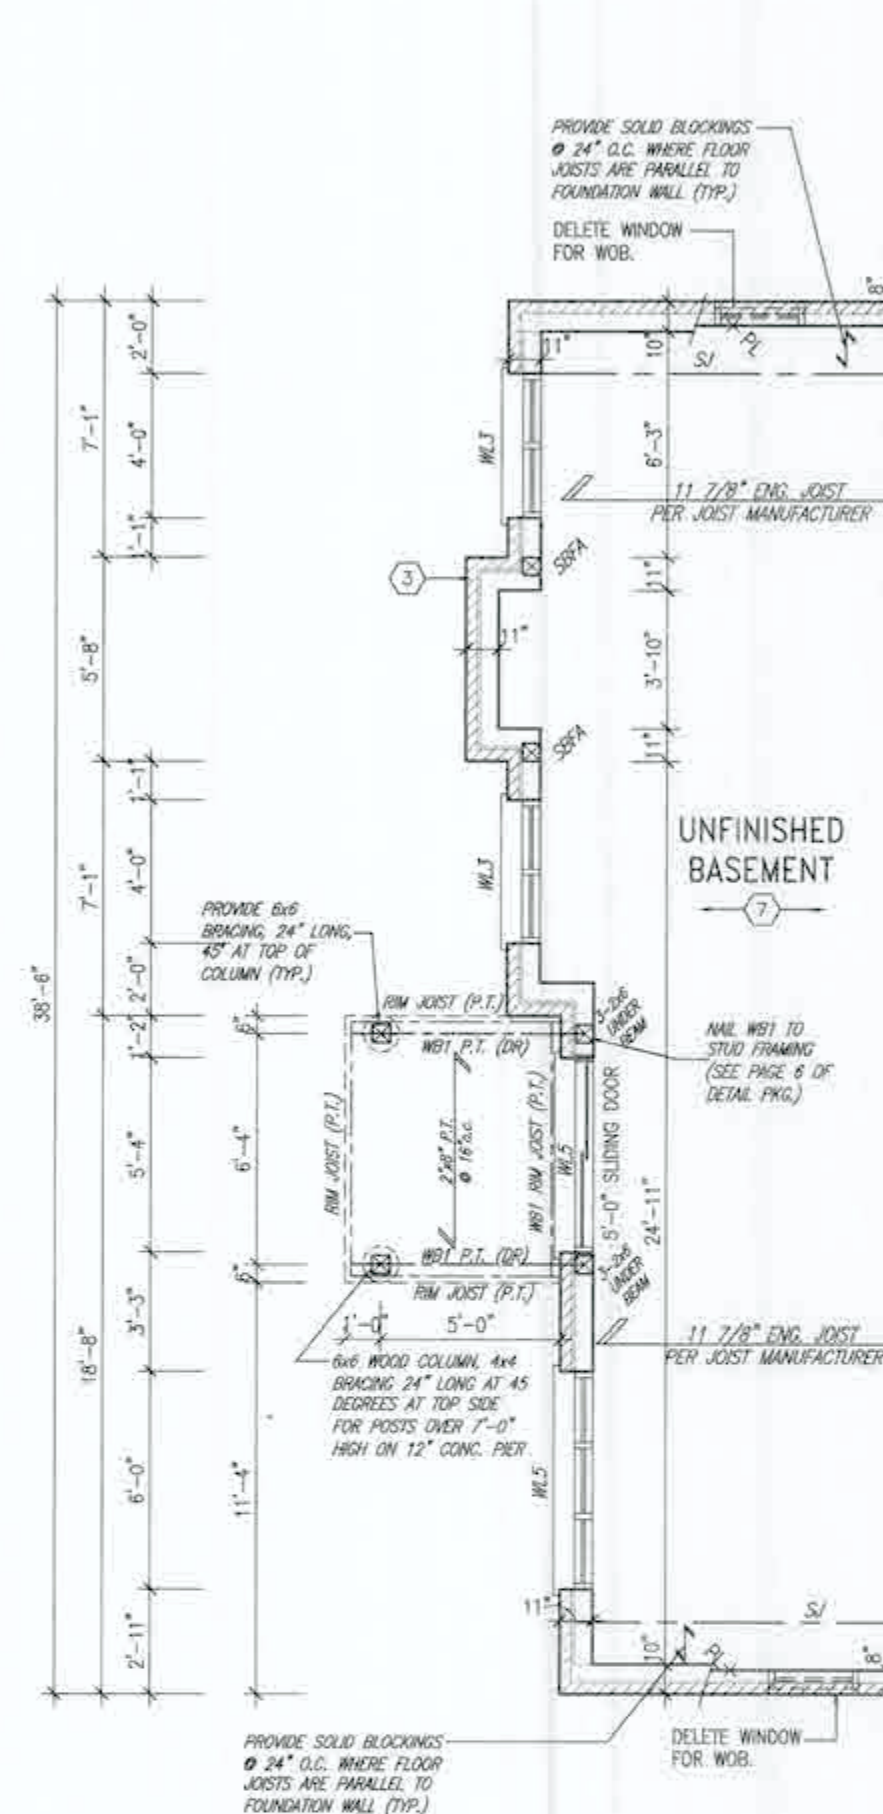

PARTIAL BASEMENT PLAN
WALK-OUT CONDITION

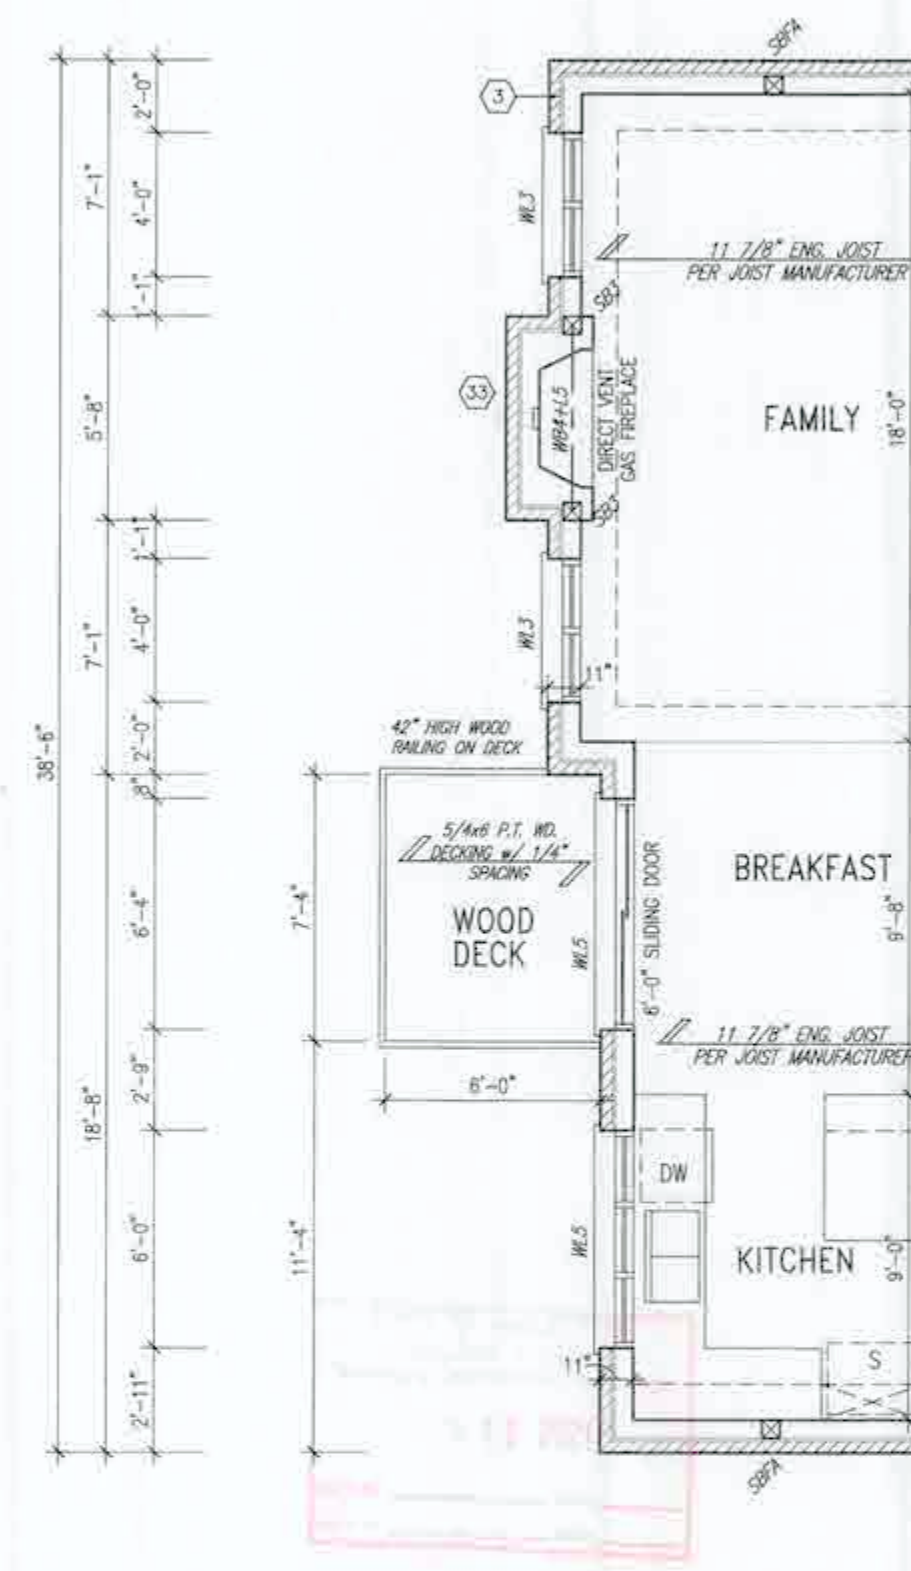

PARTIAL GROUND FLOOR PLAN
WALK-OUT CONDITION

Sm Jan 5/20

It is the builder's complete responsibility to ensure that all plans submitted for approval fully comply with the Architectural Guidelines and all applicable regulations and requirements including zoning provisions and any provisions in the subdivision agreement. The Control Architect is not responsible in any way for examining or approving site lotting plans, or working drawings with respect to any zoning or building code or permit matter or that any house can be properly built or located within the lot.

This is to certify that these plans comply with the applicable Architectural Design Guidelines approved by the City of HAMILTON.

KRUPP C. WILLIAMS LTD., ARCHITECT
4007732864, CHENGLU, HONGKONG

RECEIVED BY _____
(Date) AUG 12 2001

This stamp certifies completion of the registration process.
Order Confirmation may also apply as being
completing transaction.



18			9		
17			8		
16			7		
15			6		
14			5		
13			4	ADD WALK-OUT CONDITION.	JUN 03/21
12			3	ISSUED FOR PERMIT.	MAY 21/21
11			2	REV FOR CLIENT/ROOF/FL/ENG. COMMENTS	APR 26/21
10			1	REVISED PER CLIENT/ENG & LUMBER	MAR 31/21
9			0	PRELIMINARY ISSUED FOR CLIENT REVIEW	MAR 12/21
8	description	date	no	description	note

The undersigned has reviewed and takes responsibility for this design and how the qualifications meet the requirements set out in the Ontario Building Code to be a Designer: qualification information	Richard Vink	24
name registration information VAS Design Inc.	signature	42
Contractor must verify all dimensions on the job and report any discrepancy to the Designer before proceeding with the work. All drawings and specifications are instruments of service and the property of the Designer which must be returned at the completion of the project.		



Greenpark.
project name
RUSSELL GARDENS PH. 4 HAMILTON

SPRINGFIELD 1	14.3m	project n°	2002
---------------	-------	------------	------

SPRINGFIELD 1S
COMPLIANCE PACKAGE 'A1'

PARTIAL PLANS - WALK-OUT CONDITION

3/16" = 1'-0" 20027-SPRINGFIELD-1S

A14

All invoice specifications, related documents and design are the copyright property of SAS INSOFT. Reproduction of this property in whole or in part is strictly prohibited without SAS INSOFT's written consent.



ELEVATIONS NOT DRAWN TO ACTUAL GRADE.
REFER TO FINAL GRADING PLAN.

REAR ELEVATION '1'
WALK-OUT CONDITION

It is the builder's complete responsibility to ensure that all plans submitted for approval fully comply with the Architectural Guidelines and all applicable regulations and requirements including zoning provisions and any provisions in the subdivision agreement. The Control Architect is not responsible in any way for examining or approving site (nothing), plans or working drawings with respect to any zoning or building code or permit matter or that any house can be properly built or located on its lot.

This is to certify that these plans comply with the applicable Architectural Design Guidelines approved by the City of HAMILTON.

JOHNS L. WILLIAMS LTD., ARCHITECT
ARCHITECTURAL FIRM, INCORPORATED
AND SUCCESSORS

—
—
DATE: AUG. 27, 2012

This survey contains information about the respondent.
Please do not make any further use of this
information without permission.

18				5		
17				4		
16				7		
15				6		
14				5	ADD WALK-OUT CONDITION	JUN 03/21
13				4	ISSUED FOR PERMIT.	MAY 21/21
12				3	REV. PER CLIENT/ROOF/FL./ENG. COMMENTS	APR 26/21
11				2	REVISED PER CLIENT/ENG. & LUMBER	MAR. 31/21
10				1	PRELIMINARY, ISSUED FOR CLIENT REVIEW	MAR. 12/21
no. description date by no. description date						

The undersigned has reviewed and takes responsibility for this design and has the qualifications and meets the requirements set out in the Ontario Building Code to be a Designer.

qualification information

Richard Vink *R. Vink* 244

name signature

registration information

VAS Design Inc. 426

Contractor must verify all dimensions on the job and report any discrepancies to the Designer before proceeding with the work. As-built drawings and specifications are instruments of service and the property of the Designer which must be returned at the completion of the work. Drawings are not to be copied.

**VA3
DESIGN**
255 Consumers Rd Suite
Toronto ON M2J 1R4
(416) 630-2255 / 416-630-
va3design.com

Greenpark
 patch name
RUSSELL GARDENS PH. 4 HAMILTON
 date
9. 2021
 rear elevation '1' -
 by
BURTON
 checked by
 scale
3/16" = 1'-0"

SPRINGFIELD 1 14.3m		project no. 20027
K-OUT CONDITION file name 20027-SPRINGFIELD-15		drawing no. A15

SPRINGFIELD 1S
COMPLIANCE PACKAGE 'A1'

All drawings, specifications, model documents and design are the copyright property of VAI DESIGN. Reproduction of this property in whole or in part is strictly prohibited without VAI DESIGN's written permission.



ELEVATIONS NOT DRAWN TO ACTUAL GRADE.
REFER TO FINAL GRADING PLAN.

REAR ELEVATION '3'
WALK-OUT CONDITION

It is the builder's complete responsibility to ensure that all plans submitted for approval fully comply with the Architectural Guidelines and all applicable regulations and requirements including zoning provisions and any provisions in the subdivision agreement. The Control Architect is not responsible in any way for examining or approving site (lotting) plans or working drawings with respect to any zoning or building code or permit matter or that any house can be properly built or located on its lot.

This is to certify that these plans comply with the applicable Architectural Design Guidelines approved by the City of HAMILTON

RHON G. WILLIAMS LTD., ARCHITECT
ARCHITECTURAL CONTROL NUMBER
AAC-0986074

WILLIAMS LTD.
Date: JULY 27, 1981

"This plan reflects comments and all the questions
Design Engineers may have at this time."
(symbolic illustration)

18			5				The undersigned has reviewed and taken responsibility for this design and has the qualifications that meets the requirements set out in the Ontario Building Code to be a Designer.
17			6				Qualification Information:
16			7				
15			8				
14			9	ADD WALK-OUT CONDITION	JUN 03/21	WT	Richard Vink 2448
13			10	ISSUED FOR PERMIT	MAY 21/21	OW	signature 90
12			11	REV. PER CLIENT/ROOF/H/L/ENG. COMMENTS	APR 26/21	OW	VAS Design Inc. 4285
11			12	REVISED PER CLIENT/ENG. & LUMBER	MAR. 31/21	OW	Contractor must verify all dimensions on the job and report any discrepancies to the Designer (written) immediately with the results.
10			13	1. PRELIMINARY ISSUED FOR CLIENT REVIEW	MAR. 12/21	OW	All drawings and specifications are instruments of service and the property of the Designer which must be returned at the completion of the project. All dimensions are set at the discretion of the Designer.
9	description	date	by	description	date	by	

All drawings, specifications, related documents and design are the copyright property of WJ3 DESIGN. Reproduction of this property in whole or in part is strictly prohibited without WJ3 DESIGN's written permission.

SPRINGFIELD 1S
COMPLIANCE PACKAGE 'A1'

Greenpark.

SPRINGFIELD 1
14.3m

project name	municipality	project no.
RUSSELL GARDENS PH. 4	HAMILTON, ON.	20027

date FEB. 2021 REAR ELEVATION '3' - WALK-OUT CONDITION drawing no. A15L

2 D.BURTON 3/16" = 1'-0" 20027-SPRINGFIELD-15

A15b

UPGRADED REAR ELEVATION '2'
WALK-OUT CONDITION

[illegible]

17	18	19	479	4
----	----	-----	-----	---

SPRINGFIELD 1S
COMPLIANCE PACKAGE 'A1'



Greenpark

SPRINGFIELD 1	14.3m
---------------	-------



255 Consumers Rd. Suite 101
Toronto, ON M2J 1P9
1 416.530.2255 / 416.630.2255
un3dvision.com

project name	municipality	project no.
RUSSELL GARDENS PH. 4	HAMILTON, ON.	2002
date	drawing no.	drawing no.

FEB. 2021		UPGRADED REAR ELEV. 2' - WALKOUT CONDITION		
Drawn by	checked by	80046	File name	
D.BURTON	3/16" = 1'-0"	20027-SPRINGFIELD-15		A16c

A16c

10