

CONSTRUCTION SUMMARY

Mountainview Heights 3 (G) - Russell Gardens Building Ltd.

PURCHASERS: Warren W. SAMUEL and Faheema WARDAK TEL: RES.: 416-740-8676 BUS.: 647-206-1684

LOT / PHASE 375 / 4	REG. PLAN # 62M-1266	HOUSE TYPE Springfield One (4 Bedroom) Elev 1		
------------------------	-------------------------	--	--	--

CABINETRY

1 - KITCHEN - SHIFT STOVE TO ACCOMMODATE BUILT-IN APPLIANCES 03Nov21 Note:	
1 - KITCHEN - DELETE CABINETS ABOVE STOVE - VENDOR WILL SUPPLY 6 INCH VENT AS PER CONSTRUCTION SPECIFICATIONS AND VENT MAY NOT BE IN THE APPROPRIATE LOCATION FOR INSTALLATION OF PURCHASER SUPPLIED VENT - PURCHASER TO SUPPLY OWN FAN AFTER CLOSING 03Nov21 Note: TEMPORARY HOOD FAN MAY BE PROVIDED	
1 - KITCHEN - LIGHT VALANCE - NO ELECTRICAL 03Nov21 Note:	
1 - KITCHEN - CM 11 CROWN MOULDING 03Nov21 Note:	
1 - CABINETRY - KITCHEN - UPGRADE 2 03Nov21 Note:	
1 - CABINETRY PROVISION - PROVISION FOR PLUG ON ISLAND (PLUG EXTRA ORDERED SEPARATELY) 03Nov21 Note:	

CABINETRY ACCESSORIES

1 - KITCHEN CABINETRY UPPER - FULL DEPTH ABOVE FRIDGE - WITH GABLES - 600MM - PRICE IS EACH - UPGRADE 2 03Nov21 Note:	
1 - KITCHEN CABINETRY BASE - POT/PAN DRAWERS (CABINET) - UPGRADE 2 03Nov21 Note:	
1 - KITCHEN CABINETRY BASE - PULLOUT WIRE SPICE RACK - PRICE IS EACH 03Nov21 Note:	
1 - KITCHEN CABINETRY BASE - PULLOUT RECYCLE 2 BIN - PRICE IS EACH 03Nov21 Note:	
1 - KITCHEN CABINETRY - BUILT-IN MICROWAVE/OVEN COMBO - UPGRADE 2 03Nov21 Note:	

CERAMIC TILE

1 - DELETE ALL CERAMIC BATHROOM ACCESSORIES - DELETE TOWEL BAR, PAPER HOLDER & SOAP DISH THROUGHOUT 03Nov21 Note:	
1 - TILE - UPGRADE 4 FLOOR TILE - - POWDER ROOM 03Nov21 Note:	
1 - TILE - UPGRADE 4 FLOOR TILE - - MUD ROOM 03Nov21 Note:	
1 - TILE - UPGRADE 4 FLOOR TILE - - KITCHEN 03Nov21 Note:	
1 - TILE - UPGRADE 4 FLOOR TILE - - FOYER 03Nov21 Note:	



CONSTRUCTION SUMMARY

Mountainview Heights 3 (G) - Russell Gardens Building Ltd.

PURCHASERS: Warren W. SAMUEL and Faheema WARDAK

TEL: RES.: 416-740-8676 BUS.: 647-206-1684

LOT / PHASE 375 / 4	REG. PLAN # 62M-1266	HOUSE TYPE Springfield One (4 Bedroom) Elev 1		
------------------------	-------------------------	--	--	--

1 - TILE - UPGRADE 1 FLOOR TILE - - LAUNDRY ROOM 03Nov21 Note:	
1 - TILE - UPGRADE 1 WALL TILE - - ENSUITE BATHROOM - SHOWER 03Nov21 Note:	
1 - TILE - UPGRADE 1 FLOOR TILE - - ENSUITE BATHROOM - FLOOR 03Nov21 Note:	
1 - TILE - UPGRADE 1 WALL TILE - - BATHROOM 2 - SHOWER 03Nov21 Note:	
1 - TILE - UPGRADE 1 FLOOR TILE - - BATHROOM 2 - FLOOR 03Nov21 Note:	
1 - TILE - UPGRADE 2 WALL TILE - - BATHROOM 3/4 - TUB 03Nov21 Note:	
1 - TILE - UPGRADE 2 FLOOR TILE - - BATHROOM 3/4 - FLOOR 03Nov21 Note:	

CONSTRUCTION

1 - KITCHEN - SHIFT STOVE TO ACCOMMODATE BUILT-IN APPLIANCES 03Nov21 Note:	
1 - DELETE BULK HEADS IN KITCHEN IF CONSTRUCTION PERMITS 03Nov21 Note:	
1 - SMOOTH CEILINGS ON FIRST FLOOR ONLY - DET 03Nov21 Note:	
1 - LOWER LEVEL - BASEMENT 8 FOOT 6 INCH CONCRETE POUR - MEASURED FROM TOP OF FOOTING TO TOP OF FOUNDATION WALL 25May21 Note:	
3 - ENLARGE BASEMENT WINDOWS (MAY REQUIRE WINDOW WELLS) - WINDOW IS 30 INCHES X 24 INCHES 25May21 Note:	

COUNTER TOP

1 - KITCHEN COUNTER TOP - IN LIEU OF STANDARD AS PER OFFER 03Nov21 Note:	
---	--

ELECTICAL

1 - ***DELETE - PLUG – ROUGH-IN FOR ELECTRIC CAR PLUG IN GARAGE – FOR FUTURE ELECTRIC CAR – 240V / 40-50 AMPS 09Nov21 Note: SPECIFICATIONS REQUIRED	
1 - ***DELETE - PLUG – ROUGH-IN FOR ELECTRIC CAR PLUG IN GARAGE – FOR FUTURE ELECTRIC CAR – 240V / 40-50 AMPS 03Nov21 Note: SPECIFICATIONS REQUIRED	

ELECTRICAL

1 - BUILT IN OVEN AND MICRO PROVISION - PROVISION ONLY - ELECTRICAL ONLY 03Nov21 Note:	
---	--



CONSTRUCTION SUMMARY

Mountainview Heights 3 (G) - Russell Gardens Building Ltd.

PURCHASERS: Warren W. SAMUEL and Faheema WARDAK

TEL: RES.: 416-740-8676 BUS.: 647-206-1684

LOT / PHASE 375 / 4	REG. PLAN # 62M-1266	HOUSE TYPE Springfield One (4 Bedroom) Elev 1		
------------------------	-------------------------	--	--	--

1 - 200 AMP ELECTRICAL SERVICE 03Nov21 Note:	
1 - PLUG - ELECTRICAL PLUG - TO BE INSTALLED OVER FIREPLACE 03Nov21 Note:	
1 - PLUG - ELECTRICAL PLUG - ADD TO ISLAND 03Nov21 Note:	
1 - RELOCATE STANDARD KITCHEN LIGHT TO BE CENTERED OVER ISLAND 03Nov21 Note:	
1 - POT LIGHT - LED - FIRST FLOOR INSTALLATION - INSTALLED ON SEPERATE SWITCH FROM STANDARD LIGHT - KITCHEN WORKSPACE 03Nov21 Note:	
1 - POT LIGHT - LED - FIRST FLOOR INSTALLATION - INSTALLED ON SEPERATE SWITCH FROM STANDARD LIGHT - KITCHEN BREAKFAST 03Nov21 Note:	
1 - POWDER ROOM - INSTALL LIGHT ON WALL ABOVE MIRROR - IF CONSTRUCTION PERMITS 03Nov21 Note:	

FIREPLACE AND ACCESSORIES

1 - GAS LINE ROUGH-IN FOR BARBECUE - FIRST FLOOR 03Nov21 Note:	
1 - GAS LINE ROUGH-IN FOR STOVE (INCLUDES ELECTRICAL OUTLET) - FIRST FLOOR 03Nov21 Note:	

HARDWOOD FLOORING

1 - LAMINATE – UPGRADE TO PARKLANE SERIES IN LIEU OF STANDARD LAMINATE 03Nov21 Note:	
1 - HARDWOOD - GROUP B SERIES 5 INCH - IN LIEU OF 2 1/4 INCH NATURAL RED OAK - - MAIN HALL 03Nov21 Note:	
1 - HARDWOOD - GROUP B SERIES 5 INCH - IN LIEU OF 2 1/4 INCH NATURAL RED OAK - - LIVING ROOM 03Nov21 Note:	
1 - HARDWOOD - GROUP B SERIES 5 INCH - IN LIEU OF 2 1/4 INCH NATURAL RED OAK - - LIBRARY/DEN 03Nov21 Note:	
1 - HARDWOOD - GROUP B SERIES 5 INCH - IN LIEU OF 2 1/4 INCH NATURAL RED OAK - - FAMILY ROOM 03Nov21 Note:	
1 - HARDWOOD - GROUP B SERIES 5 INCH - IN LIEU OF 2 1/4 INCH NATURAL RED OAK - - DINING ROOM 03Nov21 Note:	

MIRRORS AND GLASS

1 - FRAMELESS GLASS SHOWER DOOR & PANEL ABOVE SEAT - INCLUDES CHROME KNOB & HINGES 03Nov21 Note:	
---	--

PROMOTIONAL



CONSTRUCTION SUMMARY

Mountainview Heights 3 (G) - Russell Gardens Building Ltd.

PURCHASERS: Warren W. SAMUEL and Faheema WARDAK TEL: RES.: 416-740-8676 BUS.: 647-206-1684

LOT / PHASE 375 / 4	REG. PLAN # 62M-1266	HOUSE TYPE Springfield One (4 Bedroom) Elev 1		
------------------------	-------------------------	--	--	--

1 - LESS CREDIT FROM PURCHASER EXTRA SHEET IN OFFER 25May21 Note:	
--	--

STAIRS AND RAILINGS

1 - STAIRCASE - 1¾" SQUARE PICKETS 03Nov21 Note:	
1 - STAINED STAIRS – STANDARD STAIRCASE - PRICE IS PER SET 03Nov21 Note:	
1 - STAIRCASE - V GROOVE HANDRAIL 03Nov21 Note:	

EXTRAS AS PER OFFER

PURCHASER(S) ACKNOWLEDGES THAT THE PURCHASE PRICE IS INCLUSIVE OF ALL CREDITS AND PROMOTIONAL PACKAGES AVAILABLE AT TIME OF PURCHASE. Worksheet Note:	
(1) The Vendor agrees that notwithstanding any other term or provision in this Agreement included in the Purchase Price and in addition to those items detailed in Schedule GP to the Agreement of Purchase and Sale, the Purchaser is entitled to a credit of Worksheet Note:	
Granite kitchen counter top, from Vendor?s standard samples Worksheet Note:	

This Document is Extremely Time Sensitive - Printed 9 Nov 21 at 13:30

Purchasers:

Warren W. SAMUEL & Faheema WARDAK

Property: 375

Telephone Res. / Bus:

(416) 740-8676 / (647) 206-1684

Project: Russell Gardens Building Ltd.

Decor Advisor:

Candace Forza

Model and Elevation: Springfield One (4 Bedroom) Elev 1

Lock Date:

3-Nov-21

3-Nov-21

Plan #: 62M-1266

Layout Changes: ☒ Yes ☐ No

Sketch Attached: ☒ Yes ☐ No

Exterior Colour Scheme:

1. Cabinetry

	Style and Colour	Hardware
Kitchen / Breakfast	HAMPTON 821 INDUSTRIAL GRAPHITE	431SA
Laundry Room	ELISSE	Standard
Powder Room	MONACO 823 DRIFT WOOD	431SA
Master Ensuite Bathroom	MONACO 350 PLATINUM SILVER	431SA
Ensuite Bath - Bedroom 2	DORAL H3453 LAVA GREY FLEETWOOD	410SA
Ensuite Bath - Bedroom 3/4	DORAL W-500	431SA
	N/A	N/A
	N/A	N/A
	N/A	N/A

Appliances:

Built In Appliances ☒ Yes ☐ No

Slide In Stove ☐ Yes ☒ No

Dishwasher Cabinet

☐ Closed ☒ Open

41" Upper Cabinets ☒ Yes ☐ No

Please NOTE: Standard Cabinet Height is 30"

Stove Opening

NOTE: If not specified, opening will be set to builder's standard opening of approximately 30" width

Fridge Opening

NOTE: If not specified, opening will be set to builder's standard opening of approximately 37" width x 74" height

** Refer to Construction Summary

2. Counters

	Counter	Edge
Kitchen / Breakfast	QUARTZ-ISTRIA	#360
Laundry Room	N/A	
Powder Room	LAMINATE-PALOMA POLAR 6698-46	
Master Ensuite Bathroom	LAMINATE-WHITE CARRARA 4924-38	
Ensuite Bath - Bedroom 2	LAMINATE-PALOMA POLAR 6698-46	
Ensuite Bath - Bedroom 3/4	LAMINATE-WHITE TIGRIS 4783-60	
	N/A	
	N/A	
	N/A	

** Refer to Construction Summary

Initials:

Purchasers:Warren W. SAMUEL & Faheema WARDAK

Telephone Res. / Bus: (416) 740-8676 / (647) 206-1684

Decor Advisor: Candace Forza

Lock Date: 3-Nov-21

Property: 375

Project: Russell Gardens Building Ltd.

Model and Elevation: Springfield One (4 Bedroom) Elev 1

Plan #: 62M-1266

3. Ceramic Flooring

		At a 45	Threshold-If App.
Entrance Vestibule	TILE-LITIUM PEARL POLISHED-24X24 ✓	<input type="checkbox"/>	metal strip where applicable
Main Hall	STRIP	<input type="checkbox"/>	
Kitchen / Breakfast	TILE-LITIUM PEARL POLISHED-24X24 ✓	<input type="checkbox"/>	
Laundry Room	TILE-LIFE ICE-12X24 ✓	<input type="checkbox"/>	
Powder Room	TILE-LITIUM PEARL POLISHED-24X24 ✓	<input type="checkbox"/>	
Master Ensuite Bathroom	TILE-STONE WHITE12 1/4 x 24 1/4	<input type="checkbox"/>	
Ensuite Bath - Bedroom 2	TILE-STONE LTE GREY-12 1/4 X 24 1/4	<input type="checkbox"/>	
Ensuite Bath - Bedroom 3/4	TILE-AXIS LIGHT GREY NAT-12X24	<input type="checkbox"/>	
GARAGE/SIDE ENTRY	TILE-LITIUM PEARL POLISHED-24X24 ✓	<input type="checkbox"/>	
	N/A	<input type="checkbox"/>	
	N/A	<input type="checkbox"/>	

** Refer to Construction Summary

4. Ceramic Wall Tile

Master Ensuite Bathroom	Selection	Describe
Tub Deck Wall	N/A	
Tub Deck	N/A	
Tub Deck Skirt	N/A	
Shower Stall	TILE-STONE WHITE12 1/4 x 24 1/4 ✓	
Bathtub Enclosure Walls	N/A	
Ensuite Bath - Bedroom 2	TILE-STONE WHITE12 1/4 x 24 1/4	
Ensuite Bath - Bedroom 3/4	TILE-AXIS BIANCO NAT-12X24	
GARAGE/SIDE ENTRY	N/A	
	N/A	
	N/A	
	N/A	
Kitchen Backsplash	N/A	

** Refer to Construction Summary - STANDARD GROUT THROUGHOUT UNLESS SPECIFIED

5. Plumbing Fixtures

All Bathrooms

White

N/A

N/A

Whirlpool

N/A

☐ Yes ☒ No

Dishwasher Rough-In ☒ Yes ☐ No

Waterline for Fridge ☐ Yes ☒ No

** Refer to Construction Summary

6. Trim Carpentry

Interior Doors	CARRARA-SMOOTH
Interior Trim	As Per Construction Specifications
Door Handles	As Per Construction Specifications
Exterior Front Door Handle	As Per Construction Specifications

** Refer to Construction Summary

Initials:  

Purchasers:Warren W. SAMUEL & Faheema WARDAK

Telephone Res. / Bus: (416) 740-8676 / (647) 206-1684

Decor Advisor: Candace Forza

Lock Date: 3-Nov-21

Property: 375

Project: Russell Gardens Building Ltd.

Model and Elevation: Springfield One (4 Bedroom) Elev 1

Plan #: 62M-1266

7. Other Flooring

Main Hall	STRIP-NSS-WIRE BRUSHED-CHARACTER-UV URETHANE OIL-RED OAK-PEWTER-5"
Living Room	STRIP-NSS-WIRE BRUSHED-CHARACTER-UV URETHANE OIL-RED OAK-PEWTER-5"
Dining Room	STRIP-NSS-WIRE BRUSHED-CHARACTER-UV URETHANE OIL-RED OAK-PEWTER-5"
Family Room	STRIP-NSS-WIRE BRUSHED-CHARACTER-UV URETHANE OIL-RED OAK-PEWTER-5"
Den / Library / Study	STRIP-NSS-WIRE BRUSHED-CHARACTER-UV URETHANE OIL-RED OAK-PEWTER-5"
Basement Landing(If Applies)	N/A
Lower Landing (If Applies)	STRIP-NSS-WIRE BRUSHED-CHARACTER-UV URETHANE OIL-RED OAK-PEWTER-5"
Upper Landing	STRIP-NSS-WIRE BRUSHED-CHARACTER-UV URETHANE OIL-RED OAK-PEWTER-5"
Upper Hall	LAMINATE-PARKLANE-NEWCASTLE OAK DARK-TL-EL-3581
Master Bedroom	LAMINATE-PARKLANE-NEWCASTLE OAK DARK-TL-EL-3581
Bedroom #2	LAMINATE-PARKLANE-NEWCASTLE OAK DARK-TL-EL-3581
Bedroom #3	LAMINATE-PARKLANE-NEWCASTLE OAK DARK-TL-EL-3581
Bedroom #4	LAMINATE-PARKLANE-NEWCASTLE OAK DARK-TL-EL-3581
Bedroom #5	N/A
FLEX ROOM	LAMINATE-PARKLANE-NEWCASTLE OAK DARK-TL-EL-3581
	N/A
	N/A
Underpad	TypeArea
	N/AN/A

** Refer to Construction Summary

8. Railings and Pickets

Railing Type	V-GROOVE	Complimenting Colour	VINTAGE PEWTER RED OAK
Picket Type	1 3/4" SQUARE PICKETS	Complimenting Colour	VINTAGE PEWTER RED OAK
Stringer / Riser	AS PER CONSTRUCTION SPECIFICATIO	Complimenting Colour	VINTAGE PEWTER RED OAK
Treads	AS PER CONSTRUCTION SPECIFICATIO	Complimenting Colour	VINTAGE PEWTER RED OAK
Red Oak Stairs <input checked="" type="radio"/> Yes <input type="radio"/> No			

** Refer to Construction Summary THE STAIN COLOURS OR FINISH AVAILABLE ON RISERS, TREADS, PICKETS AND RAILS (STAIRCASES), WILL NOT BE AN EXACT MATCH TO PREFINISHED HARDWOOD OR LAMINATE FLOORS.

9. Wall Paint Flat Finish

Main & Upper Hall	22 WARM GREY	Master Bedroom	22 WARM GREY
Living Room	22 WARM GREY	Bedroom #2	22 WARM GREY
Dining Room	22 WARM GREY	Bedroom #3	22 WARM GREY
Kitchen / Breakfast	22 WARM GREY	Bedroom #4	22 WARM GREY
Family Room	22 WARM GREY	Bedroom #5	N/A
Powder Room	22 WARM GREY	Master Ensuite	22 WARM GREY
Laundry Room	22 WARM GREY	Ensuite Bath - Bedroom 2	22 WARM GREY
Den/Library	22 WARM GREY	Ensuite Bath - Bedroom 3/4	22 WARM GREY
Trim & Door Paint-Semi Gloss	BIRCH WHITE	FLEX ROOM	22 WARM GREY
	N/A		N/A
	N/A		N/A
Smooth Ceilings First Floor	<input checked="" type="radio"/> Yes <input type="radio"/> No		

** Refer to Construction Summary

Initials:  

Purchasers: Warren W. SAMUEL & Faheema WARDAK Property: 375
Telephone Res. / Bus: (416) 740-8676 / (647) 206-1684 Project: Russell Gardens Building Ltd.
Decor Advisor: Candace Forza Model and Elevation: Springfield One (4 Bedroom) Elev 1
Lock Date: 3-Nov-21 3-Nov-21 Plan #: 62M-1266

10. Plaster Mouldings and Medallions

Entrance Vestibule	N/A	N/A	Kitchen/Breakfast	N/A	N/A
Main Hall	N/A	N/A	Den/Library	N/A	N/A
Living Room	N/A	N/A	Lower Landing	N/A	N/A
Dining Room	N/A	N/A		N/A	N/A
Family Room	N/A	N/A		N/A	N/A

** Refer to Construction Summary

11. Fireplace

Living Room			Family Room			Other Room - Specify		
Purchased	As Per Plan	N/A	Purchased	As Per Plan	N/A	Purchased	As Per Plan	N/A
<input type="radio"/>	<input type="radio"/>	<input checked="" type="radio"/>	<input type="radio"/>	<input checked="" type="radio"/>	<input type="radio"/>	<input type="radio"/>	<input type="radio"/>	<input checked="" type="radio"/>
Fireplace Type	N/A		FLAT ON WALL		N/A		N/A	
Mantle Type	N/A		MANTLE M2-STANDARD		N/A		N/A	
Colour / Stain	N/A		AS PER CONSTRUCTION SPECIFICATIONS		N/A		N/A	
Surround	N/A		NERO		N/A		N/A	
Hearth	N/A		NO		N/A		N/A	

** Refer to Construction Summary

12. Heating and Air Conditioning

Air Conditioning	NO	Gas Provisions Stove	YES
Gas Provisions Dryer	NO	Gas Provisions Barbecue	YES
Comment			

** Refer to Construction Summary

13. Electrical

Plugs and Switches	<input checked="" type="radio"/> White	DECOR	Above Kitchen Cabinet Light	<input type="radio"/> Yes <input checked="" type="radio"/> No
Hood Fan	STANDARD WHITE TEMP.		Below Kitchen Cabinet Light	<input type="radio"/> Yes <input checked="" type="radio"/> No
Appliances	Built in Cooktop	Built in Oven	Gas Stove	Microwave
	<input type="radio"/> Yes <input checked="" type="radio"/> No	<input checked="" type="radio"/> Yes <input type="radio"/> No	<input checked="" type="radio"/> Yes <input type="radio"/> No	<input checked="" type="radio"/> Yes <input type="radio"/> No
Dishwasher Rough-in	Yes			

** Refer to Construction Summary

14. General Comments


** Refer to Construction Summary

Disclaimers and Notes

- Colours of all materials are as close as possible to builder's selection, but not necessarily identical due to variances in manufacturing.
- Any extras listed above are null and void unless accompanied by a separate invoice/amendment. Said invoice must be paid in full.
- The Purchaser agrees that this colour selection is final and that no changes will be permitted, unless required by the Vendor.
- The Purchaser acknowledges reading and accepting document which contains other miscellaneous disclaimers.

Signature:  Date: 11/03/2021 Signature:  Date: 11/03/2021

enpark GROUP

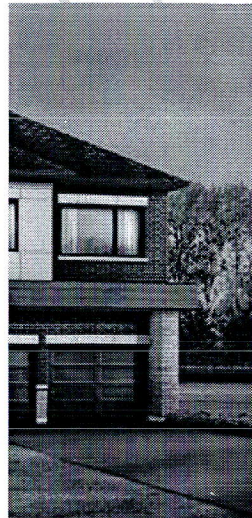

Shift
Stove

Glas Line
R.I for
BBQ.

1 Potlight




Add Plug
Above Fireplace

1 Potlight



Relocate
Std
Light
Above
Island

Plug for
B.I. over
micro

Add Plug
On
Island

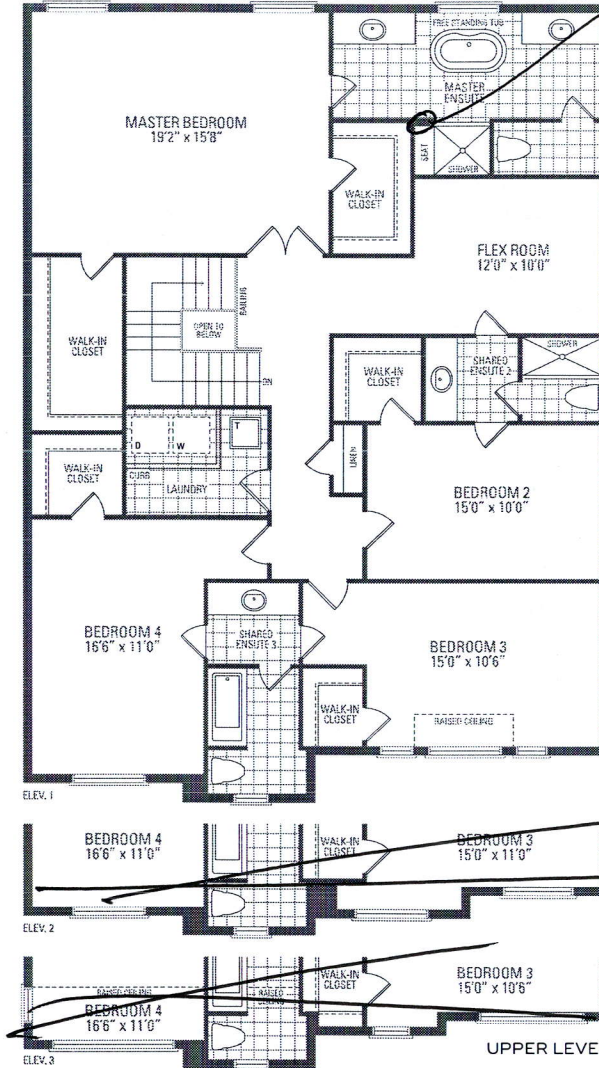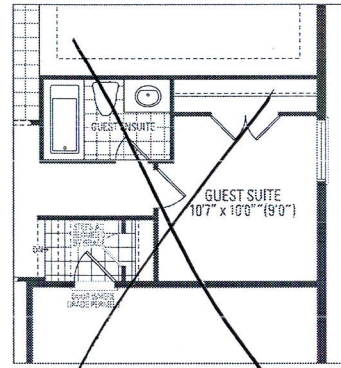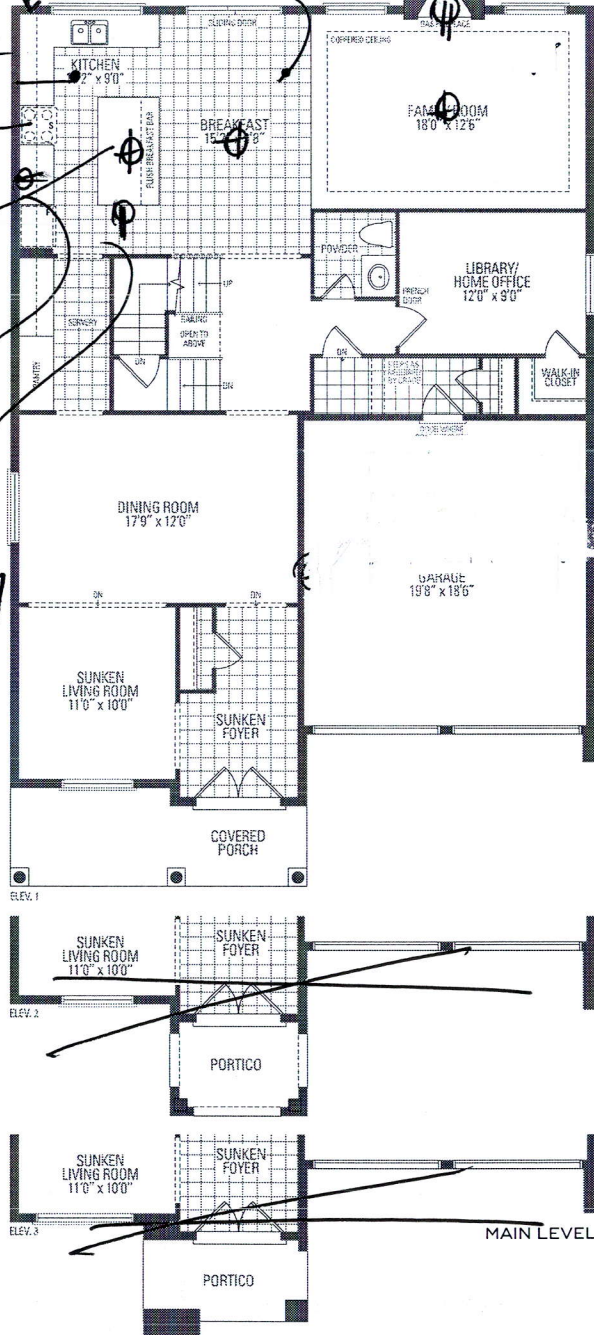

Delete Wall
Frameless Glass
Door + Panel
Above Seat

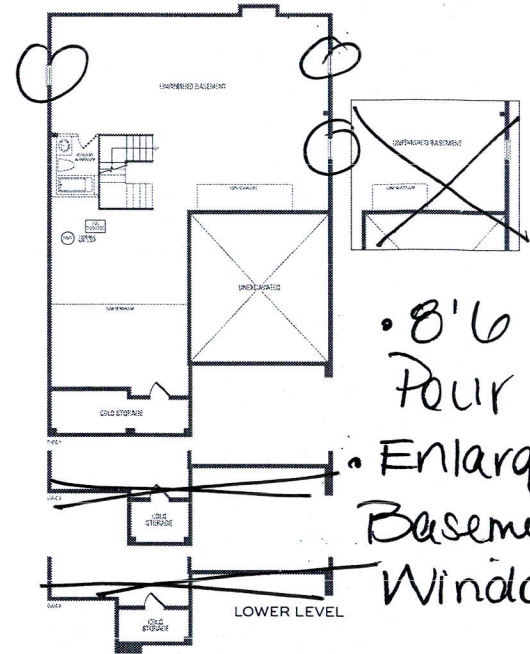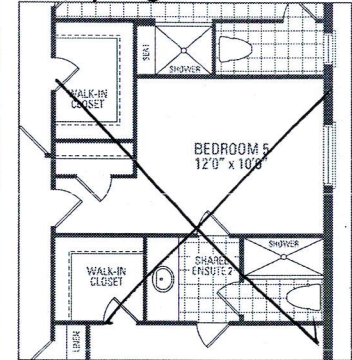

• 8'6
Four

• Enlarge
Basement
Windows


SPRINGFIELD ONE ELEV. 1 • 3,469 sq.ft. | ELEV. 2 • 3,502 sq.ft. | ELEV. 3 • 3,487 sq.ft.



Kitchen

- upg 2 Hampton Cabinetry.
- Light+Valance
- cm 11 moulding.

Shift stove + delete cabinet above

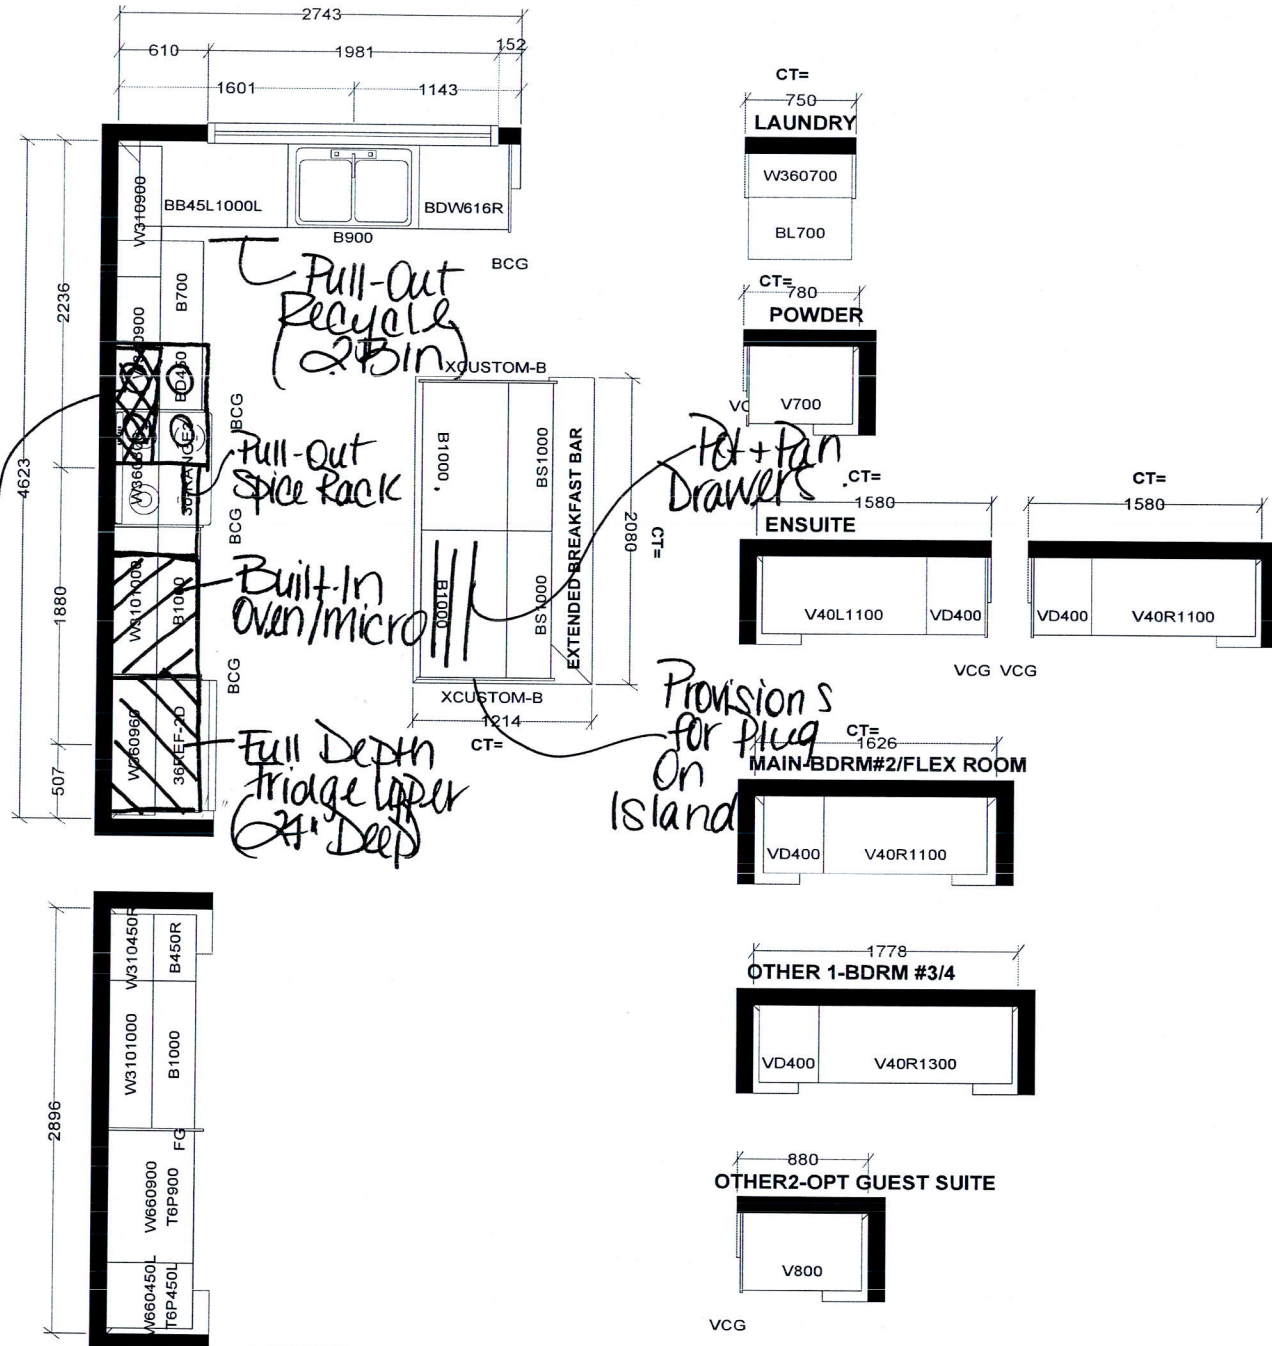

KITCHEN

Selba Industries				J #
W WIDTH	W HGHT	W CNT	This drawing is the intellectual property of SELBA INDUSTRIES INC. and is an original design which must not be released or copied unless applicable fee has been paid or job order placed.	
FLOOR HGHT	DOOR HGHT		JOB NUMBER:	
ST CENT	2X4	VENT BOX COVER	BUILDER: GREENPARK	
			SITE: RUSSELL GARDENS PH.4	
			MODEL: SPRINGFIELD 1X OPT GRND FLR EL 1,2,3	
			LOT #:	
			DESIGNER: LR	
			DATE: APR 28 21	



Purchaser: Samuel + Wardak.
Lot: 375.

Schedule SMART
Russell Gardens Building Ltd. (Phase 4)

Smart Home System includes:

1. One (1) Smart Home Hub installed in a location as determined by the Vendor;
2. One (1) Doorbell camera supplied and installed at front door;
3. One (1) smart home thermostat to be installed in a location as determined by the Vendor;
4. One (1) smart Flood sensor to be installed in a location as determined by the Vendor which is designed to detect water in the location of the sensor only;
5. Smart light switches to be installed in such locations as determined by the Vendor;



Certain devices for The Smart Home System require a fully functioning WiFi network and internet connection and others work on the Zwave wireless network. Provision of WiFi, internet access and functionality shall be the sole responsibility of the Purchaser and the Vendor assumes no responsibility or obligation with respect to the functionality or performance of a homeowner's internet or WiFi network. The Vendor does not guarantee that networks, equipment, or services will meet all homeowner needs.

The Purchaser will be required to download the Homewave Smart Connect App (the "App") in order to configure and set up the Smart Home System devices. The Purchaser is responsible to ensure that they have the appropriate technology to download the App and any charges and fees for download and/or data usage shall be at the Purchaser's sole cost and expense. Access to the App shall be provided free of charge for 1 year from the Closing Date and thereafter the Purchaser may enter into an agreement with Homewave Smart Connect to continue the services for a monthly fee (currently \$10.00/month plus HST). Fees subject to change without notice.

Purchasers are responsible for configuring all security features. The Vendor does not warrant or represent that any network or Smart Home System devices are secure or can prevent all privacy intrusions, malware, or cyber-attacks, even when correctly configured. The products and services for the Smart Home System are provided by third parties, and not the Vendor. The Vendor does not guarantee any equipment or services provided by third parties. If the Purchaser contracts with the third-party provider to upgrade or purchase further devices, the Vendor has no responsibility for same, including but not limited to, the installation, service, safety or functionality of said products.

Energy claims are not based upon specific testing of an individual home but are general assumptions. Savings will vary due to many variables, including but not limited to, actual utility rates and fees, actual construction, floor plan, occupancy, appliance usage, thermostat settings, weather conditions, number of individuals occupying the home and orientation of the home.

The Vendor is providing only those Smart Home System's devices and components listed in this Schedule. Please see the balance of your Agreement of Purchase and Sale for additional information, disclosures, and disclaimers relating to your home and its features. The specific features in a home may vary from home to home and from one community to another. The Vendor reserves the right to substitute equipment, material, appliances and brand names with items of equal or higher value, in its sole and unfettered discretion. The Vendor reserves the right, in its sole and absolute discretion, to omit installation of the Smart Home System, in part or in whole, and the Purchaser shall have no claim for abatement or reduction the Purchase Price or to any delay in closing. Installation of the Smart Home System may result in the elimination of other features listed in Schedule GP or other information material, such as but not limited to set back thermostat, rough-in for alarm or other features deemed redundant as a result of the installation of the Smart Home System.

Purchaser Initials 	Purchaser Initials 
--	--