Greenpark.

M/H 1 0 2022

■ PURCHASERS: Pardeep K	Mountainview	NSTRUCTION SUMMARY  Heights 3 (G) - Russell Gardens Buildin Singh MAND	ng Ltd. TEL: RES.:	: 416-371-4599
LOT / PHASE 508 / 4	REG. PLAN # 62M-1266	HOUSE TYPE Valleycreek Ten Elev 3		
CARINETRY ACCESSO	DRIES	TO SEE TO DED FOOT CO	TANDARD	
08Mar22 Note:		IM TO 600MM DEEP - PRICE IS PER FOOT - ST		
1 - KITCHEN CABINETRY 08Mar22 Note:	UPPER - FULL DEPTH	ABOVE FRIDGE - WITH GABLES - 600MM - PI	RICE IS EACH - STANDARD	
CERAMIC TILE  1 - FOYER - UPGRADE 4	THES			
08Mar22 Note:				
CONSTRUCTION  4 - ENLARGE BASEMEN  21 Jun 21 Note:	T WINDOWS (MAY REQ	uire window wells) - window is 30 inc	HES X 24 INCHES	
ELECTRICAL				
1 - PLUG - ELECTRICAL 08Mar22 Note:	PLUG - TO BE INSTALL	ED OVER FIREPLACE		
1 - ABOVE KITCHEN ISI 08Mar22 Note:	LAND - ADD LIGHT AND	SWITCH - NO FIXTURE INCLUDED		
1 - LIGHT AND SWITCH 08Mar22 Note:	- NO FIXTURE INCLUDI	ED - LIVING ROOM		
1 - PLUG - ELECTRICAL 08Mar22 Note:	, PLUG WITH GFI AND S	WITCH - FOR FESTIVE LIGHTING		
1 - PLUG - ELECTRICAL 21Jun21 Note:	PLUG WITH GFI AND S	WITCH - FOR FESTIVE LIGHTING		
FIREPLACE AND AC		ES ELECTRICAL OUTLET) - FIRST FLOOR		
08Mar22 Note:	N FOR STOVE (INCEODE	7		
HARDWOOD FLOOI	RING	EAS - GROUP B - 5' HARDWOOD - IN LIEU OF	STANDARD AS PER OFFER	<b>τ</b>
08Mar22 Note:	NDARD NON-TIELD AIG	CAB - GROOT B - VIII ab -		
PLUMBING	FRIDGE - ROUGH-IN ONL	V		
21Jun21 Note:	RIDGE - ROUGH-IN ONL	21		
1 - LESS BALANCE OF 08Mar22 Note:	CREDIT FROM PURCHA	ASER EXTRA SHEET IN OFFER		
	M PURCHASER EXTRA S V PROMO BALANCE \$			

Greenpark.

Granite kitchen counter top, from Vendor?s standard samples

Worksheet Note:

	CONS	STRUCTION SUMMARY		
	Mountainview H	eights 3 (G) - Russell Gardens Buildin	ıg Ltd.	
PURCHASERS: Pardeep Ka	TEL: RI	TEL: RES.: 416-371-4599		
LOT/PHASE 508/4				
1 - LESS CREDIT FROM PU 21Jun21 Note:	JRCHASER EXTRA SHEET	IN OFFER		
STAIRS AND RAILINGS  1 - STAIRCASE - V-GROO				
08Mar22 Note:	, , , , , , , , , , , , , , , , , , , ,			
1 - STAINED STAIRS - ST	ANDARD STAIRCASE - PRI	CE IS PER SET		
08Mar22 Note:				
	EX	TRAS AS PER OFFER		- I
(1) The Vendor agrees that addition to those items det Worksheet Note:	t notwithstanding any other tailed in Schedule GP to the	term or provision in this Agreement include Agreement of Purchase and Sale, the Purch	ed in the Purchase Price naser is entitled to a cred	and in lit of
PURCHASER(S) ACKNO PROMOTIONAL PACK Worksheet Note:	OWLEDGES THAT THE P AGES AVAILABLE AT TI	PURCHASE PRICE IS INCLUSIVE OF AL ME OF PURCHASE.	L CREDITS AND	

This Document is Extremely Time Sensitive - Printed <u>8 Mar 22</u> at <u>12:52</u>

# Greenpark.

# INTERIOR COLOUR SCHEME

Purchasers:

Pardeep Kaur MAND & Talwinder Singh MAND Property: 508

Telephone Res. / Bus: (416) 371-4599 /

Project: Russell Gardens Building Ltd.

Decor Advisor:

Candace Forza

Model and Elevation: Valleycreek Ten Elev 3

_ayout Changes: Yes  1. Cabinetry  Kitchen / Breakfast	and the state of t	lo Exterior Coloui	Scheme:	
(itchen / Breakfast				
				Hardware
	Style and Colour  DORAL W-500			467SA
	ELISSE			Standard
aundry Room	MONACO 350 PLATINUM SILVER			467SA
owder Room	DORAL K44 TITAN GREY		4	467SA
Master Ensuite Bathroom	L-11-		Attended	468SA
	DORAL H3078 HACIENDA WHITE			467SA
Ensuite Bath - Bedroom 4	DORAL K38 RIVERSIDE			N/A
	N/A			N/A
	N/A			N/A
	N/A		lide In Stove	Yes No
Stove Opening	NOTE: If not specified, opening			
Fridge Opening  ** Refer to Construction	NOTE: If not specified, opening	will be set to builder's standard o	pening of approximately	37" width x 74" heigi
** Refer to Construction		will be set to builder's standard o	pening of approximately	37" width x 74" heigi
		will be set to builder's standard o	pening of approximately	37" width x 74" heigi
** Refer to Construction	Summary		pening of approximately	37" width x 74" heigi
* Refer to Construction  2. Counters  Kitchen / Breakfast	Summary	Edge	pening of approximately	37" width x 74" heigi
* Refer to Construction  2. Counters  Kitchen / Breakfast Laundry Room	Summary  Counter  GRANITE-GRIGIO SARDO	Edge	pening of approximately	37" width x 74" heigi
2. Counters  Kitchen / Breakfast  Laundry Room  Powder Room	Counter  GRANITE-GRIGIO SARDO  N/A	Edge	pening of approximately	37" width x 74" heigi
* Refer to Construction  2. Counters  Kitchen / Breakfast  Laundry Room  Powder Room  Master Ensuite Bathroom	Counter GRANITE-GRIGIO SARDO N/A LAMINATE-CARRARA BIANCO 6696-46	Edge	pening of approximately	37" width x 74" heigi
2. Counters  Kitchen / Breakfast Laundry Room Powder Room Master Ensuite Bathroom	Counter GRANITE-GRIGIO SARDO N/A LAMINATE-CARRARA BIANCO 6696-46 LAMINATE-CARRARA BIANCO 6696-46 LAMINATE-WHITE CARRARA 4924-38	Edge	pening of approximately	37" width x 74" heigh
** Refer to Construction  2. Counters  Kitchen / Breakfast  Laundry Room  Powder Room  Master Ensuite Bathroom  Ensuite Bath - Bedroom 2	Counter GRANITE-GRIGIO SARDO N/A LAMINATE-CARRARA BIANCO 6696-46 LAMINATE-CARRARA BIANCO 6696-46 //3 LAMINATE-WHITE CARRARA 4924-38 LAMINATE-WHITE CARRARA 4924-38 N/A	Edge	pening of approximately	37" width x 74" heigi
** Refer to Construction  2. Counters  Kitchen / Breakfast  Laundry Room  Powder Room  Master Ensuite Bathroom  Ensuite Bath - Bedroom 2	Counter GRANITE-GRIGIO SARDO N/A LAMINATE-CARRARA BIANCO 6696-46 LAMINATE-CARRARA BIANCO 6696-46 Z3 LAMINATE-WHITE CARRARA 4924-38 LAMINATE-WHITE CARRARA 4924-38	Edge	pening of approximately	37" width x 74" heigi

Greenpar	<b>'k</b>	INTERIOR COLOUR SCHEME						
<del></del>		9 Tohuindar Singh MANID	Property:	508				
		& Talwinder Singh MAND			sell Gardens Building Ltd.			
elephone Res. / Bus:	(416) 371-4599 /	2 2 3 3 3 4 3 5 4 3 5 6 5 6 5 6 5 6 5 6 5 6 5 6 5 6 5 6 5						
ecor Advisor:	Candace Forza		Elevation:		ycreek Ten Elev 3			
ock Date:	8-Mar-22	8-Mar-22		Plan	#: 62M-1266			
. Ceramic Flooring	J			At a 45	Threshold-If App.			
ntrance Vestibule	TILE-VARENNA CAI	RRARA-24X24			metal strip where applicable			
ntrance vestibule Iain Hall	STRIP							
itchen / Breakfast	TILE-ESSENZE GR	IGIO-13X13						
aundry Room	TILE-PLAYA BLACK		10.					
owder Room	TILE-ESSENZE GR							
laster Ensuite Bathroom								
nsuite Bath - Bedroom 2								
				ī 🗆				
Ensuite Bath - Bedroom 4	TILE-ESSENZE GR			Ī				
SIDE/GARAGE HALL	TILE-ESSENZE GR							
OWER LANDING	N/A							
* Refer to Construction					400000000000000000000000000000000000000			
TOTAL CONGREGATION	na advantate tradefield 🕬							
4. Ceramic Wall Til	10							
4. Geramic vvaii III Master Ensuite Bathroon			D	escrib	е			
	ck Wall N/A							
	b Deck N/A							
	k Skirt N/A			-				
	er Stall TILE-SILVIA WHIT	ΓΕ-8X16						
Bathtub Enclosure	e Walls N/A							
Ensuite Bath - Bedroom		TE/GREY-8X16						
Ensuite Bath - Bedroom	F	TE/GREY-8X16						
SIDE/GARAGE HALL	N/A							
	N/A							
LOWER LANDING								
LOWER LANDING	N/A							
Kitchen Backsplash	N/A	DARD CROUT TUROUGH	OUT UNI E	222	PECIFIED			
Kitchen Backsplash	N/A	DARD GROUT THROUGH	OUT UNLE	SS S	PECIFIED			
Kitchen Backsplash	N/A on Summary - STANE	DARD GROUT THROUGH	OUT UNLE	SS S	PECIFIED			
Kitchen Backsplash ** Refer to Construction  5. Plumbing Fixtu	N/A on Summary - STANE	DARD GROUT THROUGH		SS S	PECIFIED  N/A ○ Yes ● No			
Kitchen Backsplash ** Refer to Constructio	N/A on Summary - STANE	DARD GROUT THROUGH		SS S				
Kitchen Backsplash  ** Refer to Construction  5. Plumbing Fixtu	N/A on Summary - STANE res White	DARD GROUT THROUGH			N/A ○ Yes ● No			
Kitchen Backsplash  ** Refer to Construction  5. Plumbing Fixtu	N/A on Summary - STANE res White N/A	DARD GROUT THROUGH		Dis	N/A ○ Yes ● No			
Kitchen Backsplash ** Refer to Construction  5. Plumbing Fixtu	N/A  on Summary - STANE  res  White  N/A  N/A	DARD GROUT THROUGH		Dis	N/A ○ Yes ● No			
Kitchen Backsplash  ** Refer to Construction  5. Plumbing Fixtu	N/A on Summary - STANE  Ires  White  N/A  N/A  N/A	DARD GROUT THROUGH		Dis	N/A ○ Yes ● No			
Kitchen Backsplash ** Refer to Construction  5. Plumbing Fixtu	N/A  on Summary - STANE  wres  White  N/A  N/A  N/A  N/A  N/A	DARD GROUT THROUGH		Dis	N/A ○ Yes ● No			
Kitchen Backsplash  ** Refer to Construction  5. Plumbing Fixtu  All Bathrooms	N/A on Summary - STANE  White  N/A  N/A  N/A  N/A  N/A  N/A  N/A  N/	DARD GROUT THROUGH		Dis	N/A ○ Yes ● No			
Kitchen Backsplash  ** Refer to Construction  5. Plumbing Fixtu  All Bathrooms	N/A on Summary - STANE  White  N/A  N/A  N/A  N/A  N/A  N/A  N/A  N/	DARD GROUT THROUGH		Dis	N/A ○ Yes ● No			
Kitchen Backsplash ** Refer to Construction  5. Plumbing Fixtu  All Bathrooms	N/A on Summary - STANE  White  N/A  N/A  N/A  N/A  N/A  N/A  N/A  N/	DARD GROUT THROUGH		Dis	N/A ○ Yes ● No			
Kitchen Backsplash ** Refer to Construction  5. Plumbing Fixtu  All Bathrooms	N/A on Summary - STANE  White  N/A  N/A  N/A  N/A  N/A  N/A  N/A  N/	DARD GROUT THROUGH		Dis	N/A ○ Yes ● No			
Kitchen Backsplash  ** Refer to Construction  5. Plumbing Fixtu  All Bathrooms  ** Refer to Construction	N/A on Summary - STANE  White  N/A  N/A  N/A  N/A  N/A  N/A  N/A  N/			Dis	N/A ○ Yes ● No			
Kitchen Backsplash  ** Refer to Construction  5. Plumbing Fixtu  All Bathrooms  ** Refer to Construction	N/A  on Summary - STANE  White  N/A  N/A  N/A  N/A  N/A  N/A  N/A  On Summary  CARRARA-SMC			Dis	N/A ○ Yes ● No			
Kitchen Backsplash  ** Refer to Construction  5. Plumbing Fixtu  All Bathrooms  ** Refer to Construction  6. Trim Carpentry  Interior Doors	N/A  on Summary - STANE  White  N/A  N/A  N/A  N/A  N/A  N/A  On Summary  CARRARA-SMC  As Per Construct	DOTH		Dis	N/A ○ Yes ● No			

Initials:\_

Greenpa	r <b>k</b> .	INTERIOR C	OLOUR SCHE	EME			
		a Talair day Cinah MAND	Property: 508				
Purchasers:		& Talwinder Singh MAND	Projects Pus	ssell Gardens Building Ltd.			
Telephone Res. / Bus:	(416) 371-4599 /		9/7				
Decor Advisor:	Candace Forza Model and Elevation: Valleycreek Ten Elev 3						
Lock Date:	8-Mar-22	8-Mar-22	Plar	n #: 62M-1266			
7. Other Flooring				107			
Main Hall	STRIP-MIRAGE-IMAG	GINE-CHARACTER-CORK-RED	OAK-DURAMATT-D	DRIFTWOOD-5"			
Living Room	STRIP-MIRAGE-IMAG	DRIFTWOOD-5"					
Dining Room	STRIP-MIRAGE-IMAGINE-CHARACTER-CORK-RED OAK-DURAMATT-DRIFTWOOD 5"						
Family Room	STRIP-MIRAGE-IMAGINE-CHARACTER-CORK-RED OAK-DURAMATT-DRIFTWOOD-5"						
Den / Library / Study	N/A	date.					
Basement Landing(If Appli	es) N/A		- In the second	100			
Lower Landing (If Applies)	TILE		D OAK DURAMATT	DRIETMOOD-5"			
Upper Landing		GINE-CHARACTER-CORK-RE		DRIFTWOOD-3			
Upper Hall		ON-ROCHEFORT OAK-TL-LW					
Master Bedroom		ON-ROCHEFORT OAK-TL-LW					
Bedroom #2	를 보고 있다. 사람들은 100 kg (100 kg)))))))))))))	ON-ROCHEFORT OAK-TL-LW					
Bedroom #3	21 22 22 22 22 22 22 22 22 22 22 22 22 2	ON-ROCHEFORT OAK-TL-LW					
Bedroom #4		ON-ROCHEFORT OAK-TL-LW	1317				
Bedroom #5	N/A						
	N/A		The second secon	and the second s			
	N/A		2017				
	N/A	***	The state of the s				
Underpad	Type N/A		l/A				
8. Railings and P	ickets						
400	ROOVE	Complin	nenting Colour	MIRAGE DRIFTWOOD RED OAK			
Picket Type AS	PER CONSTRUCTION SE	PECIFICATIONS Complin	Complimenting Colour MIRAGE DRIFTWOOD RED OAK				
Other Type AS	DED CONSTRUCTION	SPECIFICATIO Complit	menting Colour	MIRAGE DRIFTWOOD RED OAK			
Stringer / Riser AS	PER CONSTRUCTION	SPECIFICATIO Complia	monting Colour	MIRAGE DRIFTWOOD RED OAK			
· ·	DER CONSTRUCTION Oak Stairs • Yes	1494	nenting colour [	MINAGE BINI 14400B NEB 07 IN			
** Refer to Constru AND RAILS (STAIR FLOORS.	ction Summary THE CASES), WILL NOT BE	STAIN COLOURS OR F E AN EXACT MATCH TO	INISH AVAILABI PREFINISHED I	LE ON RISERS, TREADS, PICKETS HARDWOOD OR LAMINATE			
⊢9. Wall Paint Flat	Finish ————						
Main & Upper Hall	22 WARM GRE	Y Maste	Bedroom	22 WARM GREY			
Living Room	22 WARM GRE	Y Bedro	om #2	22 WARM GREY			
Dining Room	22 WARM GRE	Y Bedro	om #3	22 WARM GREY			
Kitchen / Breakfast	22 WARM GRE	100	om #4	22 WARM GREY			
Family Room	22 WARM GRE	- Control of the Cont	om #5	N/A			
Powder Room	22 WARM GRE		r Ensuite	22 WARM GREY			
Laundry Room	22 WARM GRE	77-79 ISVANCES INVESTMENT	e Bath - Bedroo	om 2/3 22 WARM GREY			
Den/Library	N/A		e Bath - Bedroo				
√	emi GlossBIRCH WHITE	AND USE CONTROL	ವ ಪ್ರಾಣಾಣಕ ಪ್ರತಿಕ್ರಿಸಿ	N/A			
min & Door Paint-Se	N/A	40.		N/A			
	LN//T						

No

	(3)	
	(3)	
Initials:_	4	


N/A

Smooth Ceilings First Floor Yes

\*\* Refer to Construction Summary


N/A

Greenp	ark	<b>L</b> 10		IN	rerior c	OLOUR S	CHEME		
		ardeep Kaur MA	ND & Tal	winder Sir	nah MAND	Property:	508		
Purchasers:			IND a ran	Williadi Cii	.9	Project:	Russell Ga	rdens Building	Ltd.
Telephone Res. / B	57	16) 371-4599 /			Model and			Ten Elev 3	
Decor Advisor:		andace Forza		8-Mar-22		Livration		62M-1266	
Lock Date:		Mar-22		0-Wai-22					
10. Plaster Mo					Kitchen/B	reakfast	N/A	N/A	
Entrance Vestibul		/A	N/A N/A		Den/Libra		N/A	N/A	
Main Hall	L	/A	N/A		Lower La	2	N/A	N/A	
Living Room		/A			201101 201		N/A	N/A	
Dining Room	L	/A	N/A						
Family Room	1	/A	N/A						
** Refer to Cons	structio	n Summary							
11. Fireplace	12			Family Ro	nom.		Other F	Room - Specify	
	ng Room			Purchase		n N/A	Purch	nased As Per Plan	N/A
	chased	As Per Plan N/A			•		$\subset$		•
Fireplace Type N/A	J			FLAT ON	WALL		N/A	W	
Mantle Type N/A					M2-STANDAR		N/A		
Colour / Stain N/A				AS PER C	CONSTRUCTION	ON SPECIFIC			
Surround N/A				GRIGIO C	ARNICO		N/A	100	
Hearth N/A				NO			N/A		
Air Conditioning Gas Provision Comment ** Refer to Const	ng s Dryei	NO NO				16516	visions Sto visions Bar		
13. Electrical				200				0.1:41:-14	. ○ You ● No
Plugs and Switch	nes	White		DECOR				Cabinet Light	
Hood Fan		STANDARD W							
Appliances			<b>top</b> No □	Built Yes	in Oven ■ No	0.000	Gas Stove Yes	<u> </u>	Yes No
Dishwasher Rou	gh-in	Yes							
** Refer to Const	ruction	Summary						4100	
** Refer to Constr				A Section 1					
must be pa 3) The Purcha by the Venc 4) The Purcha disclaimers 5) In the even the Interior	all maten manulisted a id in function in function is a colour	erials are as clo facturing. bove are null a II. rees that this co knowledges rea onflict betweer r Scheme, the I	and void olour sele ading and the Star nterior C	unless ac ection is d acception dard Fea olour Sch	ccompanie final and th ng docume atures sche neme shall	d by a sepanat no charent which cedule of the prevail.	rate invoic nges will be ontains oth	e/amendment permitted, un er miscellane t of Purchase	. Said invoice aless required ous and Sale and
Signature:	Sta	lundif	<u>M</u> Date	e:08/03	202 Signati	ure:		Da	ate:

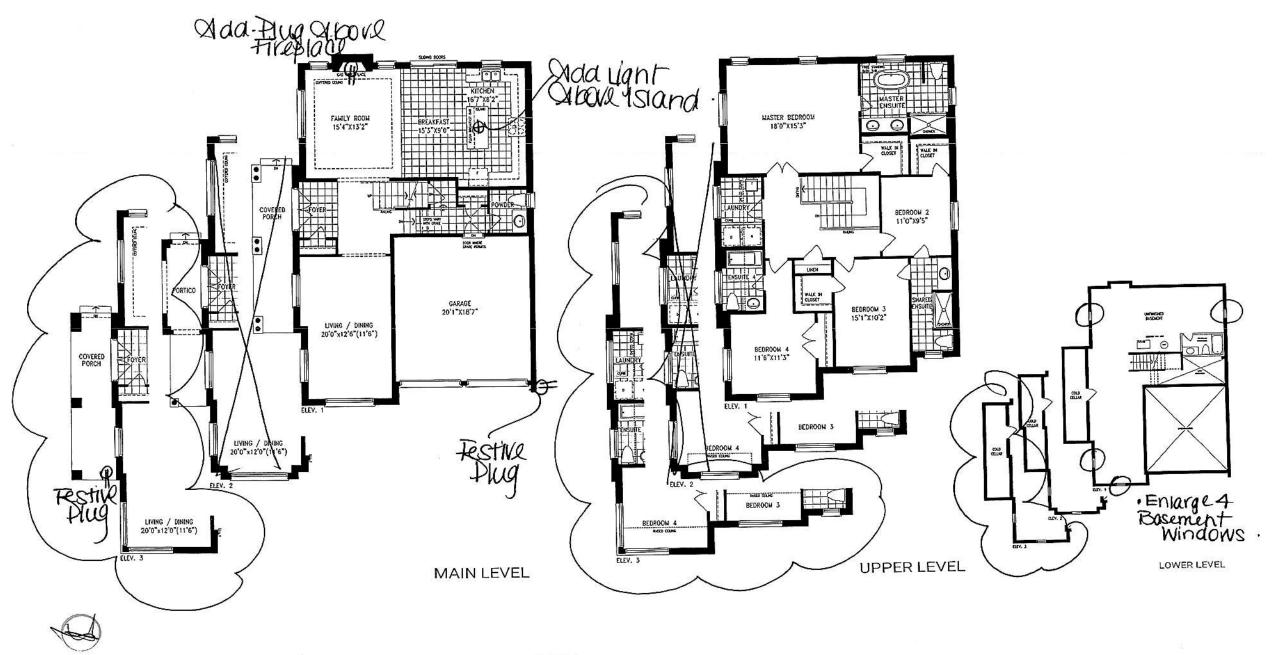

VALLEYCREEK TEN ELEV. 1 - 2,608 sq.ft. | ELEV. 2 - 2,590 sq.ft. | ELEV. 3 - 2,601 sq.ft.



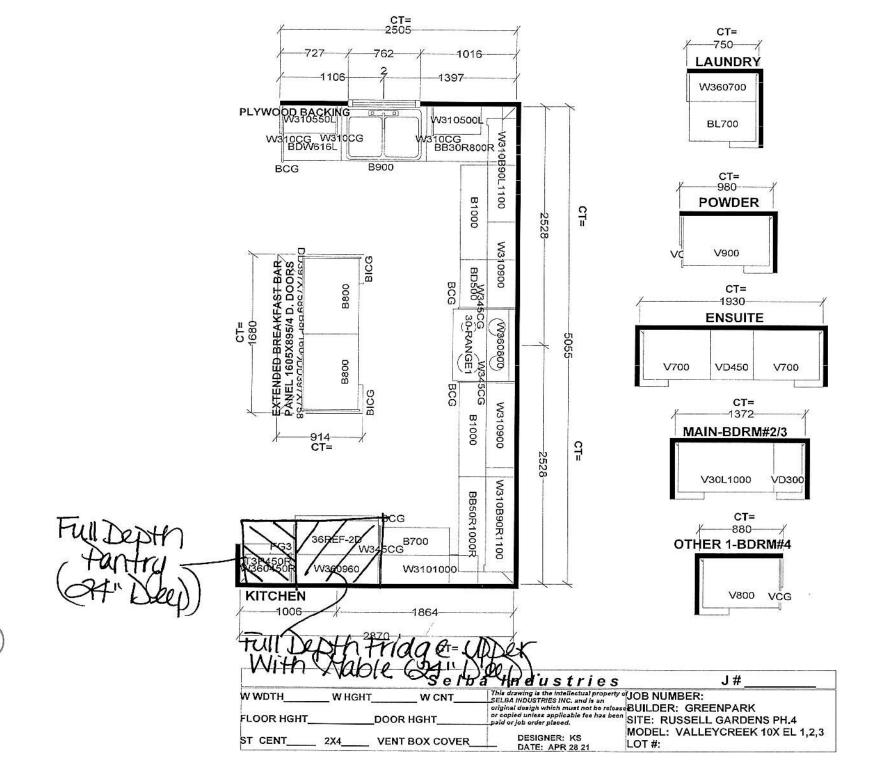

Purchaser: Lot:

### Schedule SMART Russell Gardens Building Ltd. (Phase 4)

## Smart Home System includes:

- 1. One (1) Smart Home Hub installed in a location as determined by the Vendor;
- 2. One (1) Doorbell camera supplied and installed at front door;
- 3. One (1) smart home thermostat to be installed in a location as determined by the Vendor;
- 4. One (1) smart Flood sensor to be installed in a location as determined by the Vendor which is designed to detect water in the location of the senor only;
- 5. Smart light switches to be installed in such locations as determined by the Vendor;

Certain devices for The Smart Home System require a fully functioning WiFi network and internet connection and others work on the Zwave wireless network. Provision of WiFi, internet access and functionality shall be the sole responsibility of the Purchaser and the Vendor assumes no responsibility or obligation with respect to the functionality or performance of a homeowner's internet or WiFi network. The Vendor does not guarantee that networks, equipment, or services will meet all homeowner needs.

The Purchaser will be required to download the Homewave Smart Connect App (the "App") in order to configure and set up the Smart Home System devices. The Purchaser is responsible to ensure that they have the appropriate technology to download the App and any charges and fees for download and/or data usage shall be at the Purchaser's sole cost and expense. Access to the App shall be provided free of charge for 1 year from the Closing Date and thereafter the Purchaser may enter into an agreement with Homewave Smart Connect to continue the services for a monthly fee (currently \$10.00/month plus HST). Fees subject to change without notice.

Purchasers are responsible for configuring all security features. The Vendor does not warrant or represent that any network or Smart Home System devices are secure or can prevent all privacy intrusions, malware, or cyber-attacks, even when correctly configured. The products and services for the Smart Home System are provided by third parties, and not the Vendor. The Vendor does not guarantee any equipment or services provided by third parties. If the Purchaser contracts with the third-party provider to upgrade or purchase further devices, the Vendor has no responsibly for same, including but not limited to, the installation, service, safety or functionality of said products.

Energy claims are not based upon specific testing of an individual home but are general assumptions. Savings will vary due to many variables, including but not limited to, actual utility rates and fees, actual construction, floor plan, occupancy, appliance usage, thermostat settings, weather conditions, number of individuals occupying the home and orientation of the home.

The Vendor is providing only those Smart Home System's devices and components listed in this Schedule. Please see the balance of your Agreement of Purchase and Sale for additional information, disclosures, and disclaimers relating to your home and its features. The specific features in a home may vary from home to home and from one community to another. The Vendor reserves the right to substitute equipment, material, appliances and brand names with items of equal or higher value, in its sole and unfettered discretion. The Vendor reserves the right, in its sole and absolute discretion, to omit installation of the Smart Home System, in part or in whole, and the Purchaser shall have no claim for abatement or reduction the Purchase Price or to any delay in closing. Installation of the Smart Home System may result in the elimination of other features listed in Schedule GP or other information material, such as but not limited to set back thermostat, rough-in for alarm or other features deemed redundant as a result of the installation of the Smart Home System.

Purchaser Initials Initials