
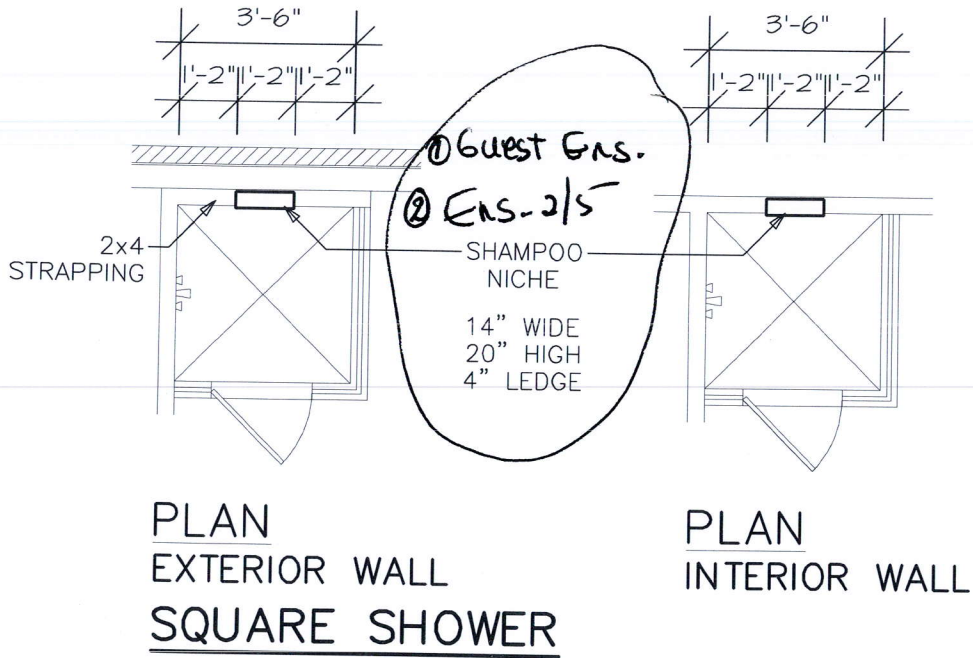


Lot. 359
Russell Gardens

Shower Niches:

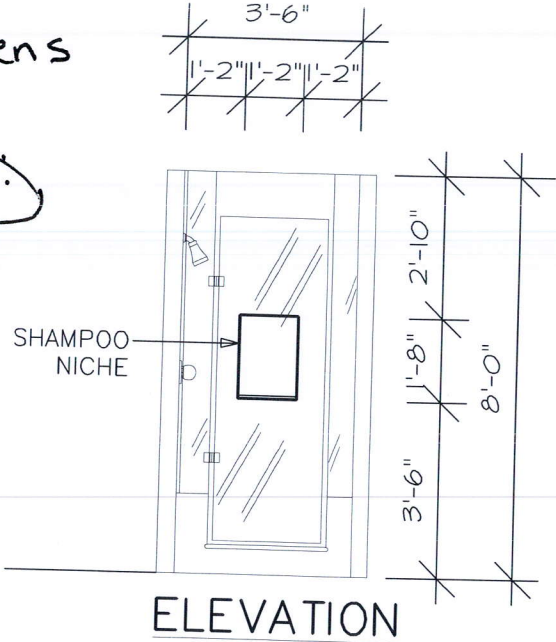

RECEIVED
MAR 17 2022

SHAMPOO NICHE (2 SIZES)

NOTE:
SHOWER STALL MAY
VARY BY MODEL

