

CONSTRUCTION SUMMARY

RECEIVED

Mountainview Heights 3 (G) - Russell Gardens Building Ltd.

MAR 23 2022

TEL:

PURCHASERS: MUHAMMAD IFTIKH AHMAD and BEENA IFTIKHAR

LOT / PHASE	REG. PLAN #	HOUSE TYPE		
172 / 3	62M-1266	Mountainash Six (4 Bedroom) Elev 2		

CABINETRY


1 - ***DELETE - CABINETRY - KITCHEN - CM3 CROWN MOULDING 22Mar22 Note:	
1 - CABINETRY - KITCHEN - CM3 CROWN MOULDING 11Mar21 Note:	
1 - ***DELETE - KITCHEN CABINETRY - DIFFERENT COLOUR ISLAND - FLAT FEE*** 11Mar21 Note:	
1 - KITCHEN CABINETRY - DIFFERENT COLOUR ISLAND - FLAT FEE 23Feb21 Note:	
1 - KITCHEN - DELETE CABINETS ABOVE STOVE - VENDOR WILL SUPPLY 6 INCH VENT AS PER CONSTRUCTION SPECIFICATIONS AND VENT MAY NOT BE IN THE APPROPRIATE LOCATION FOR INSTALLATION OF PURCHASER SUPPLIED VENT - PURCHASER TO SUPPLY OWN FAN AFTER CLOSING 23Feb21 Note: TEMPORARY HOOD FAN MAY BE PROVIDED	
1 - CABINETRY - KITCHEN - LIGHT VALENCE - NO ELECTRICAL 23Feb21 Note:	
1 - CABINETRY - KITCHEN - UPGRADE 3 23Feb21 Note:	
1 - CABINETRY PROVISION - PROVISION FOR PLUG ON ISLAND (PLUG EXTRA ORDERED SEPARATELY) 23Feb21 Note:	

CABINETRY ACCESSORIES


1 - CABINETRY FEE FOR FLUSH CUTOUT ON WALL OVEN/MICROWAVE COMBO CABINET ONLY 11Mar21 Note:	
1 - KITCHEN CABINETRY - MINI STACKED UPPER CABINETS - PRICE IS PER FOOT - UPGRADE 3 CABINETRY 11Mar21 Note:	
1 - KITCHEN - BLU MOTION DRAWERS 23Feb21 Note:	
1 - PANTRY UNIT UPGRADE - TO GO FROM 300MM TO 600MM DEEP - PRICE IS PER FOOT - UPGRADE 3 23Feb21 Note:	
1 - KITCHEN CABINETRY UPPER - FULL DEPTH ABOVE FRIDGE - WITH GABLES - 600MM - PRICE IS EACH - UPGRADE 3 23Feb21 Note:	
1 - KITCHEN CABINETRY BASE - PULLOUT WIRE SPICE RACK - PRICE IS EACH 23Feb21 Note:	
1 - KITCHEN CABINETRY - BUILT-IN MICROWAVE/OVEN COMBO - UPGRADE 3 23Feb21 Note:	
1 - KITCHEN CABINETRY BASE - COOKTOP CABINET WITH POT DRAWERS (2 DRAWERS) - UPGRADE 3 23Feb21 Note:	

CERAMIC TILE

RUSSELL GARDENS
172

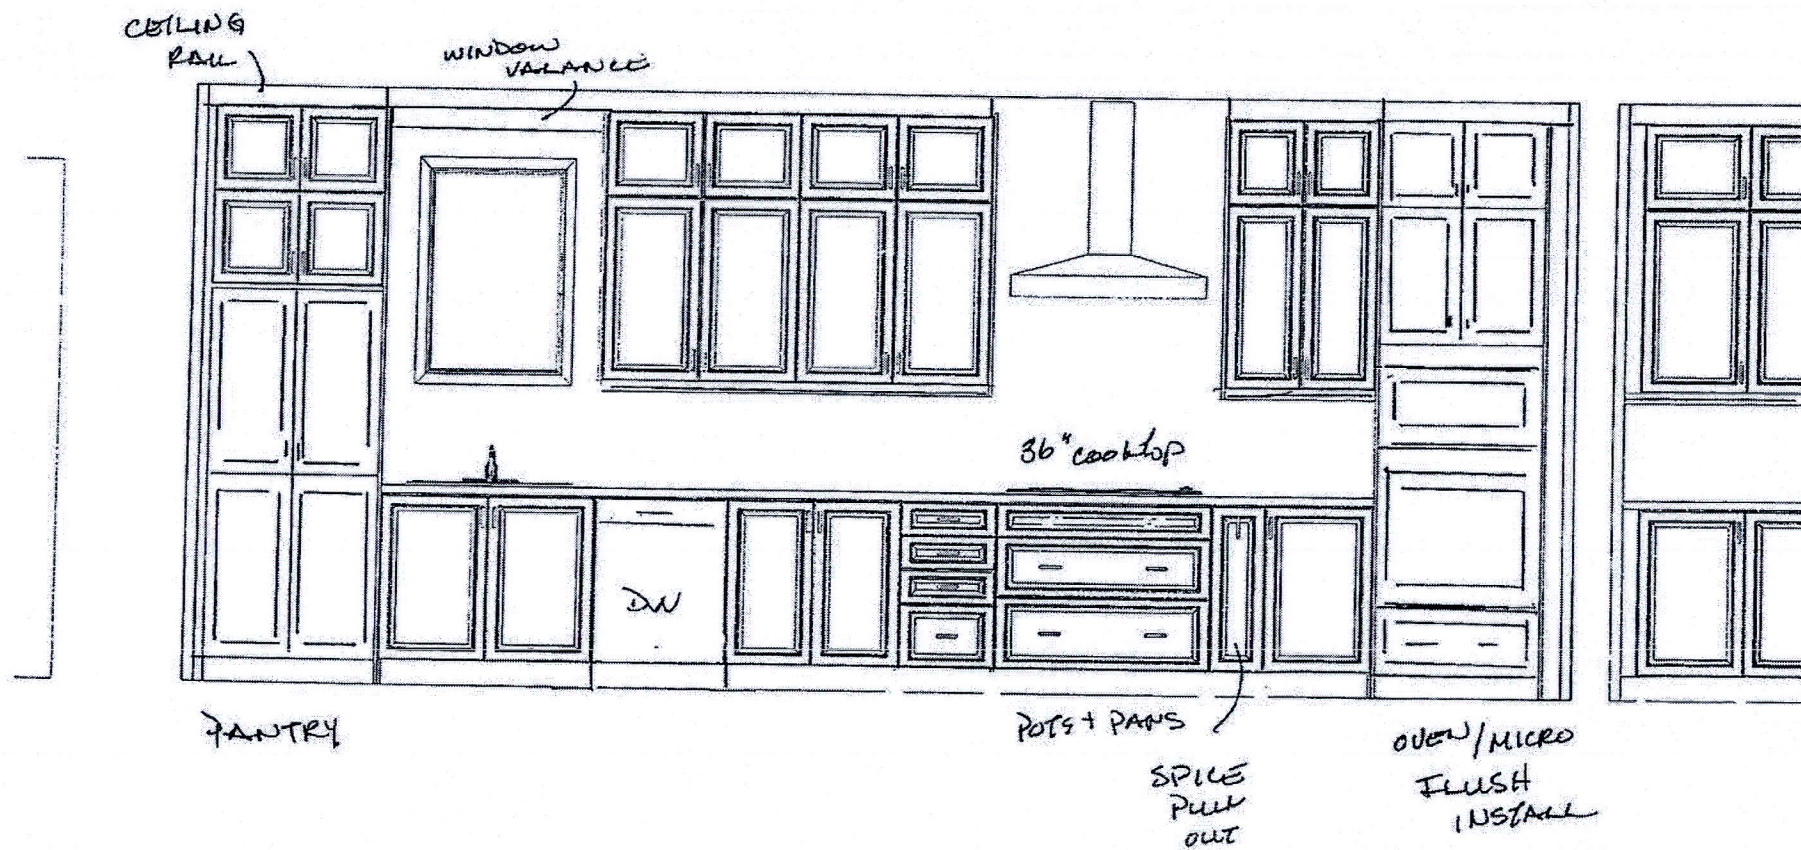


RUSSELL GARDENS

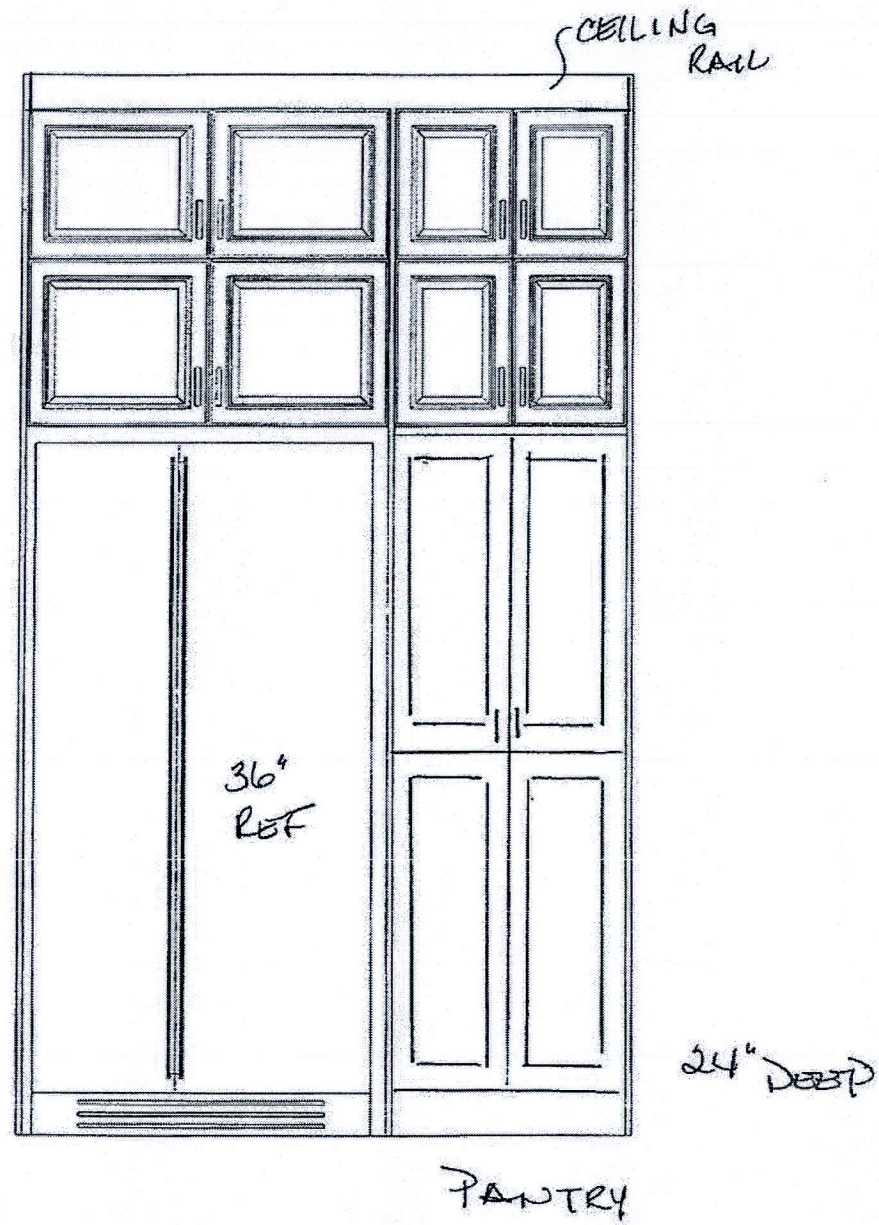

RUSSELL GARDENS



CEILING
RAIL

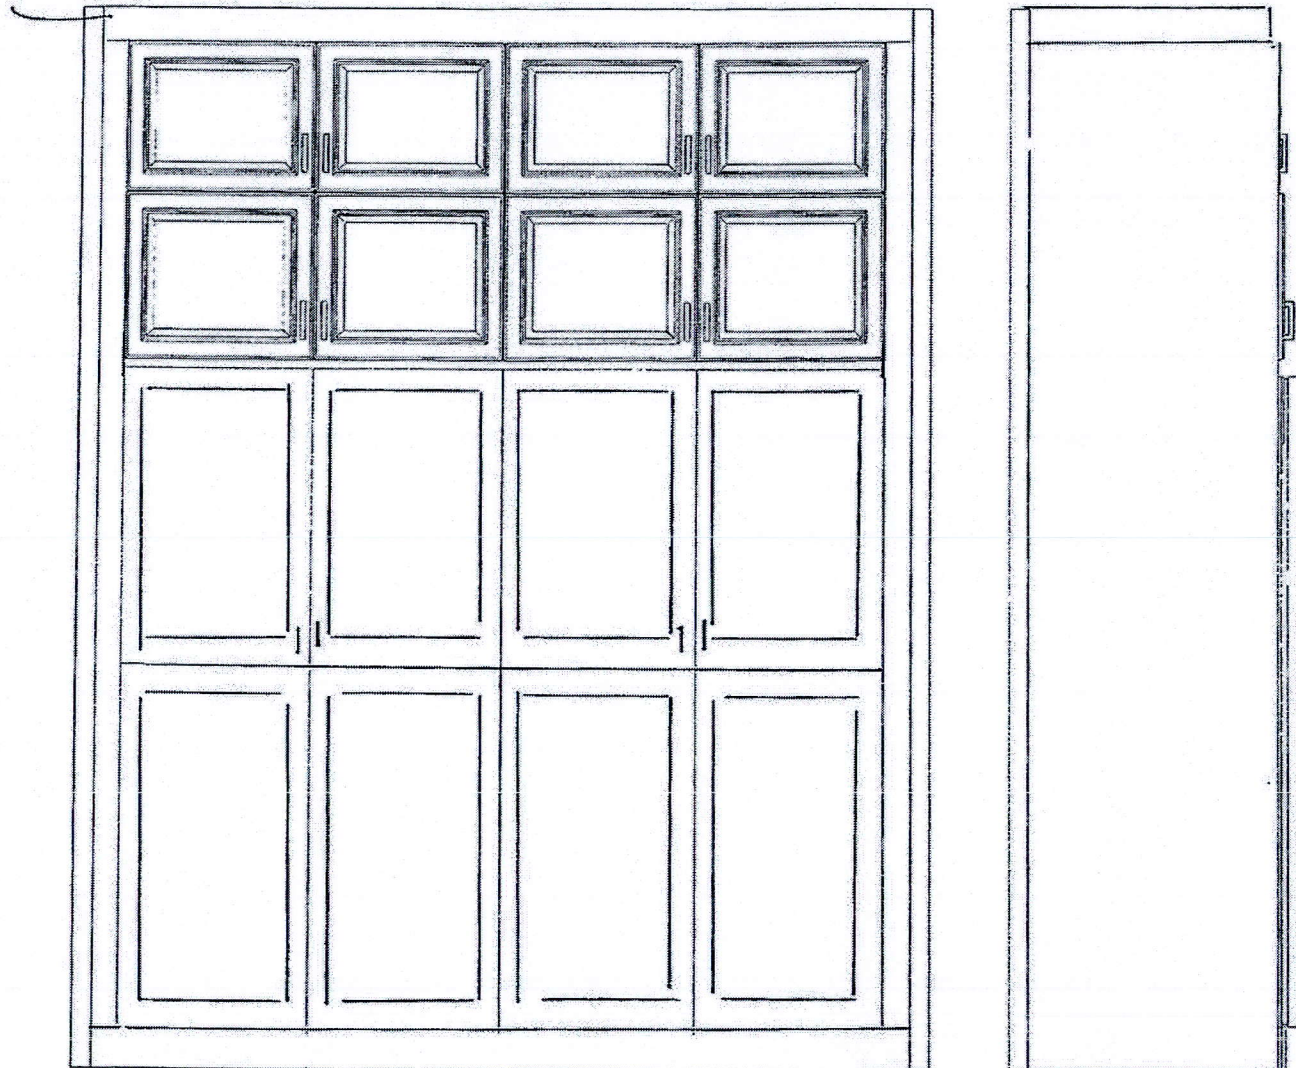

PANTRY / SERVERY

Ⓡ

RUSSELL GARDENS

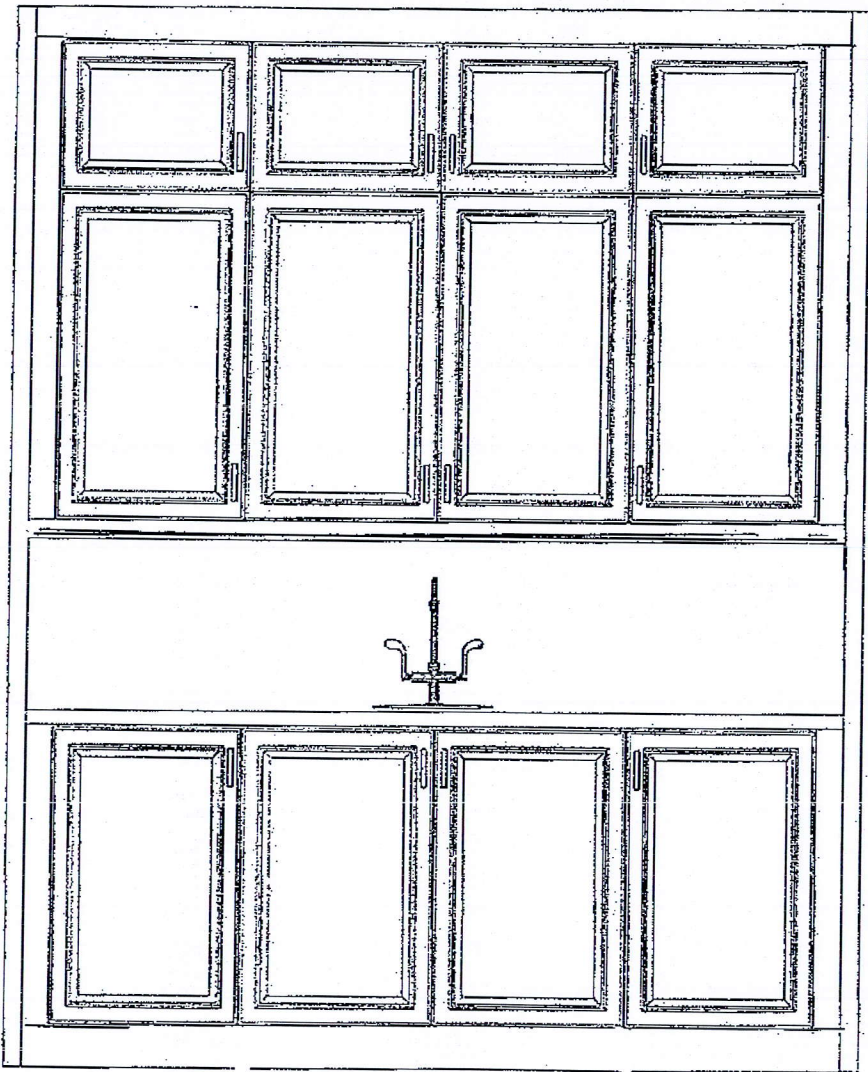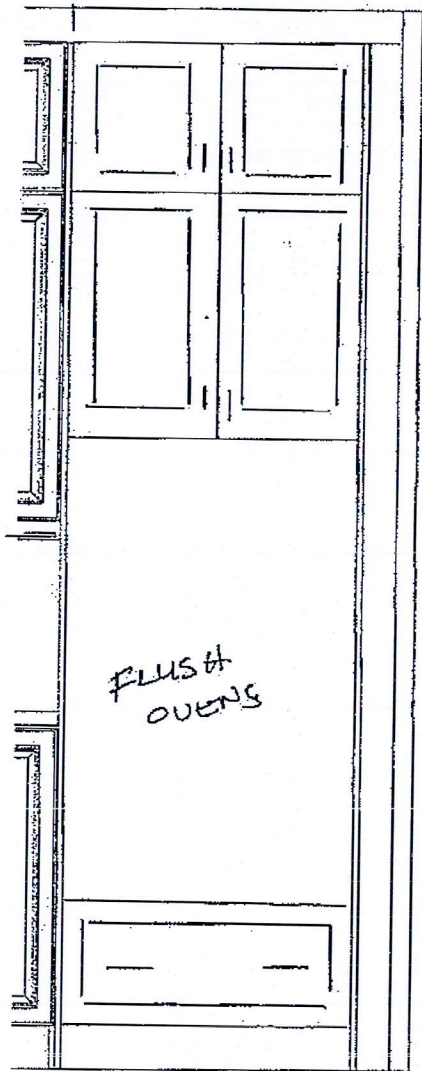

CEILING
RAIL

92
~~192~~

398

860

2708

1442

SERVERY

(F)