
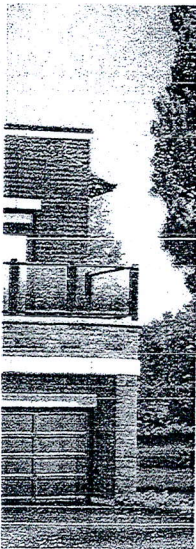


npark
GROUP

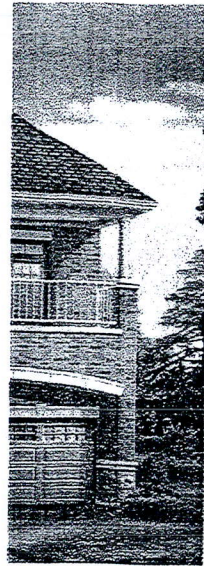

RECEIVED






APR 11 8 2022

plug

" Lot. 383 " Russell Gardens "

Correct
Brochure
Attached

Add
LIGHT

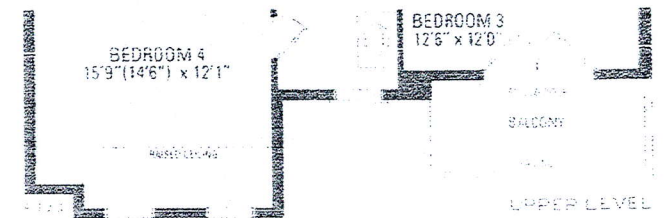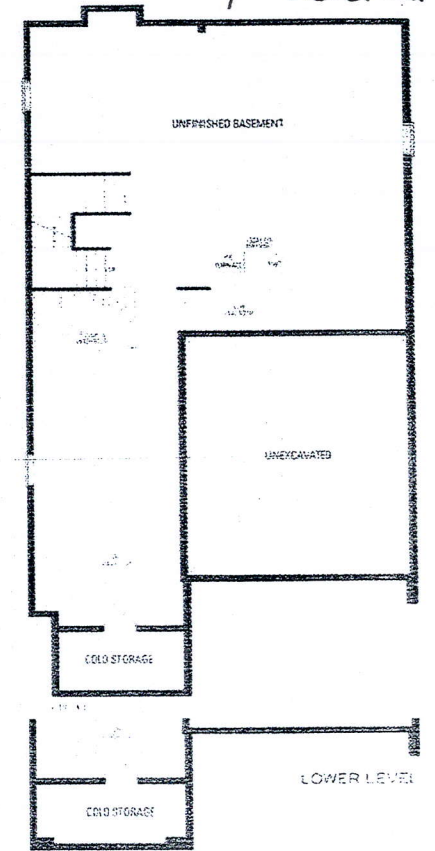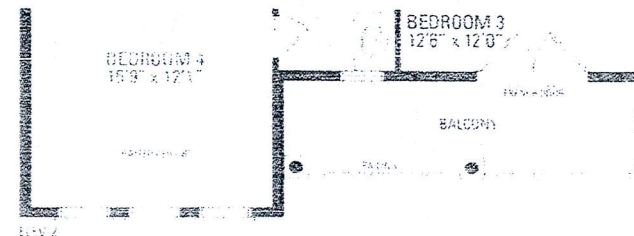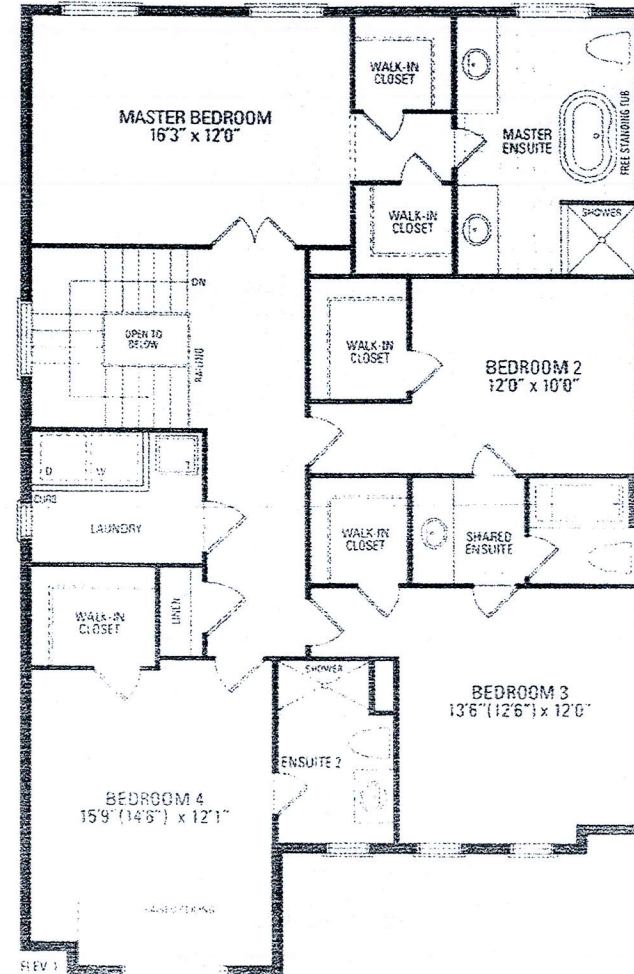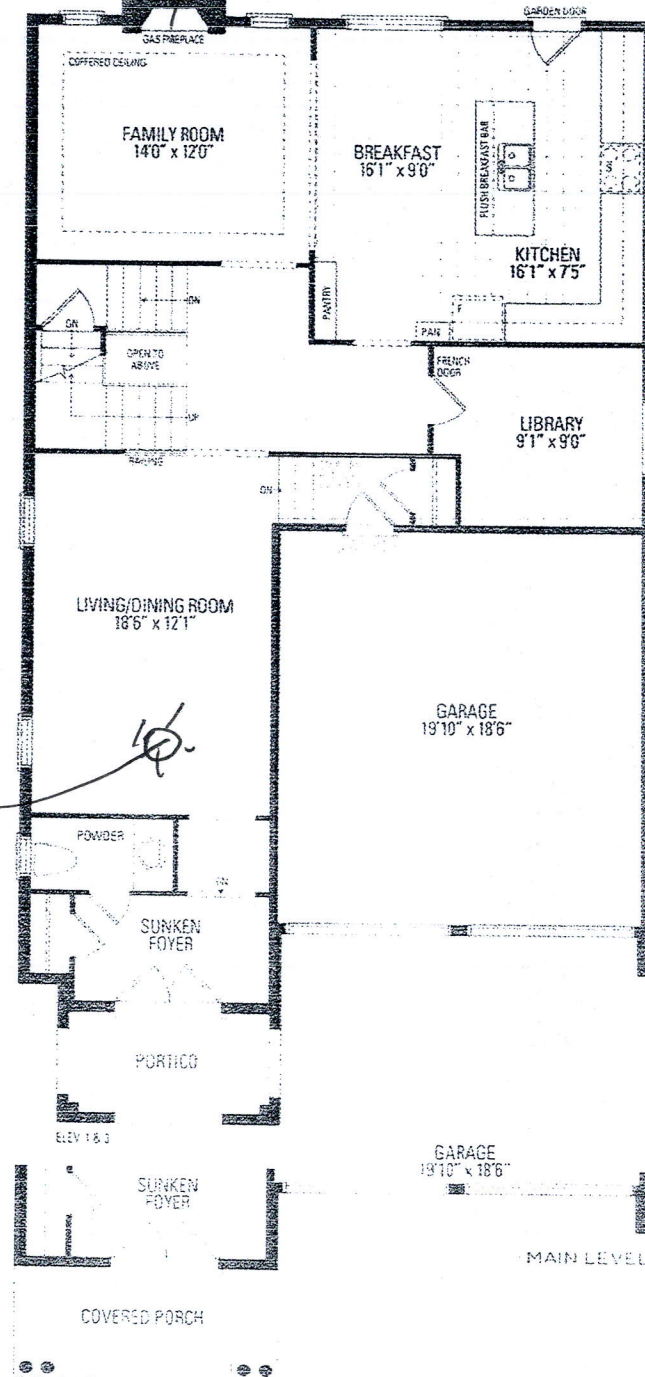

Valleycreek 4 A.