Greenpark.



CONSTRUCTION SUMMARY

Mountainview Heights 3 (G) - Russell Gardens Building Ltd.

RECEIVED

| PURCHASERS: \ | Vijaya Kumar | RAYUDU | and Bhargavi | RAYUDU |
|---------------|--------------|--------|--------------|--------|
|---------------|--------------|--------|--------------|--------|


APR 2 1 2022

TEL:

| LOT / PHASE | REG. PLAN# | HOUSE TYPE | 10 10 17 17 17 17 17 17 17 17 17 17 17 17 17 | |
|--|------------------------|--|--|------|
| 372 / 4 | 62M-1266 | Springfield Three (4 Bed with Guest Suite) Elev 3 | | |
| 1 - POT LIGHT - LED - FIRS WORKSPACE 09Mar22 Note: | | TION - INSTALLED ON SEPERATE SWITCH FROM STATE | NDARD LIGHT - KIT | CHEN |
| | | | | |
| 1 - POT LIGHT - LED - FIRS | T FI OOD INSTALL AT | CION INCTALLED ON GERERAL | | |
| BREAKFAST 09Mar22 Note: | T LOOK INSTALLAT | TION - INSTALLED ON SEPERATE SWITCH FROM STAT | NDARD LIGHT - KIT | CHEN |
| 1-POTLIGHT LED EIDE | T EL OOD DIGTALLA | | | |
| ROOM 09Mar22 Note: | I FLOOR INSTALLAT | TON - INSTALLED ON SEPERATE SWITCH FROM STAN | NDARD LIGHT - FAN | MILY |
| 1 - POT LIGHT - LED - FIRST | FELOOD INSTALLAT | ION DISTALLED ON GERRE TO | | |
| LIVING/DINING ROOM 09Mar22 Note: | TILOOK INSTALLAT | ION - INSTALLED ON SEPERATE SWITCH FROM STAN | IDARD LIGHT - | |
| 1 - 200 AMP ELECTRICAL S | ERVICE | | | |
| 09Mar22 Note: | | | | |
| FIREPLACE AND ACCES | | | | |
| 1 - OVERMANTEL - CAST ST | TONE - FOR 9 FOOT C | CEILING | | |
| 09Mar22 Note: | | | | < |
| 1 - MANTEL - CAST STONE | - QUALITAS II STYLE | MANTEL | | |
| 09Mar22 Note: | | | | |
| 1 - GAS LINE ROUGH-IN FO | R STOVE (INCLUDES | ELECTRICAL OUTLET) - FIRST FLOOR | | |
| 09Mar22 Note: | | Therizon | | |
| | | | | |
| HARDWOOD FLOORING | * | | | |
| | | | | |
| 09Mar22 Note: | IO PARKLANE SERIE | S IN LIEU OF STANDARD LAMINATE | | |
| 1 HADDWOOD ODOUGE | | | | |
| 09Mar22 Note: | SERIES 6 1/2 INCH - IN | N LIEU OF 2 1/4 INCH NATURAL RED OAK MAIN H. | ALL | |
| 1 - HARDWOOD GROUD D | CEDIEC (1/2 DIOIL D | LLIEU OR A (URVENIE DE LE CONTROL DE LE CONT | | |
| 09Mar22 Note: | SERIES 6 1/2 INCH - II | N LIEU OF 2 1/4 INCH NATURAL RED OAK - LIVING A | AND DINING ROOM | |
| 1 - HARDWOOD - GROUP B S | SERIES 6 1/2 INCH - IN | N LIEU OF 2 1/4 INCH NATURAL RED OAK GUEST S | HUEE | |
| 09Mar22 Note: | | V BILLO OF 2 IN THEIR NATURAL RED OAK GUEST S | OHE | |
| 1 - HARDWOOD - GROUP B S | SERIES 6 1/2 INCH - IN | N LIEU OF 2 1/4 INCH NATURAL RED OAK FAMILY | POOM | |
| 09Mar22 Note: | | Table of 2 in their witch it keb oak I Awill I | KOOW | |
| MIRRORS AND GLASS | | | III - II | |
| 1 GUEST ENSUITE BATHR | OOM – FRAMELESS | GLASS SHOWER ENCLOSURE – INCLUDES CHROME I | KNOB AND HINGES | |
| 14Apr22 Note: | | | New | . ** |
| REPARTMENT STANDERS | GLASS SHOWER DO | OR FOR 5 FOOT PAN - INCLUDES CHROME KNOB & F | INGES GUEST EN | |
| 14Apr22 Note: | | | | |
| | | | | |

1 - SHOWER DOOR HANDLE - MATTE BLACK D-RING WITH TOWEL BAR - MASTER ENSUITE BATHROOM

09Mar22 Note:

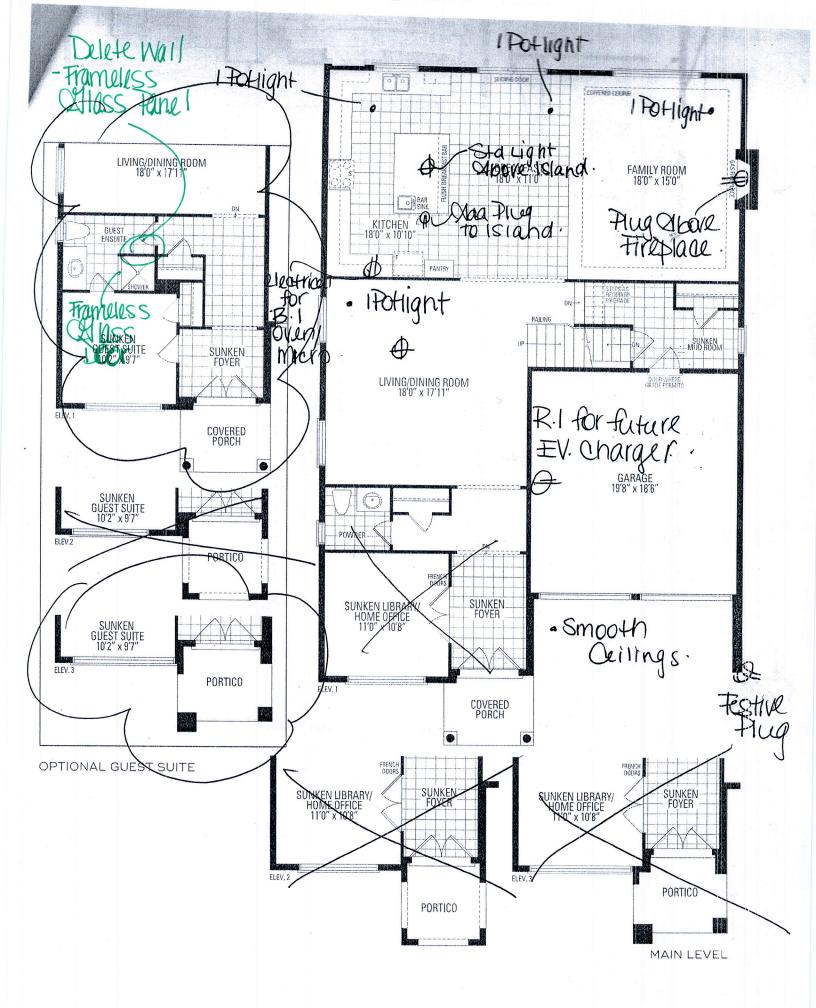

SPRINGFIELD THREE ELEV. 1 - 3,7

Orientation of home may be reversed and purchaser agrees to accept same. Steps and porches may stated floor areas. All renderings are artist's concept. Dimensions, specifications and architectural details

