

Revised - Selbg

CONSTRUCTION SUMMARY - PARTIAL ONLY
Mountainview Heights 3 (G) - Russell Gardens Building Ltd.

PURCHASERS: David Paul GRAY and Jessica M. GRAY TEL: RES.: 416-660-3312

LOT NUMBER	PHASE	HOUSE TYPE	REG. PLAN #		
18	3	Mountainash Seven Elev 3	62M-1266		
INV#	QTY	EXTRA / CHANGE			

Offer	Note:
-------	-------

CABINETRY


27,061 27Apr22	1 - PURCHASER ACCEPTS REVISED WOOD HOOD FAN TO CEILING AS PER ATTACHED DRAWING -NO CHARGE TRANSITIONAL WOOD HOOD WITH SQUARE MOULDING--- Note:
25,027 14Jan21	1 - CABINETRY - KITCHEN - UPGRADE 2 Note:
25,027 14Jan21	1 - CABINETRY - KITCHEN - LIGHT VALENCE Note:
25,027 14Jan21	1 - DELETE HARDWARE NO HOLES DRILLED - KITCHEN ONLY Note:
25,027 14Jan21	1 - KITCHEN CABINETRY - DIFFERENT COLOUR ISLAND - FLAT FEE Note:

This Document is Extremely Time Sensitive - Printed 27 Apr 22 at 14:37

RECEIVED
APR 28 2022

Lot. 18
Russell
Gardens -

Aruba
Door -

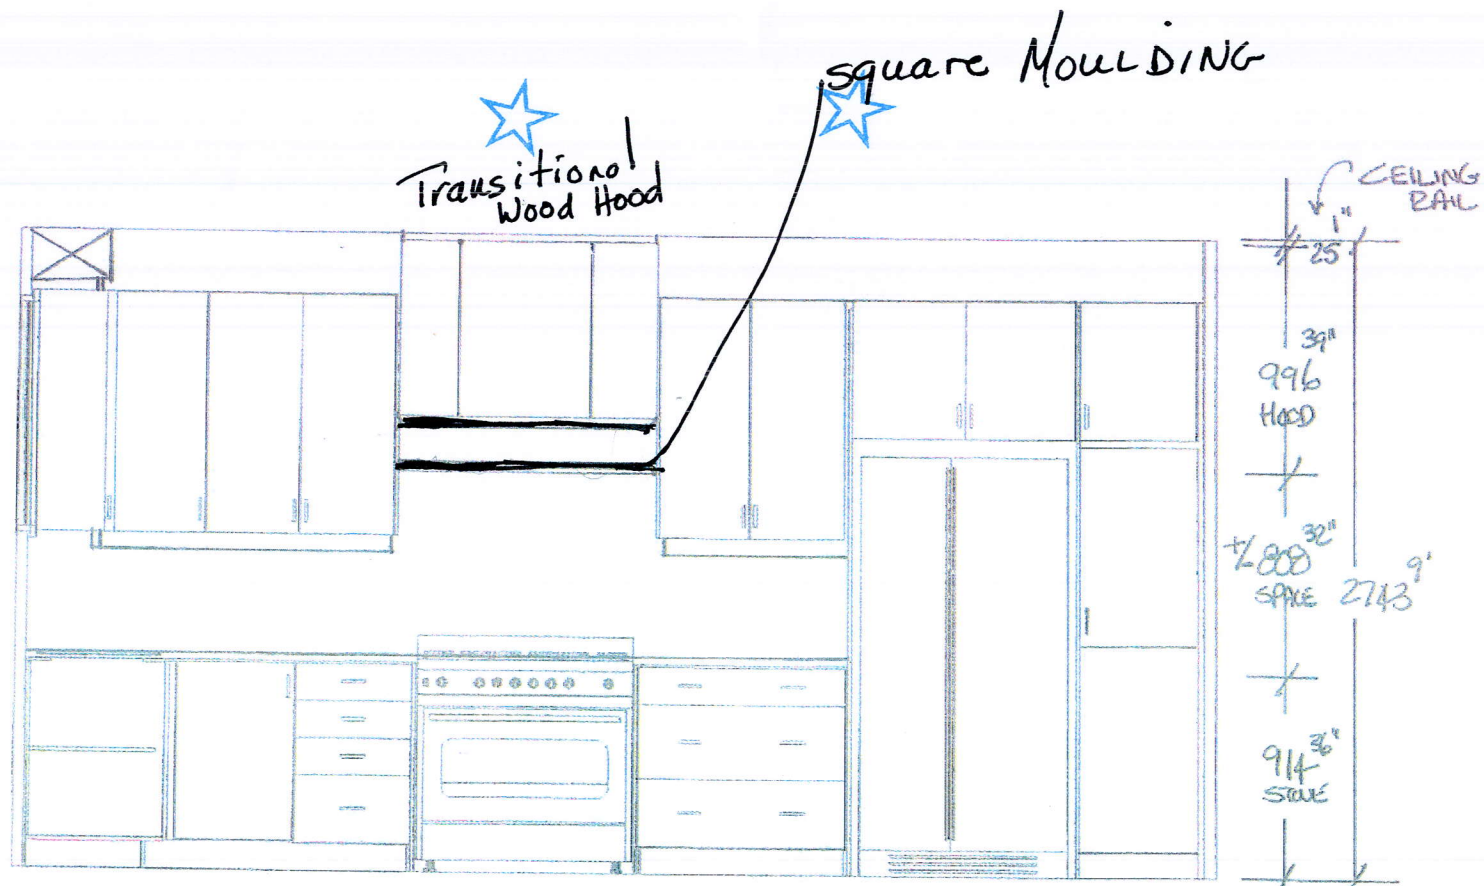

This drawing is the intellectual property of
SELBA INDUSTRIES INC. and is an
artistic
interpretation of the general
appearance of the design. It is
not meant to be an exact rendition.

20
TECHNOLOGIES

Designed: 11/22/2021
Printed: 4/22/2022

Revised Hood

~~APR 22/22~~
APR 26/22

2103074

LAYOUT

Drawing #: 1